


FHWA REGION NO.	STATE	PROJECT NO.	YEAR	SHEET NO.	TOTAL SHEETS
7	KANSAS	54-87 K-6657-01	2002	159	1122

DATE	
BY	
REFERENCES NOTED	
REFERENCES CHECKED	

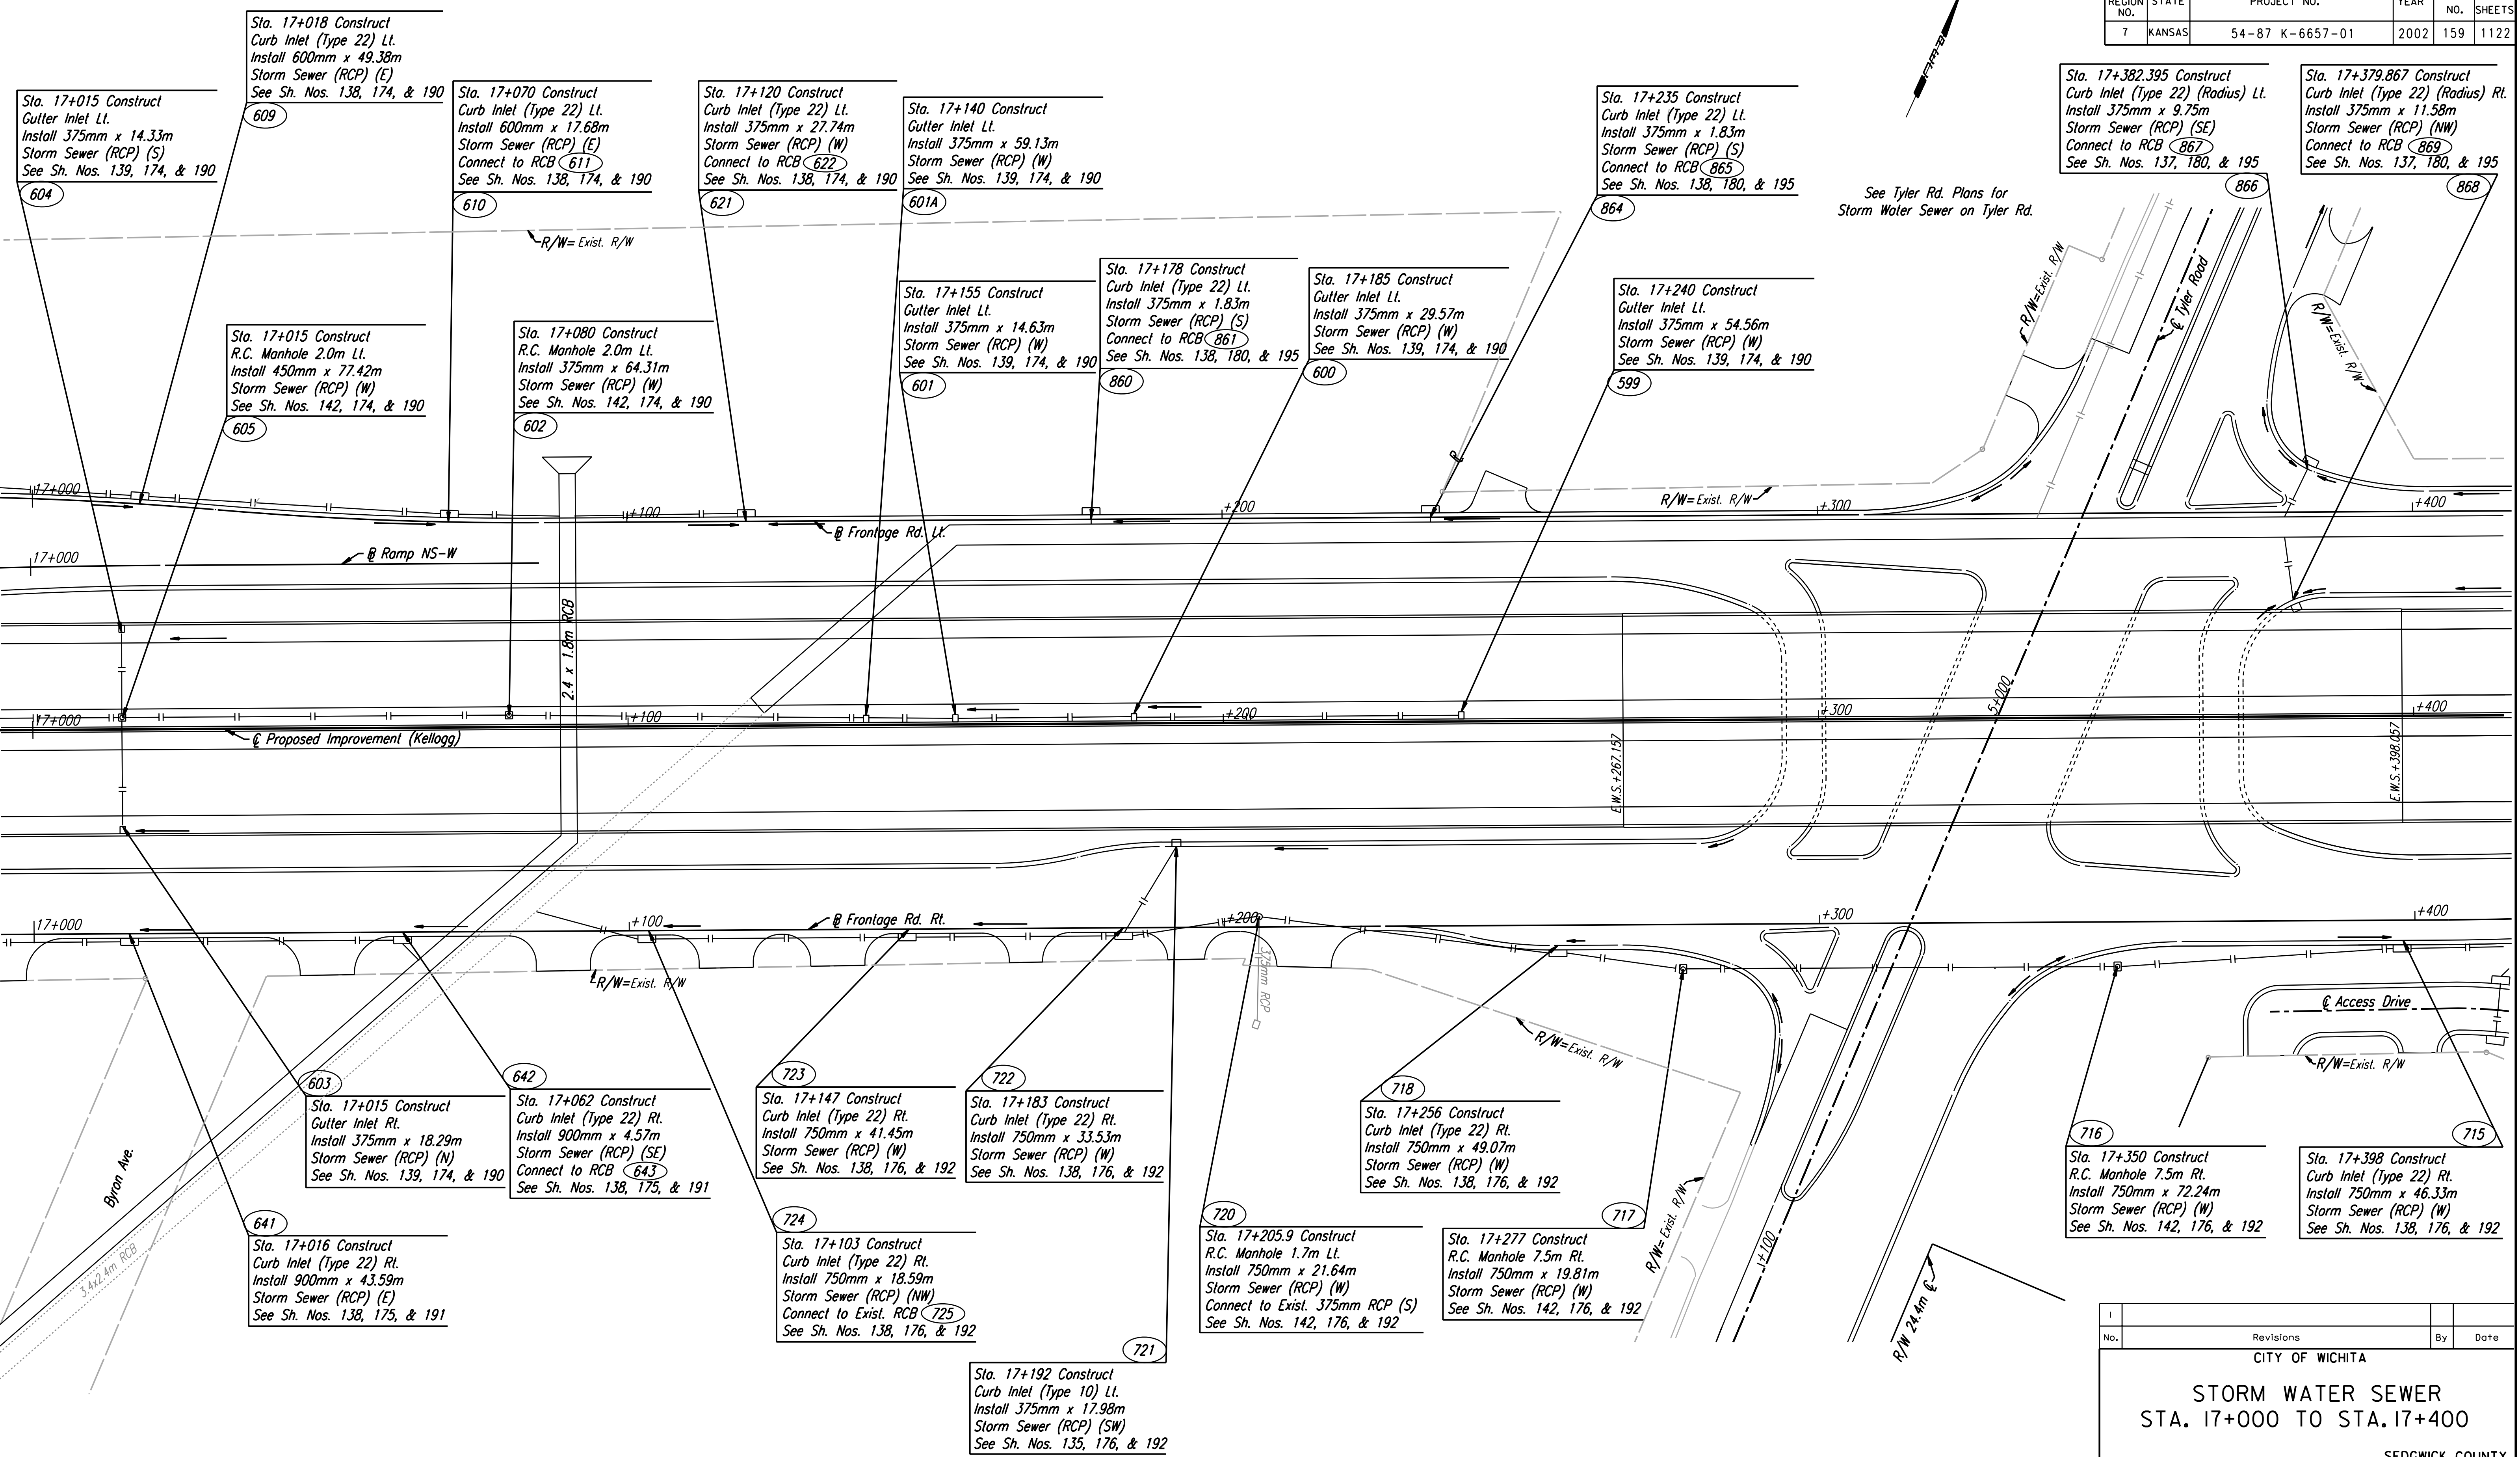

DSNR: JPS OPER: JGP SCALE: 1:500
 i:/1997/97362/As-Builts/dgn's/159--sww170-174.dgn Last Rev: 8-2-07 By: gdr

RECORD DRAWING

No.		Revisions	By	Date
CITY OF WICHITA				
STORM WATER SEWER STA. 17+000 TO STA. 17+400				
SEDGWICK COUNTY				
Professional Engineering Consultants, P.A. 303 S. TOPEKA • WICHITA, KANSAS 67202 316-262-2691 • FAX 316-262-3003				
Designed by	RCH	Checked by	WDH	
Drawn by	JGP	Date	April, 2002	Job No. 97362