


FHWA REGION NO.	STATE	PROJECT NO.	YEAR	SHEET NO.	TOTAL SHEETS
7	KANSAS	54-87 K-6657-01	2002	171	1122

REFERENCES NOTED	DATE
REFERENCES CHECKED	
BY	

DSNR: RCH OPER: JGP SCALE: 1:500
 I:/1997/97362/As-Builts/dgn s/ Sh 171 - sws - profiles.dgn Last Rev: 8-20-07 By: gdr

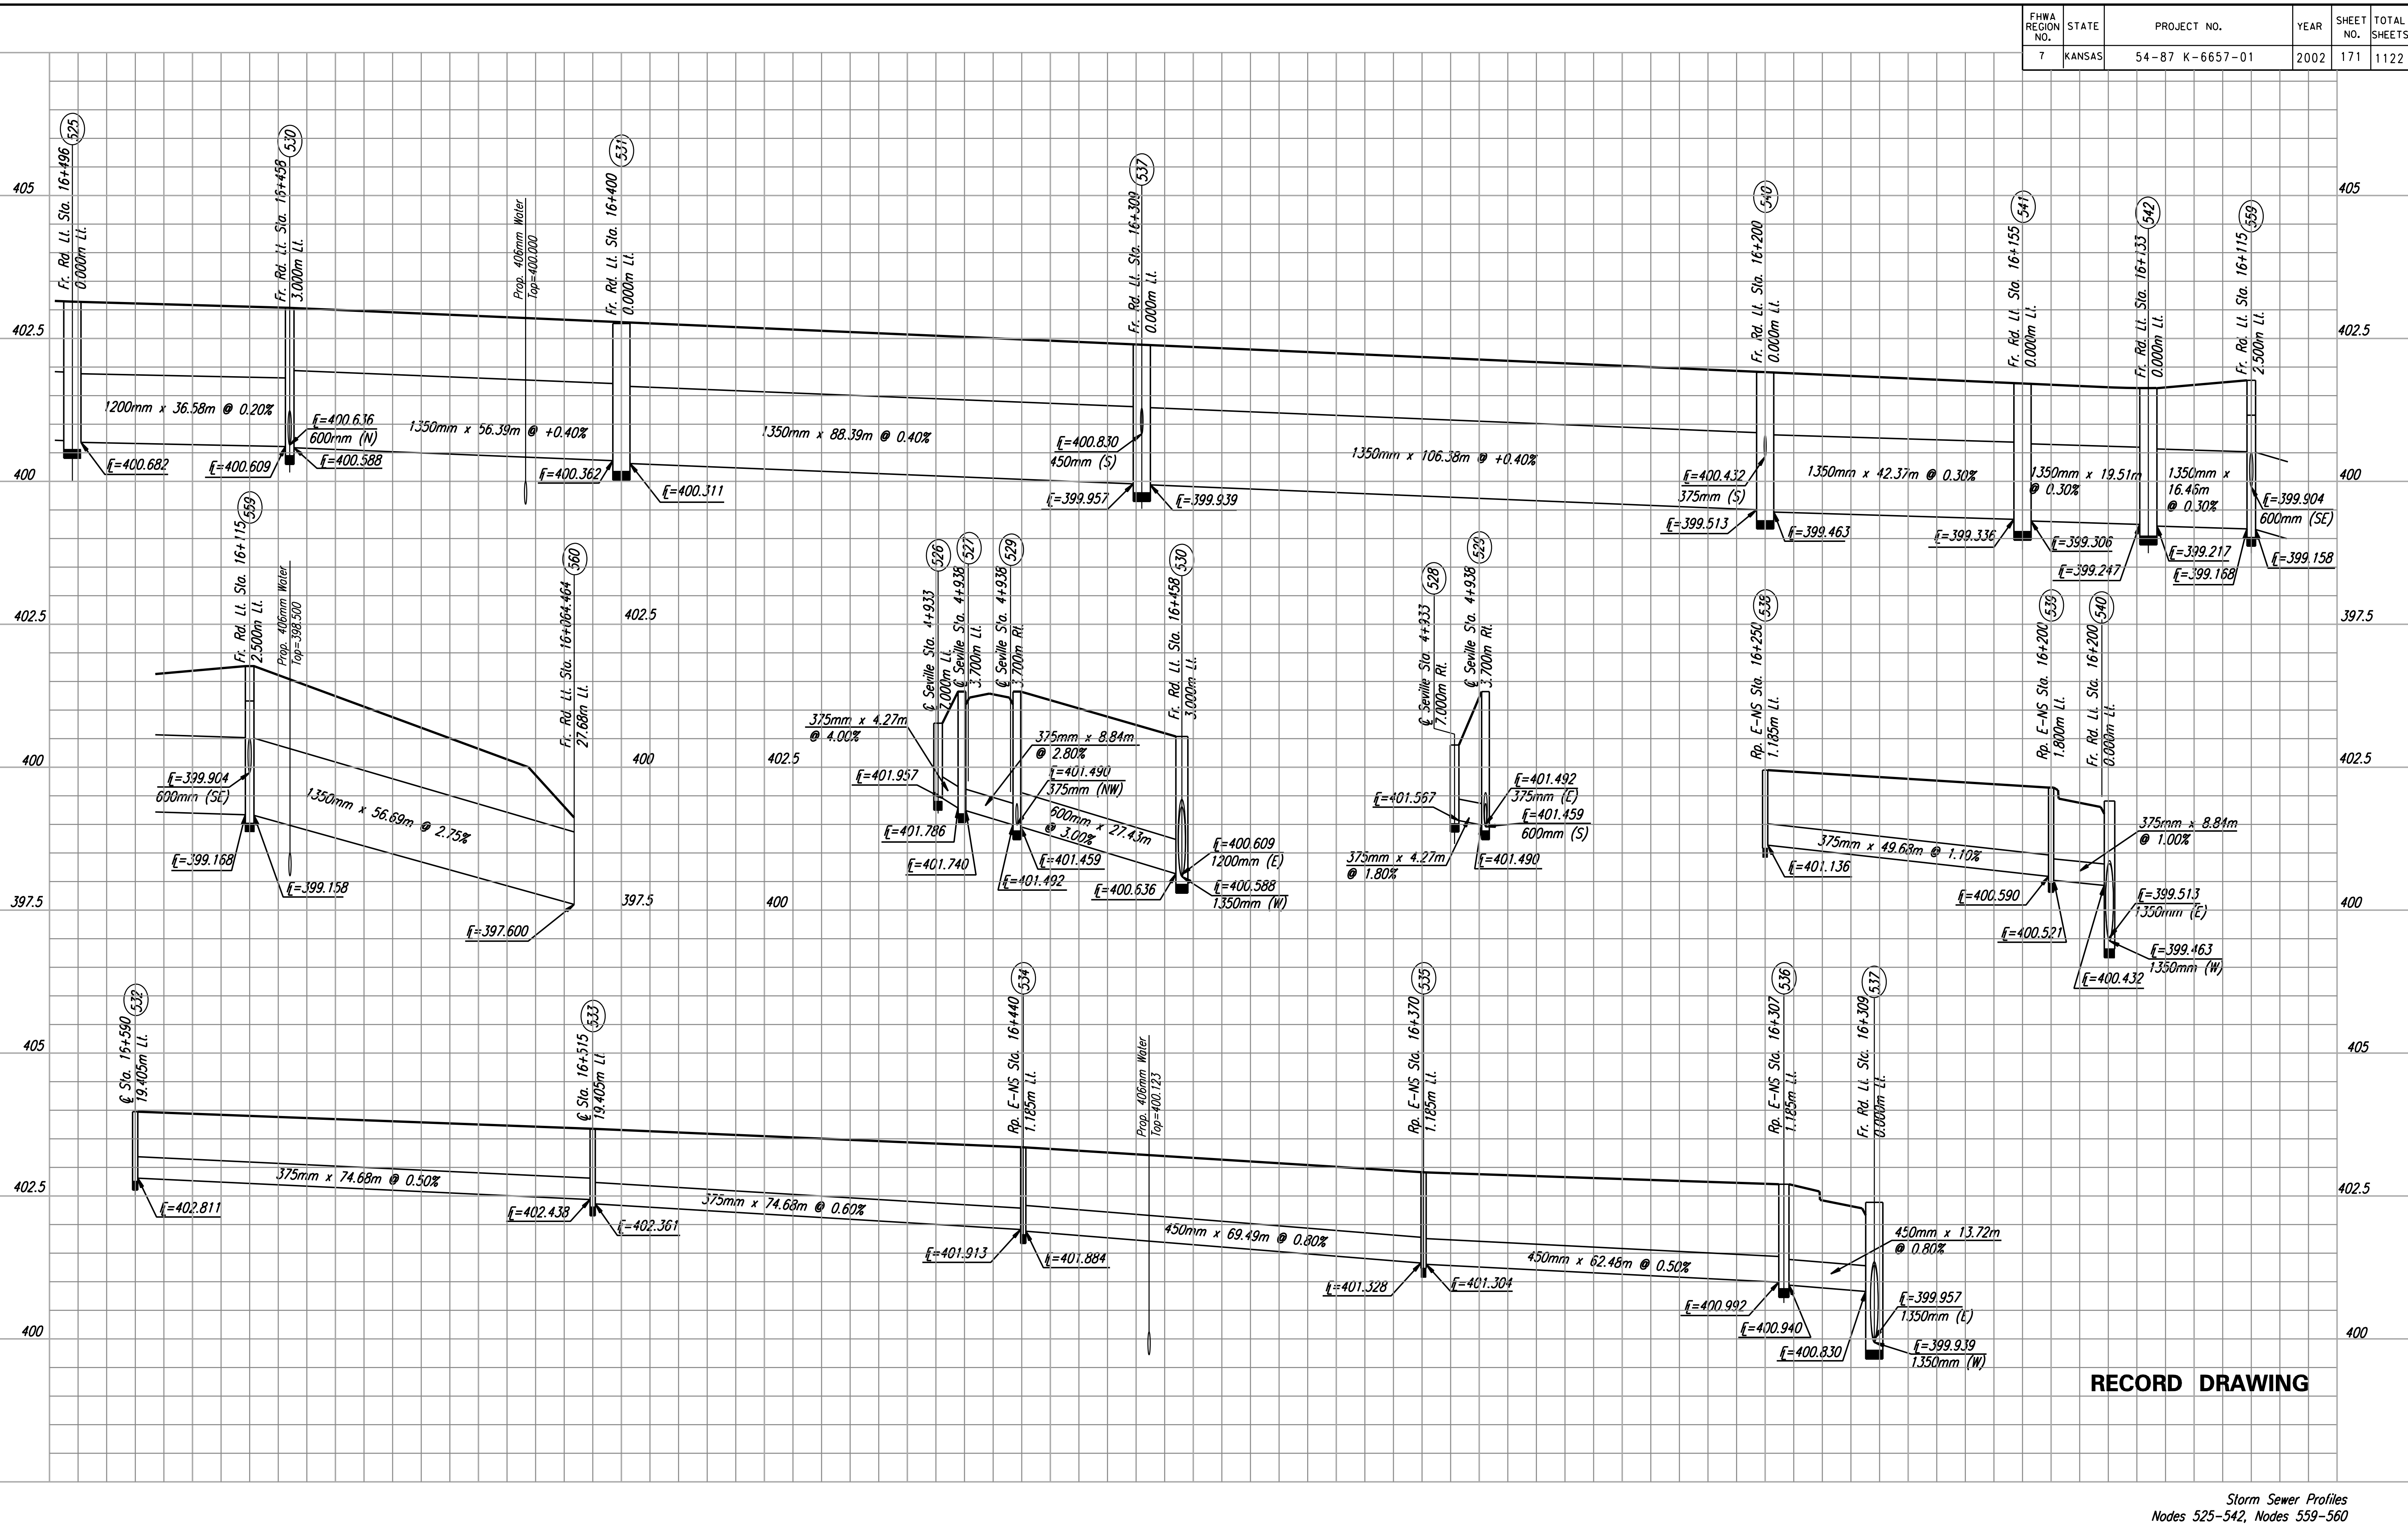

RECORD DRAWING