
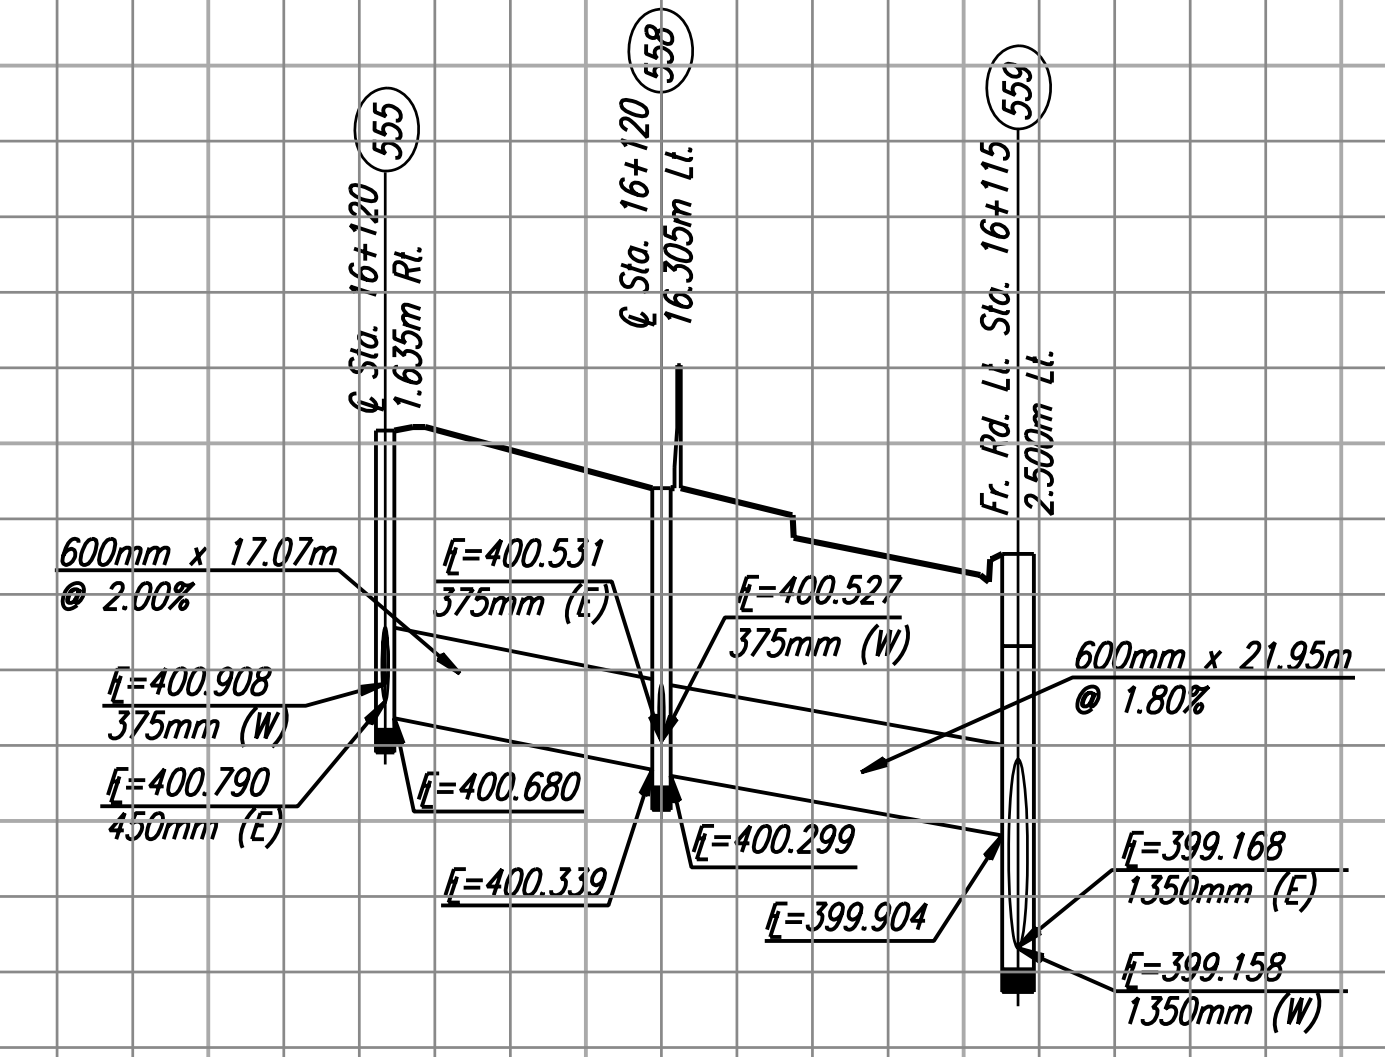
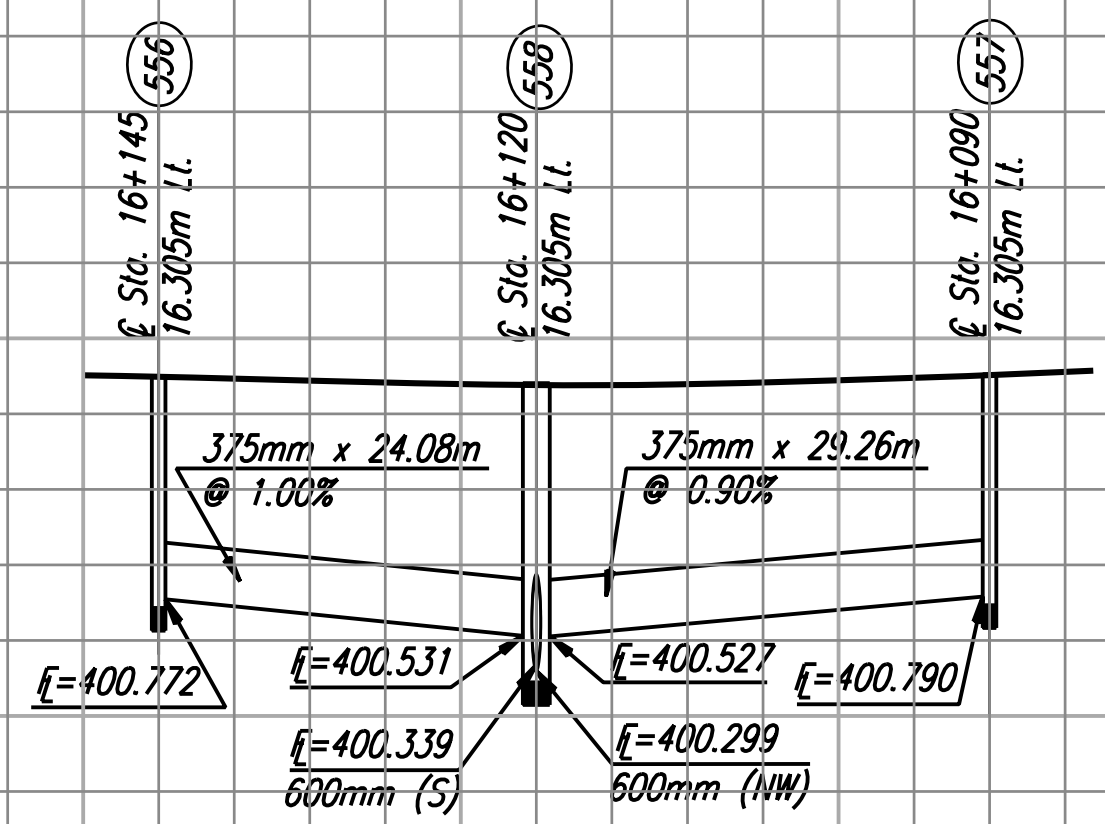
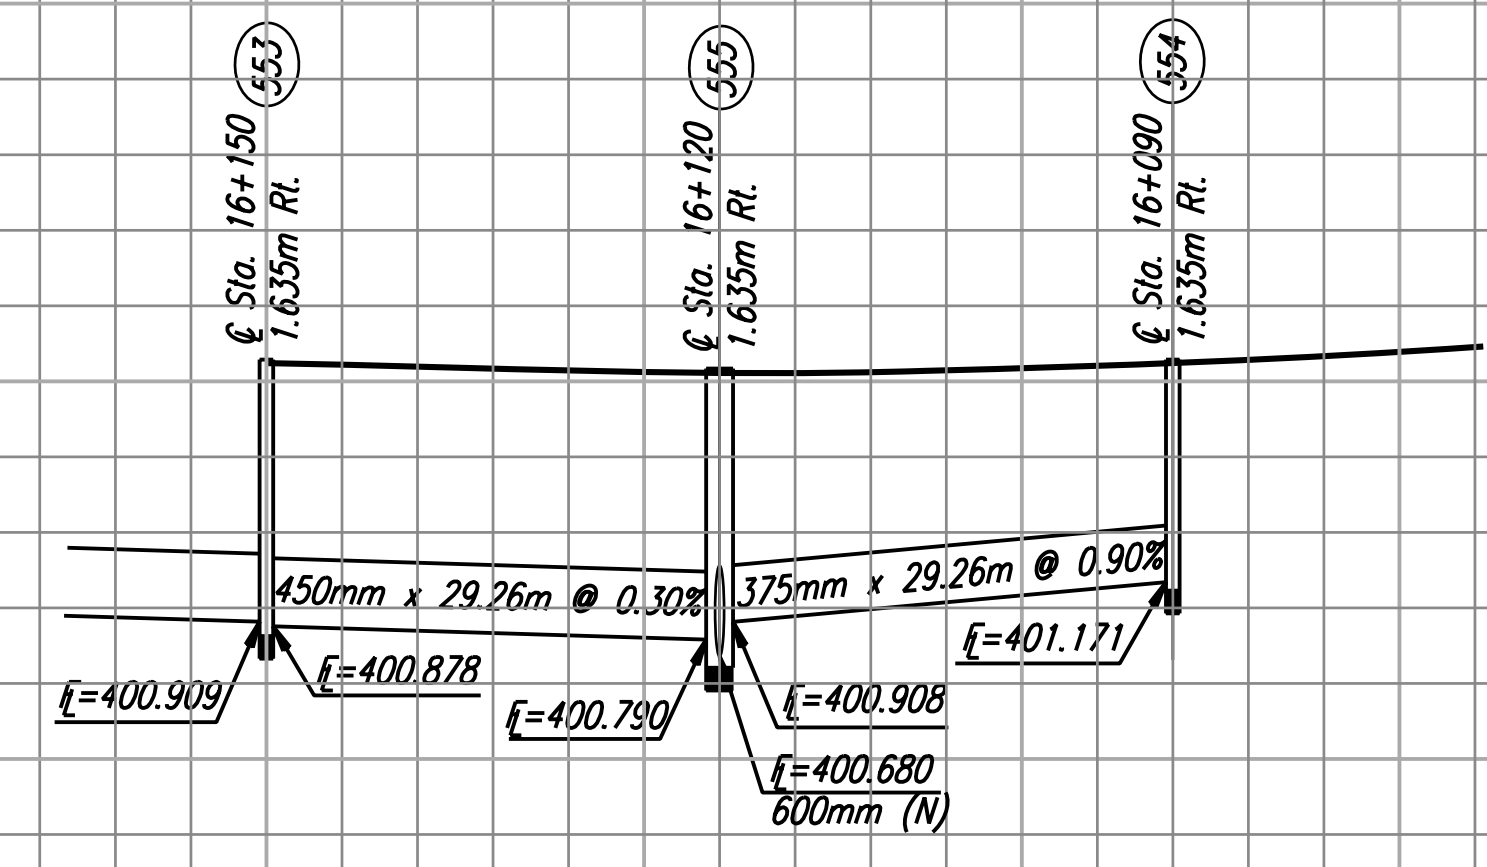


FHWA REGION NO.	STATE	PROJECT NO.	YEAR	SHEET NO.	TOTAL SHEETS
7	KANSAS	54-87 K-6657-01	2002	172	1122

DATE	
BY	
REFERENCES NOTED	
REFERENCES CHECKED	

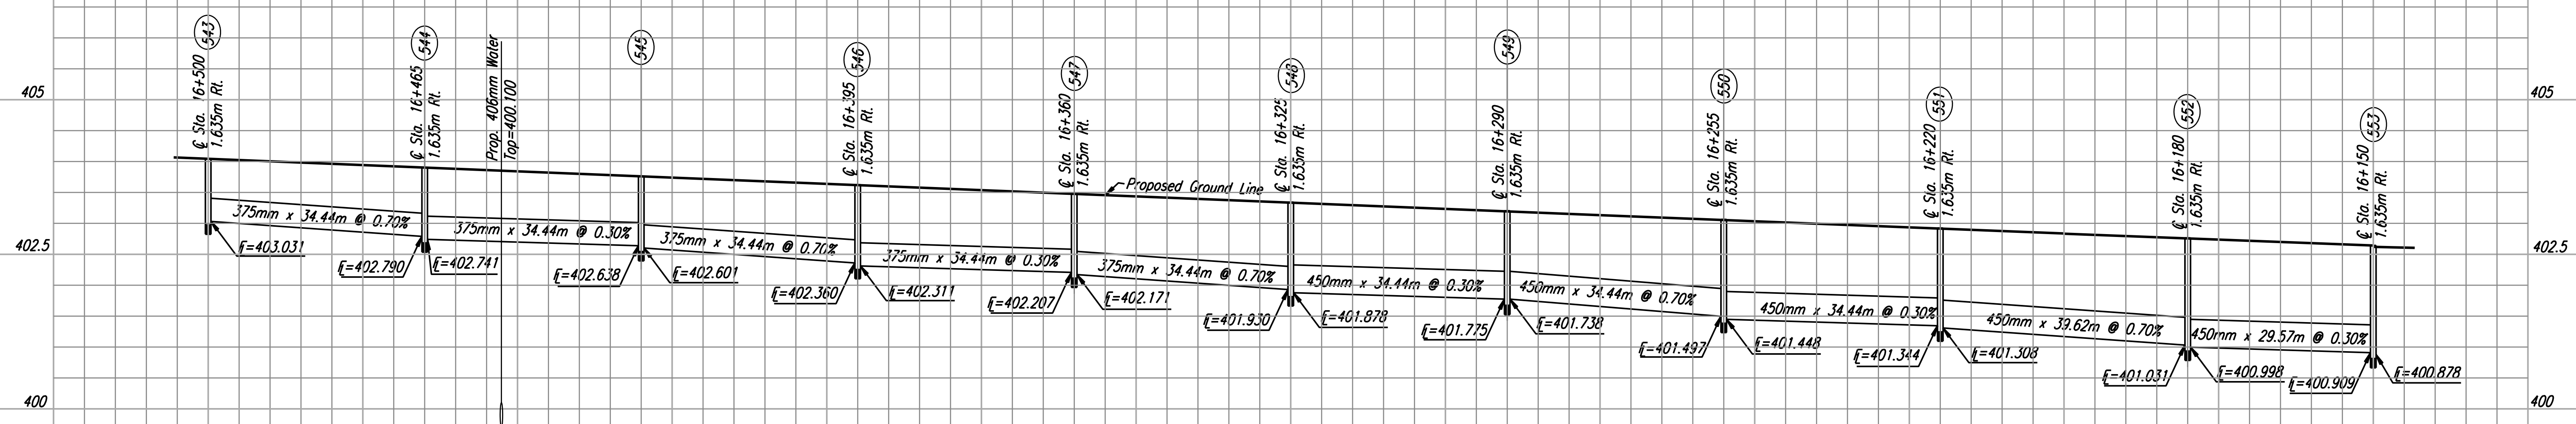

DSNR: RCH OPER: JGP SCALE: 1:500
 I:/1997/97362/4s-Built/dgn/s/Sh 172-sws-profiles.dgn Last Rev: 8-20-07 By: gdr

RECORD DRAWING