


| FHWA REGION NO. | STATE | PROJECT NO. | YEAR | SHEET NO. | TOTAL SHEETS |
|-----------------|--------|-----------------|------|-----------|--------------|
| 7 | KANSAS | 54-87 K-6657-01 | 2002 | 174 | 1122 |

| DATE | BY |
|------|----|
| | |
| | |
| | |

DSNR: RCH OPER: JGP SCALE: 1:500
 I:/1997/97362/As-Builts/dgn s/ Sh 174-sws-profiles.dgn Last Rev: 8-20-07 By: gar

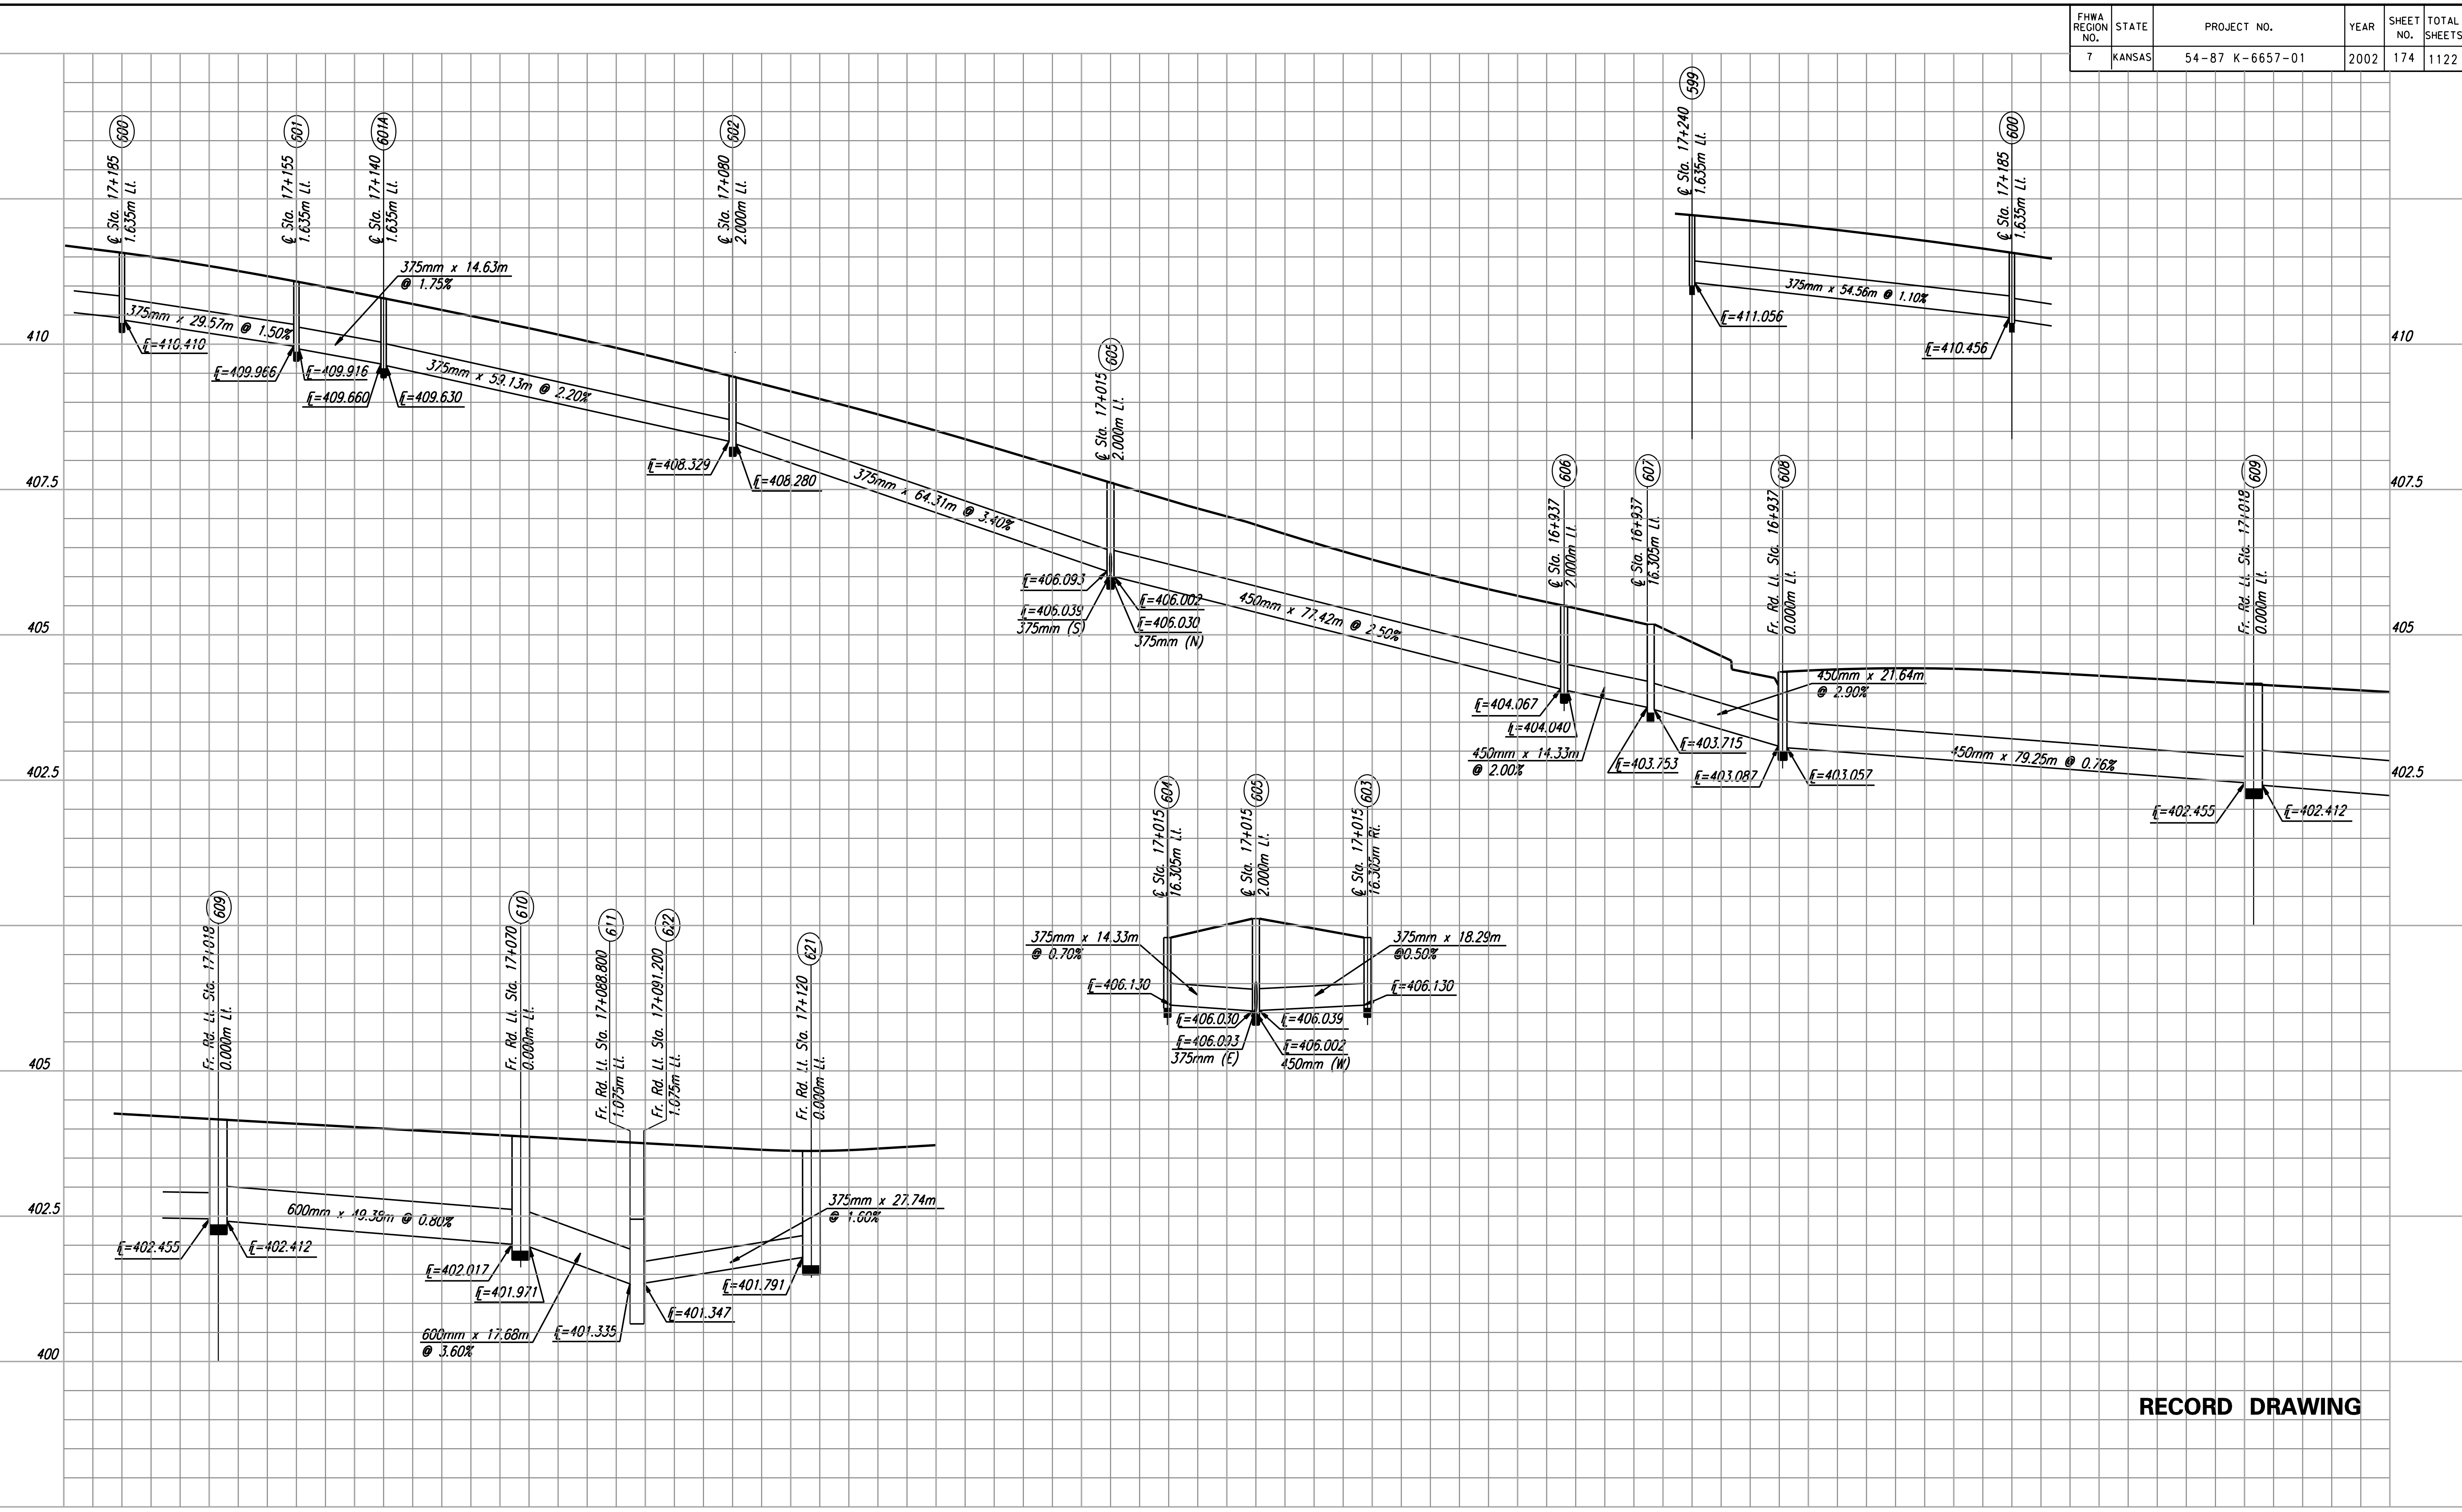

RECORD DRAWING