


FHWA REGION NO.	STATE	PROJECT NO.	YEAR	SHEET NO.	TOTAL SHEETS
7	KANSAS	54-87 K-6657-01	2002	177	1122

BY	DATE

REFERENCES NOTED	REFERENCES CHECKED

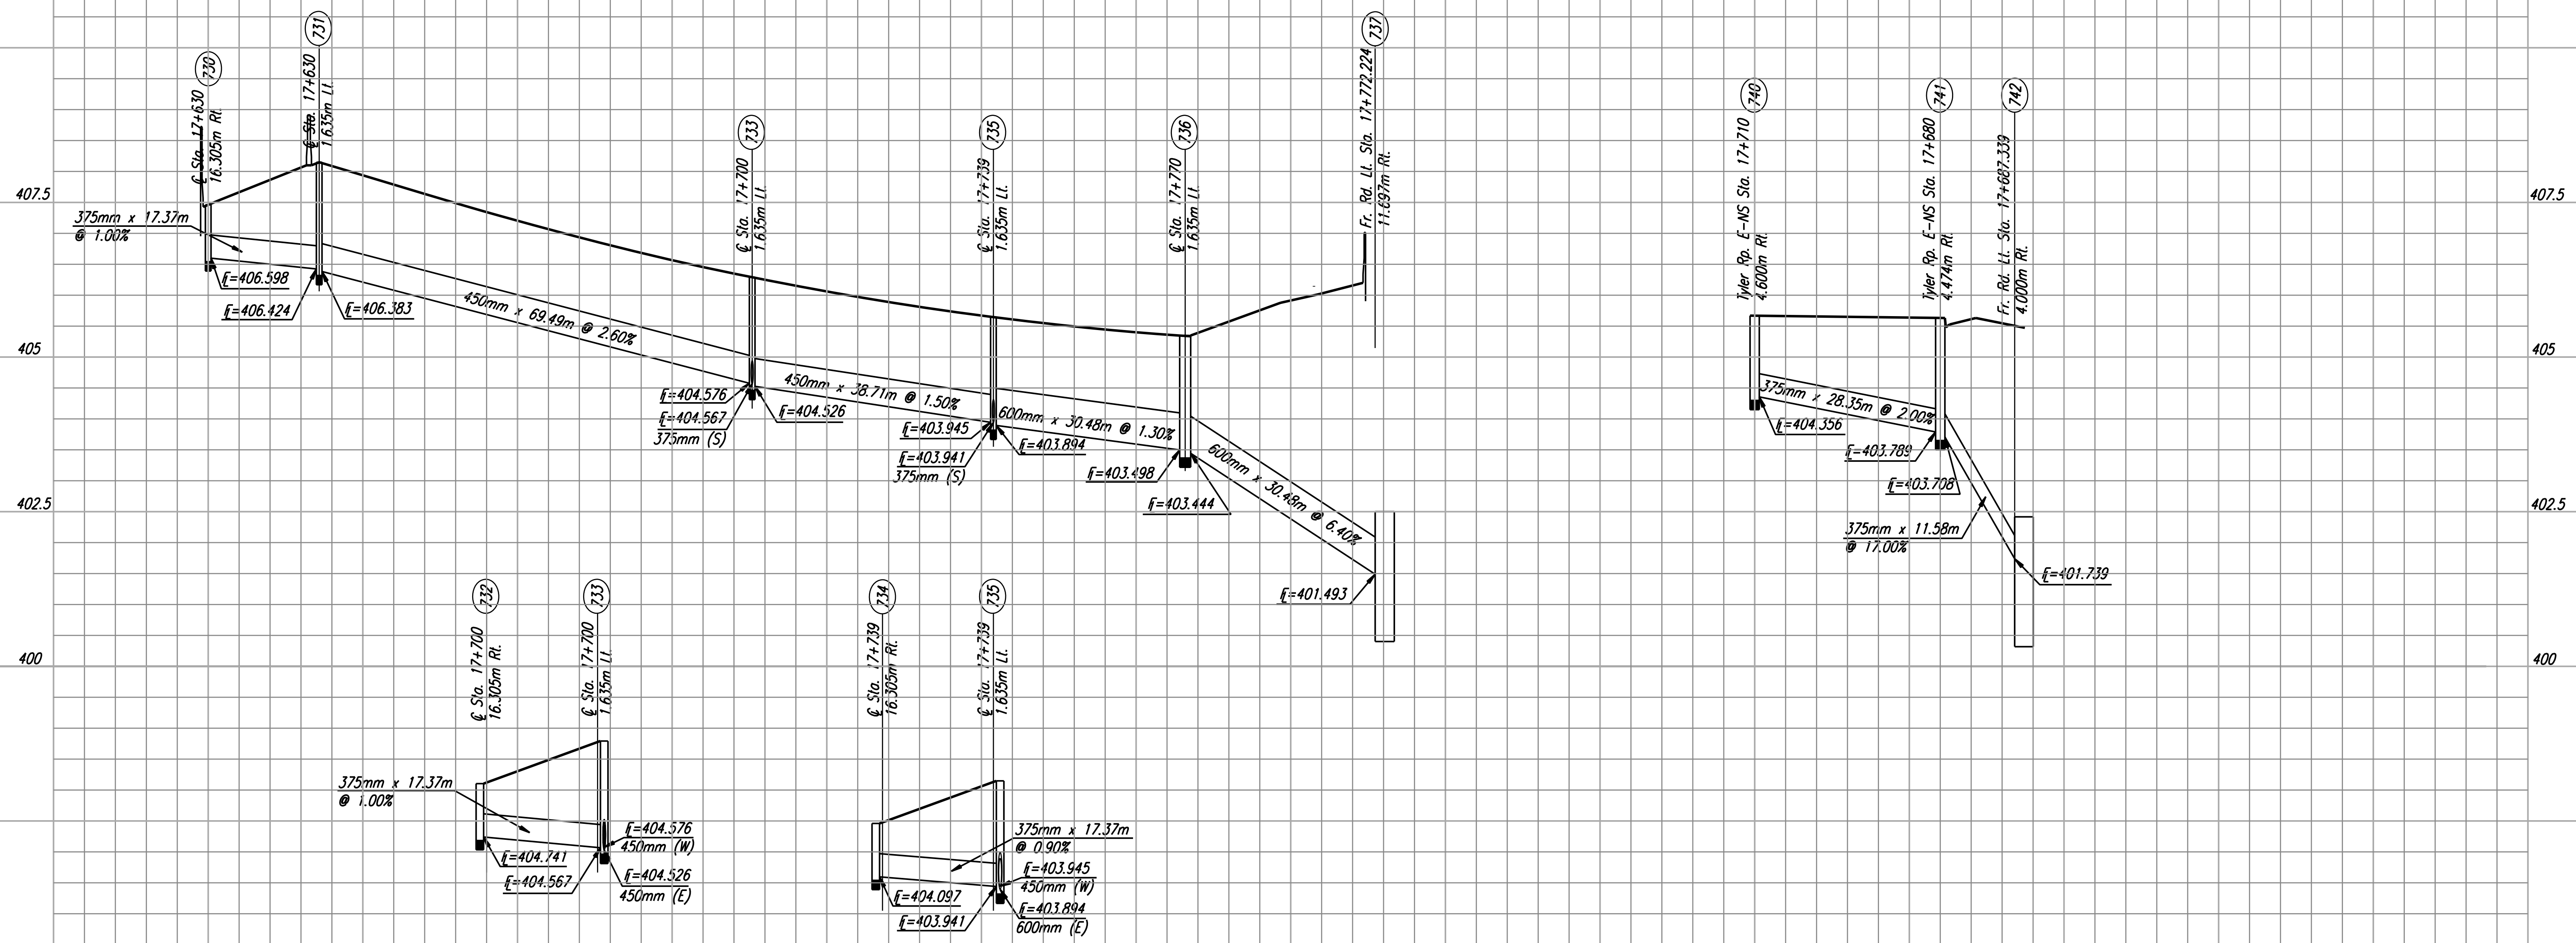

DSNR: RCH OPER: JGP SCALE: 1:500  
 I:/1997/97362/As-Builts/dgn s/ Sh 177 - sws - profiles.dgn Last Rev: 8-20-07 By: gdr

**RECORD DRAWING**