


BY	DATE
REFERENCES NOTED	
REFERENCES CHECKED	

DSNR: RCH OPER: JGP SCALE: 1:500  
 I:\1997\97362\As-Builts\ogn's\Sh 179-sws-profiles.dgn Last Rev: 8-20-07 By: gdr

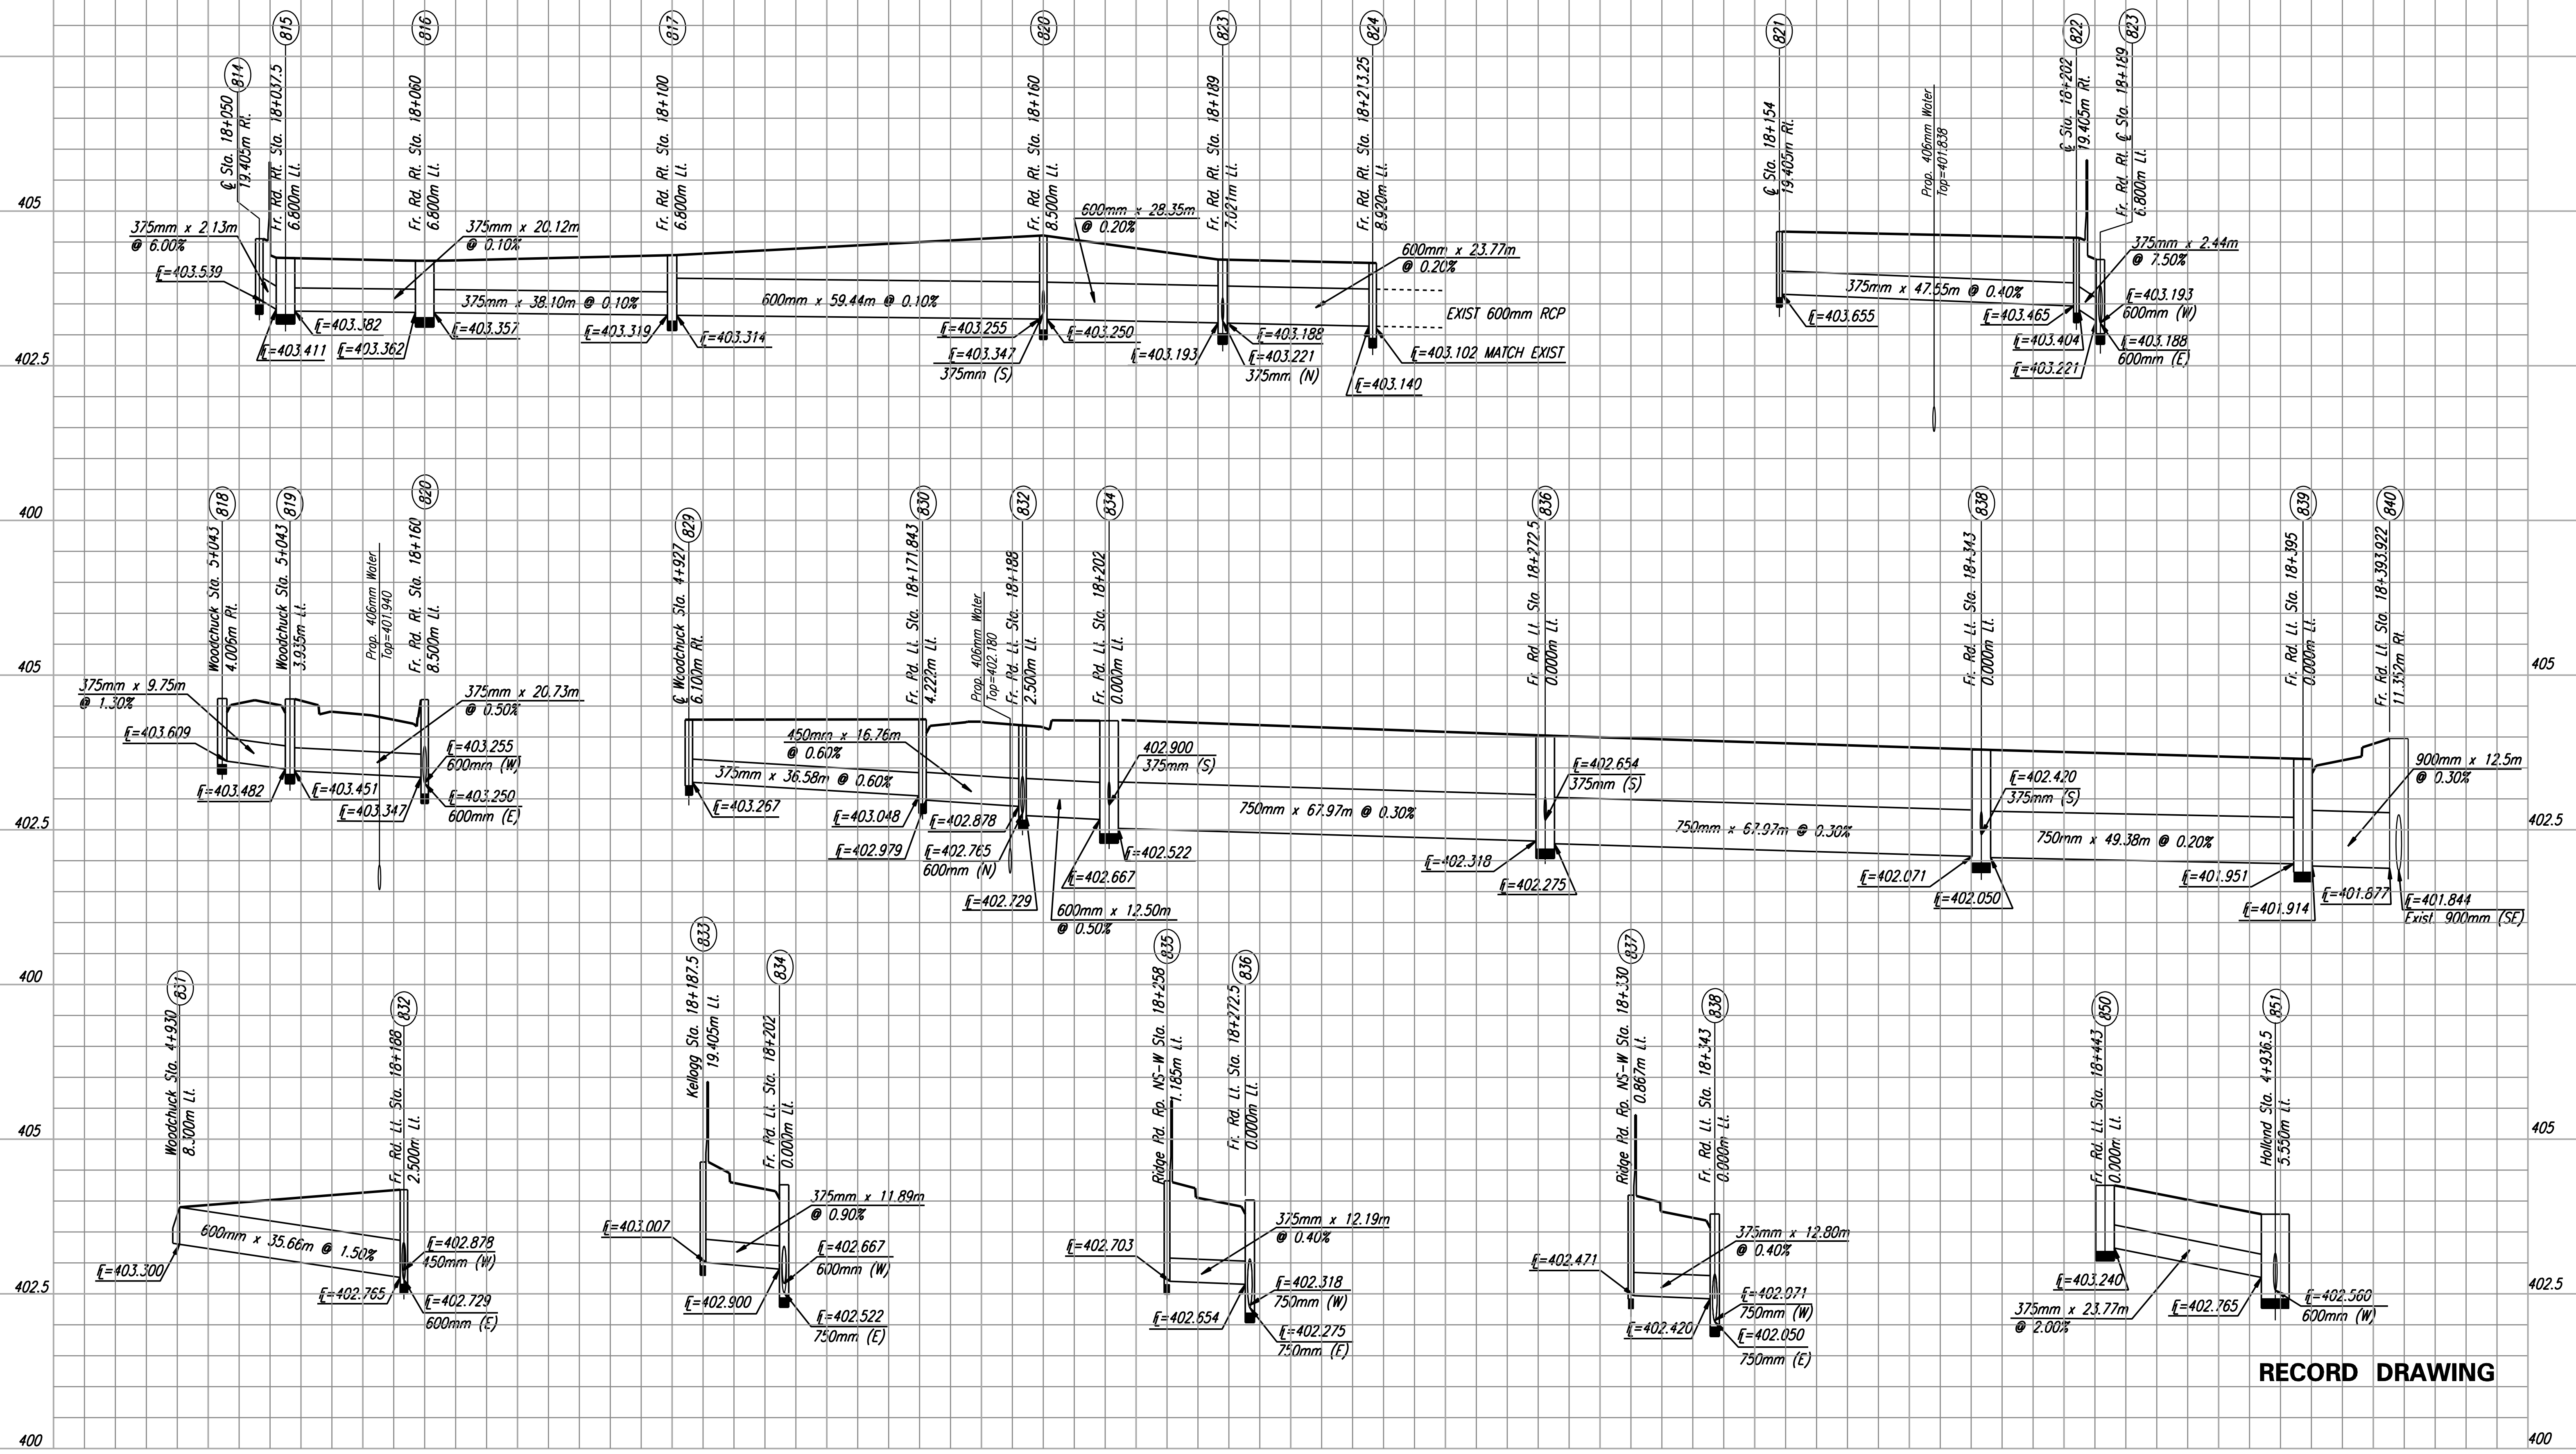

**RECORD DRAWING**