


STATE	PROJECT NO.	YEAR	SHEET NO.	TOTAL SHEETS
KANSAS	54-87 K-6657-01	2002	243	1122

DATE	
BY	
REFERENCES NOTED	
REFERENCES CHECKED	

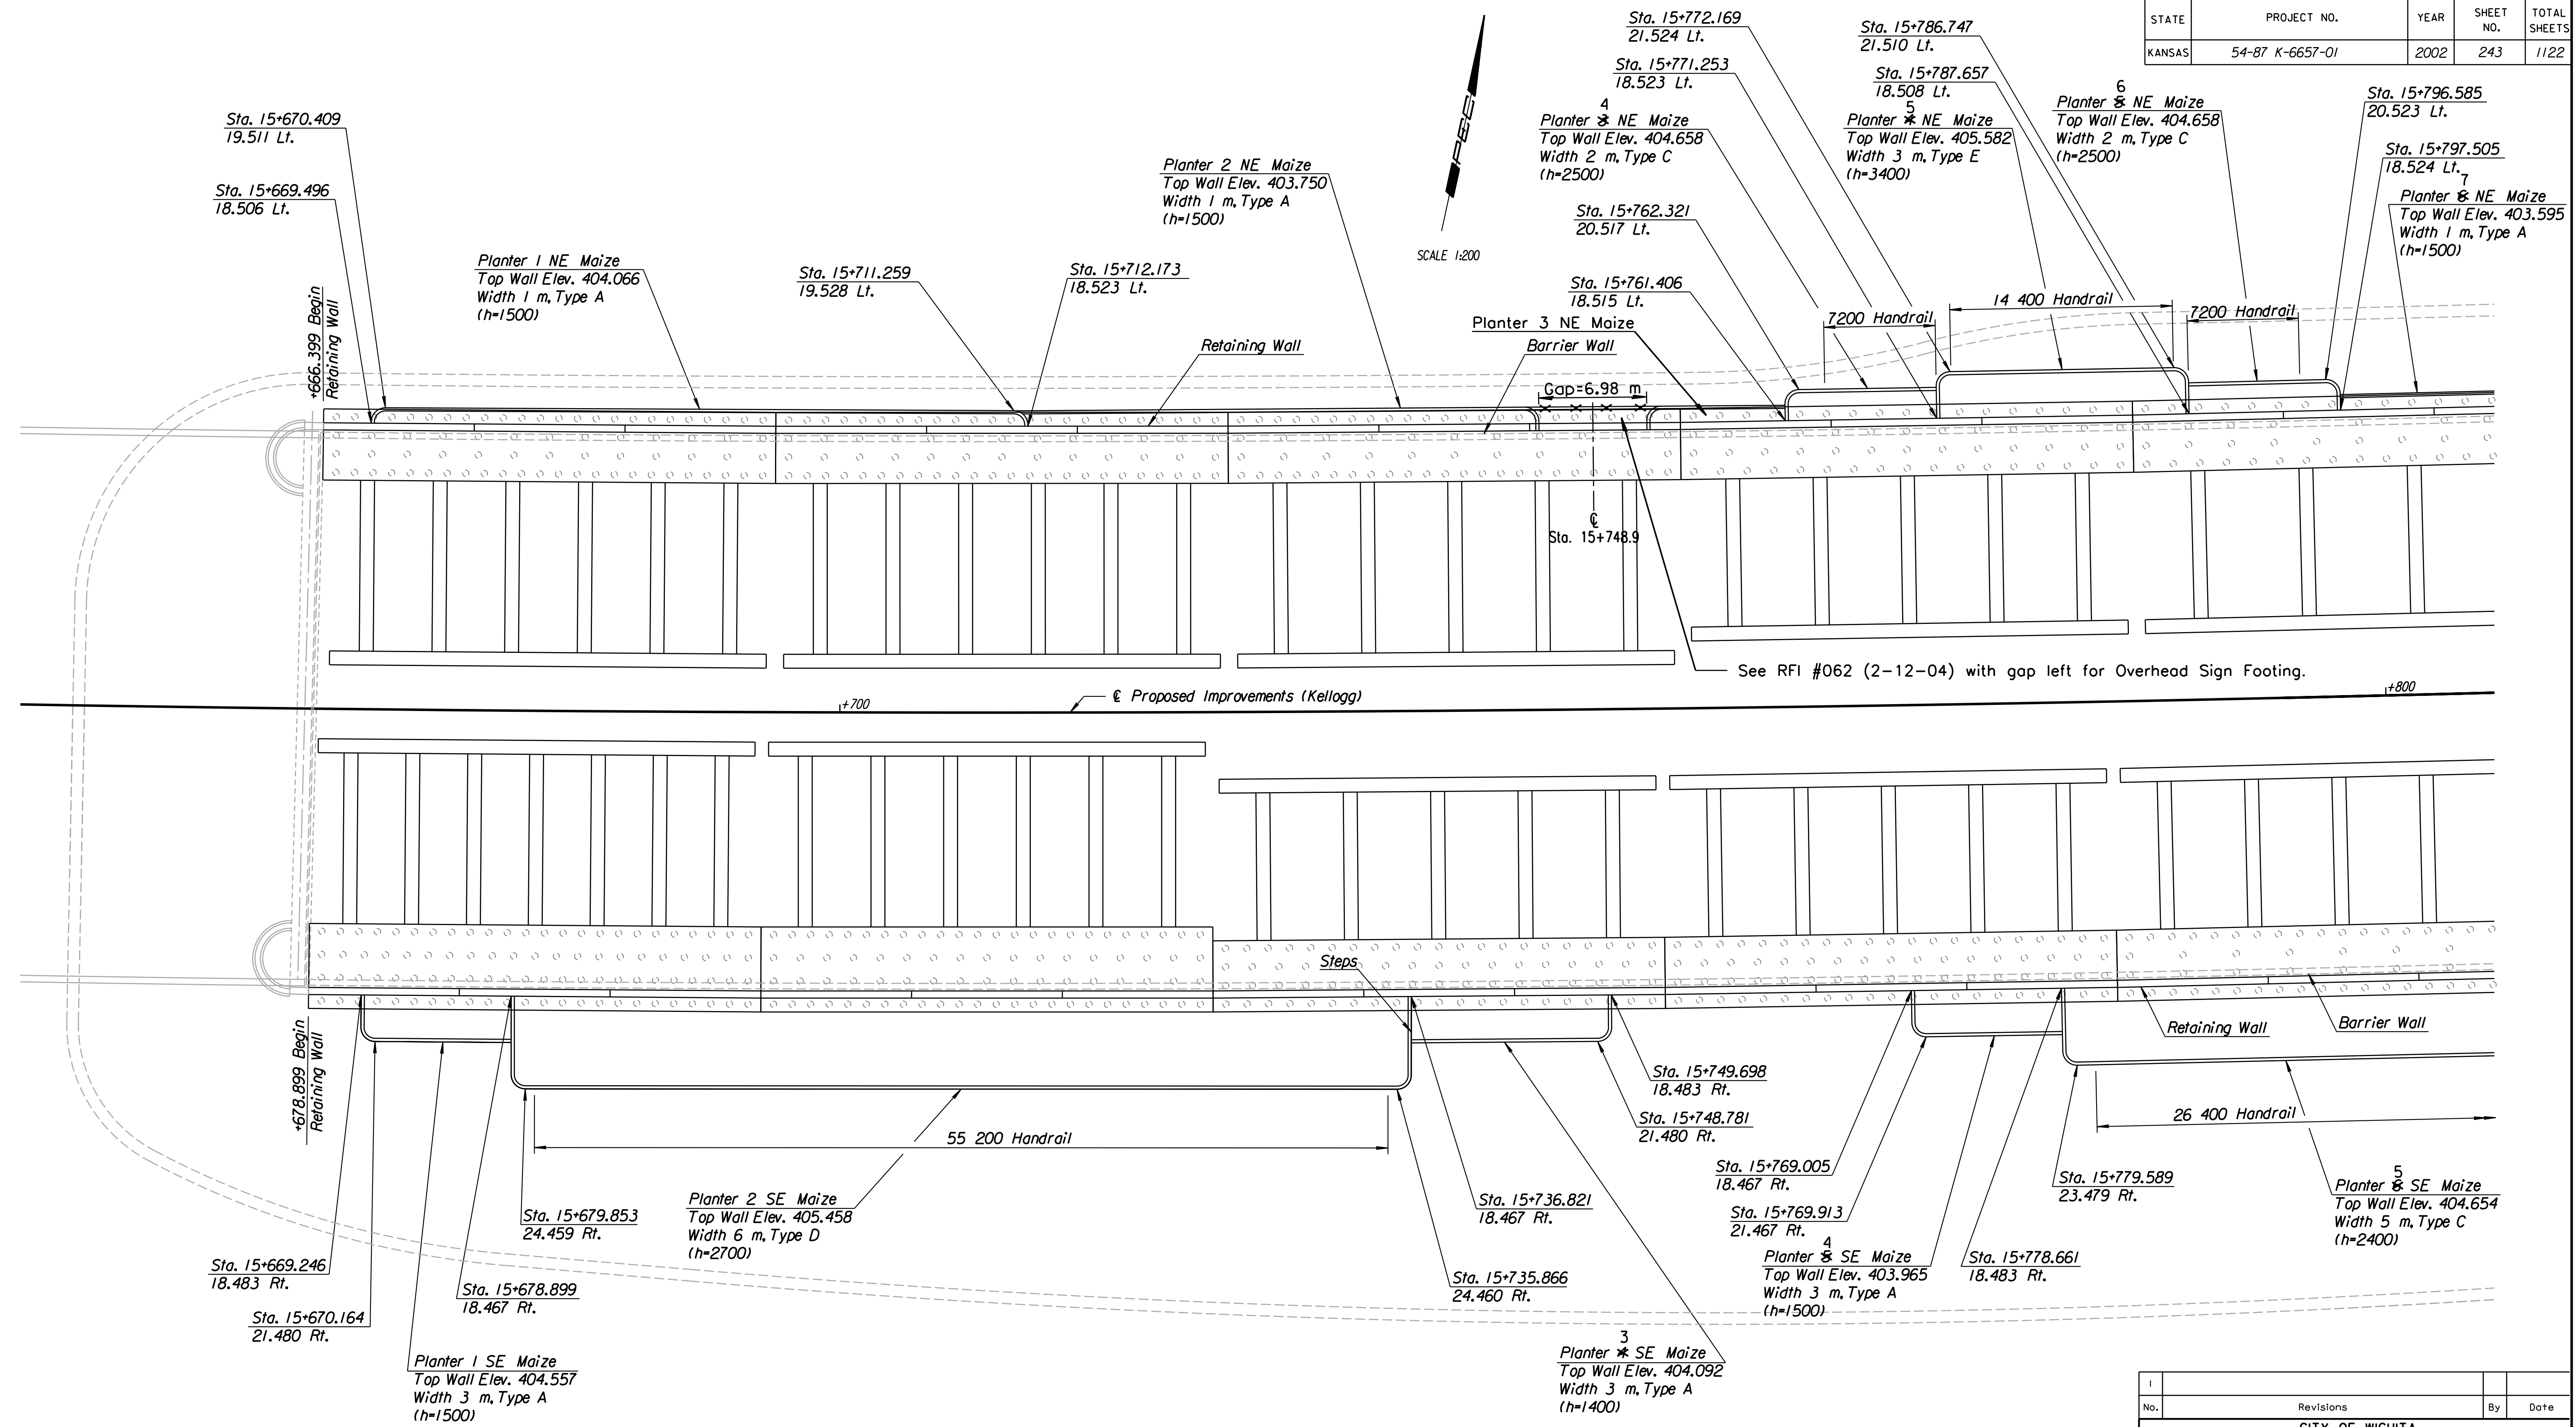

See RFI #062 (2-12-04) with gap left for Overhead Sign Footing.

PLAN

Note: See Sheet No. 238A for Wall Type A thru Wall Type E. *If equals Top of Planter Wall to Bottom of Footing.

① *Width* of planters=width + 5 in. (0.127 m).

RECORD DRAWING

No.	Revisions	By	Date

CITY OF WICHITA
KELLOGG
 CAST IN PLACE RETAINING WALL
 STA. 15+647 to STA. 15+807
 SEDGWICK COUNTY

Professional Engineering Consultants, P.A.
 303 S. TOPEKA • WICHITA, KANSAS 67202
 316-262-2691 • FAX 316-262-3003

Designed by	PDF	Checked by	RAS
Drawn by	DRP	Date	April, 2002
		Job No.	97362

DSNR: PDF OPER: DRP SCALE: 1:200
 i:/1997/97362/As-Builts/dgn's/Vol 2/Sh 243-plantwall4.dgn Last Rev: 8-21-07 By: gar