



STATE	PROJECT NO.	YEAR	SHEET NO.	TOTAL SHEETS
KANSAS	54-87 K-6657-01	2002	247	1122

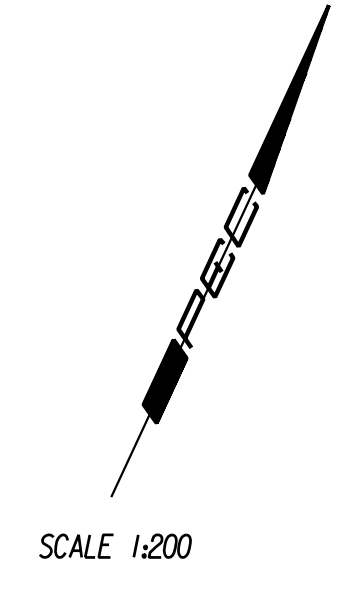

DATE	
BY	
REFERENCES NOTED	
REFERENCES CHECKED	

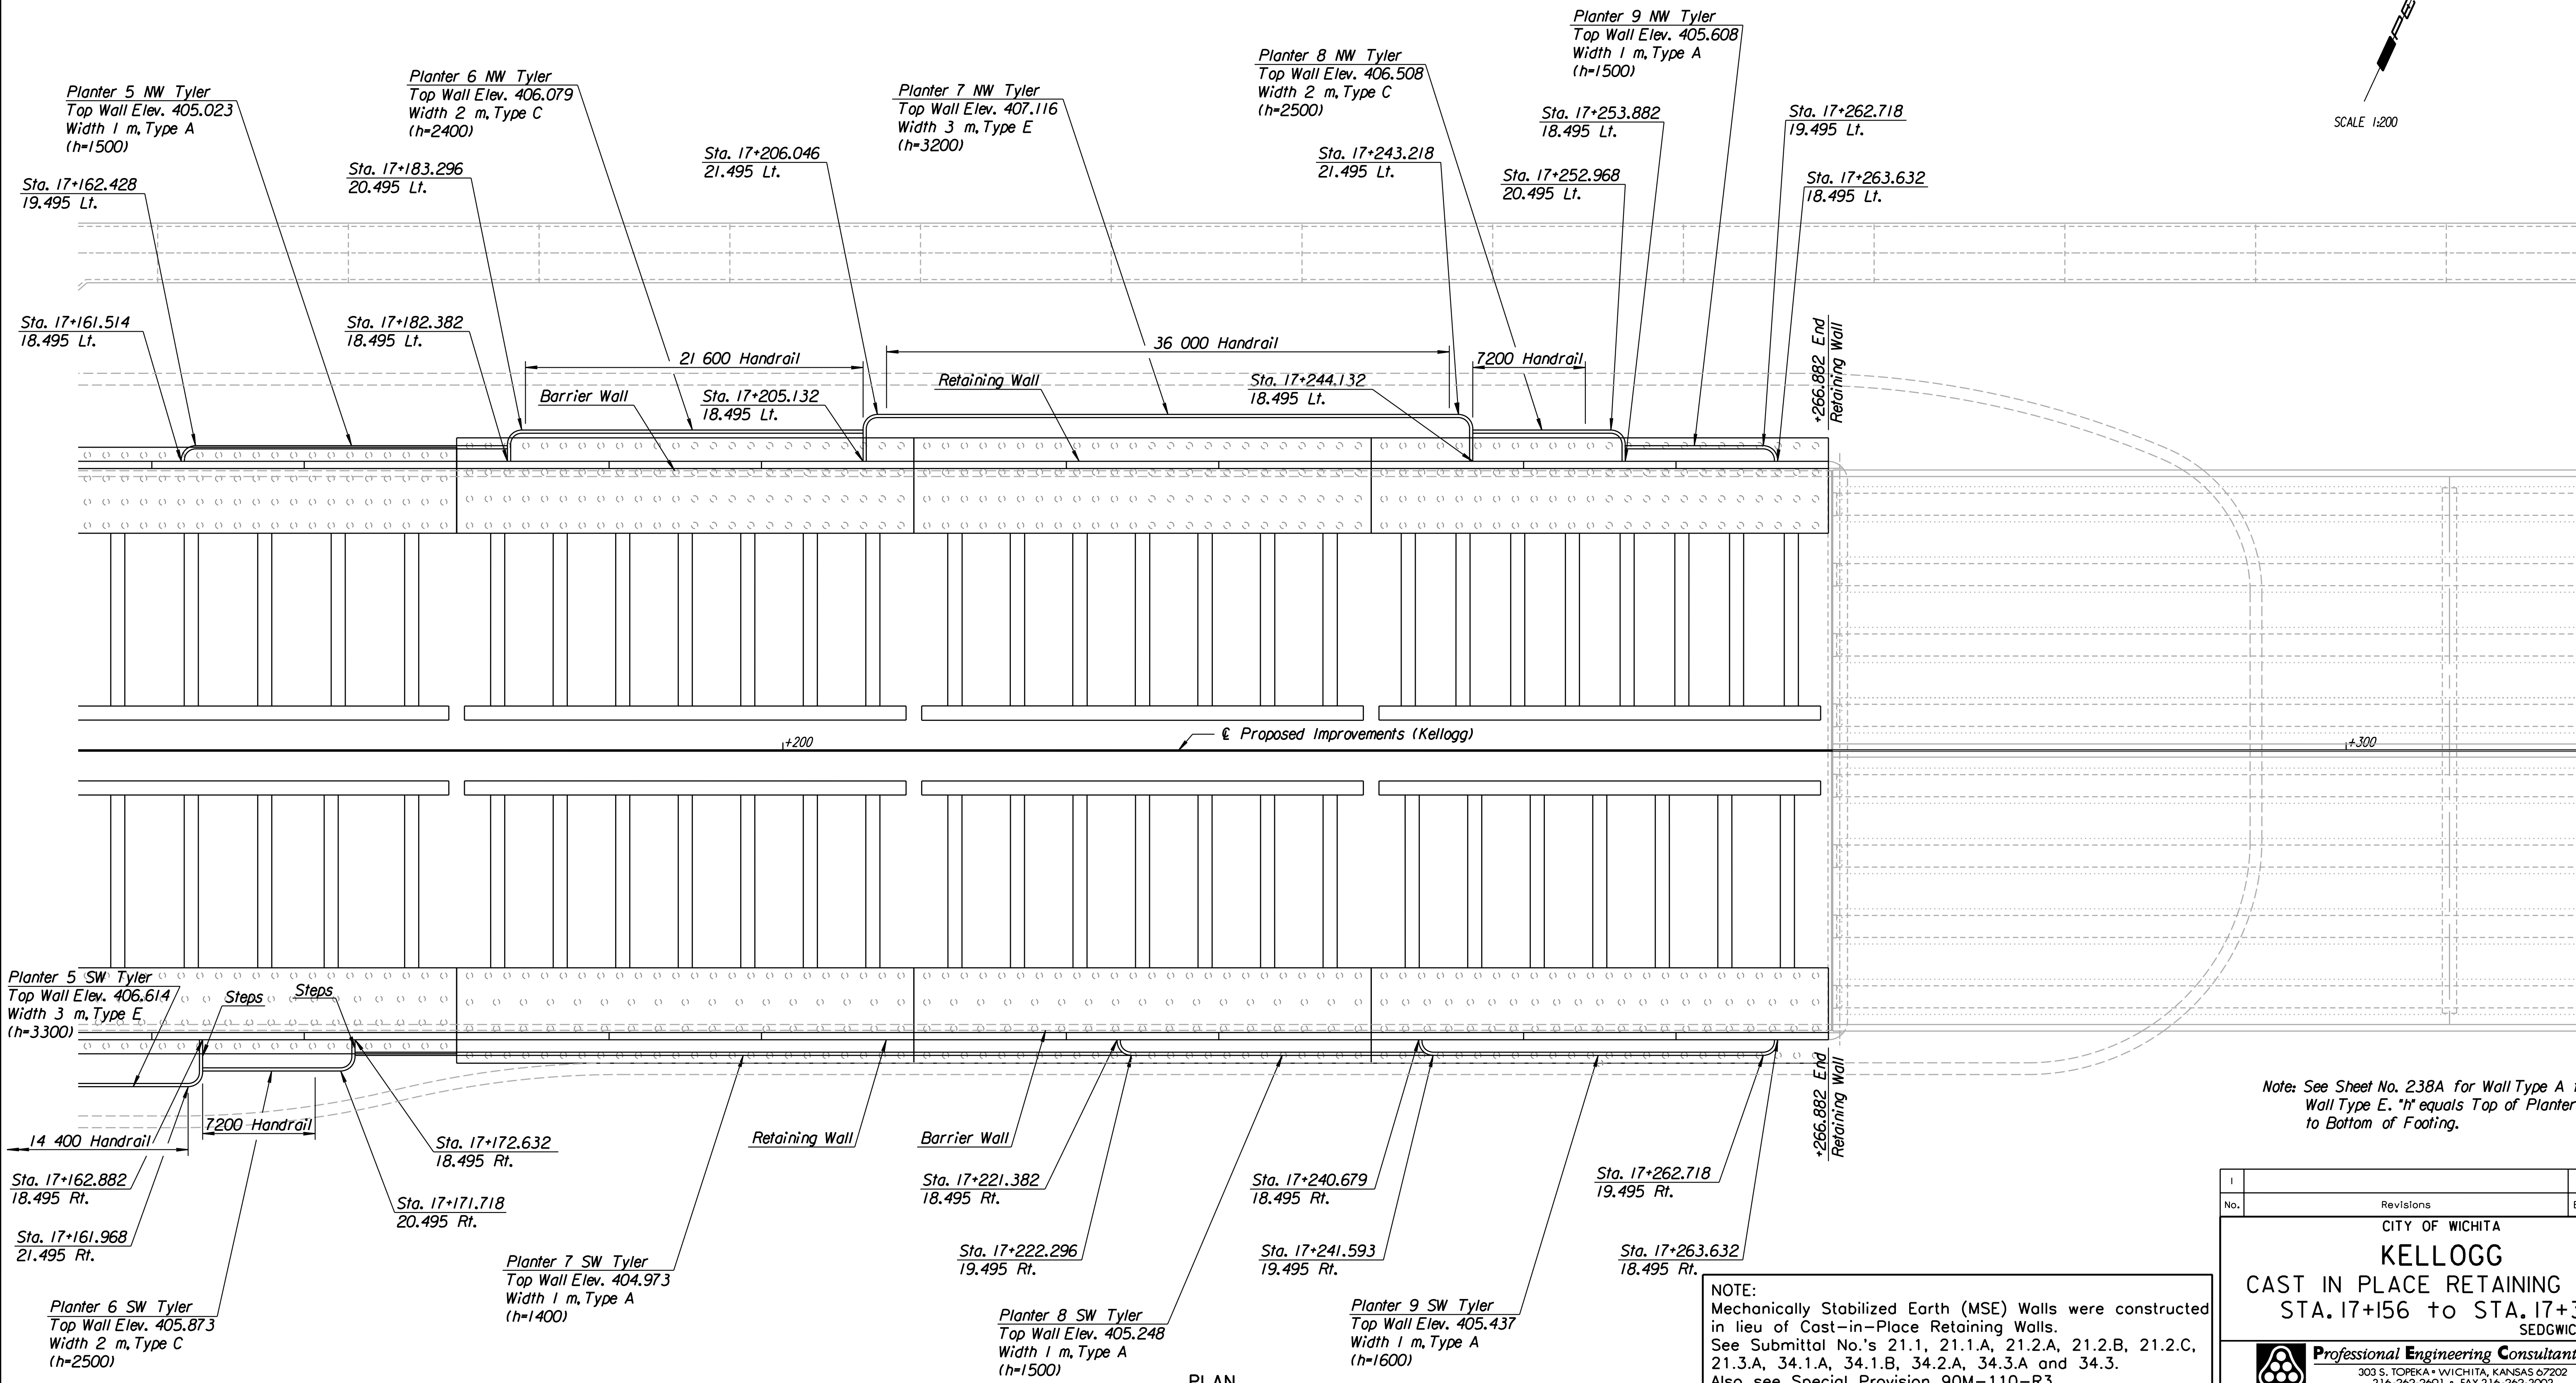

DSWR: PDF OPER: DRP SCALE: 1:200  
 i:/1997/97362/As-Builts/dgn's/Vol 2/Sh 247-plantwall8.dgn Last Rev: 8-22-07 By: gdr

Note: See Sheet No. 238A for Wall Type A thru Wall Type E. "h" equals Top of Planter Wall to Bottom of Footing.

NOTE:  
 Mechanically Stabilized Earth (MSE) Walls were constructed in lieu of Cast-in-Place Retaining Walls.  
 See Submittal No.'s 21.1, 21.1.A, 21.2.A, 21.2.B, 21.2.C, 21.3.A, 34.1.A, 34.1.B, 34.2.A, 34.3.A and 34.3.  
 Also see Special Provision 90M-110-R3.

Revisions		By	Date
No.			
CITY OF WICHITA			
<b>KELLOGG</b>			
CAST IN PLACE RETAINING WALL			
STA. 17+156 to STA. 17+315			
SEDGWICK COUNTY			
<b>Professional Engineering Consultants, P.A.</b>			
<small>303 S. TOPEKA • WICHITA, KANSAS 67202 316-262-2691 • FAX 316-262-3003</small>			
Designed by	PDF	Checked by	RAS
Drawn by	DRP	Date	April, 2002
		Job No.	97362

**RECORD DRAWING**

PLAN