



STATE	PROJECT NO.	YEAR	SHEET NO.	TOTAL SHEETS
KANSAS	54-87 K-6657-01	2002	377	1122

DATE	BY	REFERENCES NOTED	REFERENCES CHECKED

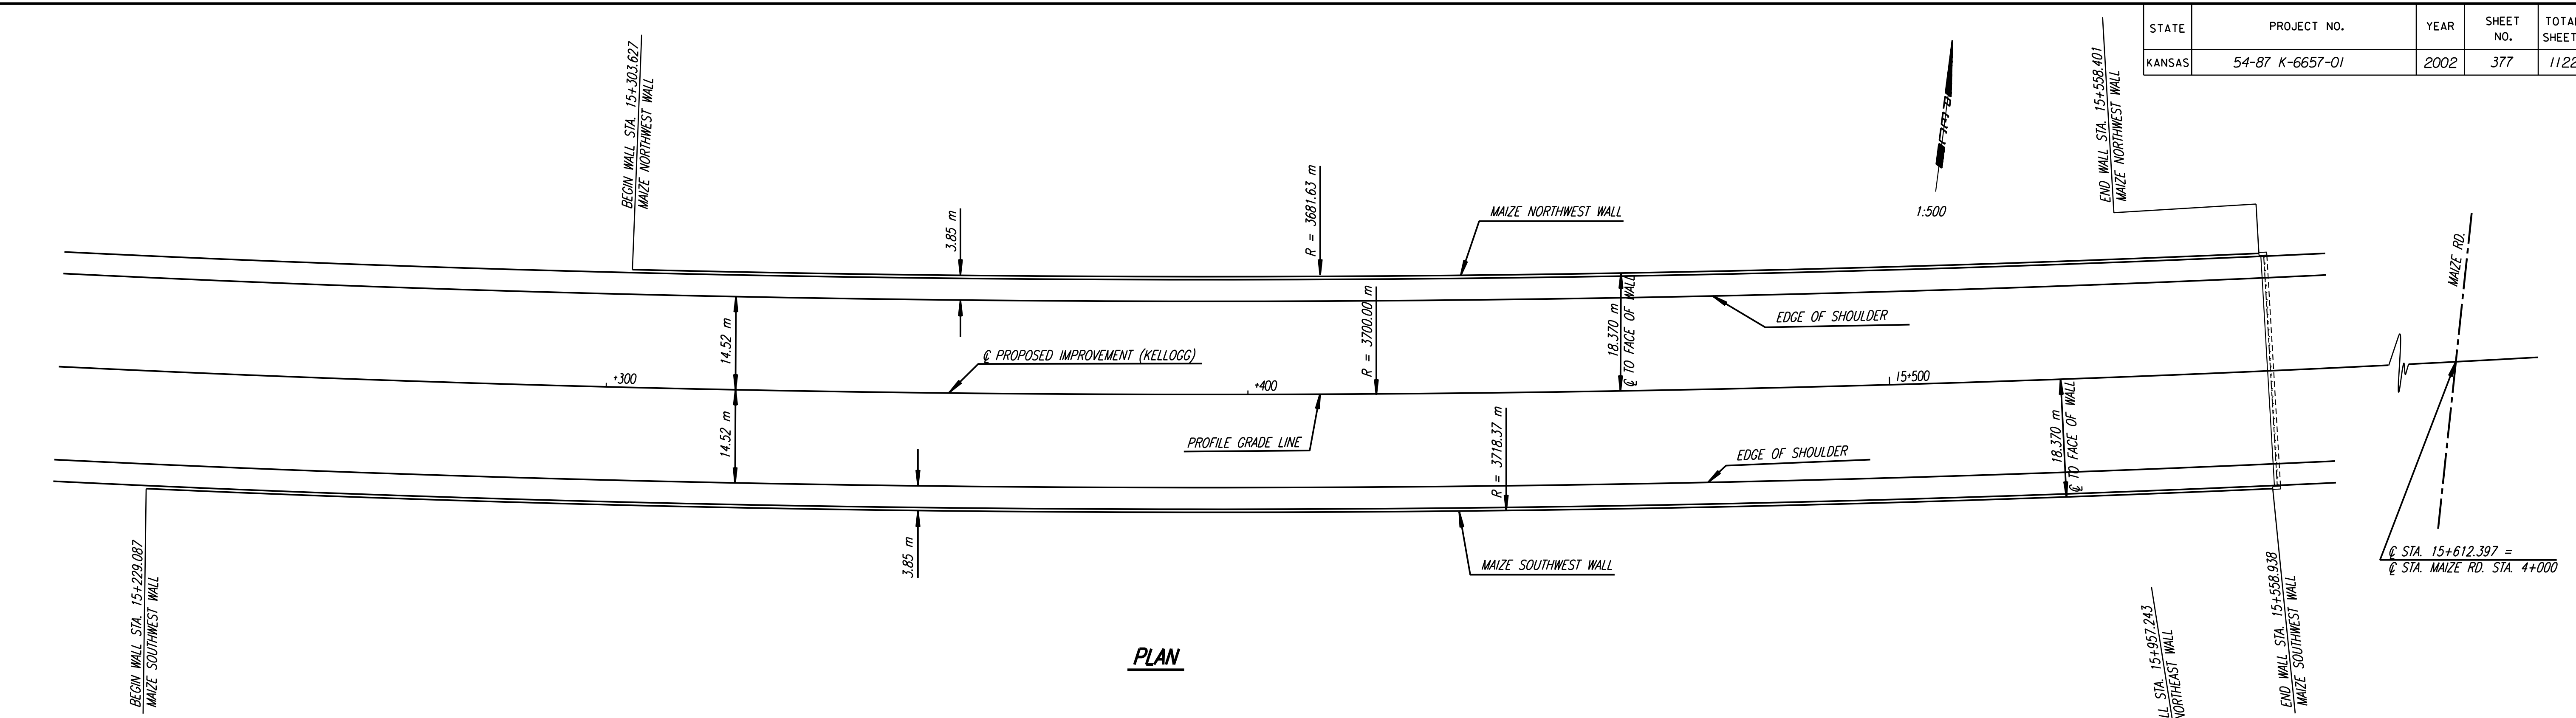

PLAN

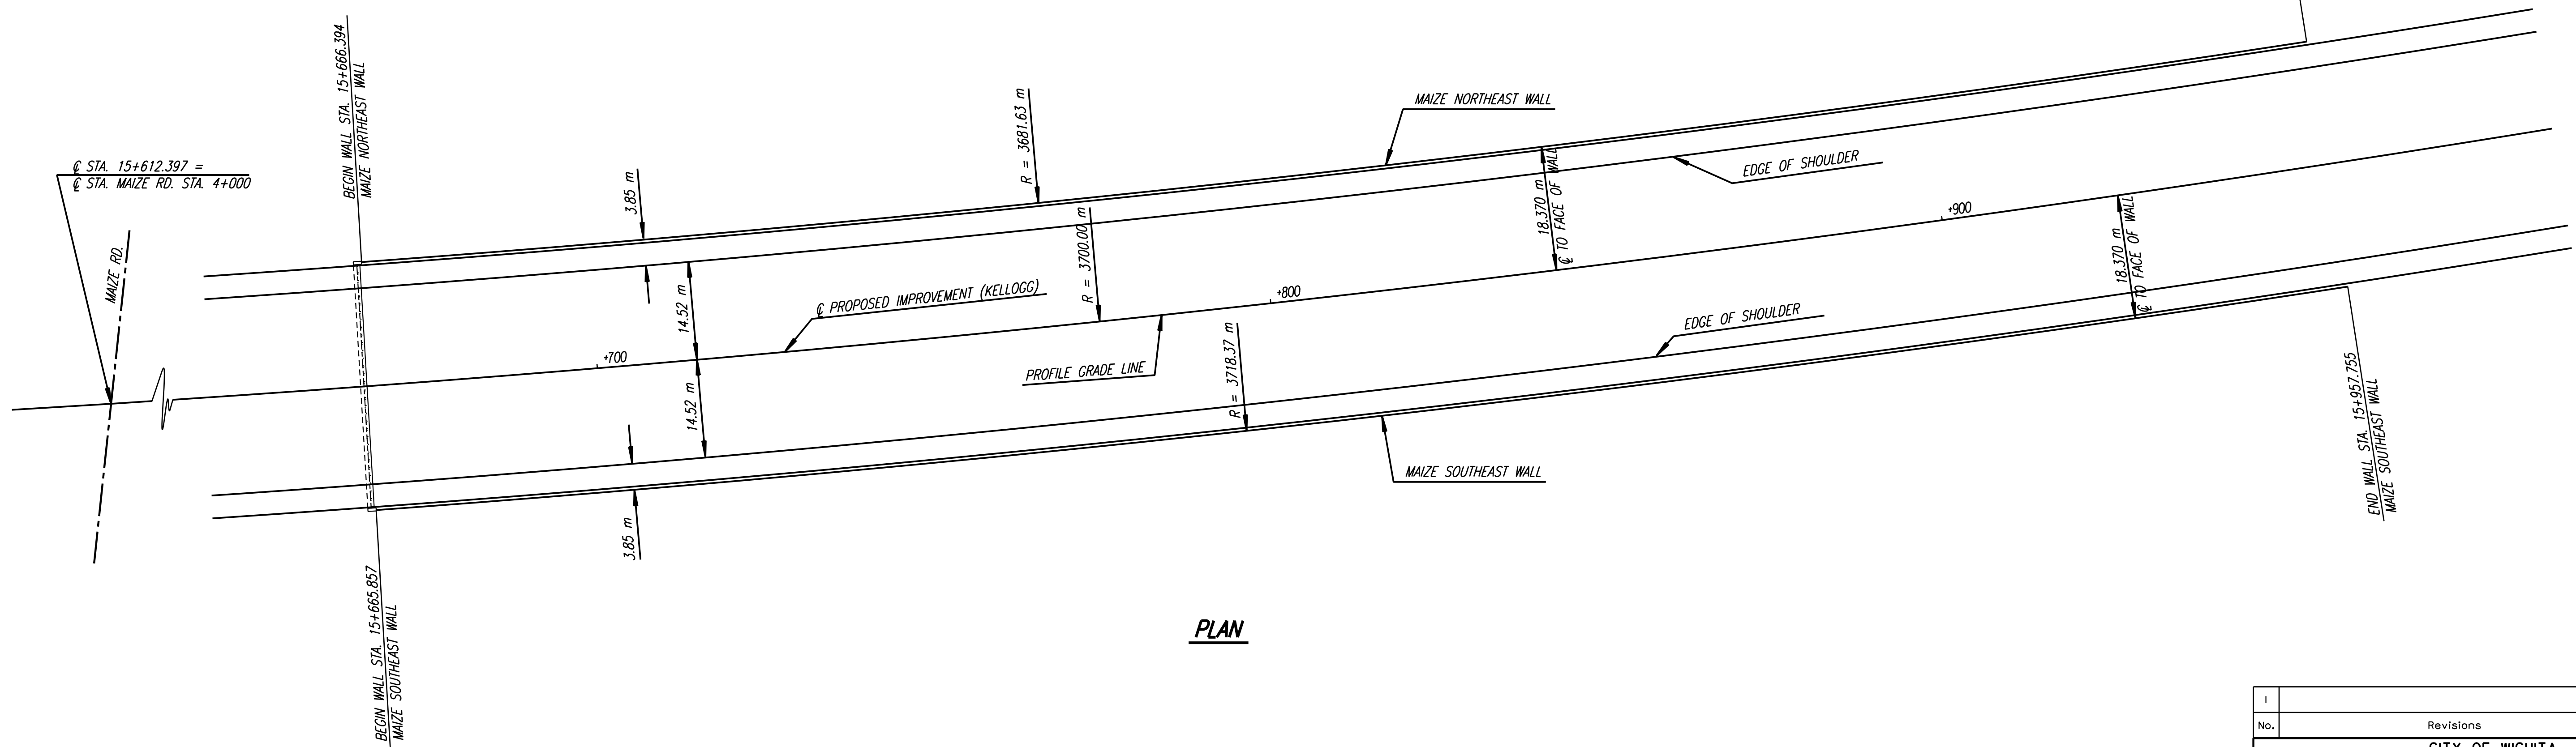

PLAN

STATIONS SHOWN ARE PROPOSED @ KELLOGG UNLESS NOTED OTHERWISE.

RECORD DRAWING

DSMR: WDH OPER: JCP SCALE: 1:500
 i:/1997/97362/As-Builts/dgn's/Vol 2/Sh 377--Retwall--Maizewest plan.dgn Last Rev: 8-24-07 By: gdr

No.	Revisions	By	Date

CITY OF WICHITA
MECHANICALLY STABILIZED EARTH WALLS
 PLAN MAIZE WALLS
 SEDGWICK COUNTY

Professional Engineering Consultants, P.A.
 303 S. TOPEKA • WICHITA, KANSAS 67202
 316-262-2691 • FAX 316-262-3003

Designed by	RWM	Checked by	WDH
Drawn by	JSB	Date	April, 2002
		Job No.	97362