
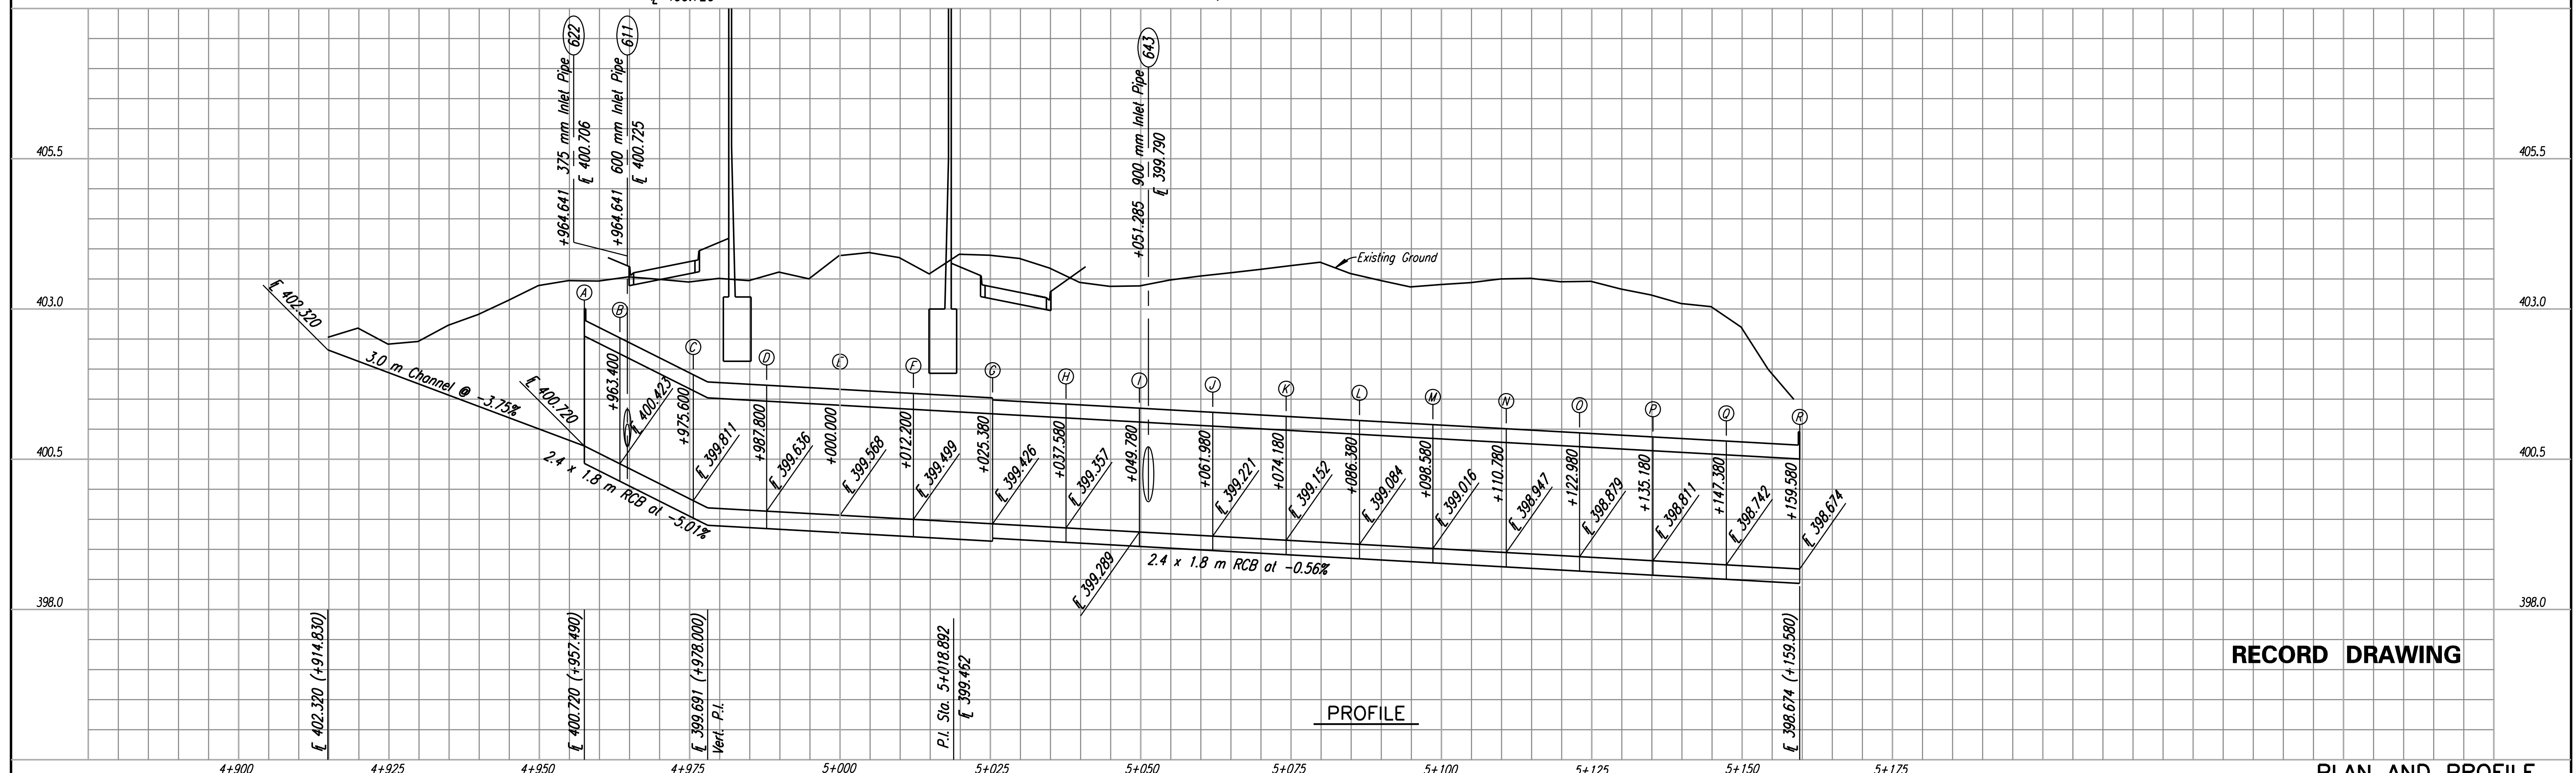


STATE	PROJECT NO.	YEAR	SHEET NO.	TOTAL SHEETS
KANSAS	54-87 K-6657-01	2002	400	1122

DATE	
BY	
REFERENCES NOTED	
REFERENCES CHECKED	

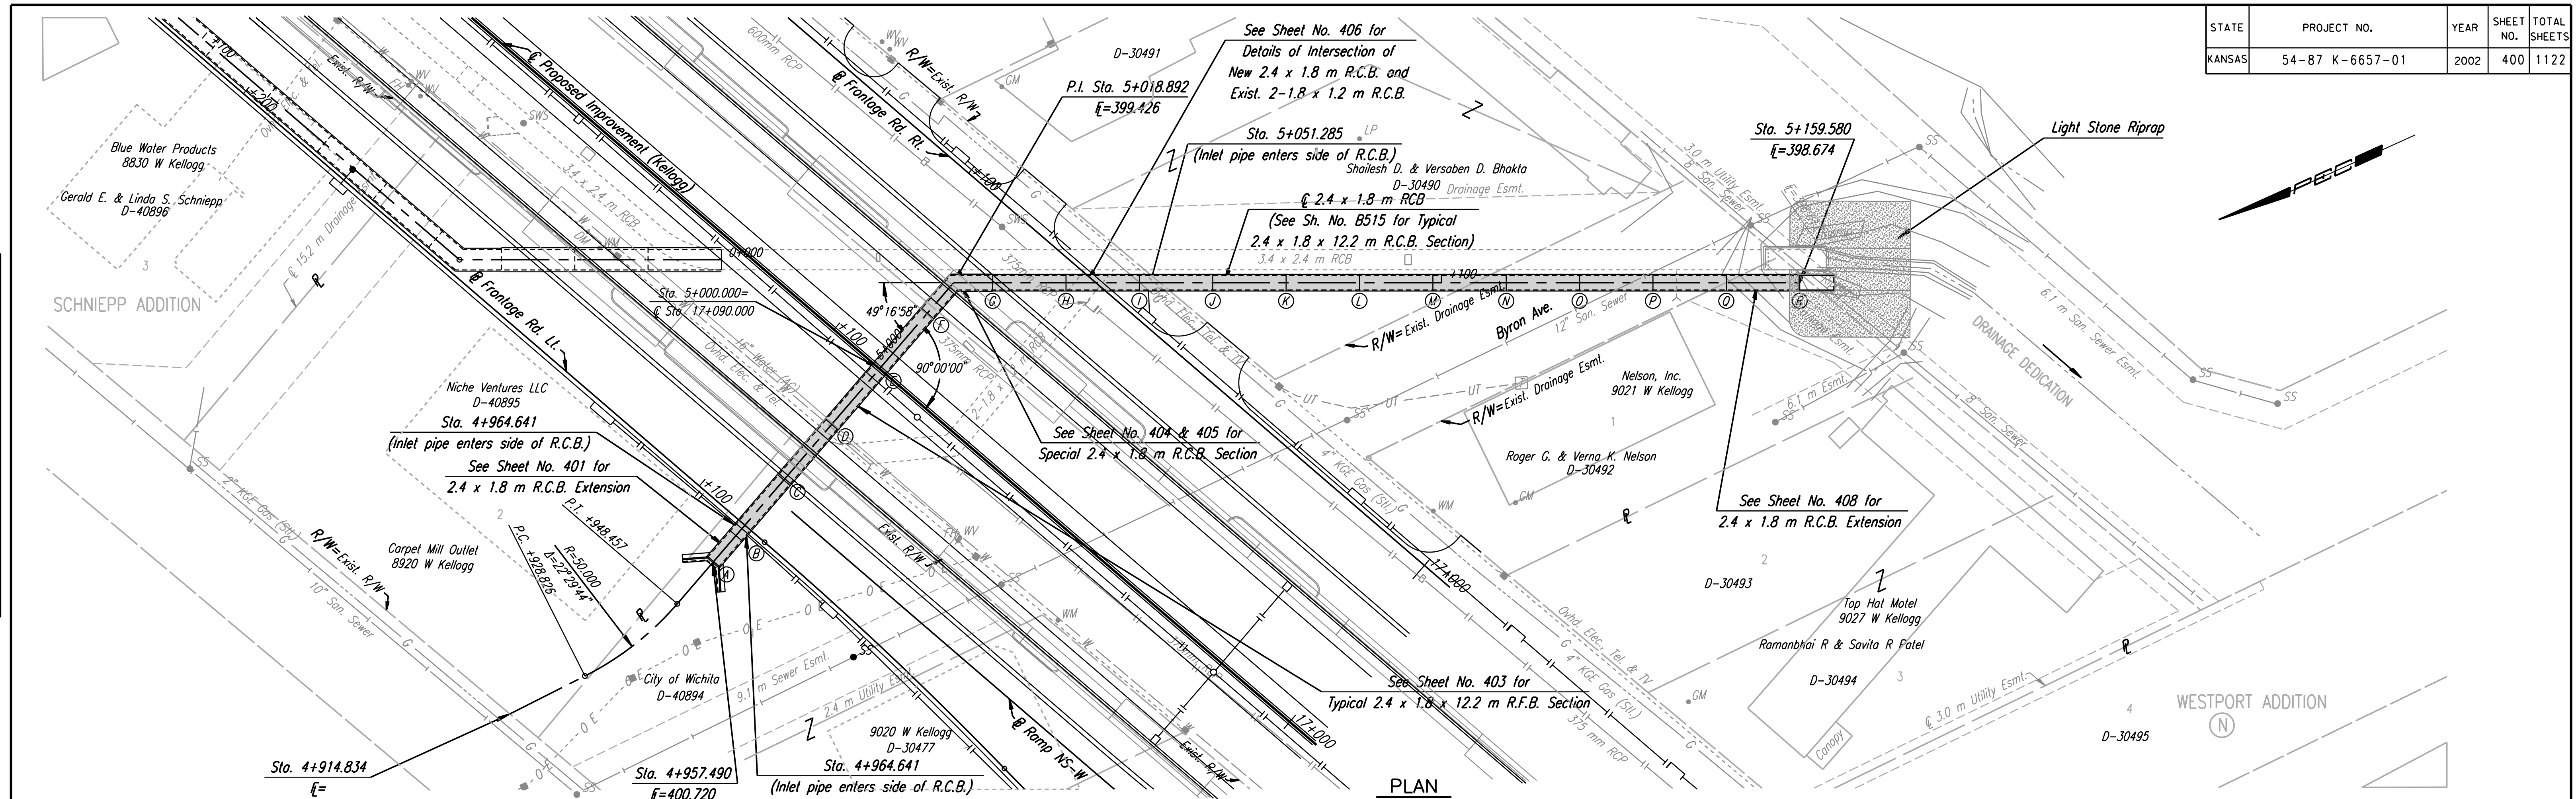

RECORD DRAWING

**PLAN AND PROFILE
2.4 x 1.8 m R.F.B.**

DSNR: RWA OPER: GDR SCALE: 1:500
 t:/1997/97162/As-Built/dgn/NoL_2/54-400-RCB171.dgn Last Rev.: 8-28-07 By: gdr