


STATE	PROJECT NO.	YEAR	SHEET NO.	TOTAL SHEETS
KANSAS	54-87 K-6657-01	2002	421	1122

BY	DATE


REFERENCES NOTED	REFERENCES CHECKED

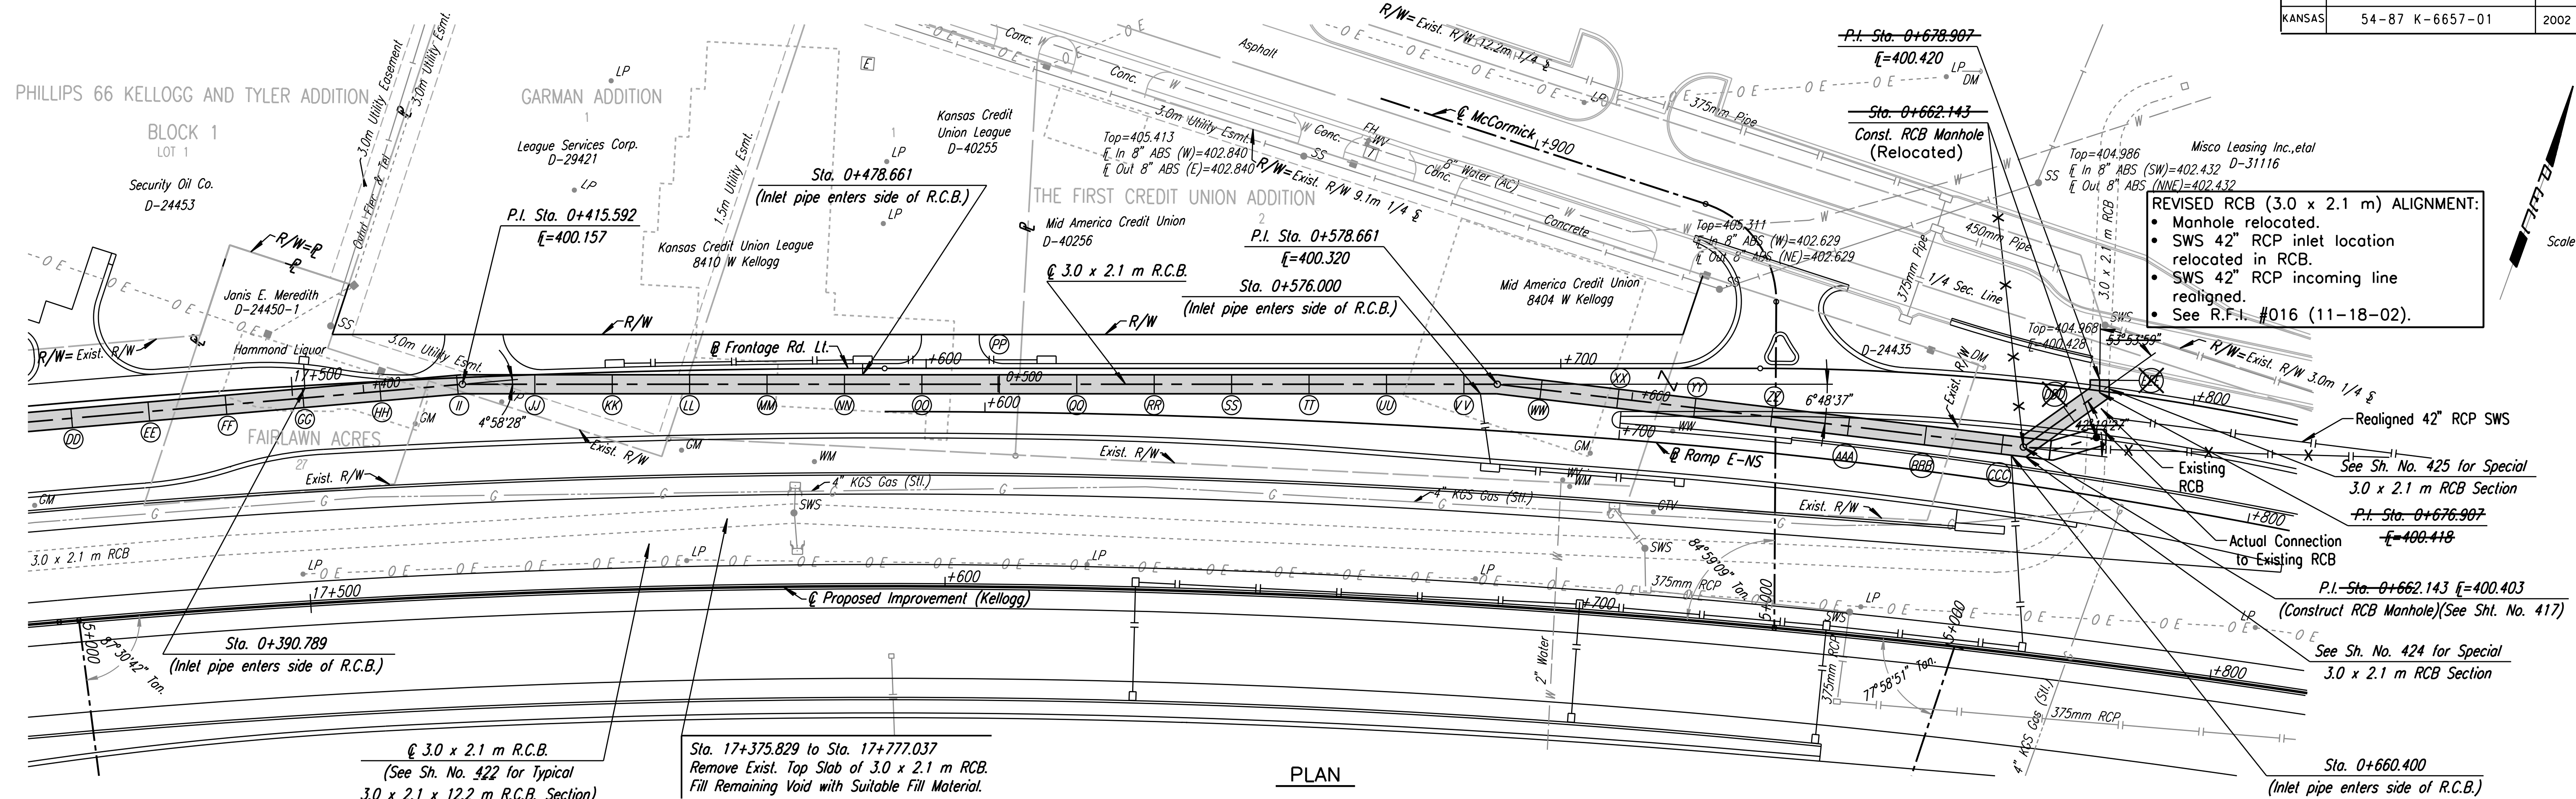

- REVISED RCB (3.0 x 2.1 m) ALIGNMENT:**
- Manhole relocated.
 - SWS 42" RCP inlet location relocated in RCB.
 - SWS 42" RCP incoming line realigned.
 - See R.F.I. #016 (11-18-02).

Scale 1:500

PLAN

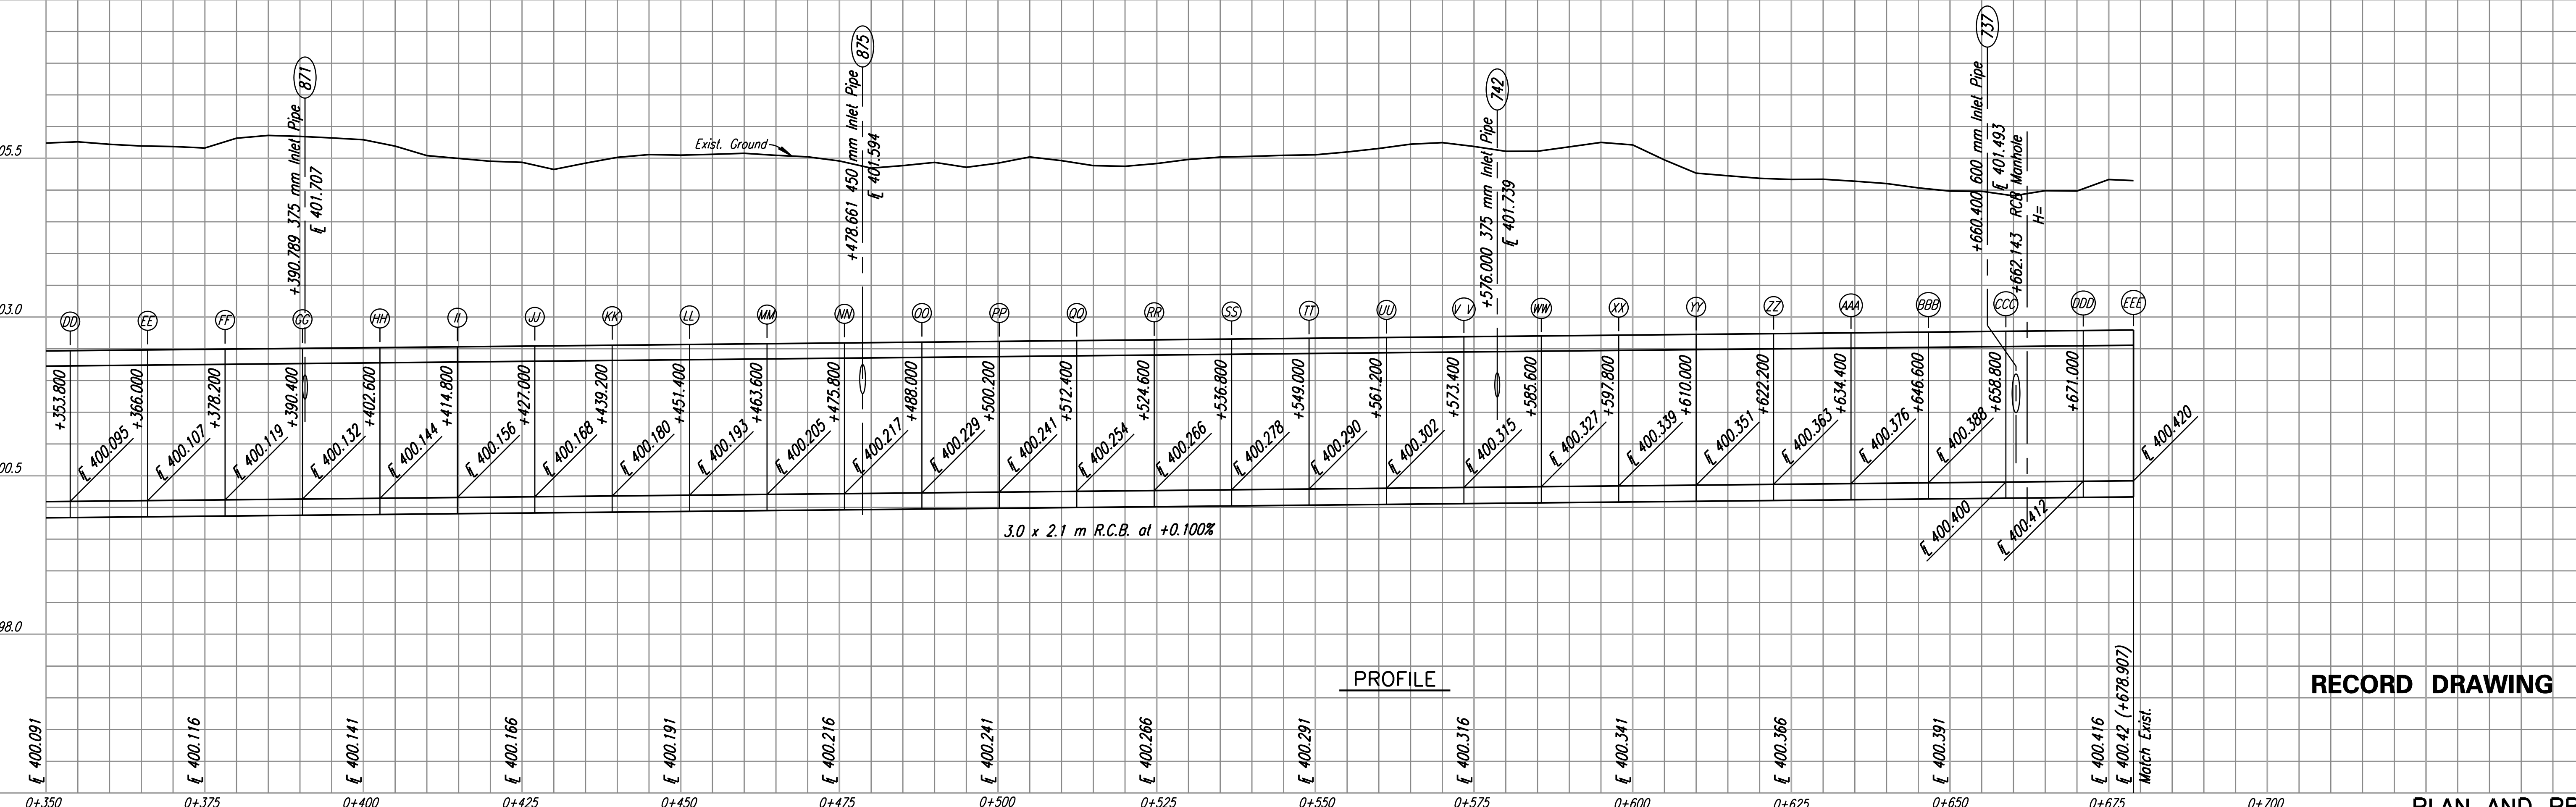

PROFILE

RECORD DRAWING

PLAN AND PROFILE
3.0 x 2.1 m R.C.B.

OPER: GDR SCALE: 1:500
 1/1997/97362/As-Built/dgn/NoL_2/54_421-RCB10x7.dgn Last Rev.: 8-29-07 By: gar