



STATE	PROJECT NO.	YEAR	SHEET NO.	TOTAL SHEETS
KANSAS	54-87 K-6657-01	2002	368	1122

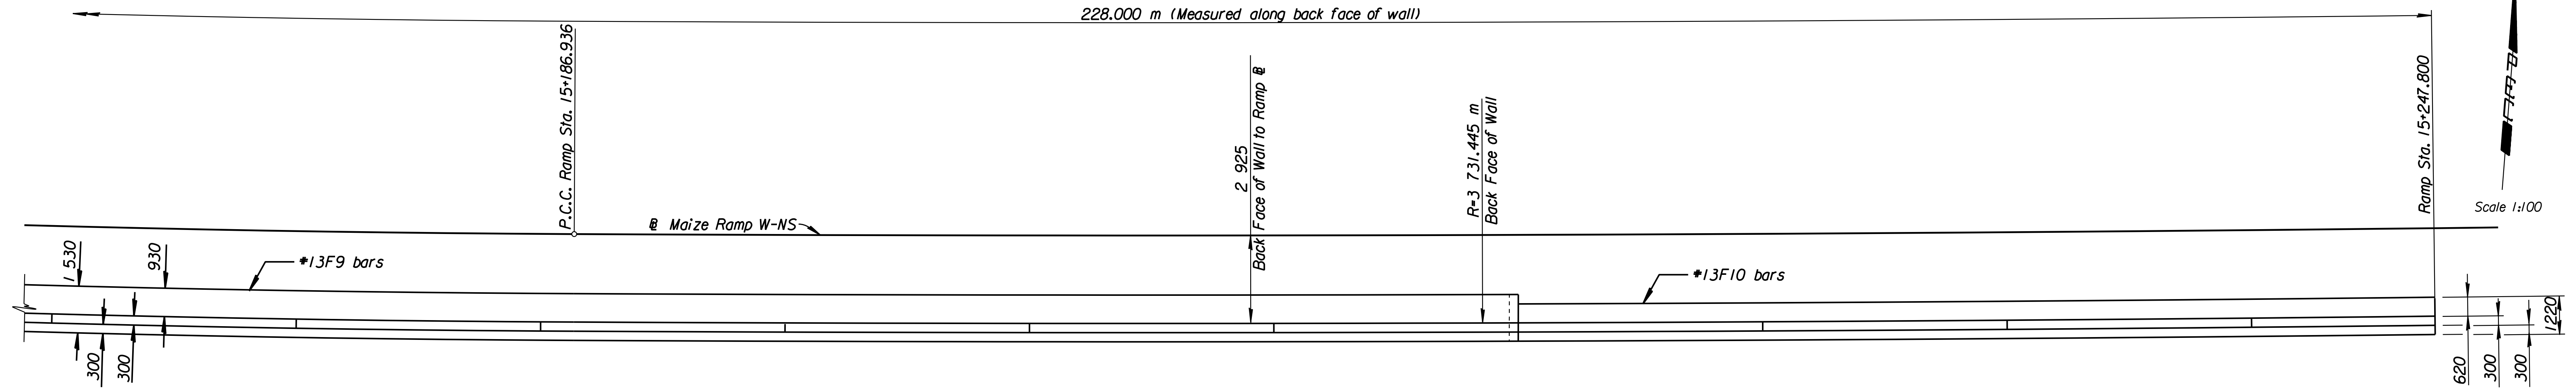

PLAN

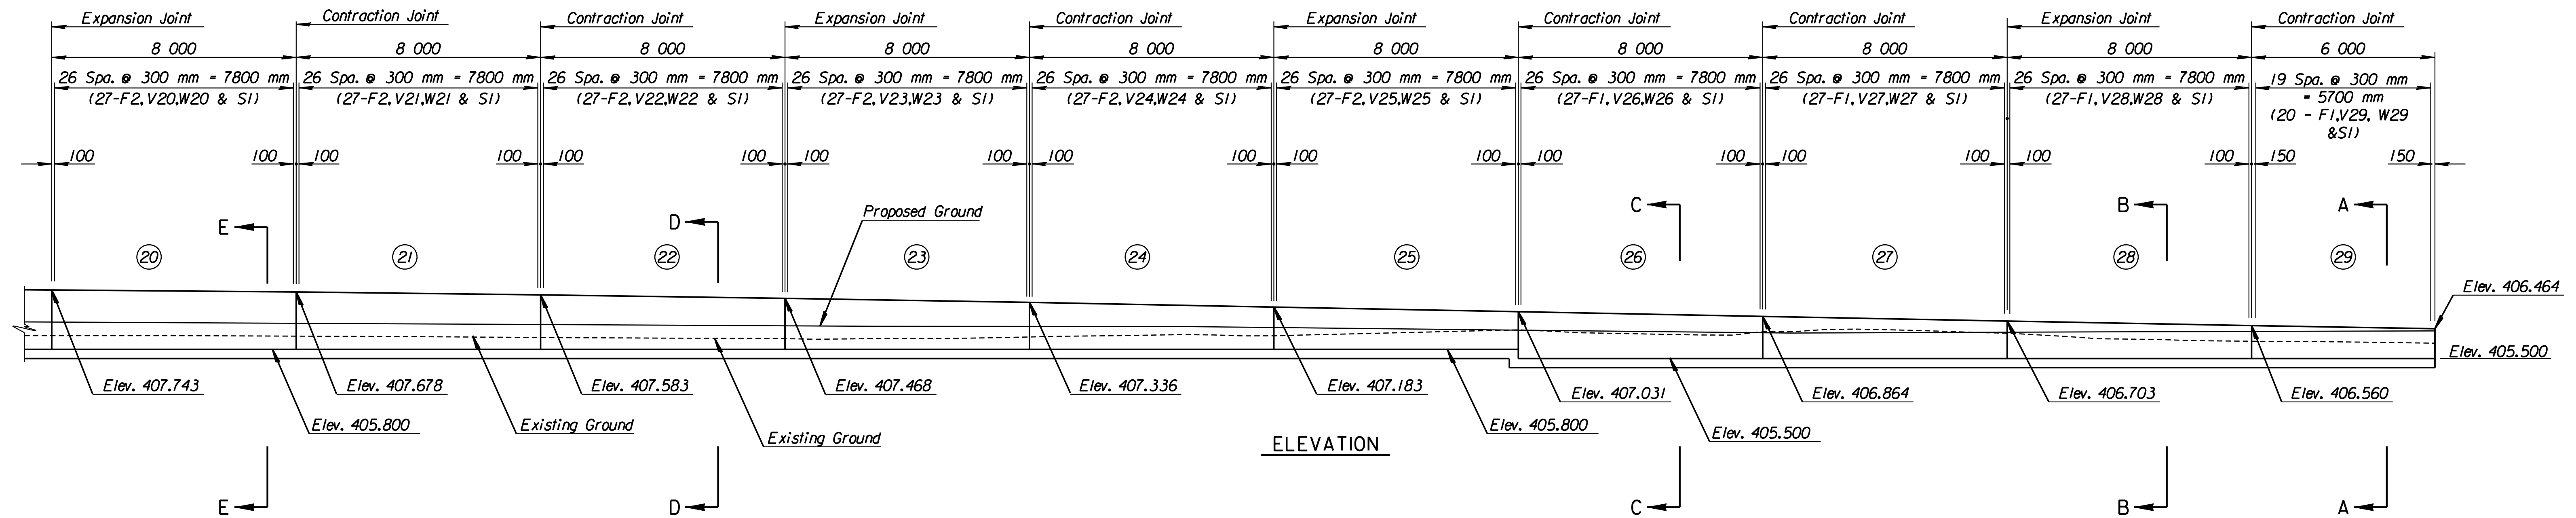

ELEVATION

Plotted By: svb 3-25-02
 L:\1997\37362\As-Builts\agr\1.s\Vol 2\Sh 368-wall_9.dgn Last Rev: 8-24-07 By: gdr

RECORD DRAWING

1			
No.	Revisions	By	Date
CITY OF WICHITA			
RETAINING WALL #9			
STA. 15+170 TO STA. 15+248			
SEDGWICK COUNTY			
Professional Engineering Consultants, P.A. 303 S. TOPEKA • WICHITA, KANSAS 67202 316-262-2691 • FAX 316-262-3003			
Designed by	SET	Checked by	RAS
Drawn by	DWK	Date	April, 2002
		Job No.	97362