




STATE	PROJECT NO.	YEAR	SHEET NO.	TOTAL SHEETS
KANSAS	54-87 K-6657-01	2002	371	1122

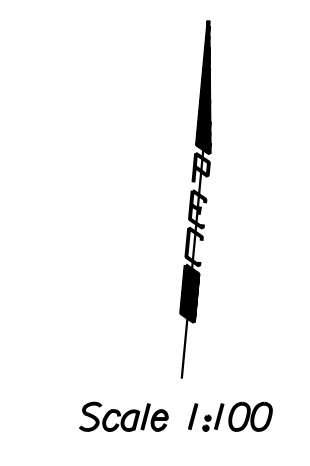

DATE	
BY	
REFERENCES NOTED	
REFERENCES CHECKED	

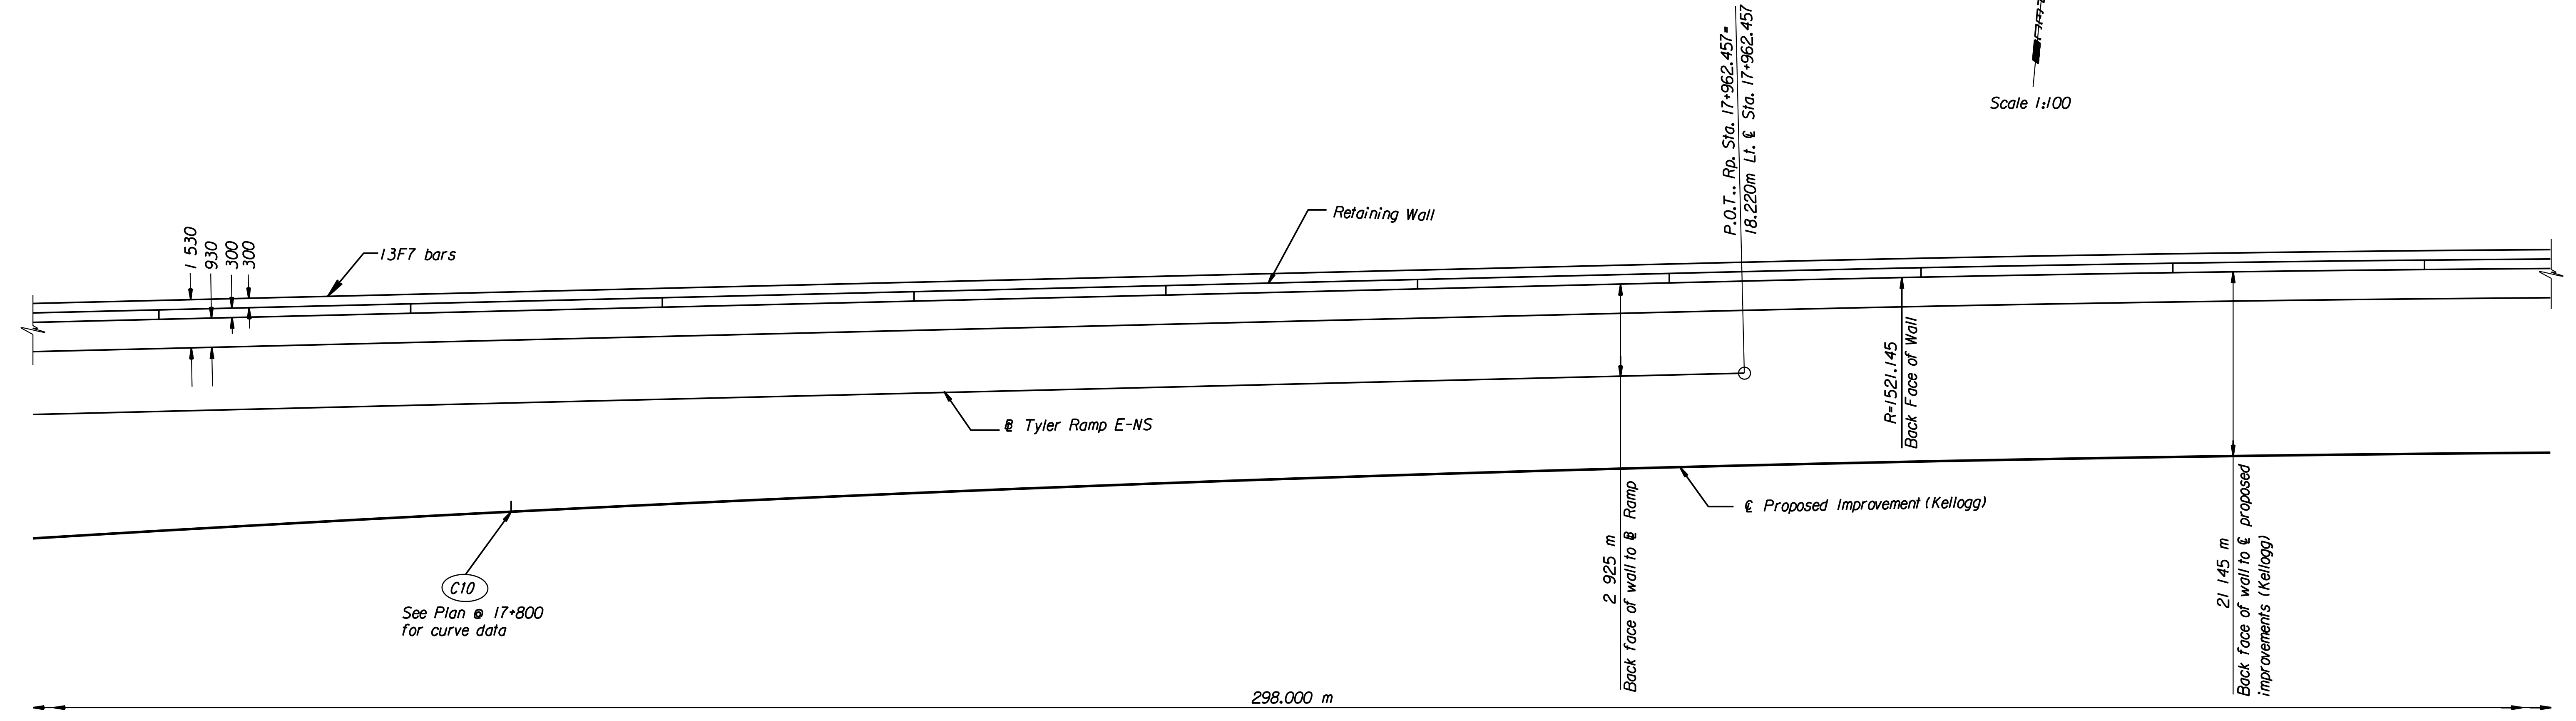

PLAN

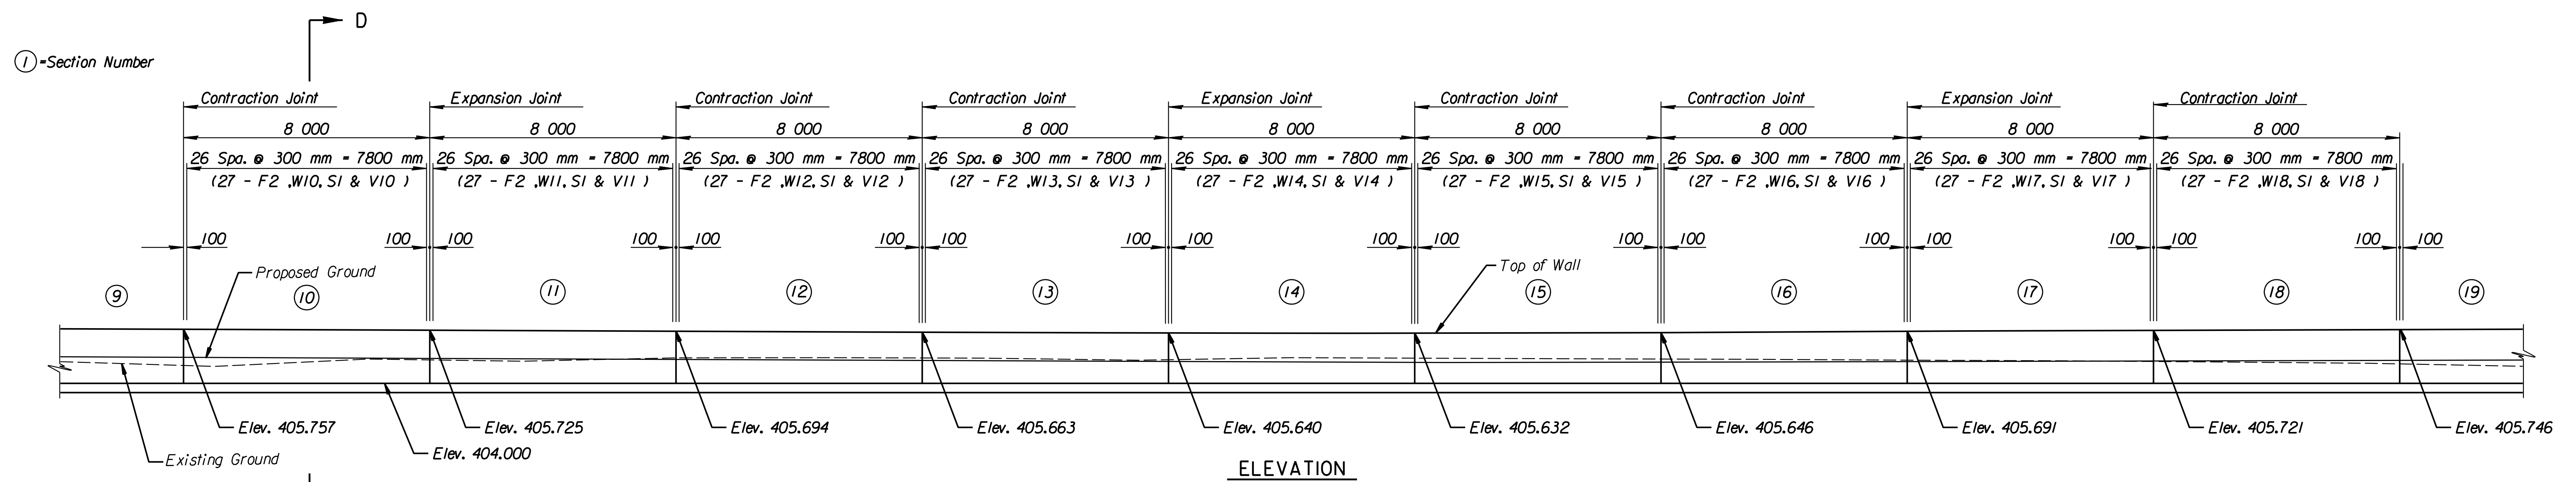

ELEVATION

DSWR: SET OPER: JGP SCALE: 1:100  
 i:/1997/97362/As-Builts/dgn's/Vol 2/Sh 371-wal\_10.dgn Last Rev: 8-24-07 By: gdr

**RECORD DRAWING**

No.	Revisions	By	Date
CITY OF WICHITA <b>RETAINING WALL #10</b> STA. 17+912 TO STA. 17+984 SEDGWICK COUNTY			
<b>Professional Engineering Consultants, P.A.</b> <small>303 S. TOPEKA • WICHITA, KANSAS 67202          316-262-2691 • FAX 316-262-3003</small>			
Designed by	SET	Checked by	RAS
Drawn by	DWK	Date	April, 2002
		Job No.	97362