



STATE	PROJECT NO.	YEAR	SHEET NO.	TOTAL SHEETS
KANSAS	54-87 K-6657-01	2002	372	1122

Scale 1:100

DATE	
BY	
REFERENCES NOTED	
REFERENCES CHECKED	

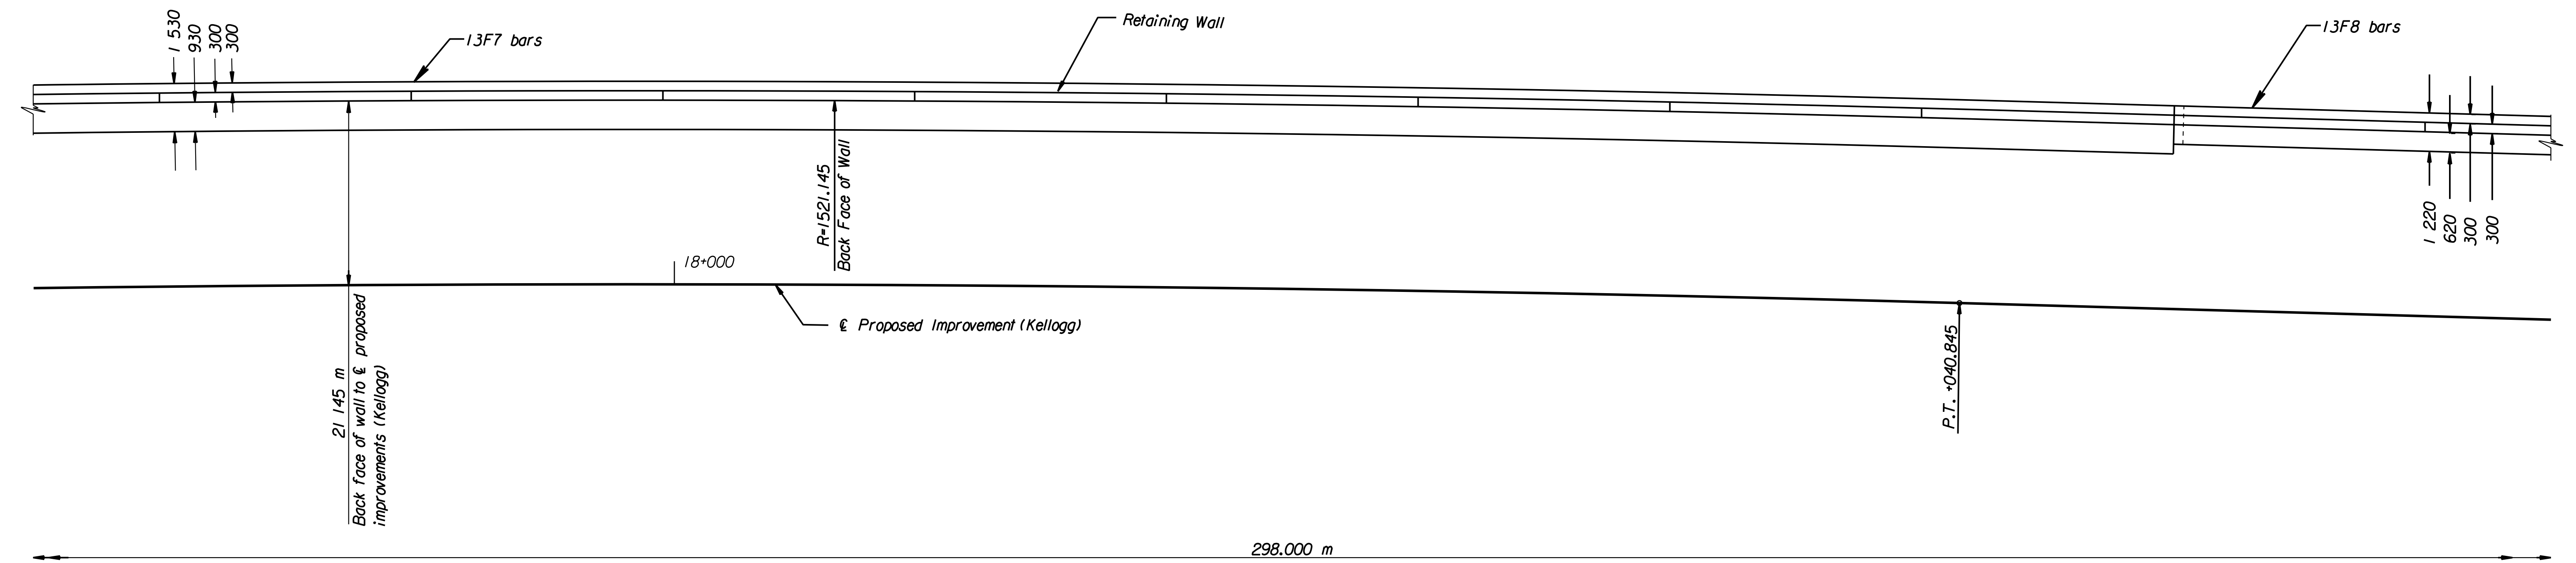

PLAN

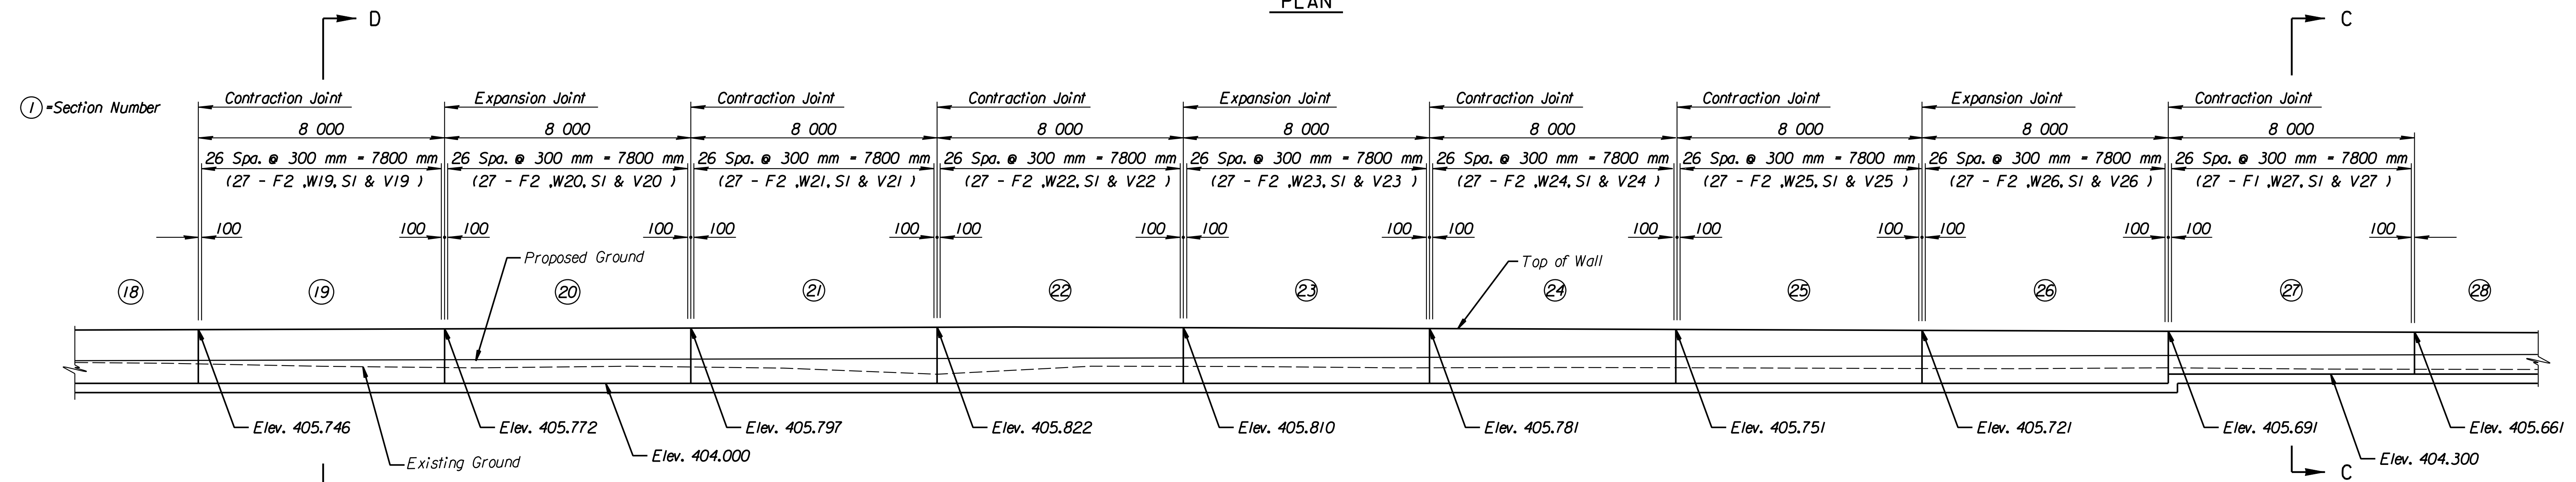

ELEVATION

DSNR: SET OPER: JGP SCALE: 1:100  
 i:/1997/97362/As-Builts/dgn's/Vol 2/Sh 372-wall\_10.dgn Last Rev: 8-24-07 By: gdr

No.	Revisions	By	Date
CITY OF WICHITA <b>RETAINING WALL #10</b> STA. 17+984 TO STA. 18+056 SEDGWICK COUNTY			
<b>Professional Engineering Consultants, P.A.</b> <small>303 S. TOPEKA • WICHITA, KANSAS 67202          316-262-2691 • FAX 316-262-3003</small>			
Designed by	SET	Checked by	RAS
Drawn by	DWK	Date	April, 2002
		Job No.	97362

**RECORD DRAWING**