

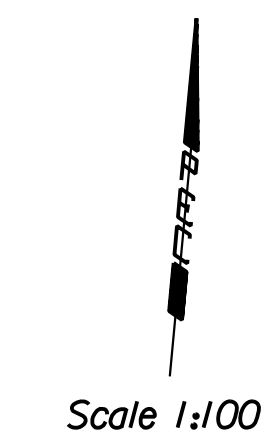


STATE	PROJECT NO.	YEAR	SHEET NO.	TOTAL SHEETS
KANSAS	54-87 K-6657-01	2002	373	1122

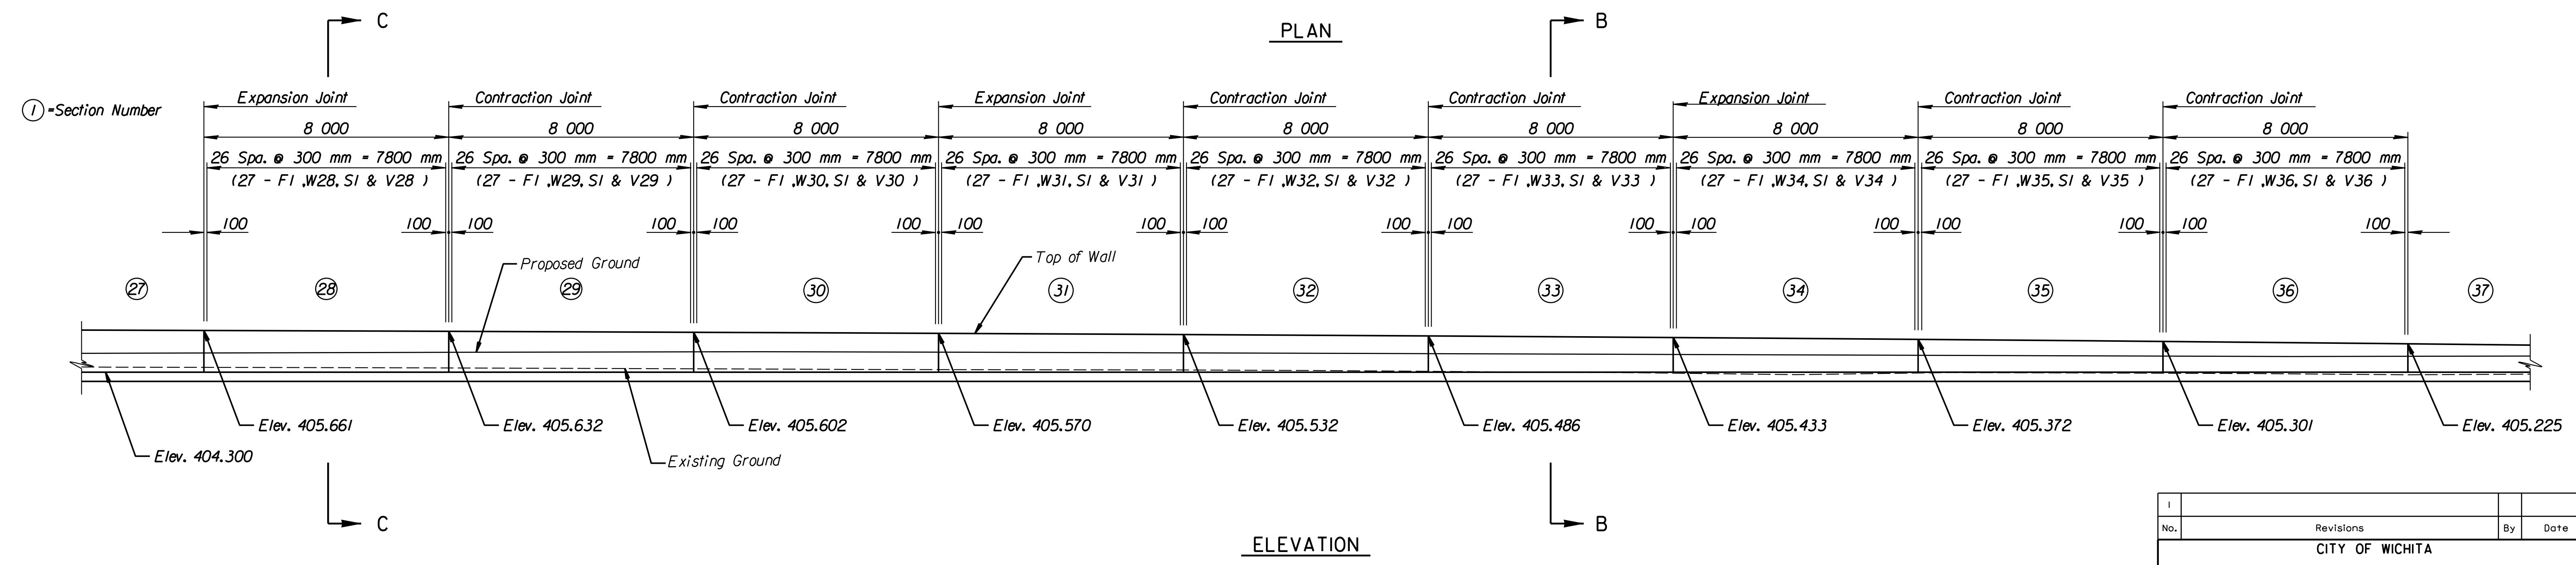

DATE	BY	REFERENCES NOTED	REFERENCES CHECKED

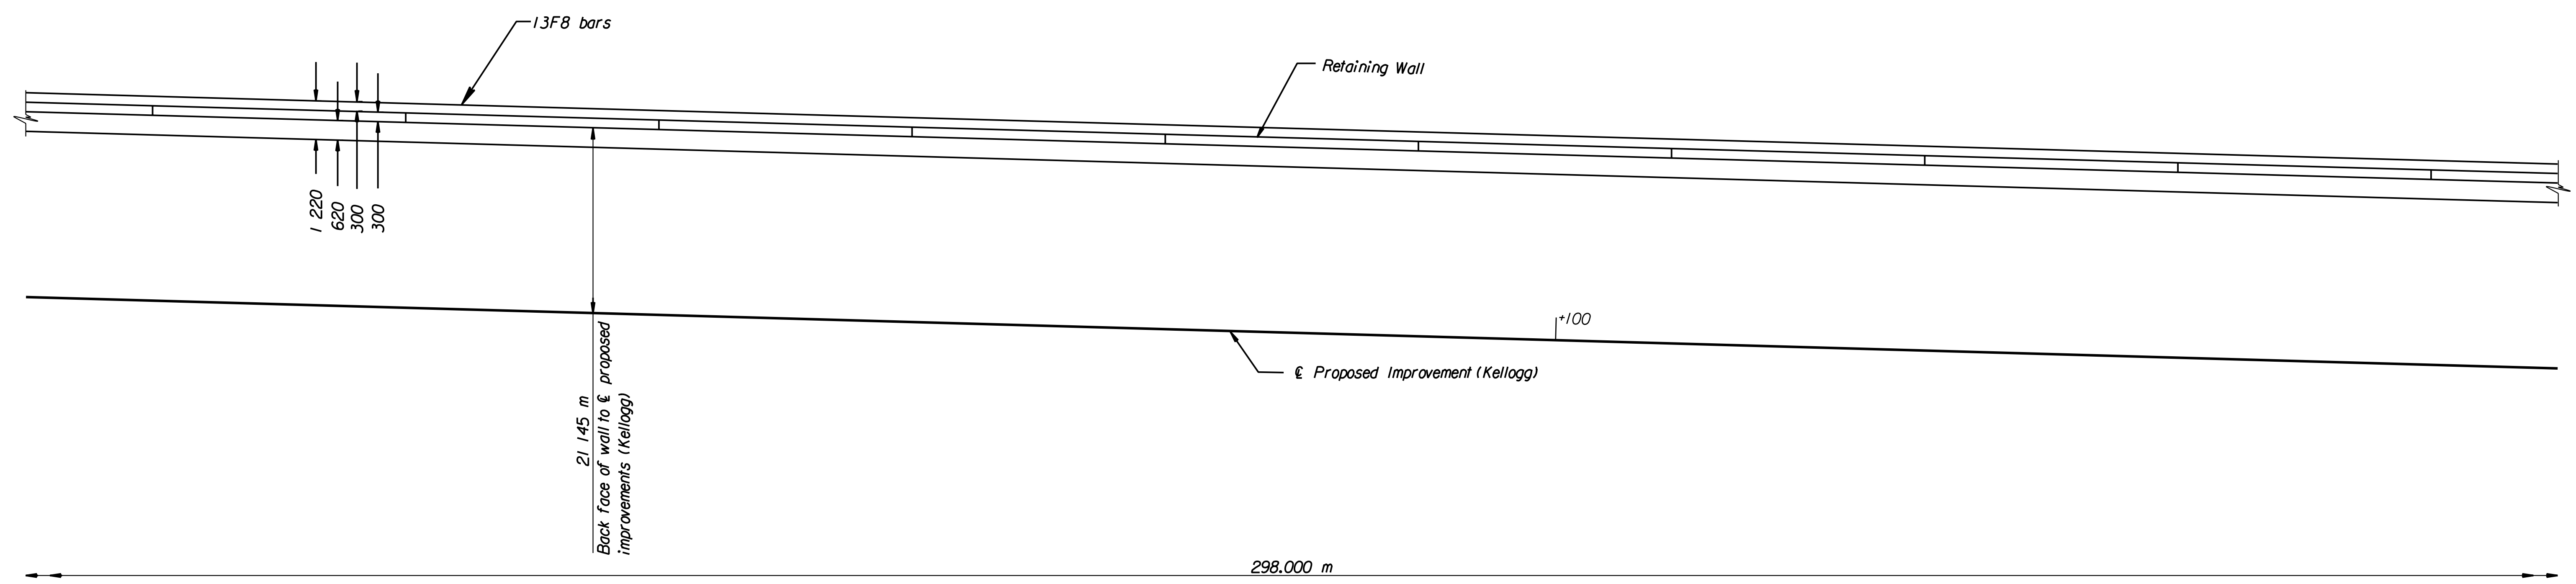

DSNR: SET OPER: JGP SCALE: 1:100  
 i:/1997/97362/As-Builts/dgn's/Val 2/Sh 373-wall 10.dgn Last Rev: 8-24-07 By: gdr

**RECORD DRAWING**

No.	Revisions	By	Date

CITY OF WICHITA

**RETAINING WALL #10**

STA. 18+056 TO STA. 18+128

SEDGWICK COUNTY

**Professional Engineering Consultants, P.A.**  
 303 S. TOPEKA • WICHITA, KANSAS 67202  
 316-262-2691 • FAX 316-262-3003

Designed by	SET	Checked by	RAS
Drawn by	DWK	Date	April, 2002    Job No. 97362