


FHWA REGION NO.	STATE	PROJECT NO.	YEAR	SHEET NO.	TOTAL SHEETS
7	KANSAS	54-87 K-6657-01	2002	378	1122

REFERENCES NOTED	BY	DATE
REFERENCES CHECKED		

DSNR: WDH OPER: JCP SCALE: 1:500  
 I:/1997/97362/As-Builts/dgn's/Vol 2/Sh 378-Retwall-MNW profile.dgn Last Rev: 8-24-07 By: gar

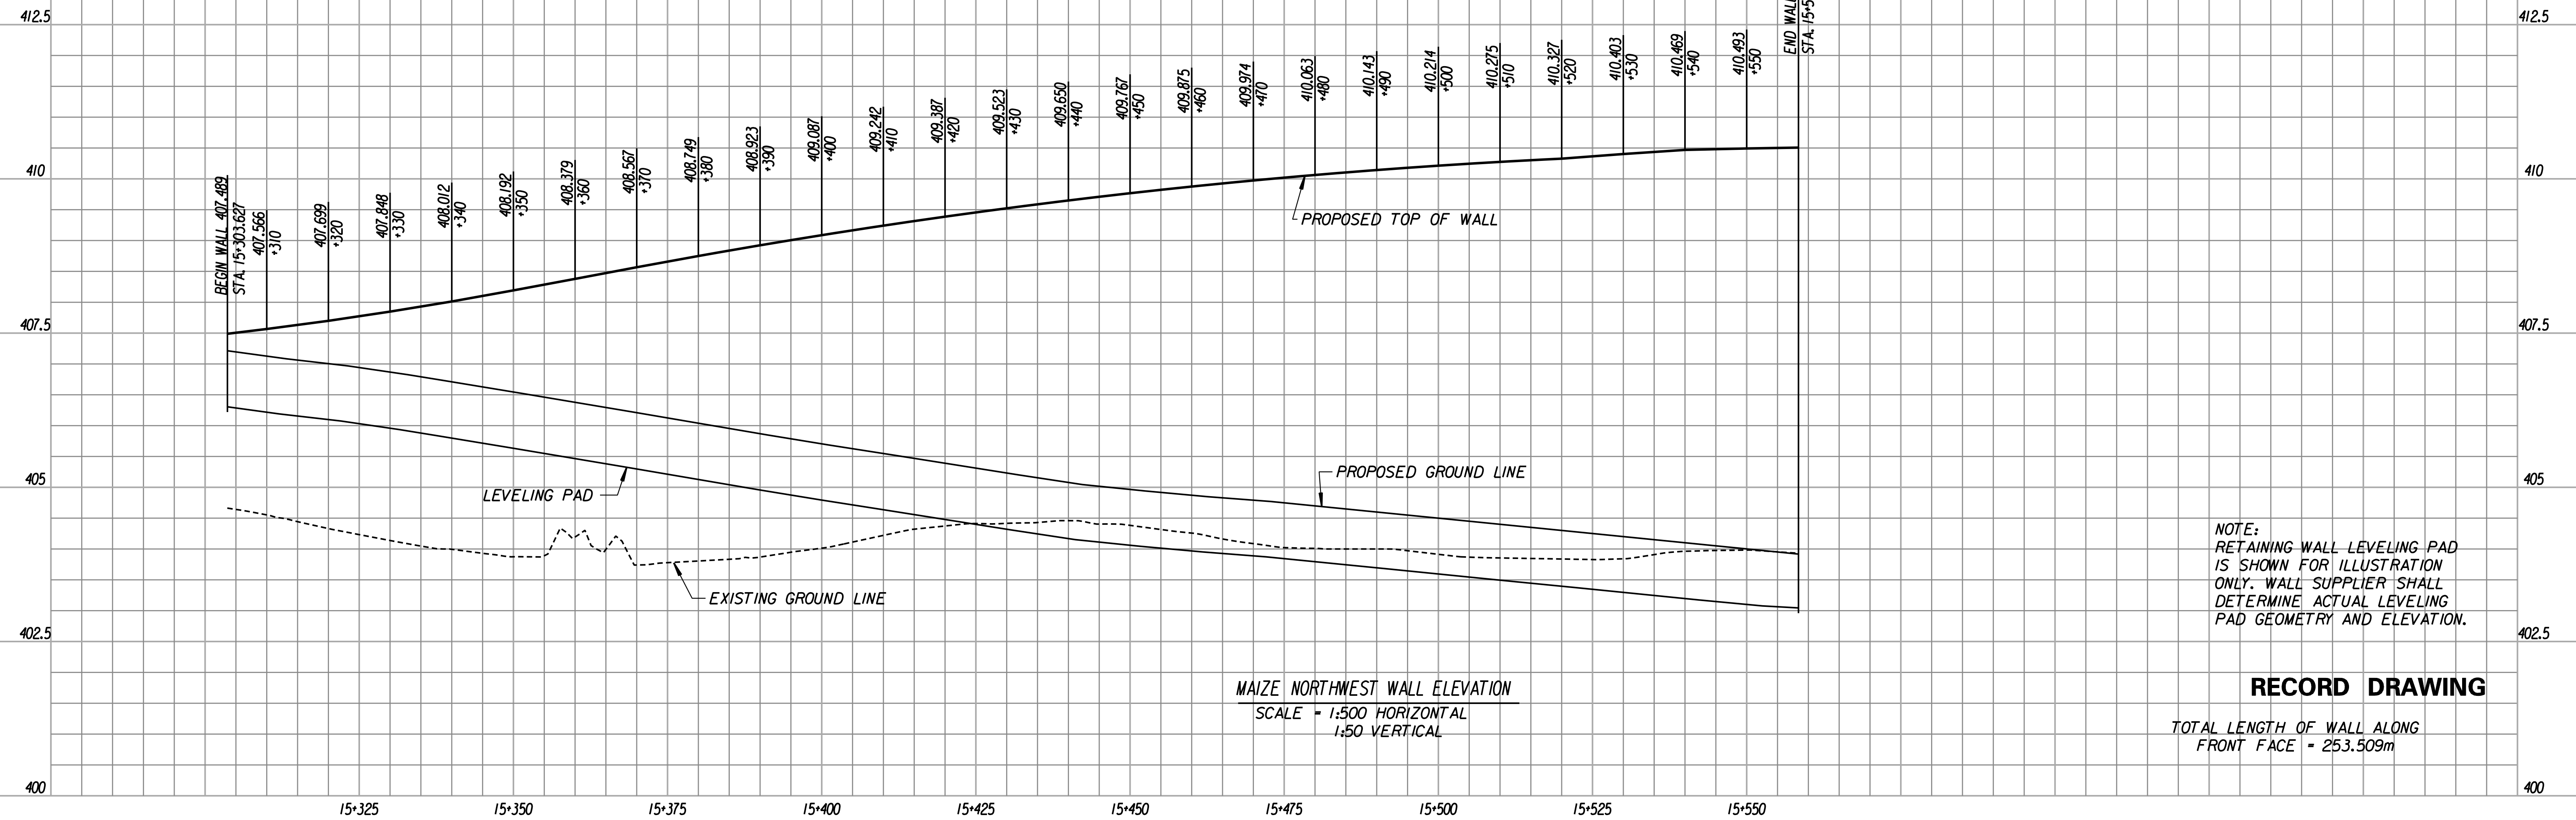

NOTE:  
 RETAINING WALL LEVELING PAD  
 IS SHOWN FOR ILLUSTRATION  
 ONLY. WALL SUPPLIER SHALL  
 DETERMINE ACTUAL LEVELING  
 PAD GEOMETRY AND ELEVATION.

**RECORD DRAWING**

TOTAL LENGTH OF WALL ALONG  
 FRONT FACE = 253.509m

MAIZE NORTHWEST WALL ELEVATION  
 SCALE = 1:500 HORIZONTAL  
 1:50 VERTICAL