


FHWA REGION NO.	STATE	PROJECT NO.	YEAR	SHEET NO.	TOTAL SHEETS
7	KANSAS	54-87 K-6657-01	2002	381	1122

REFERENCES NOTED	DATE
REFERENCES CHECKED	

DSNR: WDH OPER: JCP SCALE: 1:500
 I:/1997/97362/As-Builts/dgn's/Vol 2/Sh 381-Retwall-MSE profile.dgn Last Rev: 8-27-07 By: gdr

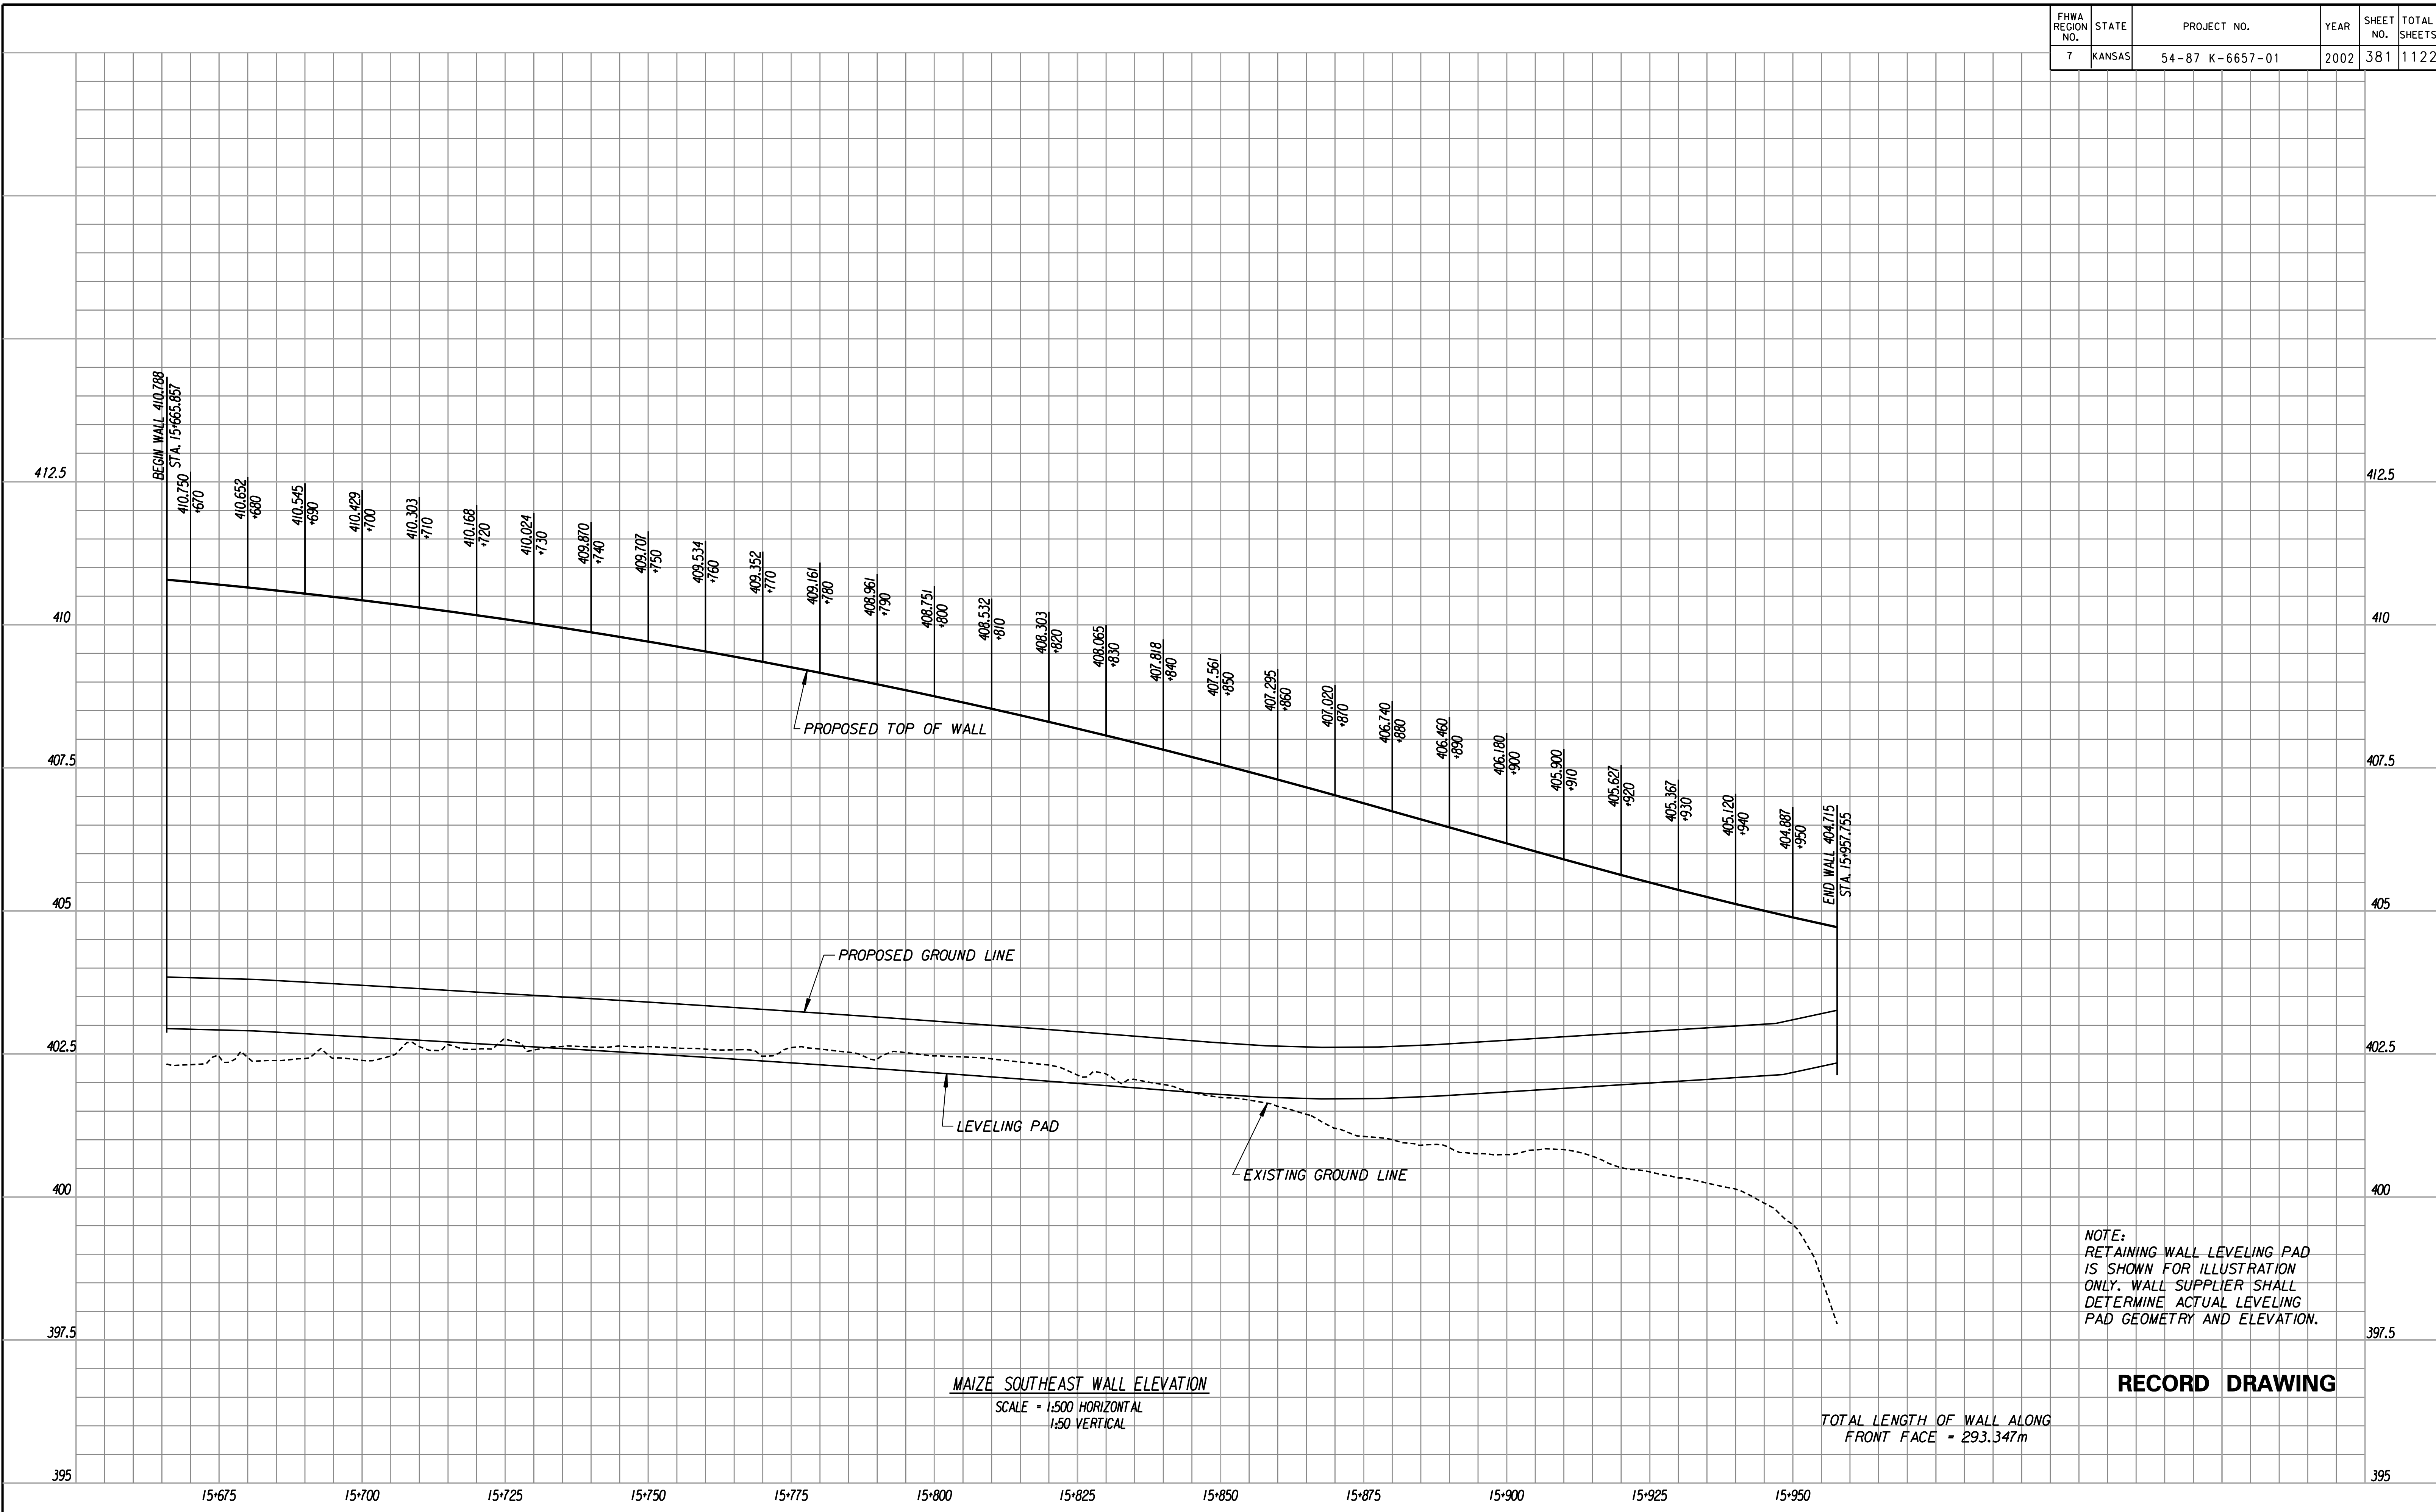

NOTE:
 RETAINING WALL LEVELING PAD
 IS SHOWN FOR ILLUSTRATION
 ONLY. WALL SUPPLIER SHALL
 DETERMINE ACTUAL LEVELING
 PAD GEOMETRY AND ELEVATION.

MAIZE SOUTHEAST WALL ELEVATION
 SCALE = 1:500 HORIZONTAL
 1:50 VERTICAL

TOTAL LENGTH OF WALL ALONG
 FRONT FACE = 293.347m

RECORD DRAWING