
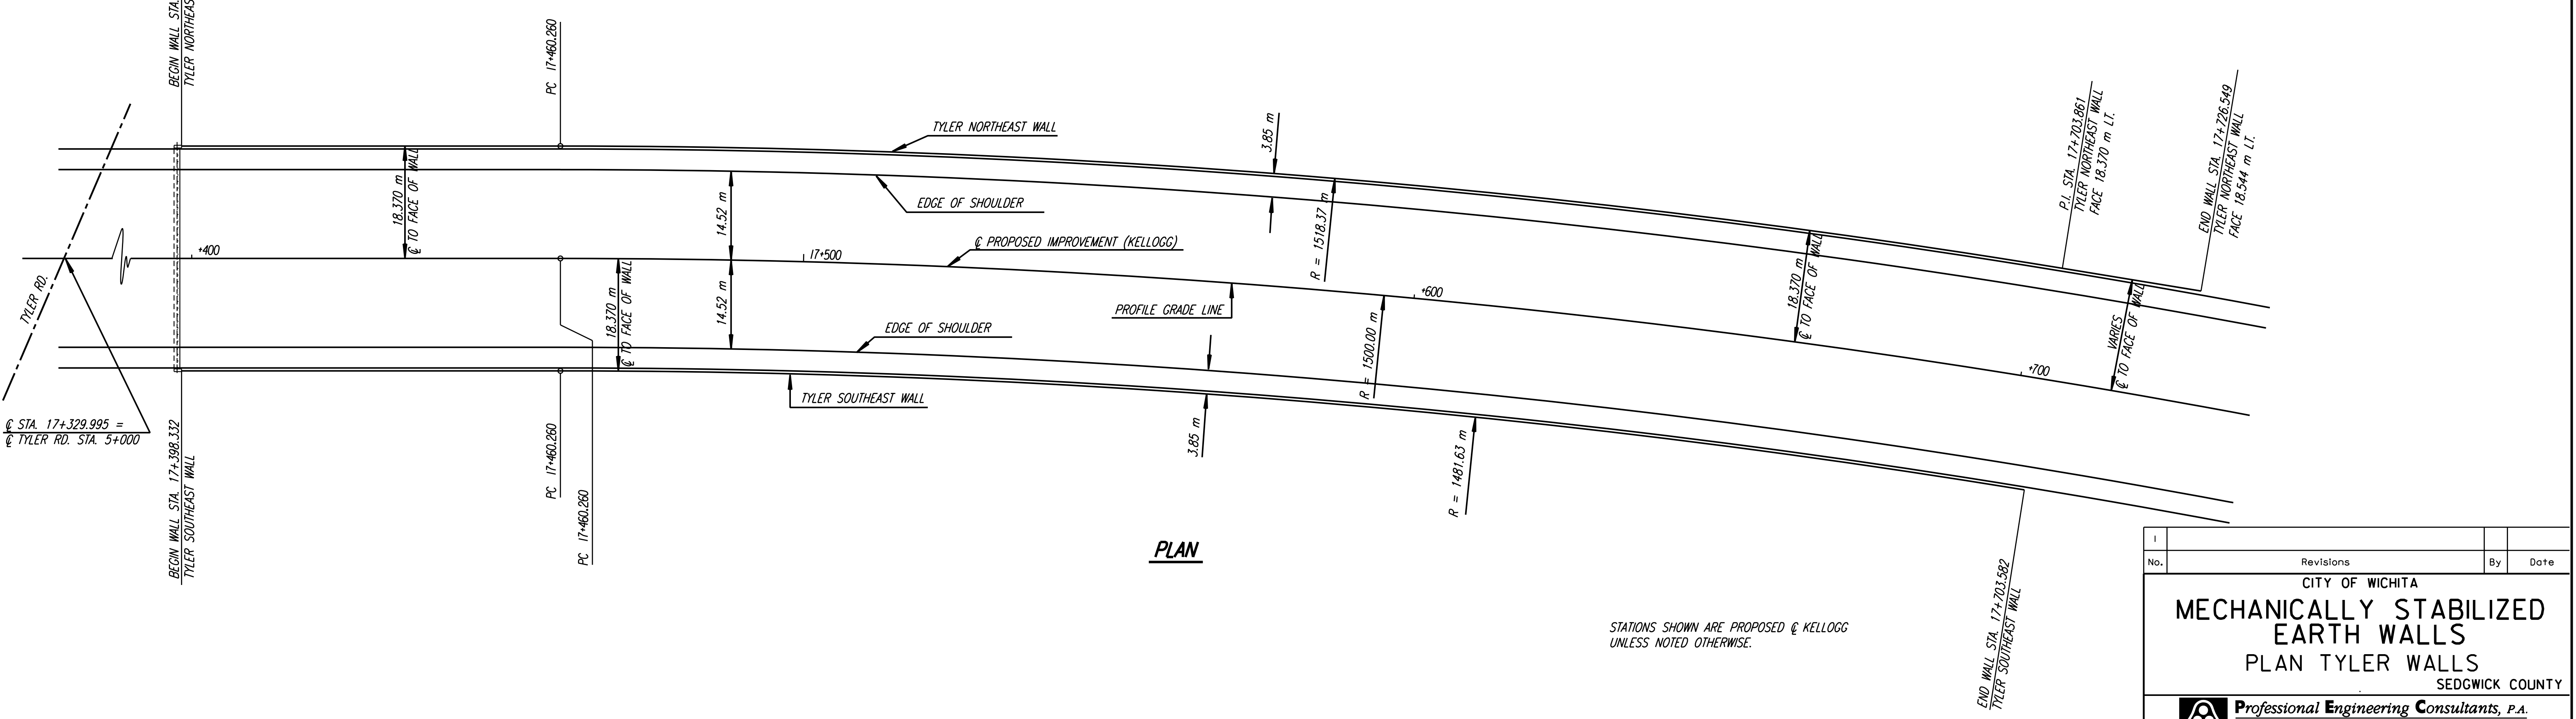


STATE	PROJECT NO.	YEAR	SHEET NO.	TOTAL SHEETS
KANSAS	54-87 K-6657-01	2002	382	1122

DATE	BY
REFERENCES NOTED	REFERENCES CHECKED

DSNR: WDH OPER: JGP SCALE: 1:500  
 i:/1997/97362/As-Builts/dgn's/Vol 2/Sh 382--Retwall--TYLERwest.dgn Last Rev: 8-27-07 By: gdr

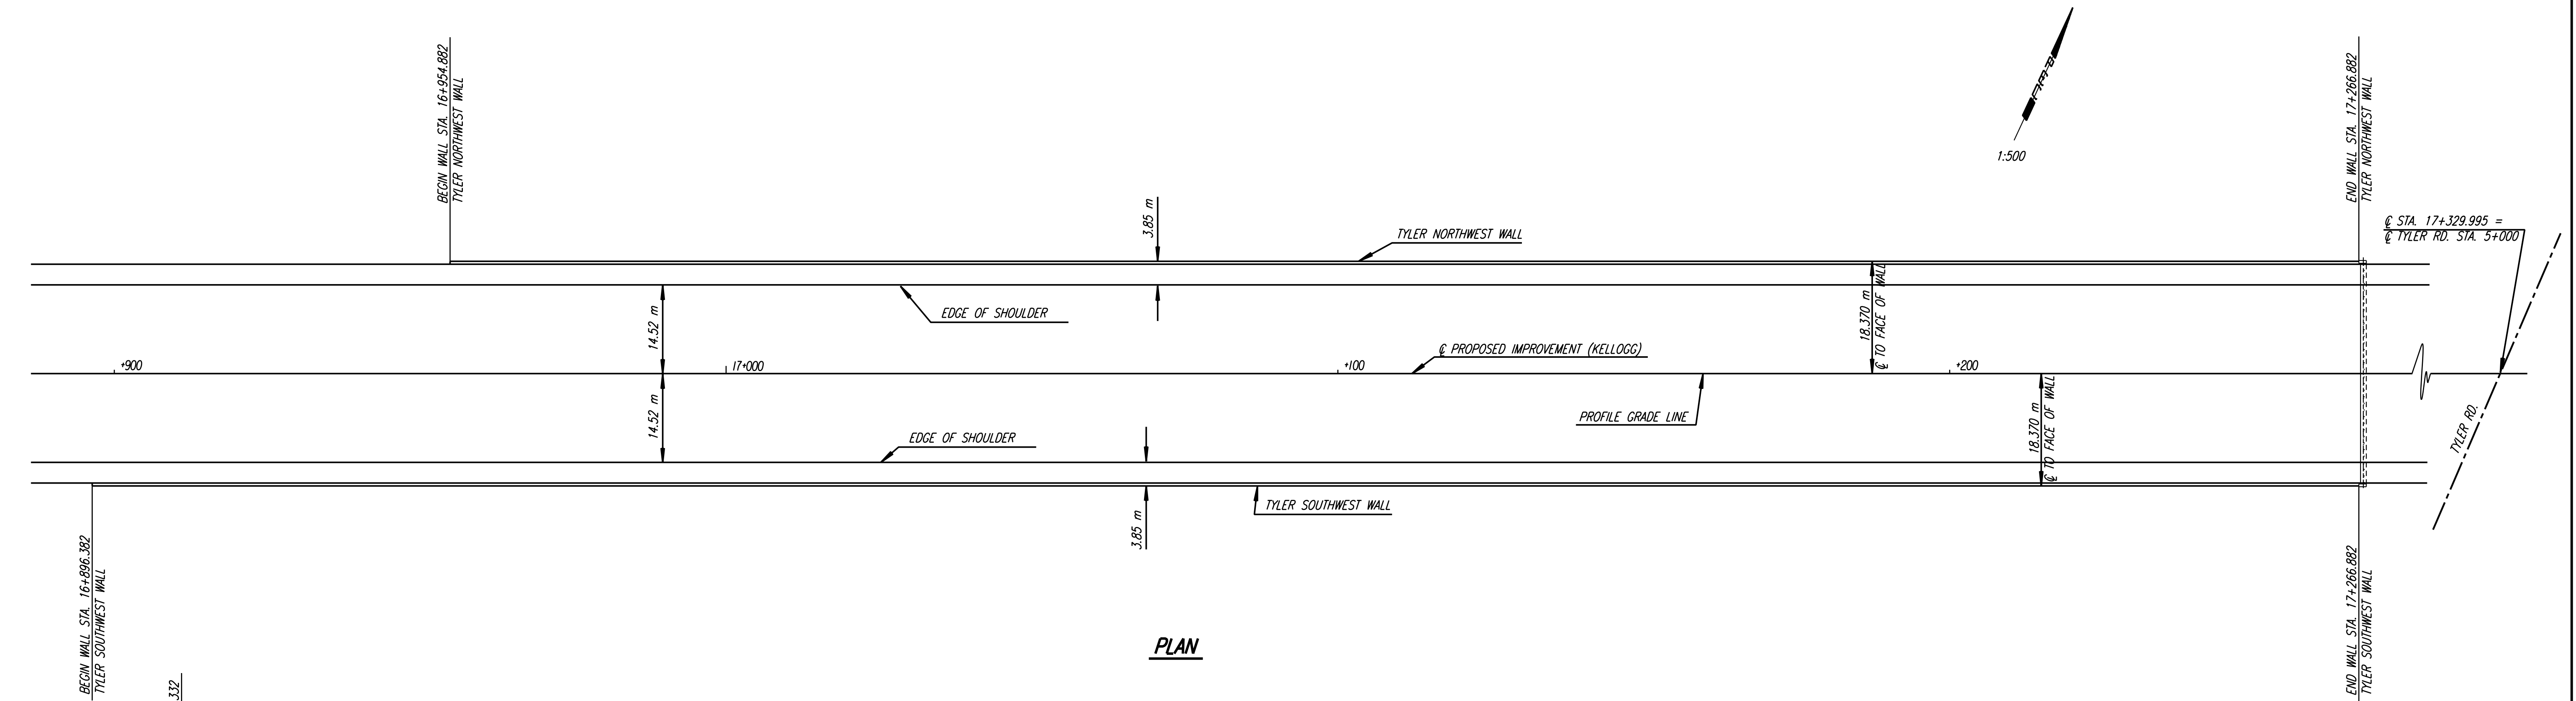

**RECORD DRAWING**

1			
No.	Revisions	By	Date
CITY OF WICHITA <b>MECHANICALLY STABILIZED EARTH WALLS</b> PLAN TYLER WALLS SEDGWICK COUNTY			
<b>Professional Engineering Consultants, P.A.</b> 303 S. TOPEKA • WICHITA, KANSAS 67202 316-262-2691 • FAX 316-262-3003			
Designed by	RWM	Checked by	WDH
Drawn by	JSB	Date	April, 2002
		Job No.	97362