


FHWA REGION NO.	STATE	PROJECT NO.	YEAR	SHEET NO.	TOTAL SHEETS
7	KANSAS	54-87 K-6657-01	2002	383	1122

REFERENCES NOTED	BY	DATE
REFERENCES CHECKED		

DSNR: WDH OPER: JGP SCALE: 1:500
 i:/1997/97362/As-Builts/dgn's/Vol 2/Sh 383-RetWall-TNW_profile.dgn Last Rev: 8-27-07 By: gdr

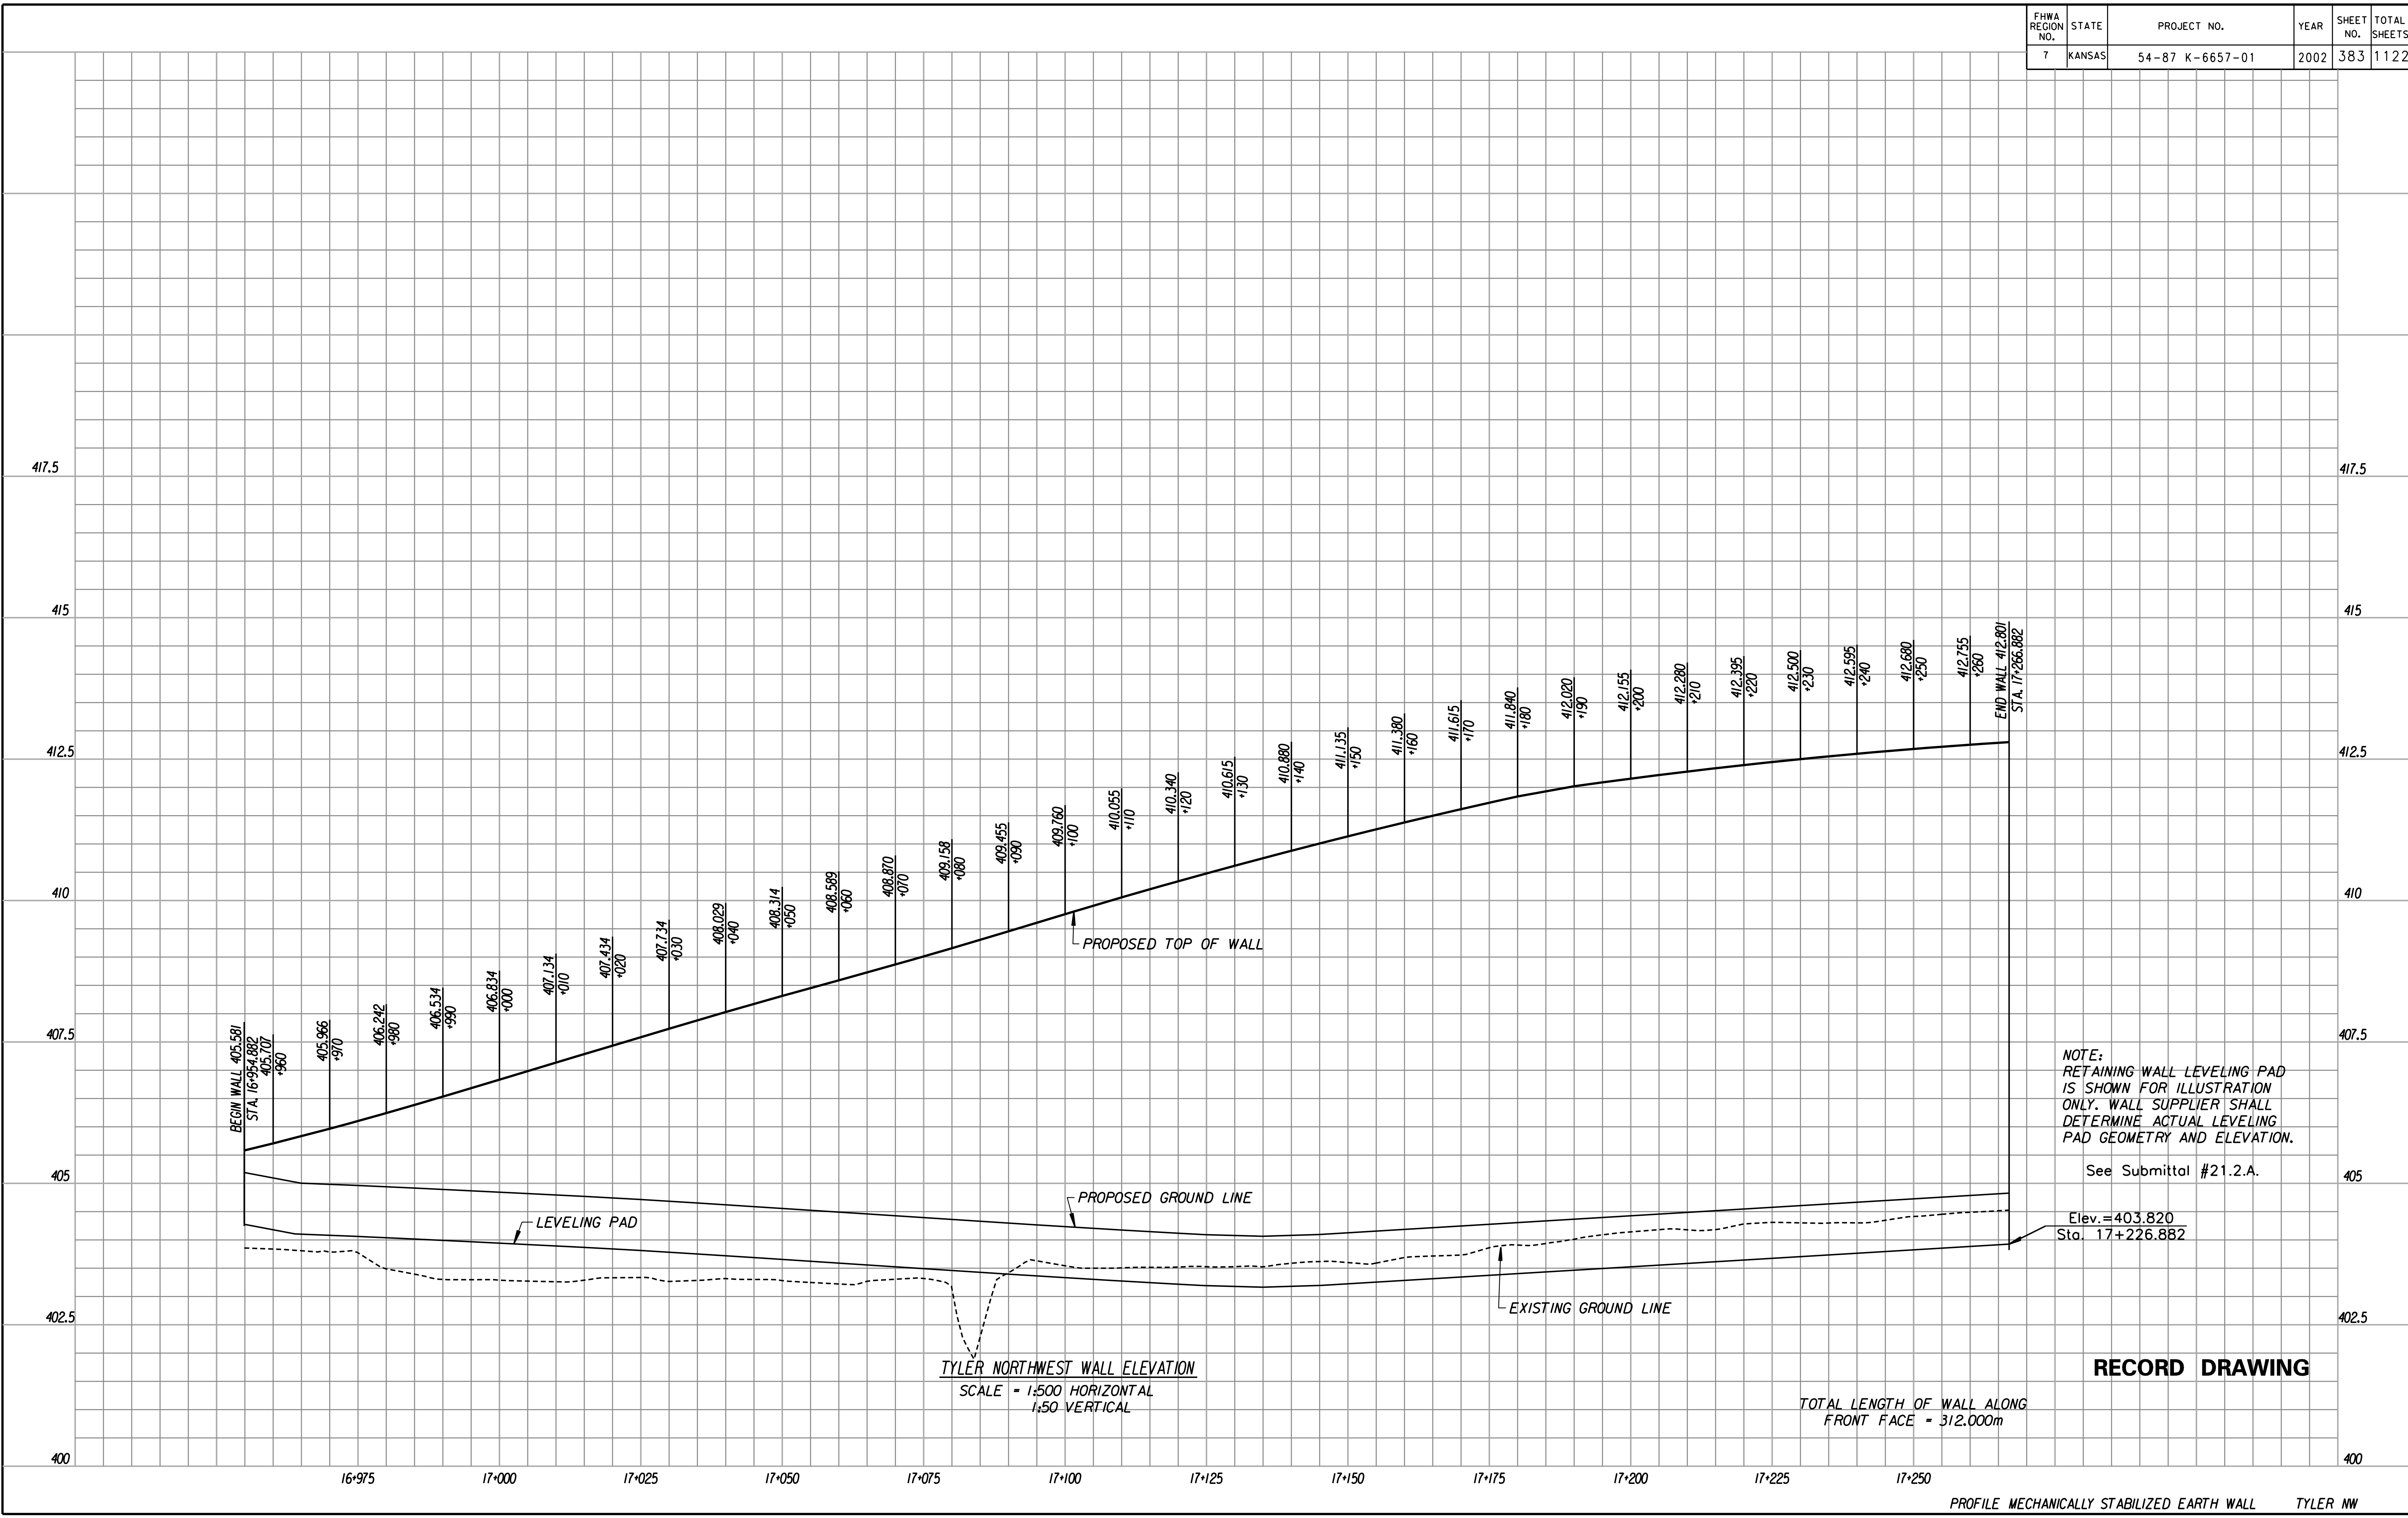

NOTE:
 RETAINING WALL LEVELING PAD
 IS SHOWN FOR ILLUSTRATION
 ONLY. WALL SUPPLIER SHALL
 DETERMINE ACTUAL LEVELING
 PAD GEOMETRY AND ELEVATION.

See Submittal #21.2.A.

Elev. = 403.820
 Sta. 17+226.882

RECORD DRAWING

TOTAL LENGTH OF WALL ALONG
 FRONT FACE = 312.000m

TYLER NORTHWEST WALL ELEVATION
 SCALE = 1:500 HORIZONTAL
 1:50 VERTICAL