


FHWA REGION NO.	STATE	PROJECT NO.	YEAR	SHEET NO.	TOTAL SHEETS
7	KANSAS	54-87 K-6657-01	2002	384	1122

REFERENCES NOTED	BY	DATE
REFERENCES CHECKED		

DSNR: WDH OPER: JGP SCALE: 1:500  
 i:/1997/97362/As-Builts/dgn's/Vol 2/Sh 384-RetWall-TSW\_profile.dgn Last Rev: 8-27-07 By: gdr

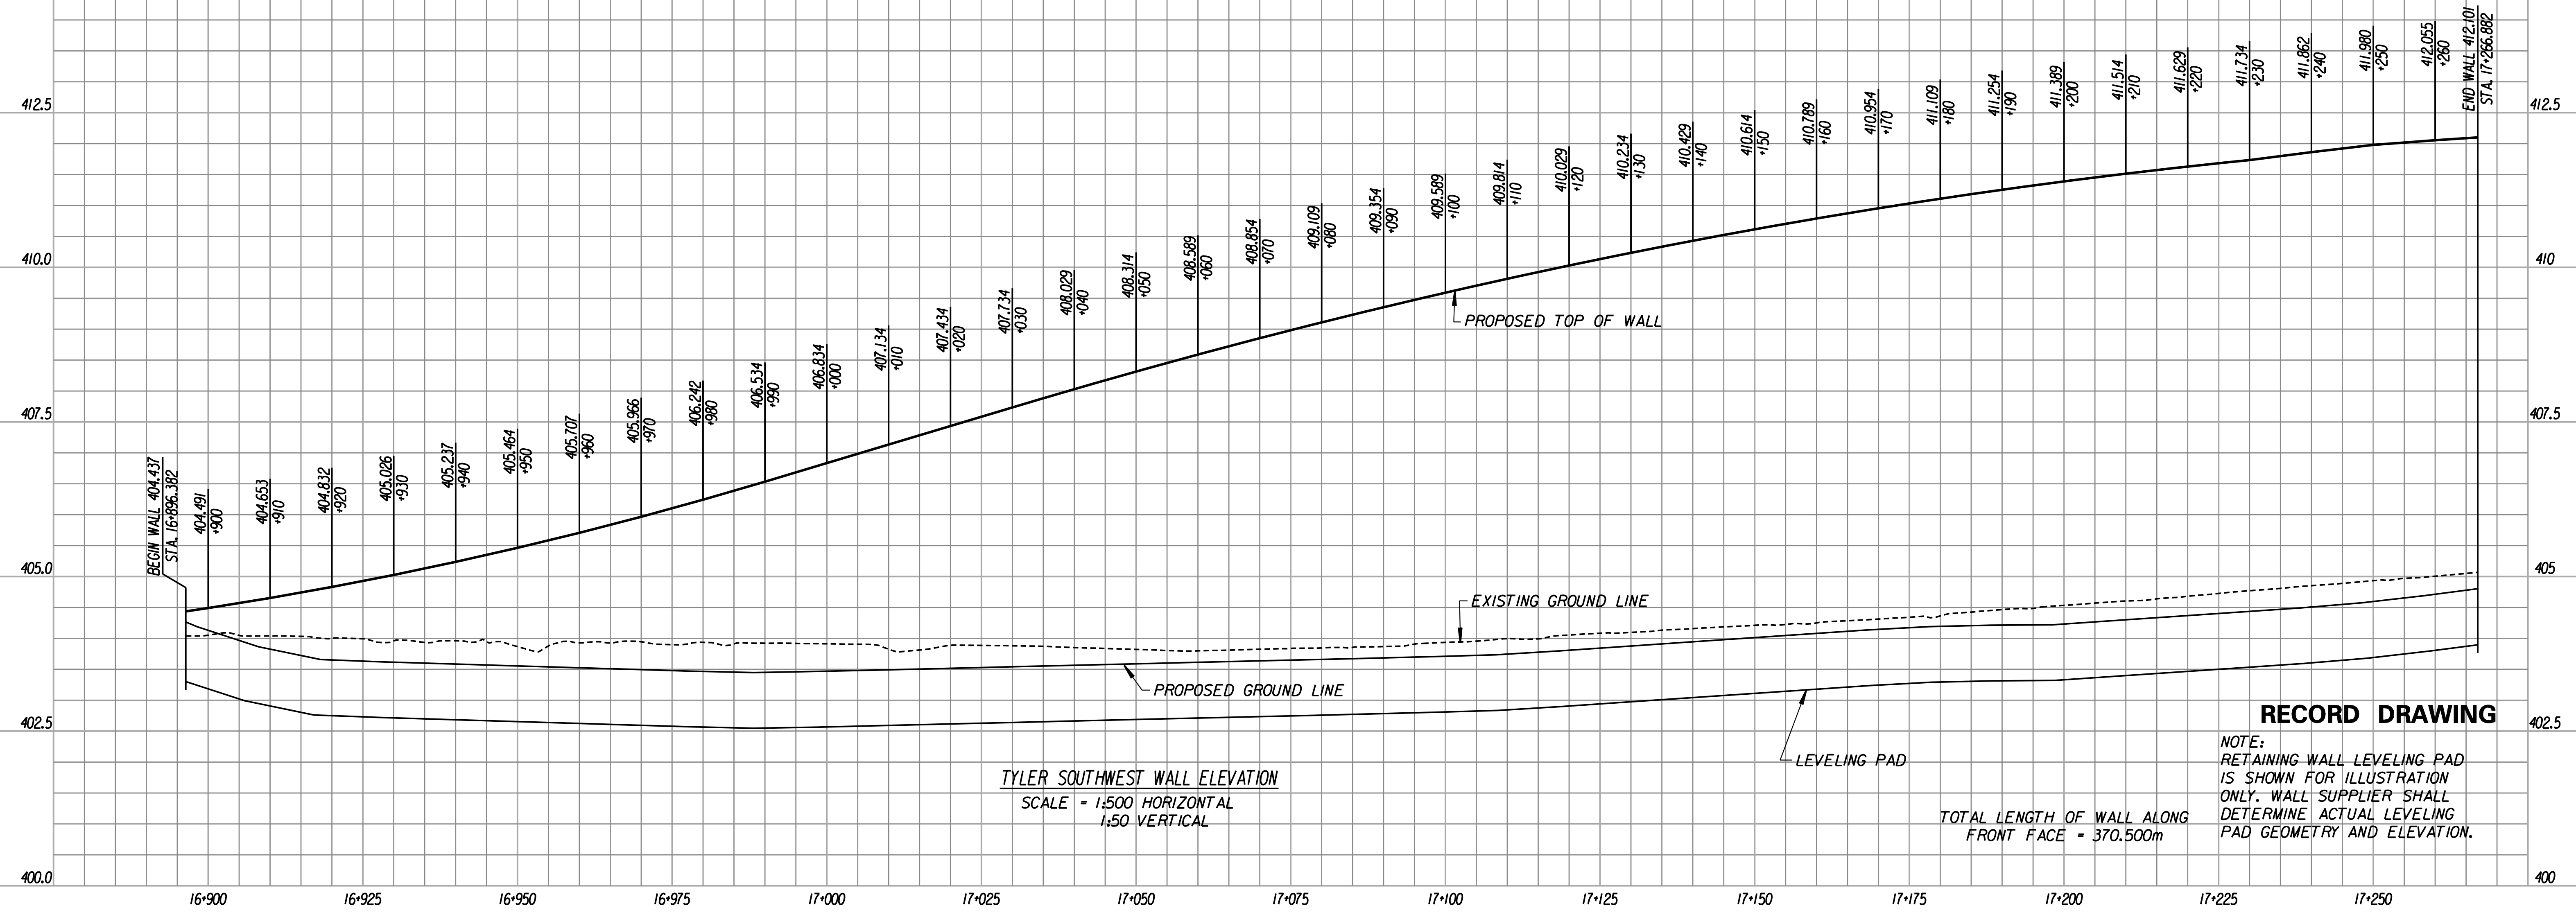

**TYLER SOUTHWEST WALL ELEVATION**  
 SCALE = 1:500 HORIZONTAL  
 1:50 VERTICAL

**RECORD DRAWING**

NOTE:  
 RETAINING WALL LEVELING PAD  
 IS SHOWN FOR ILLUSTRATION  
 ONLY. WALL SUPPLIER SHALL  
 DETERMINE ACTUAL LEVELING  
 PAD GEOMETRY AND ELEVATION.

TOTAL LENGTH OF WALL ALONG  
 FRONT FACE = 370.500m