


FHWA REGION NO.	STATE	PROJECT NO.	YEAR	SHEET NO.	TOTAL SHEETS
7	KANSAS	54-87 K-6657-01	2002	385	1122

REFERENCES NOTED	BY	DATE
REFERENCES CHECKED		

DSNR: WDH OPER: JGP SCALE: 1:500
 i:/1997/97362/As-Builts/dgn's/Vol 2/Sh 385-RetWall-TNE_profile.dgn Last Rev: 8-27-07 By: gdr

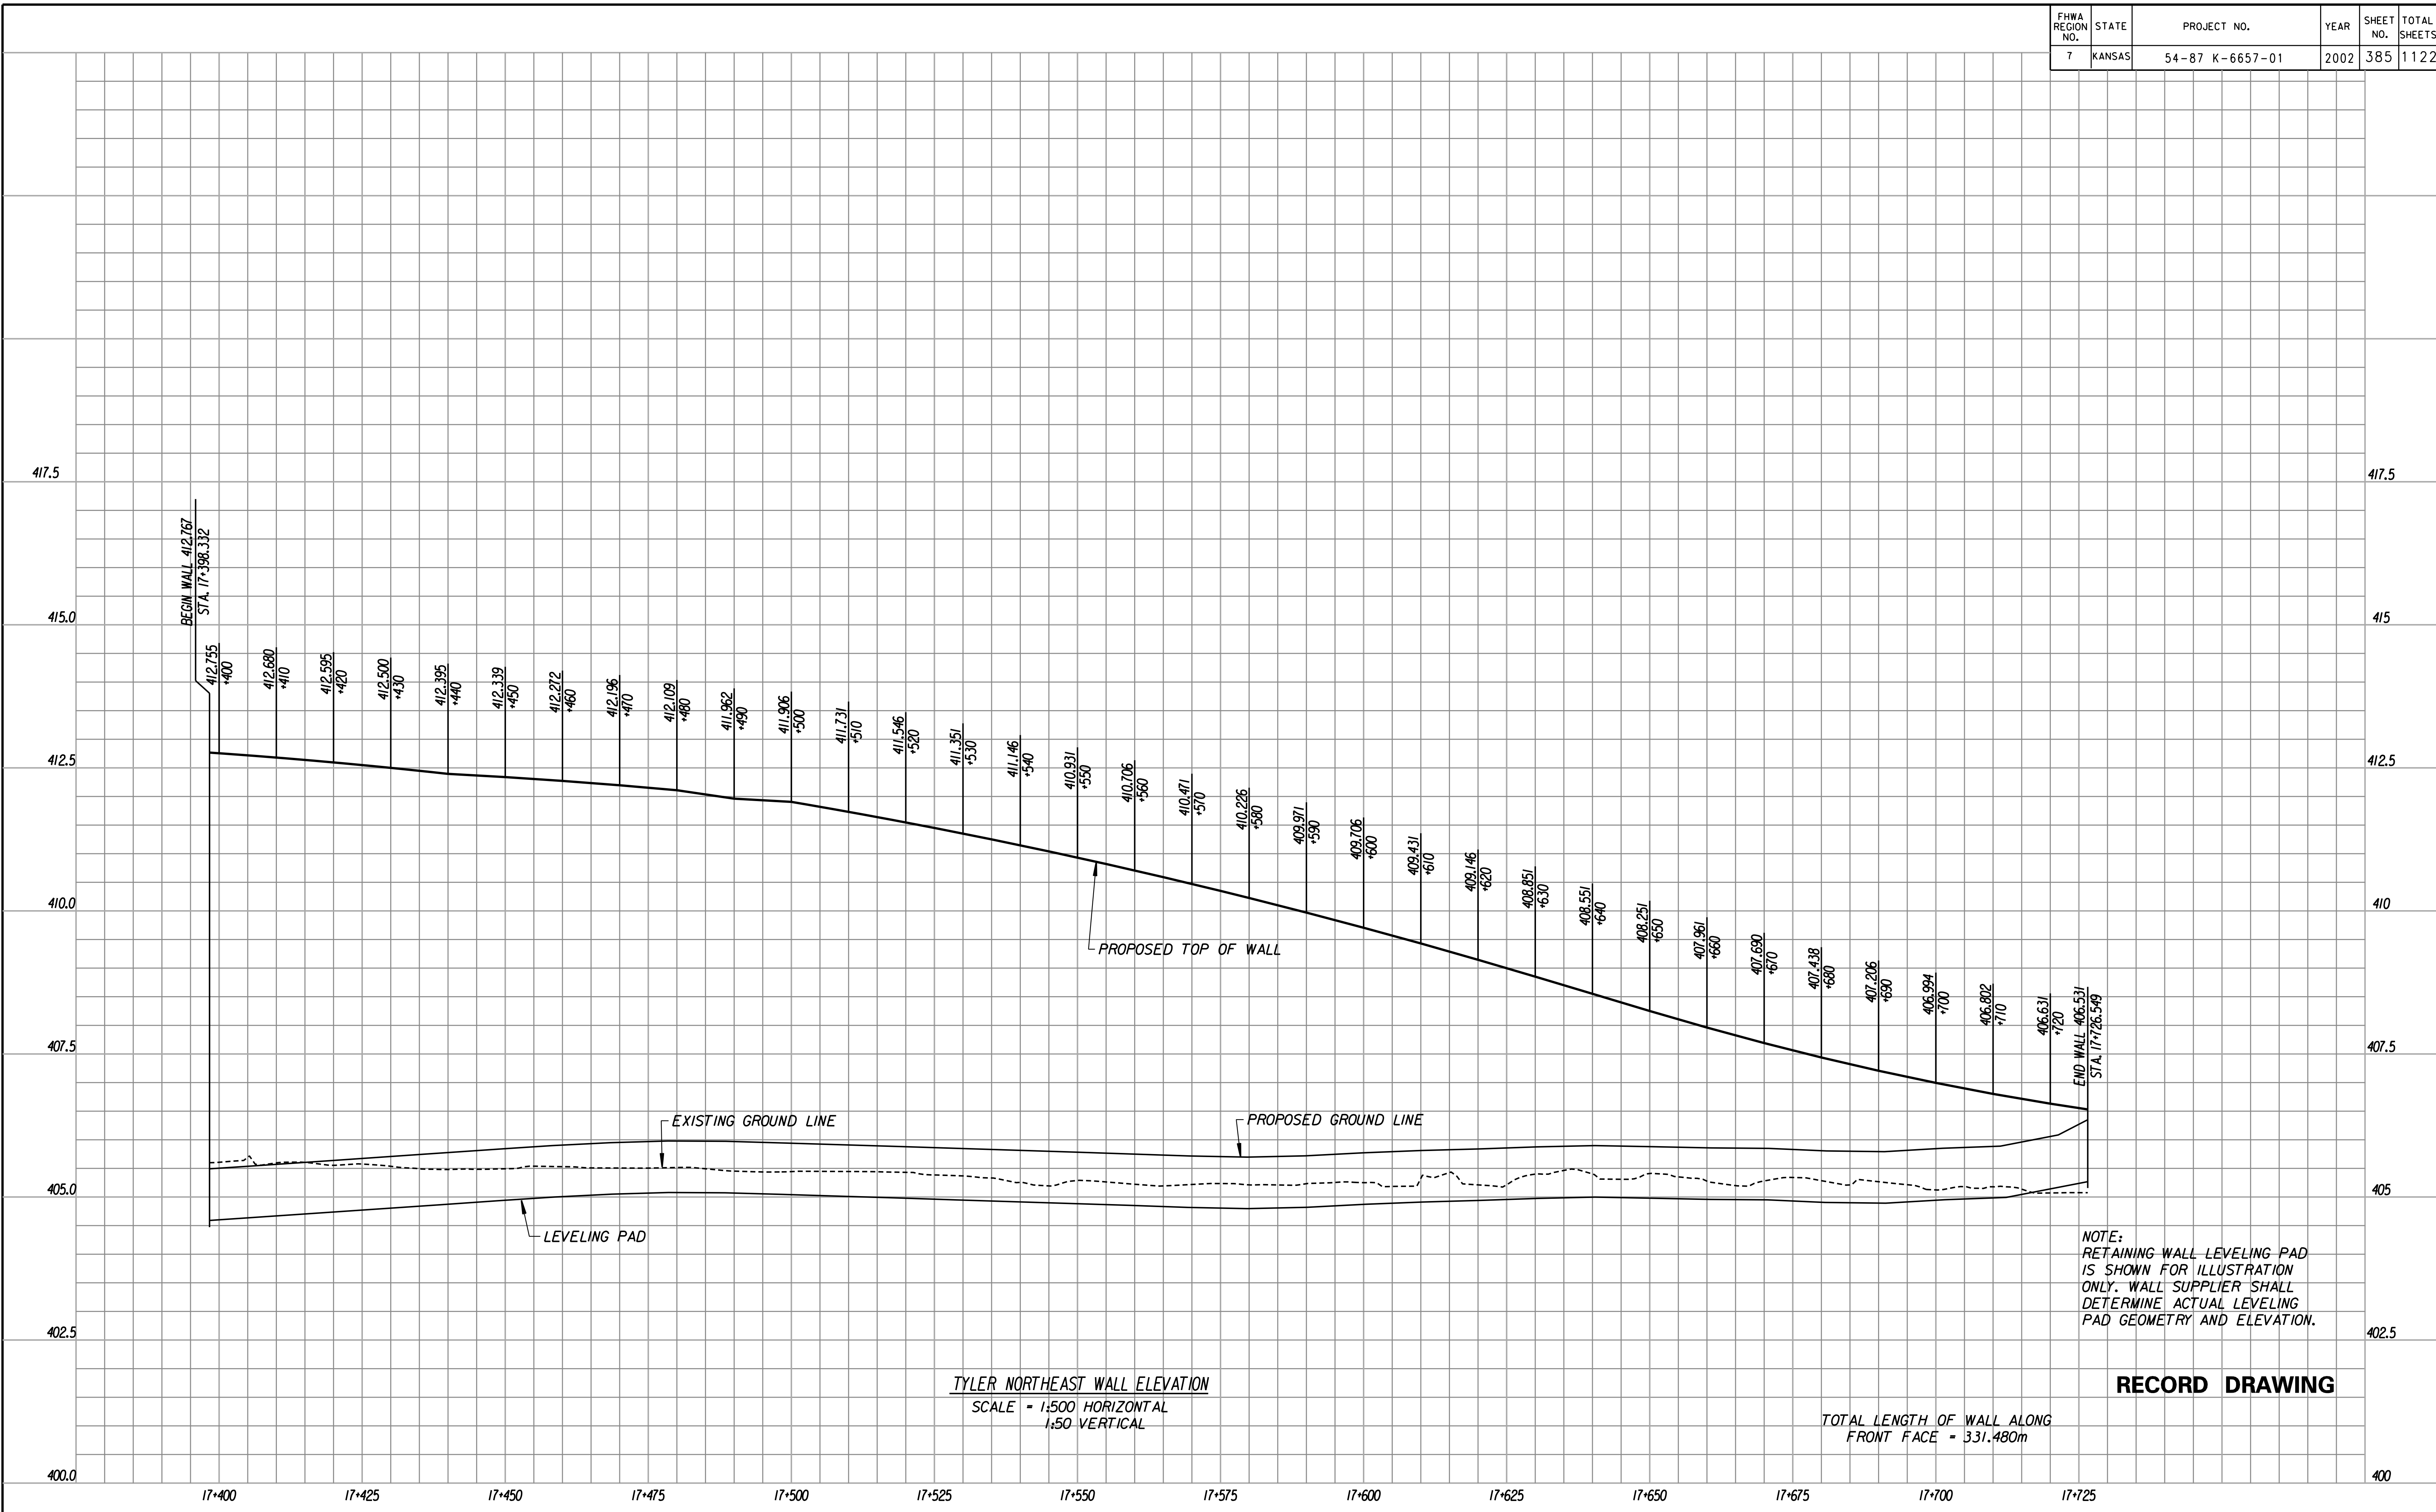

TYLER NORTHEAST WALL ELEVATION
 SCALE = 1:500 HORIZONTAL
 1:50 VERTICAL

TOTAL LENGTH OF WALL ALONG
 FRONT FACE = 331.480m

RECORD DRAWING