



STATE	PROJECT NO.	YEAR	SHEET NO.	TOTAL SHEETS
KANSAS	54-87 K-6657-01	2002	392	1122

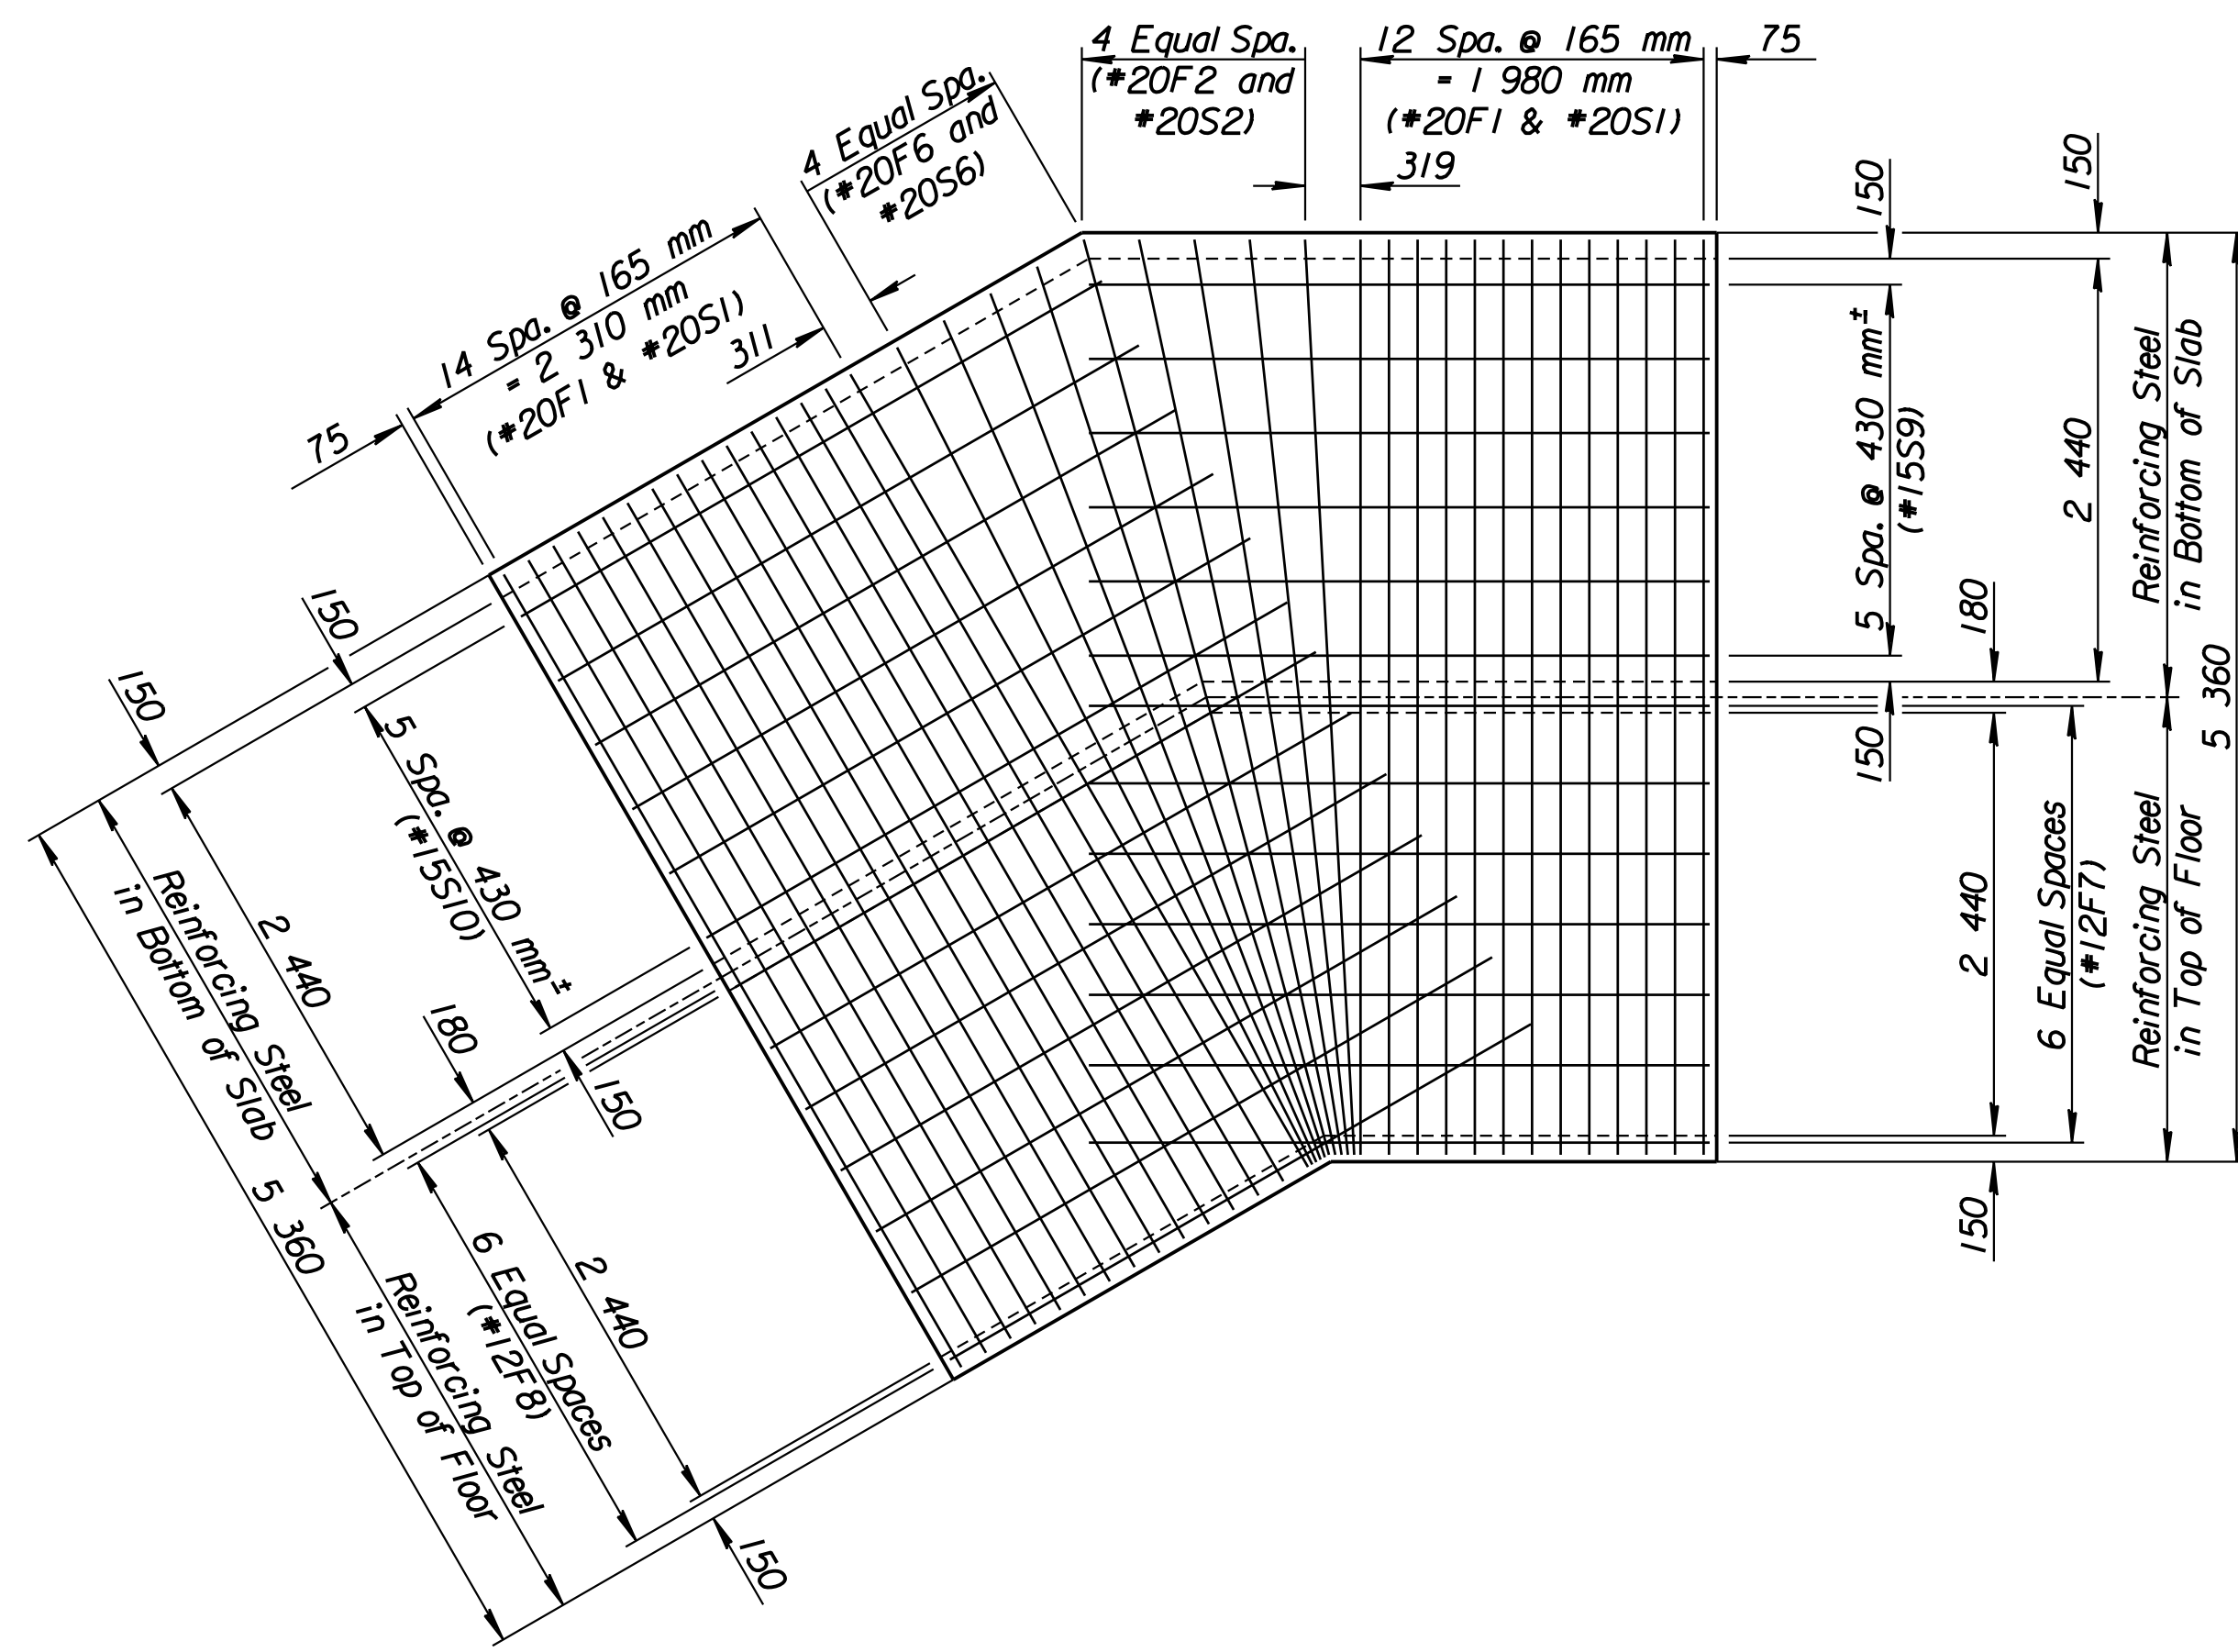

REINFORCING IN TOP OF FLOOR AND IN BOTTOM OF SLAB

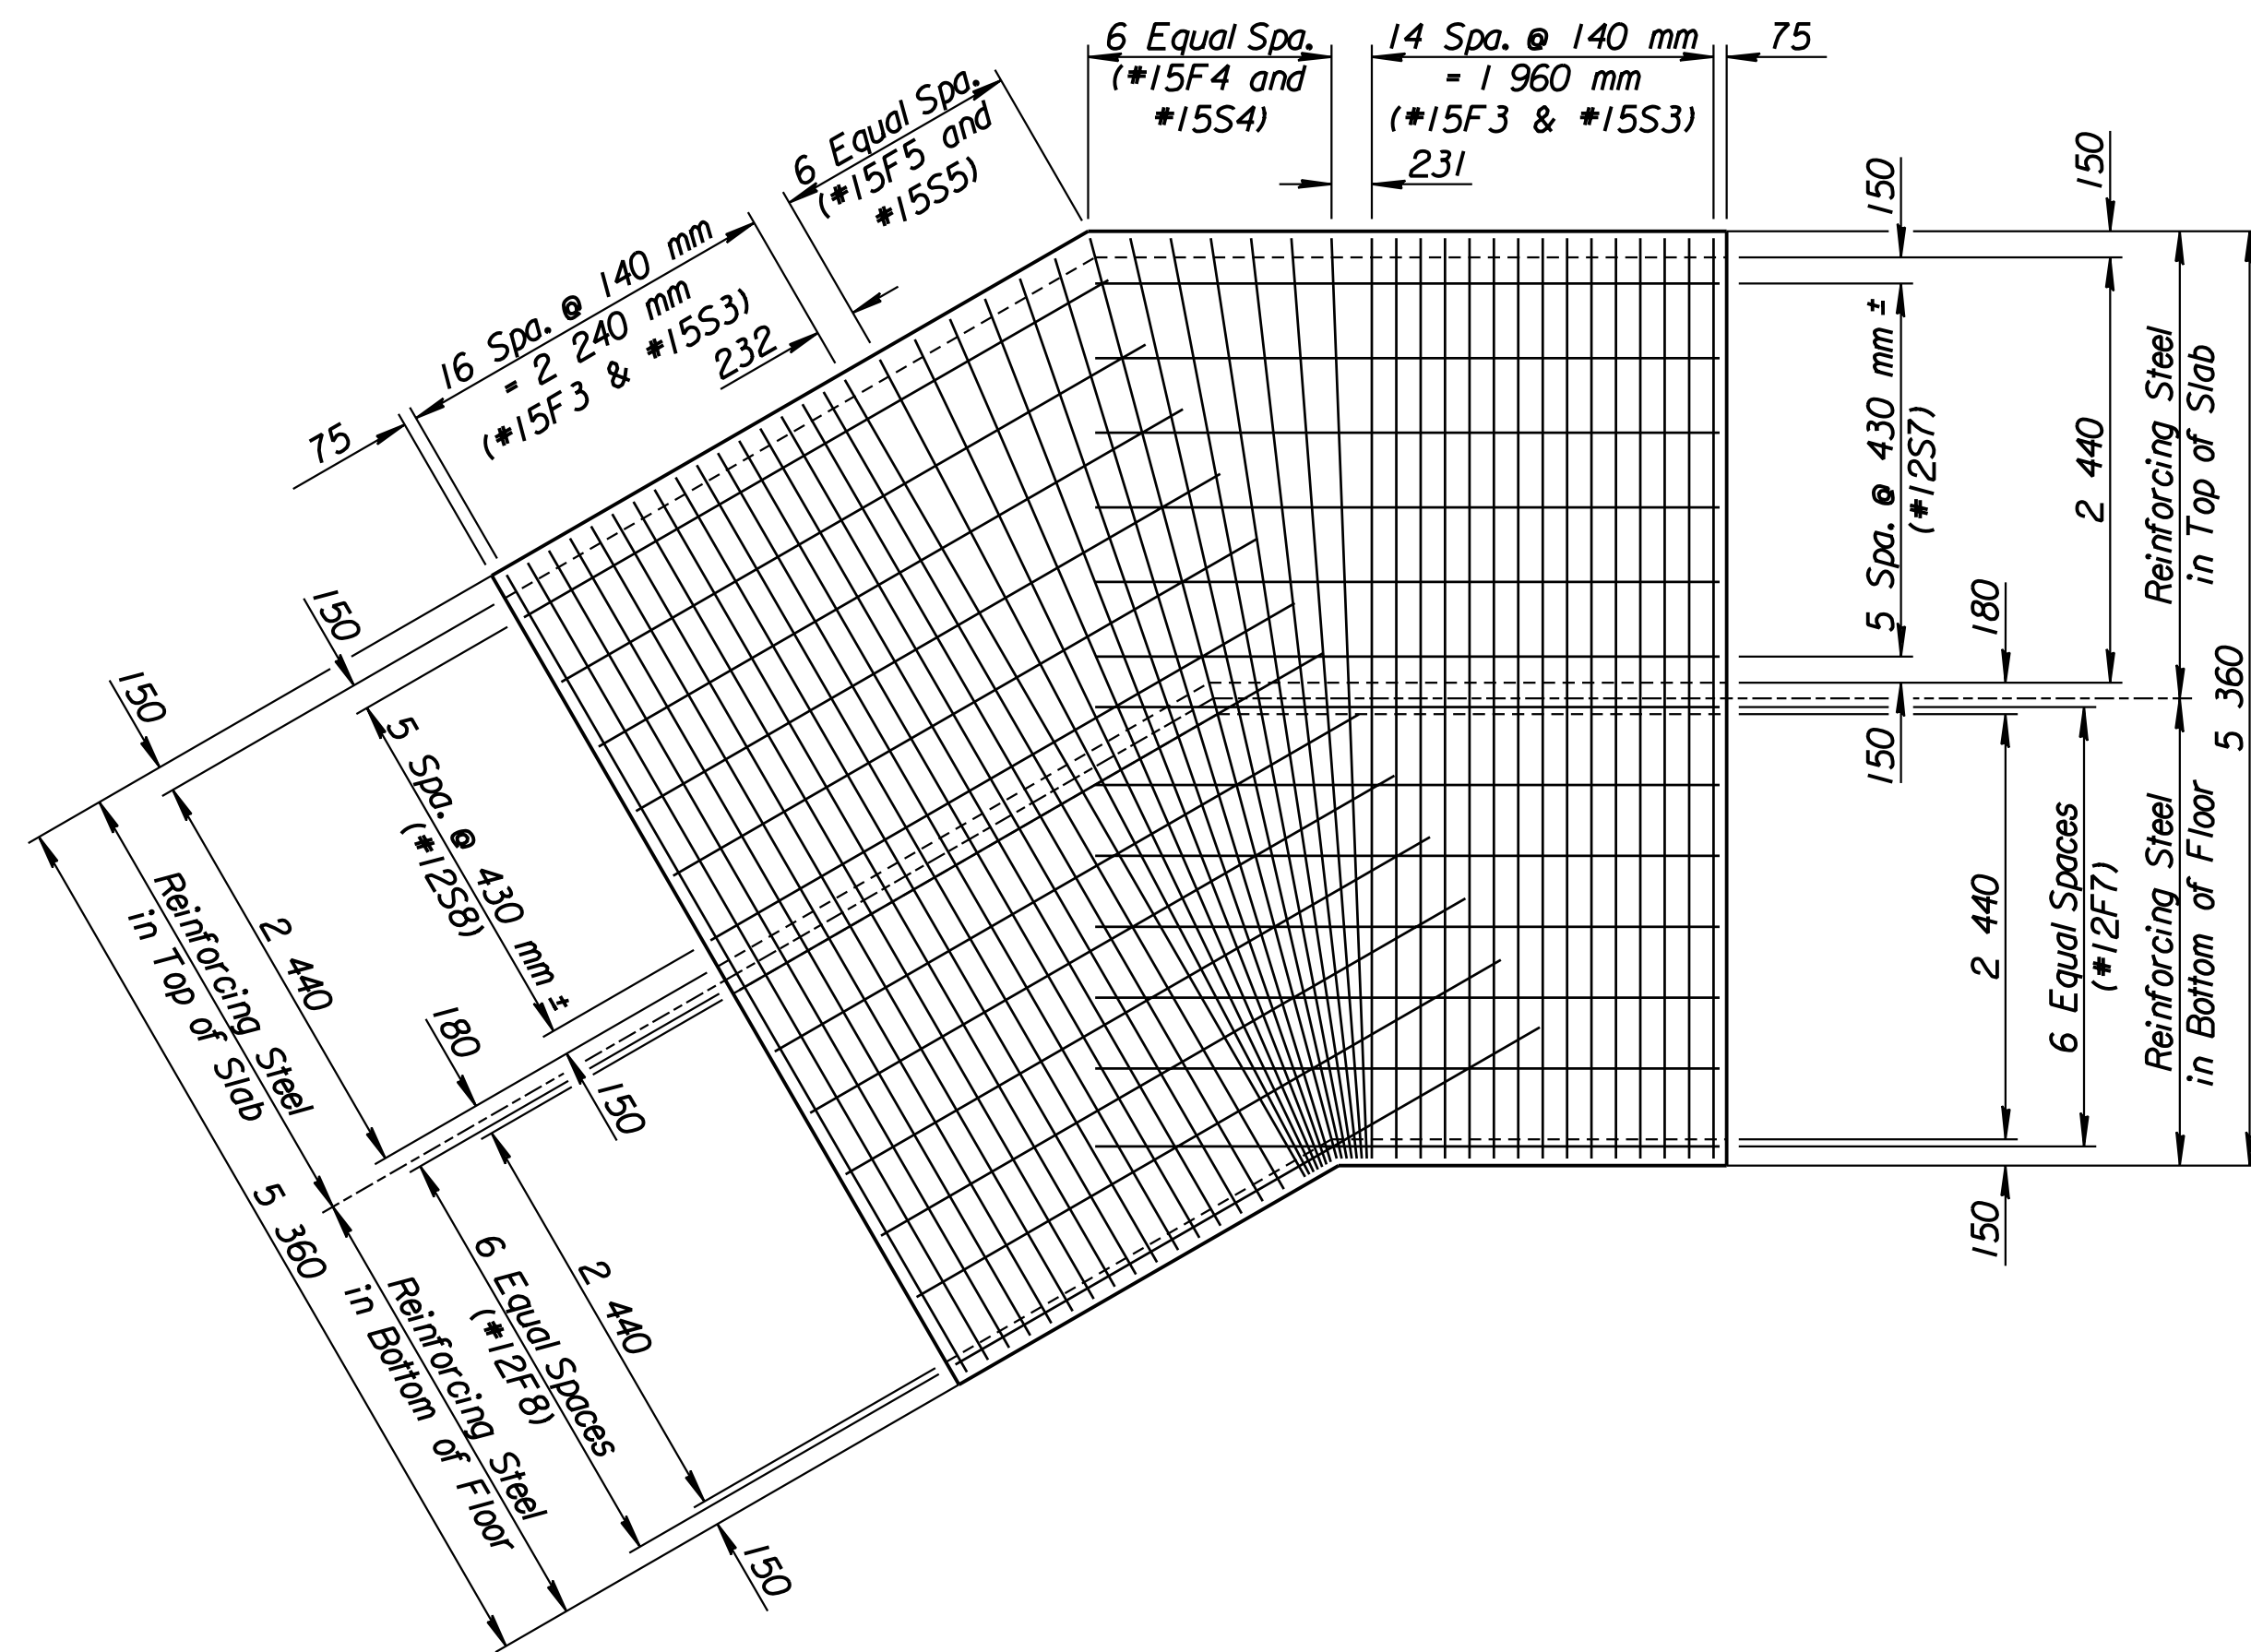

REINFORCING IN BOTTOM OF FLOOR AND IN TOP OF SLAB

Plotted by: ras 2-1-2002
I:/1997/97362/As-Built/dgn/s/Vol_2/Sh_392-dbl24bend.dgn Last Rev.: 8-28-07 By: gdr

1			
No.	Revisions	By	Date
CITY OF WICHITA			
SPECIAL 2 - 2.4 x 0.9 m			
R.C.B. SECTION AT P.I.			
WEST KELLOGG (US 54)			
SEDGWICK COUNTY			
Professional Engineering Consultants, P.A.			
303 S. TOPEKA • WICHITA, KANSAS 67202			
316-262-2691 • FAX 316-262-3003			
Designed by	RWA	Checked by	RAS
Drawn by	GDR	Date	April 11, 2002 Job No. 97362

RECORD DRAWING