
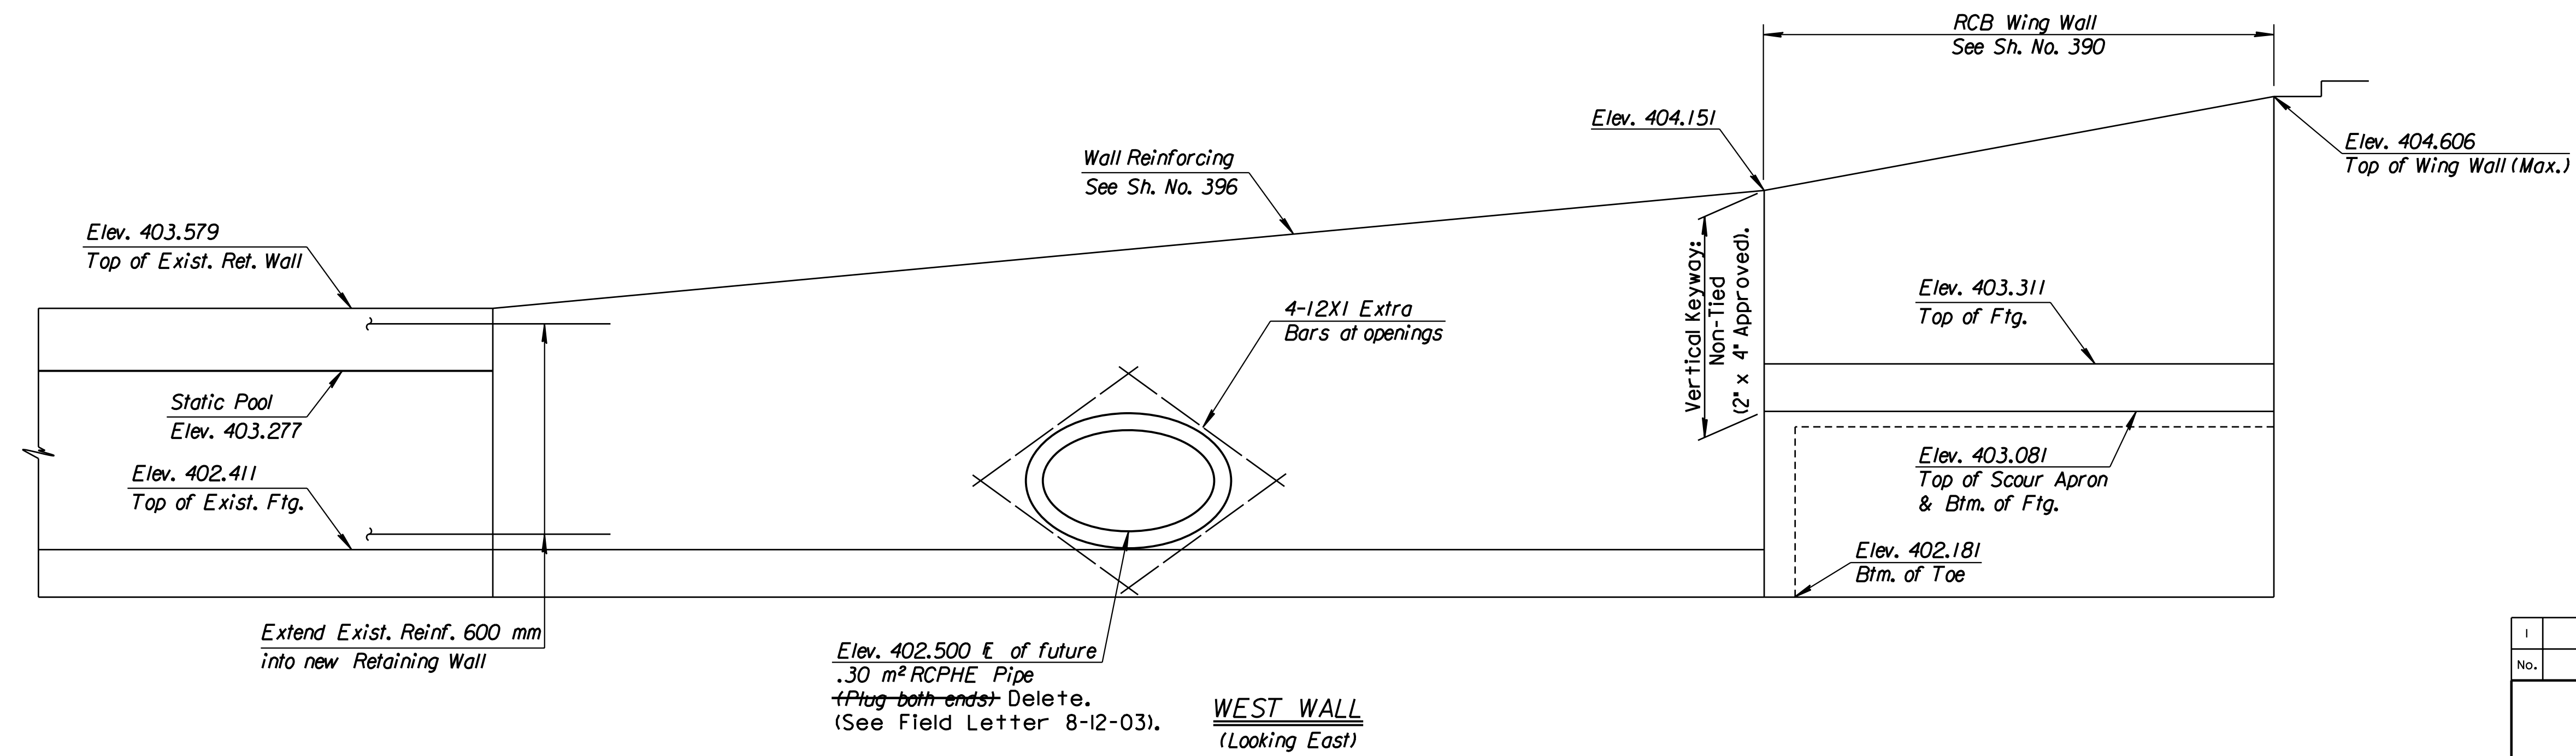


FHWA REGION NO.	STATE	PROJECT NO.	YEAR	SHEET NO.	TOTAL SHEETS
7	KANSAS	54-87 K-6657-01	2002	397	1122

DATE	
BY	
REFERENCES NOTED	
REFERENCES CHECKED	

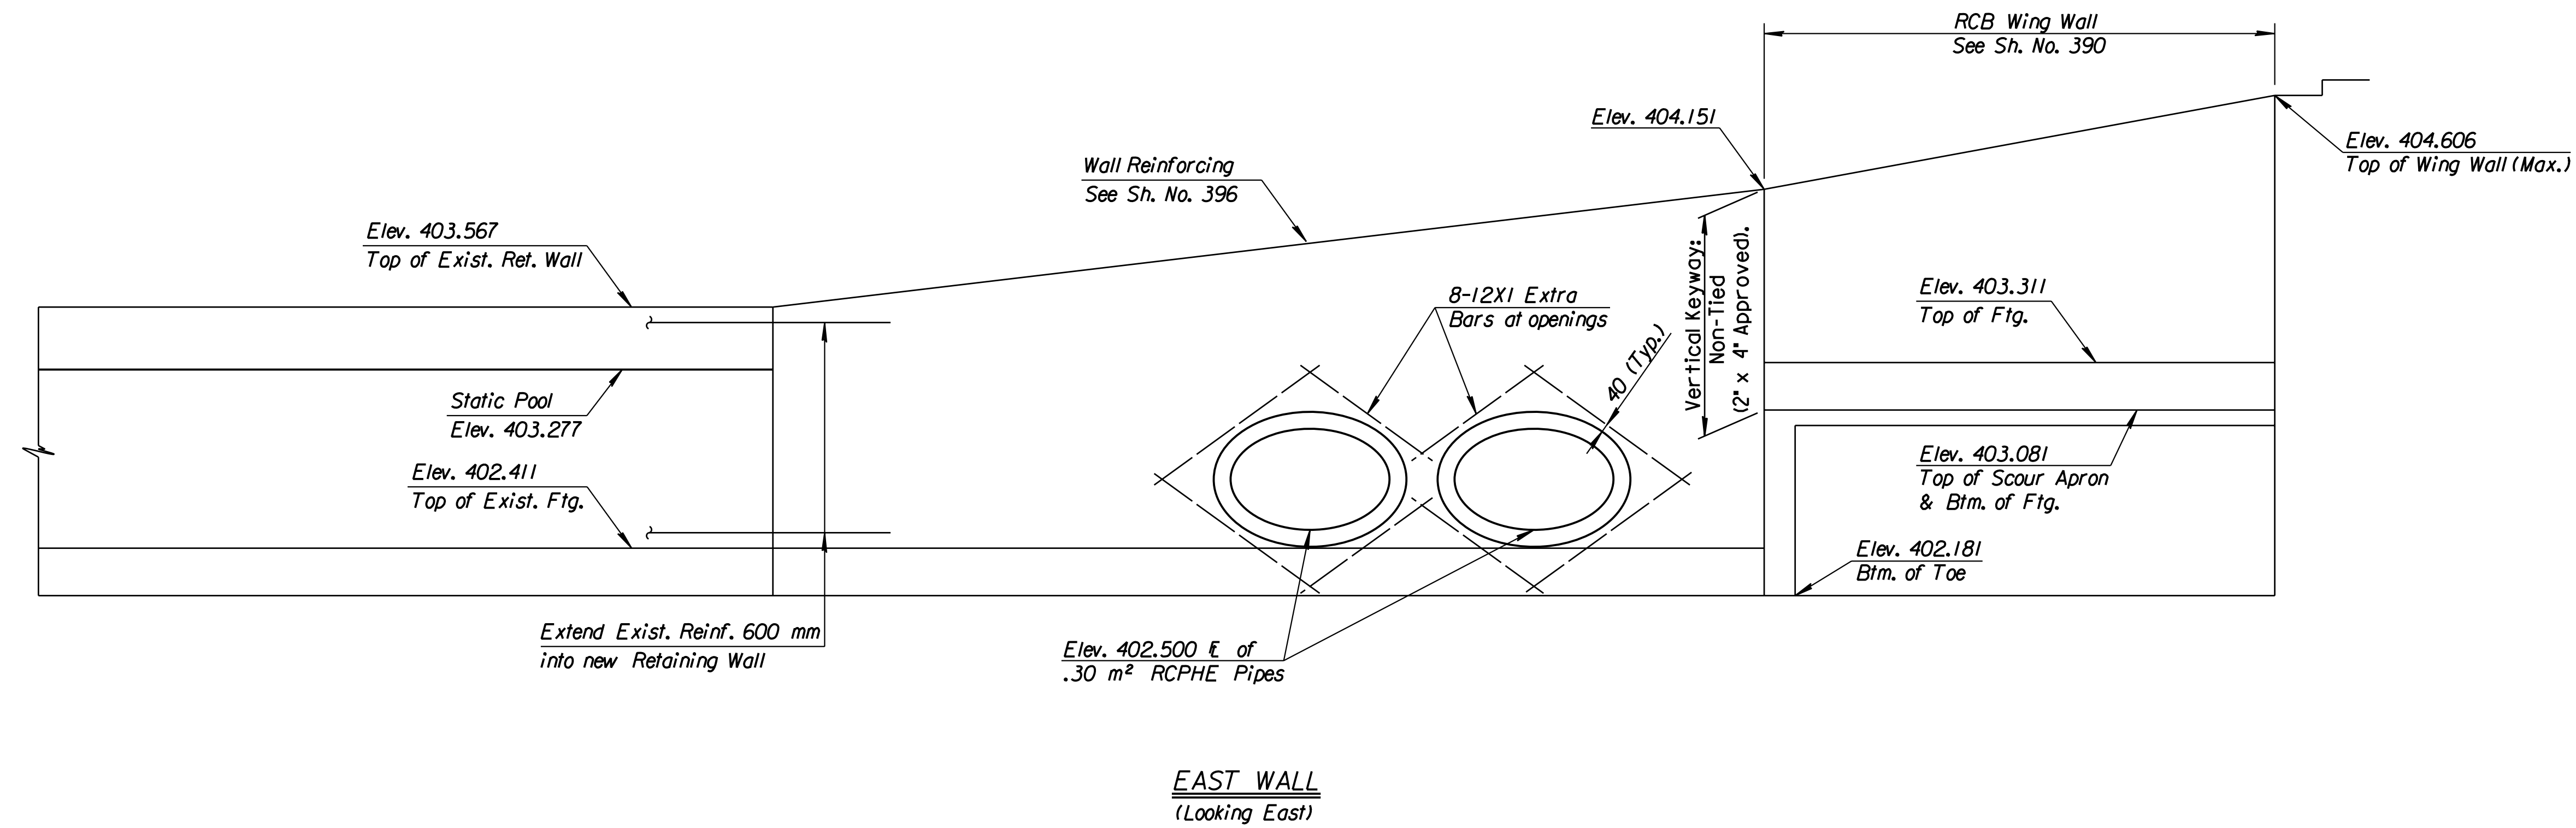

DSWR: RWA OPER: DRP SCALE: 1:20  
 i:/1997/97362/As-Builts/dgn's/VoL\_2/Sh\_397-WingDetail.dgn Last Rev.: 8-28-07 By: gdr

**RECORD DRAWING**

No.	Revisions	By	Date
KANSAS DEPARTMENT OF TRANSPORTATION <b>EXTENDED WING WALL DETAILS</b> PROJECT NO. 54-87 K-6657-01 SEDGWICK COUNTY			
<b>Professional Engineering Consultants, P.A.</b> 303 S. TOPEKA • WICHITA, KANSAS 67202 316-262-2691 • FAX 316-262-3003			
Designed by	RWA	Checked by	RAS
Drawn by	DRP	Date	Apr 11, 2002 Job No. 97362