



STATE	PROJECT NO.	YEAR	SHEET NO.	TOTAL SHEETS
KANSAS	54-87 K-6657-01	2002	406	1122

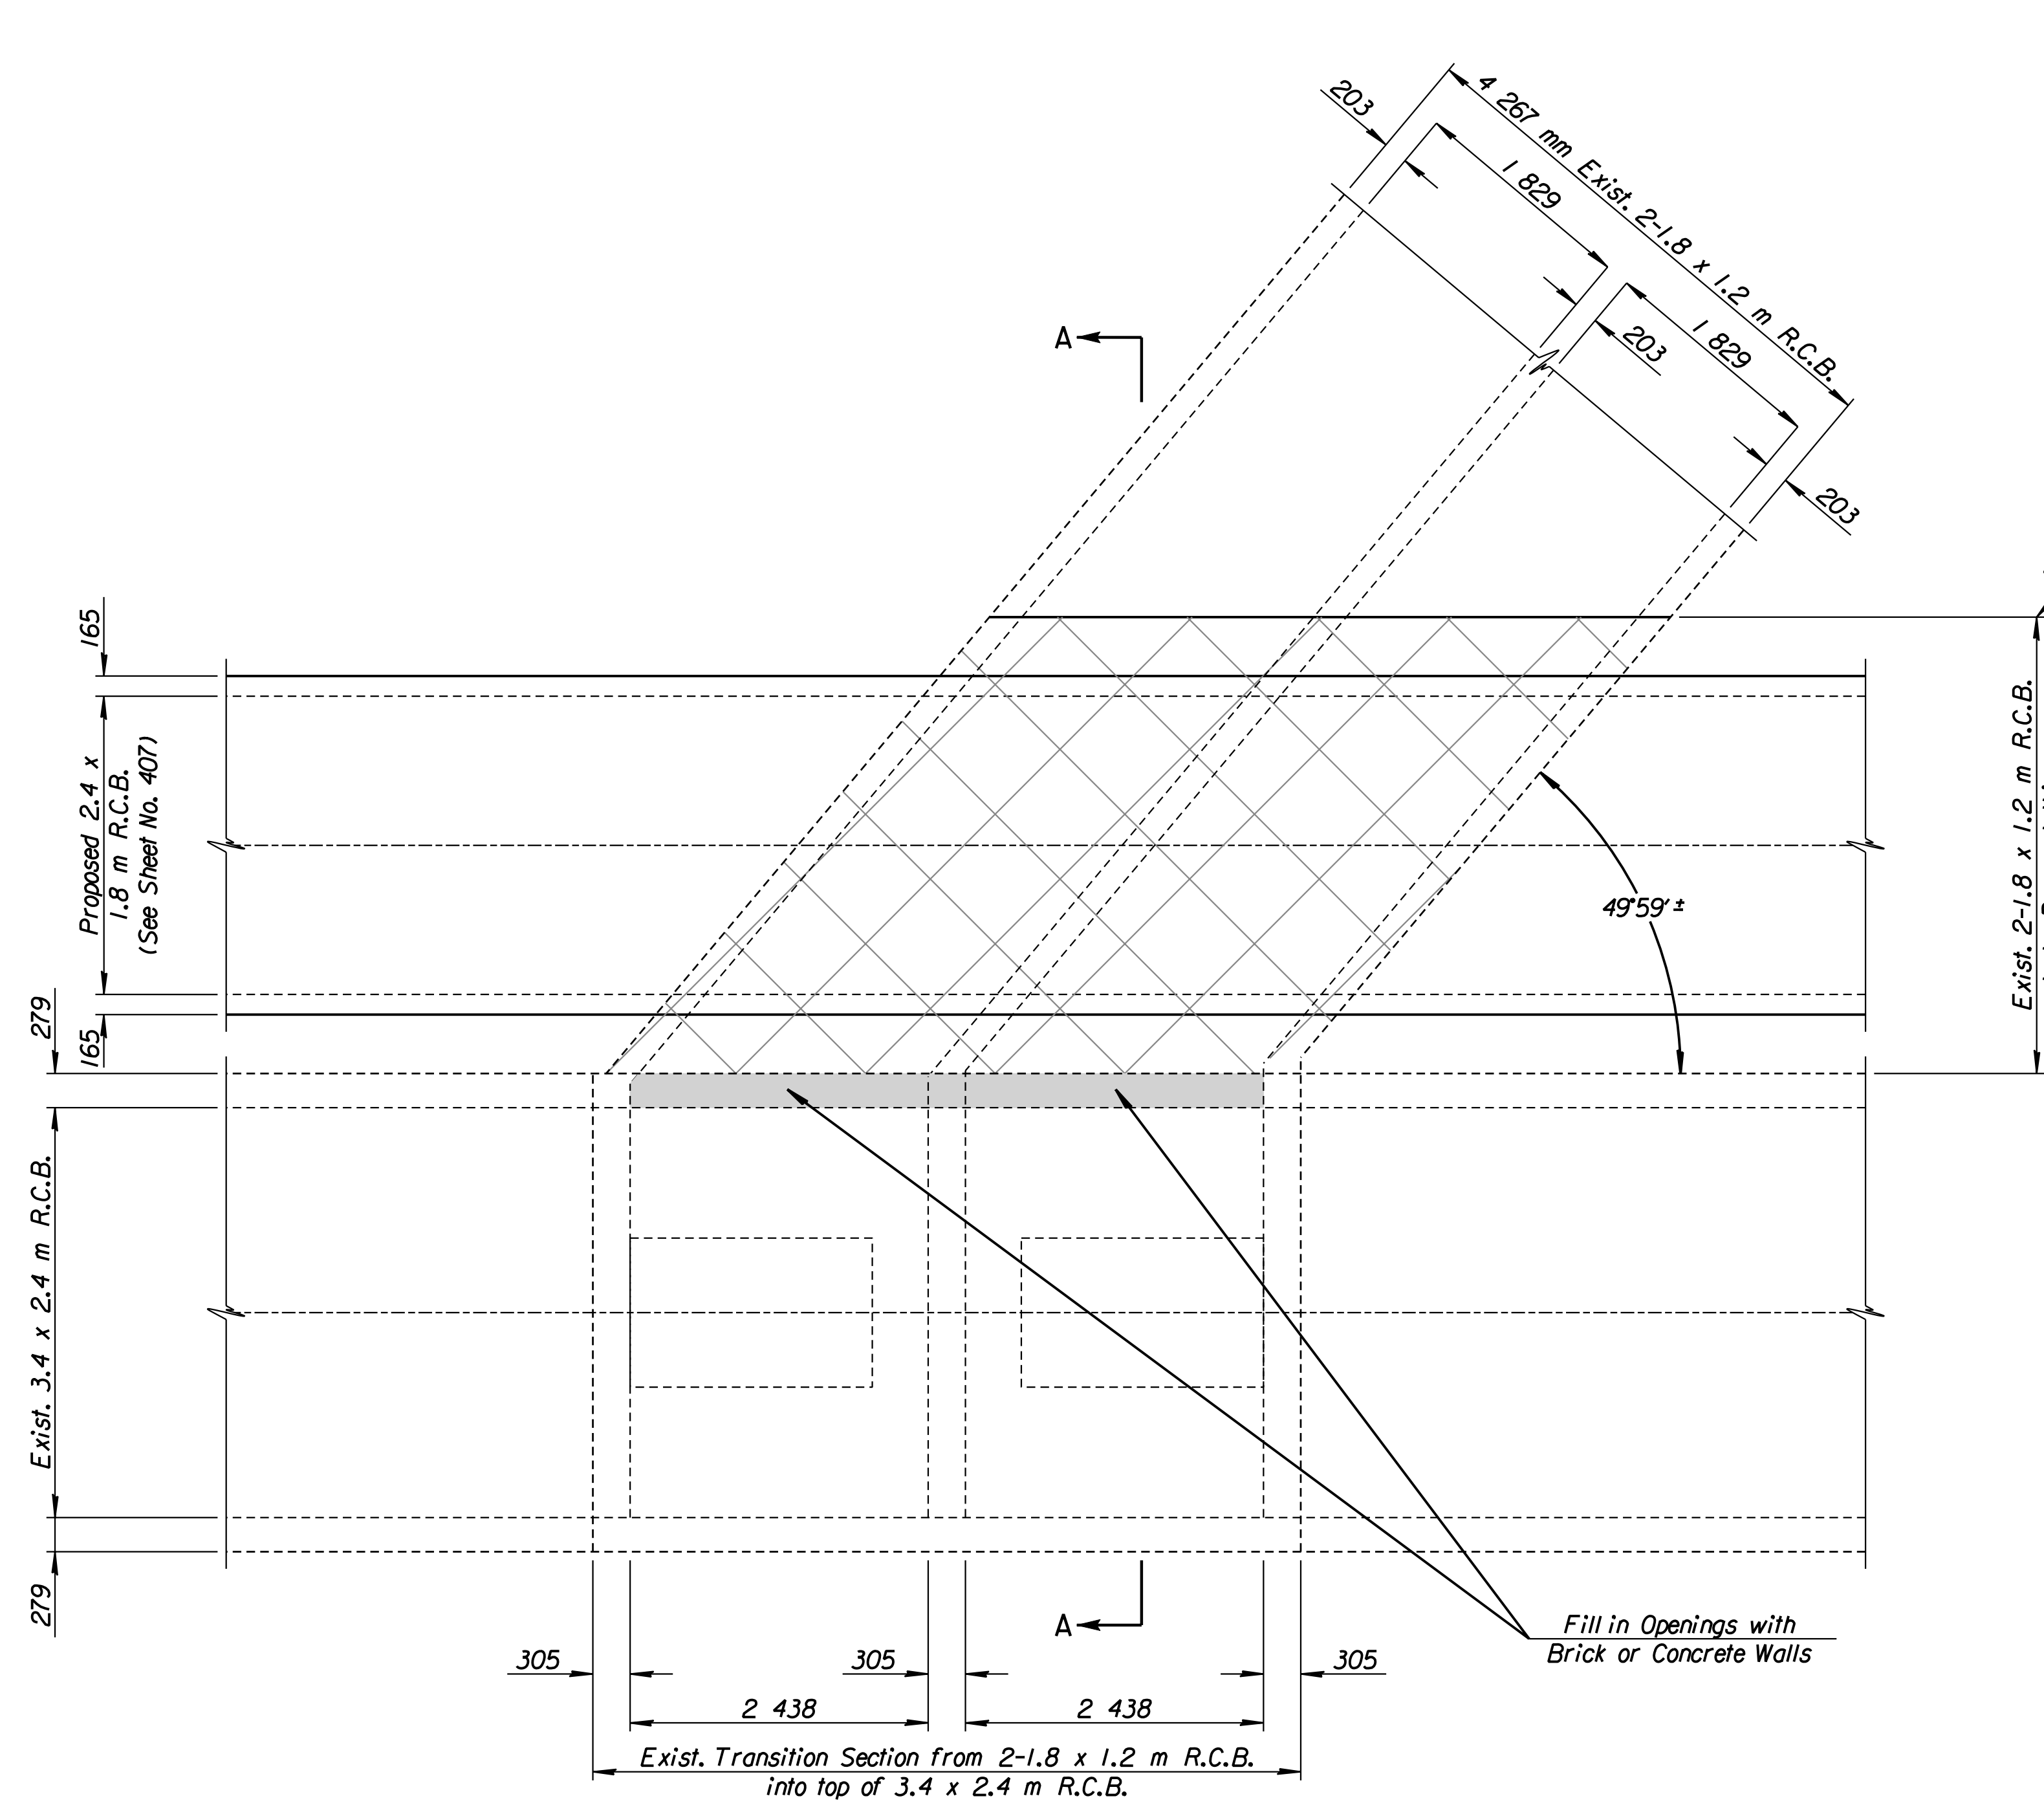

PLAN

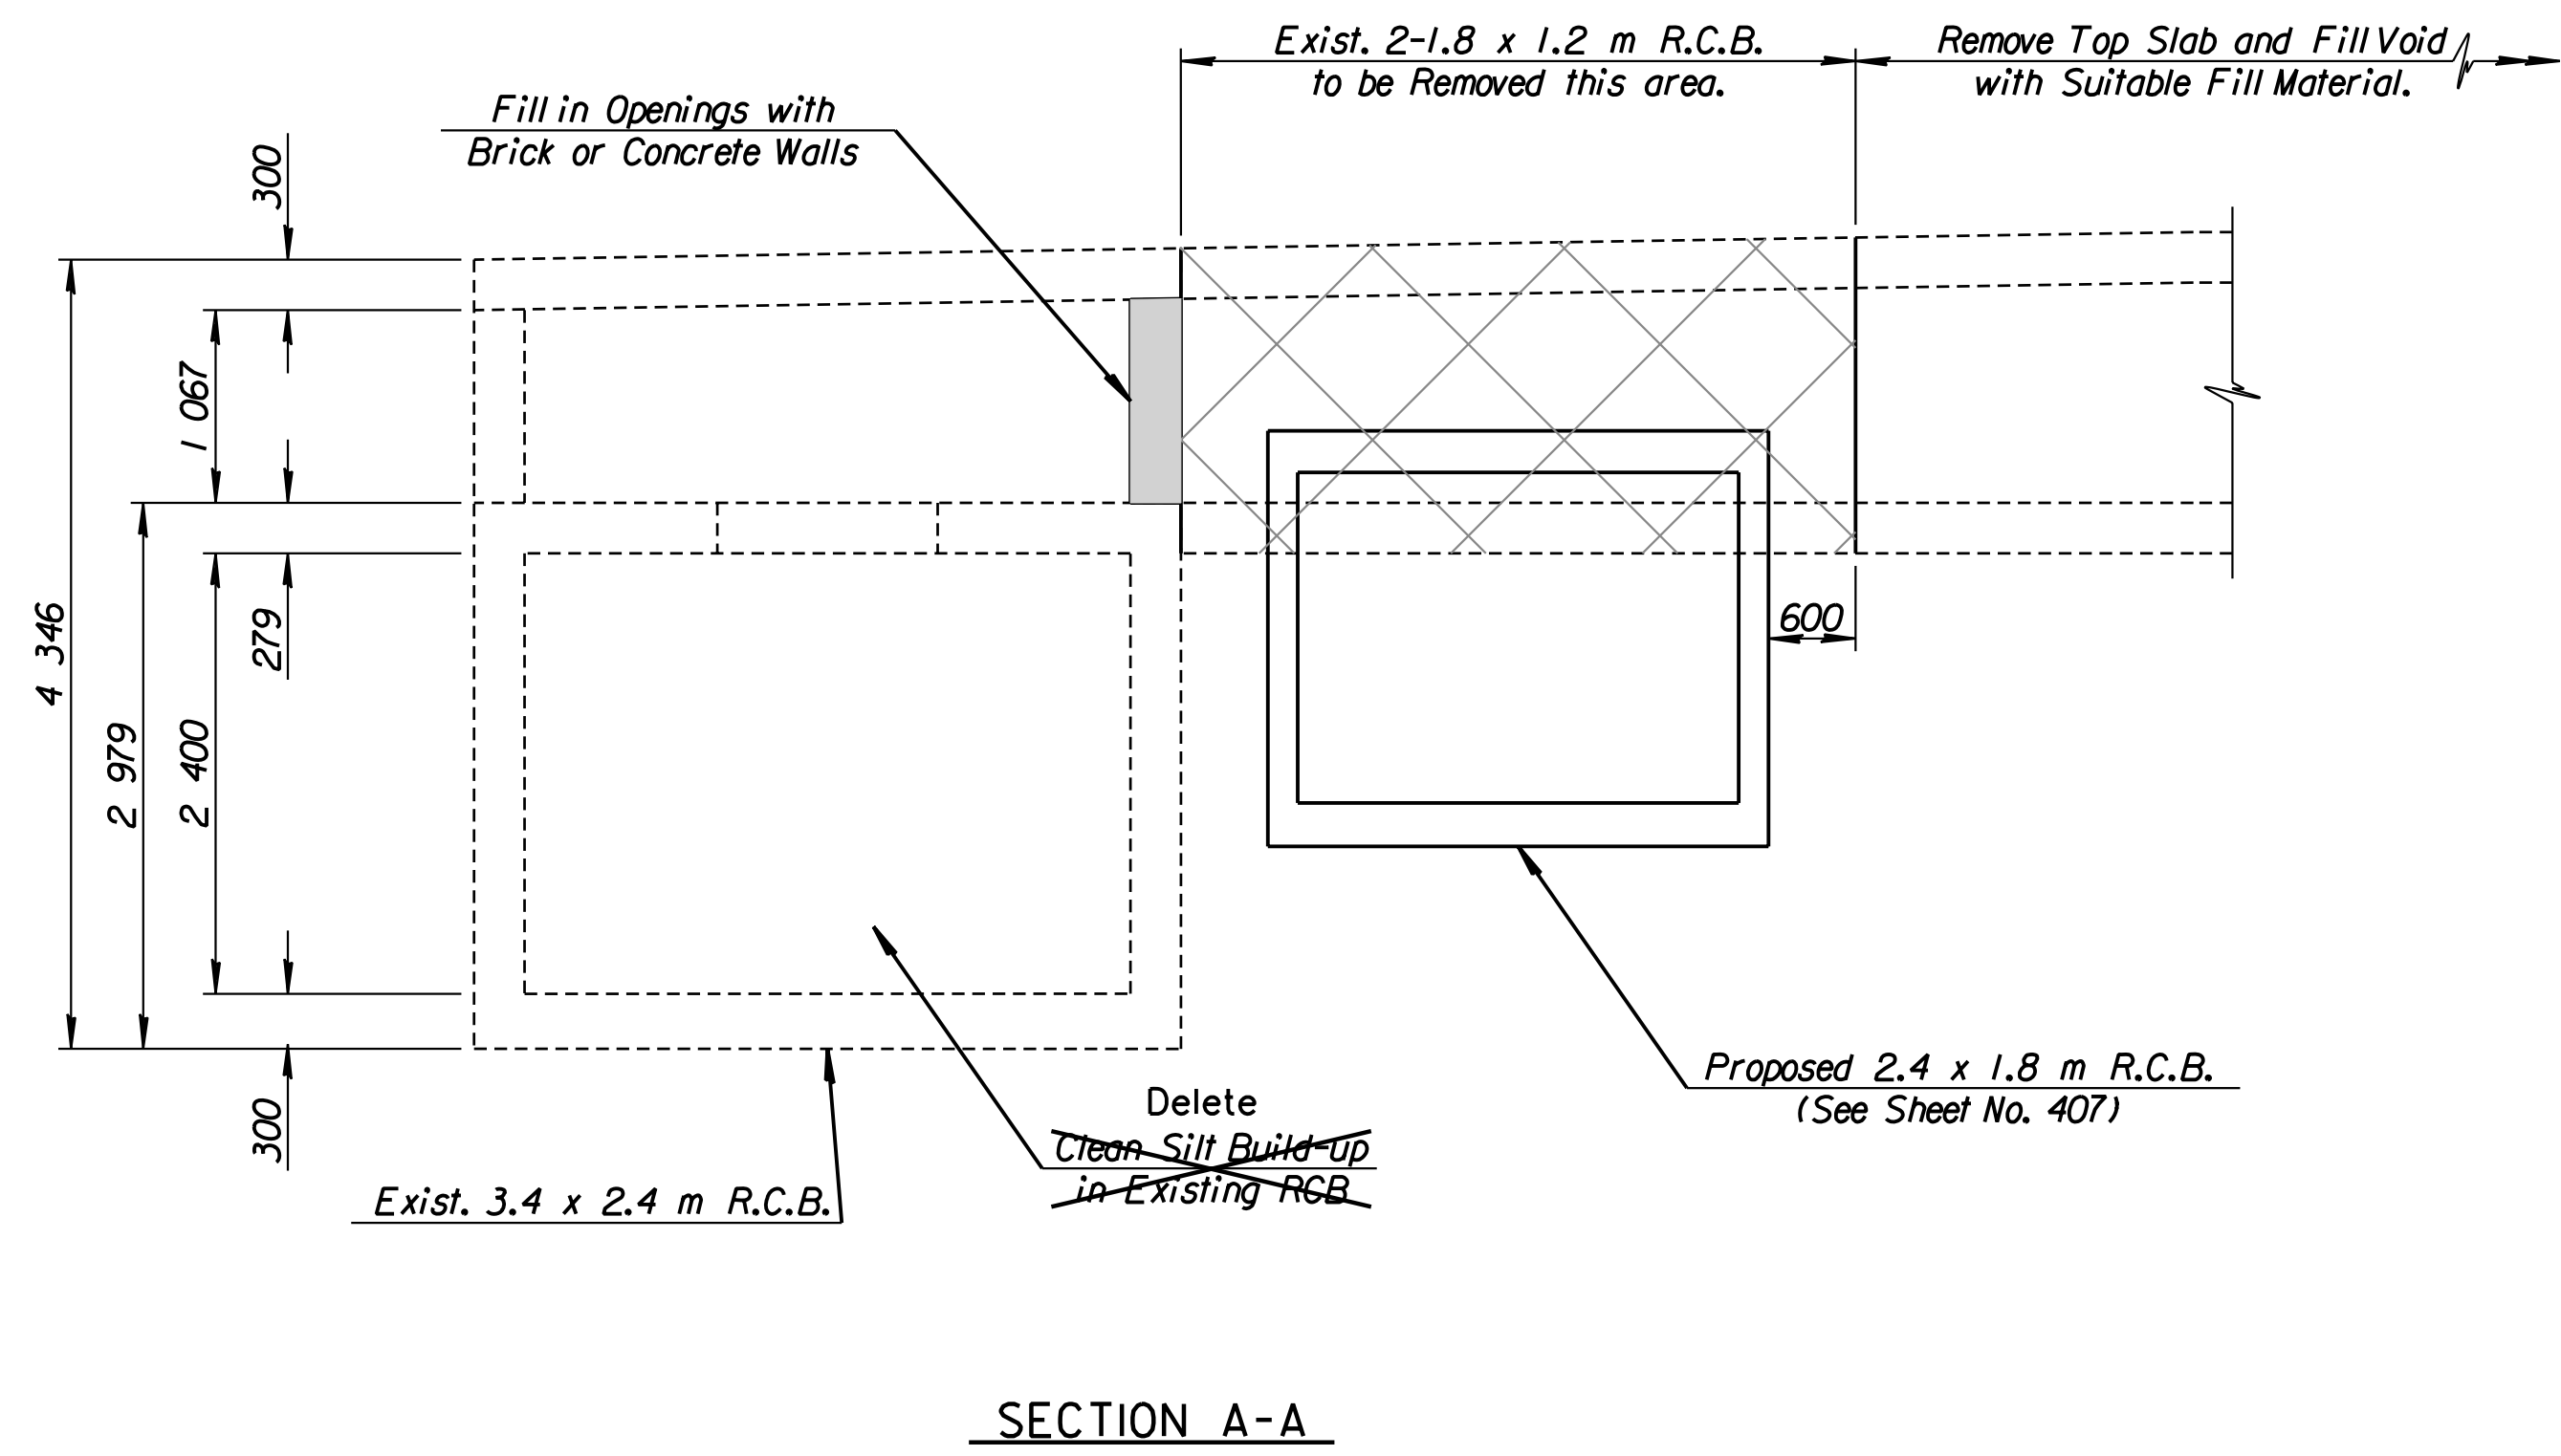

ADDENDUM #1:
 Sheet 406 Delete note to clean silt from the existing 3.4 x 2.4 m RCB. The Contractor will not be required to clean debris out of the existing 3.4 x 2.4 m RCB.

Plotted by: ras 2-11-2002
 I:/1997/97362/As-Builts/dgn/s/Vol_2/Sh_406-24xingE.x.dgn.dgn Last Rev.: 8-28-07 By: gdr

RECORD DRAWING

1			
No.	Revisions	By	Date
CITY OF WICHITA Sta. 17+090.000			
REMOVAL OF 2-1.8 x 1.2 m R.C.B. SECTION			
KELLOGG (US-54)			
SEDGWICK COUNTY			
Professional Engineering Consultants, P.A. 303 S. TOPEKA • WICHITA, KANSAS 67202 316-262-2691 • FAX 316-262-3003			
Designed by	RWA	Checked by	RAS
Drawn by	GDR	Date	April, 2002 Job No. 97362