




STATE	PROJECT NO.	YEAR	SHEET NO.	TOTAL SHEETS
KANSAS	54-87 K-6657-01	2002	415	1122

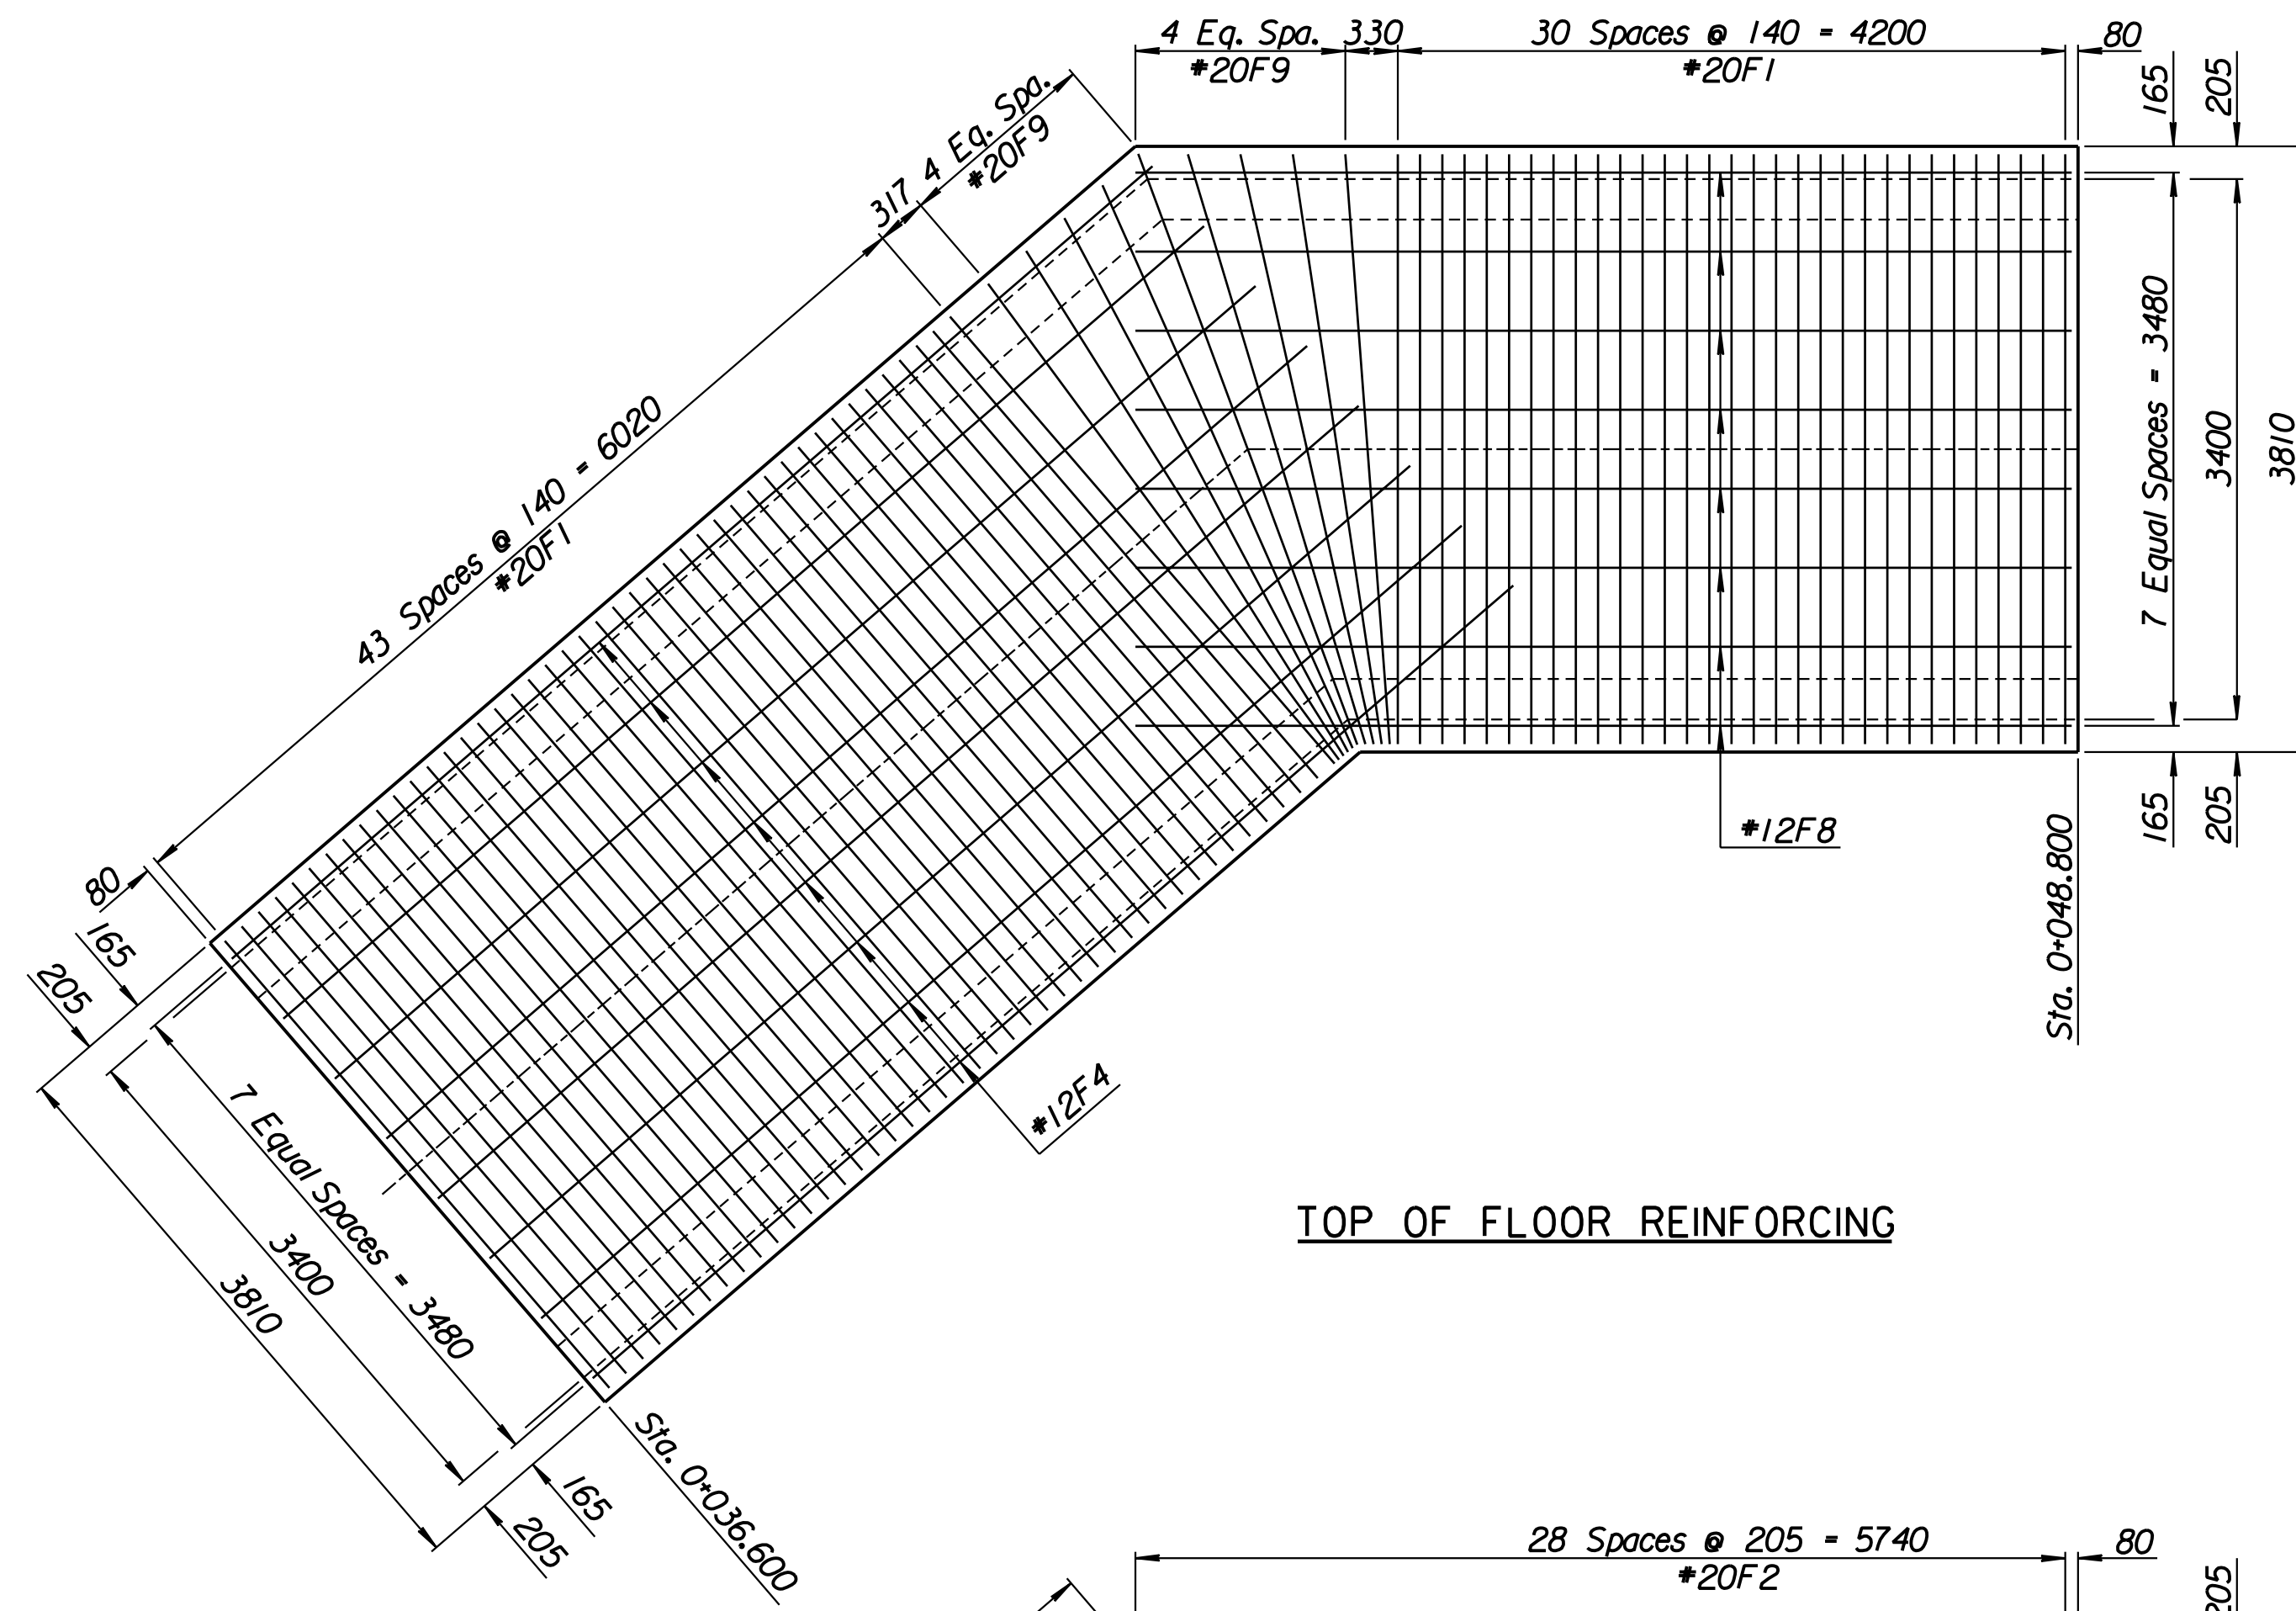


TOP OF FLOOR REINFORCING

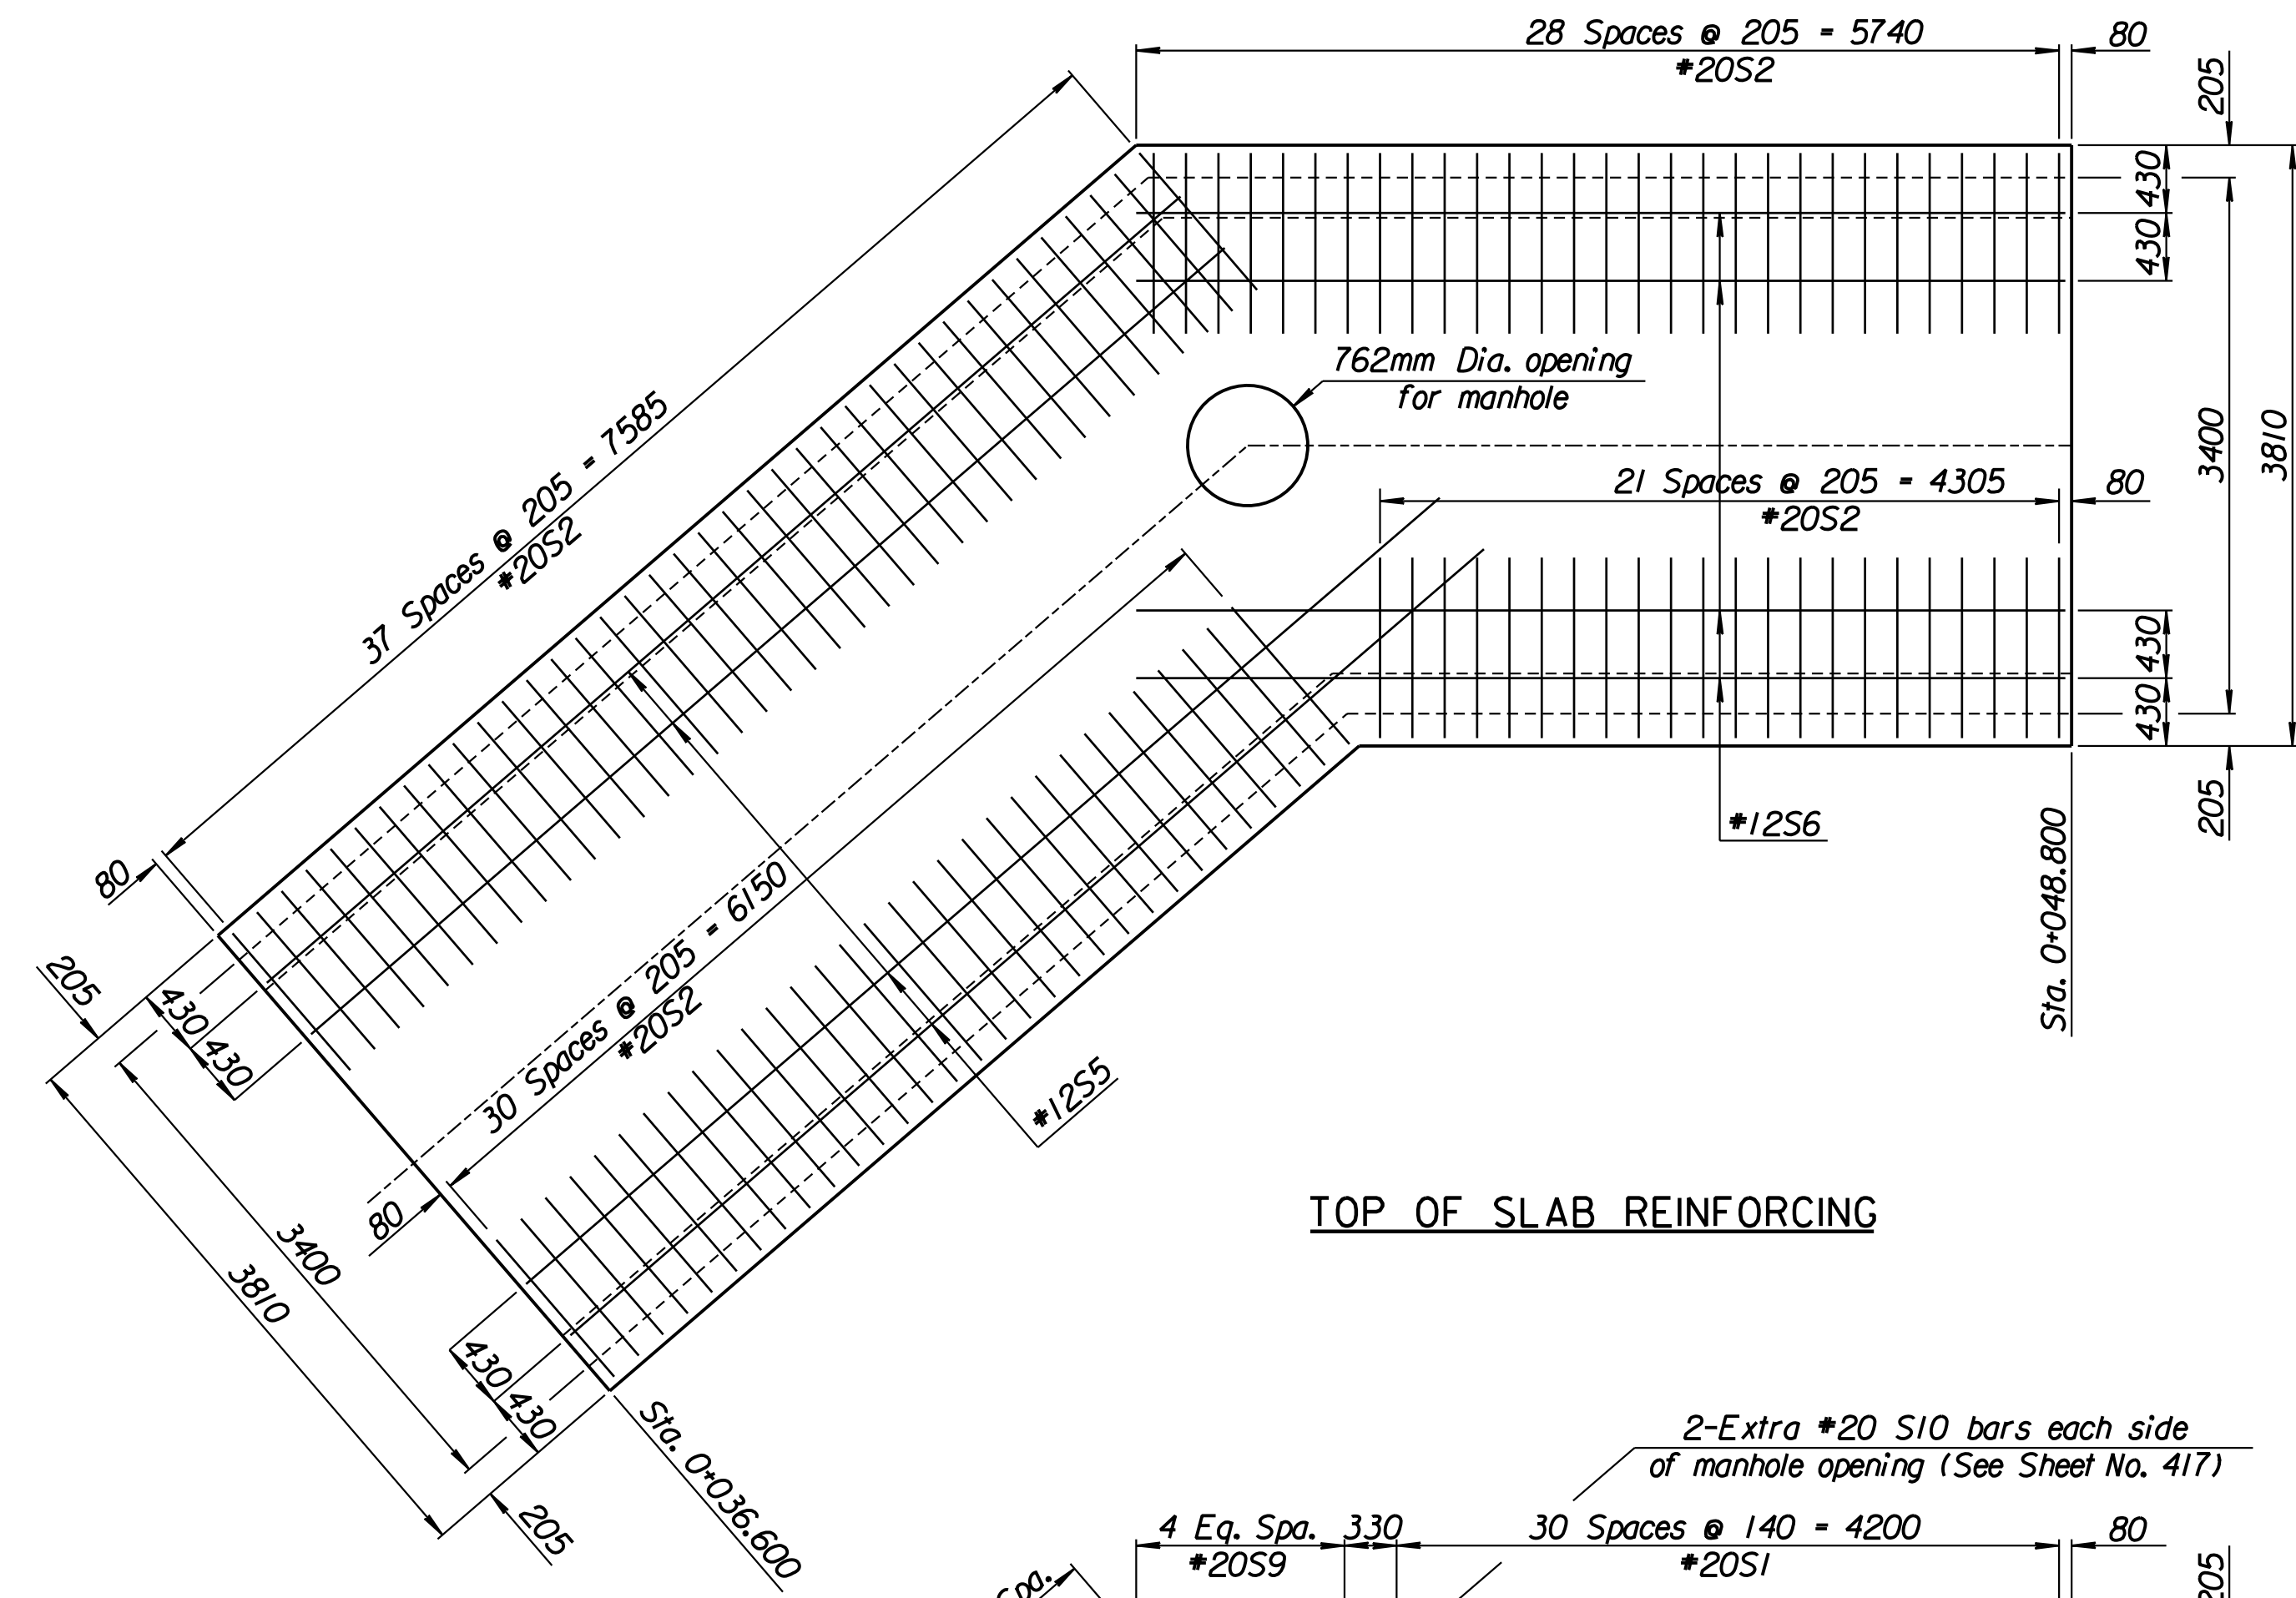

TOP OF SLAB REINFORCING

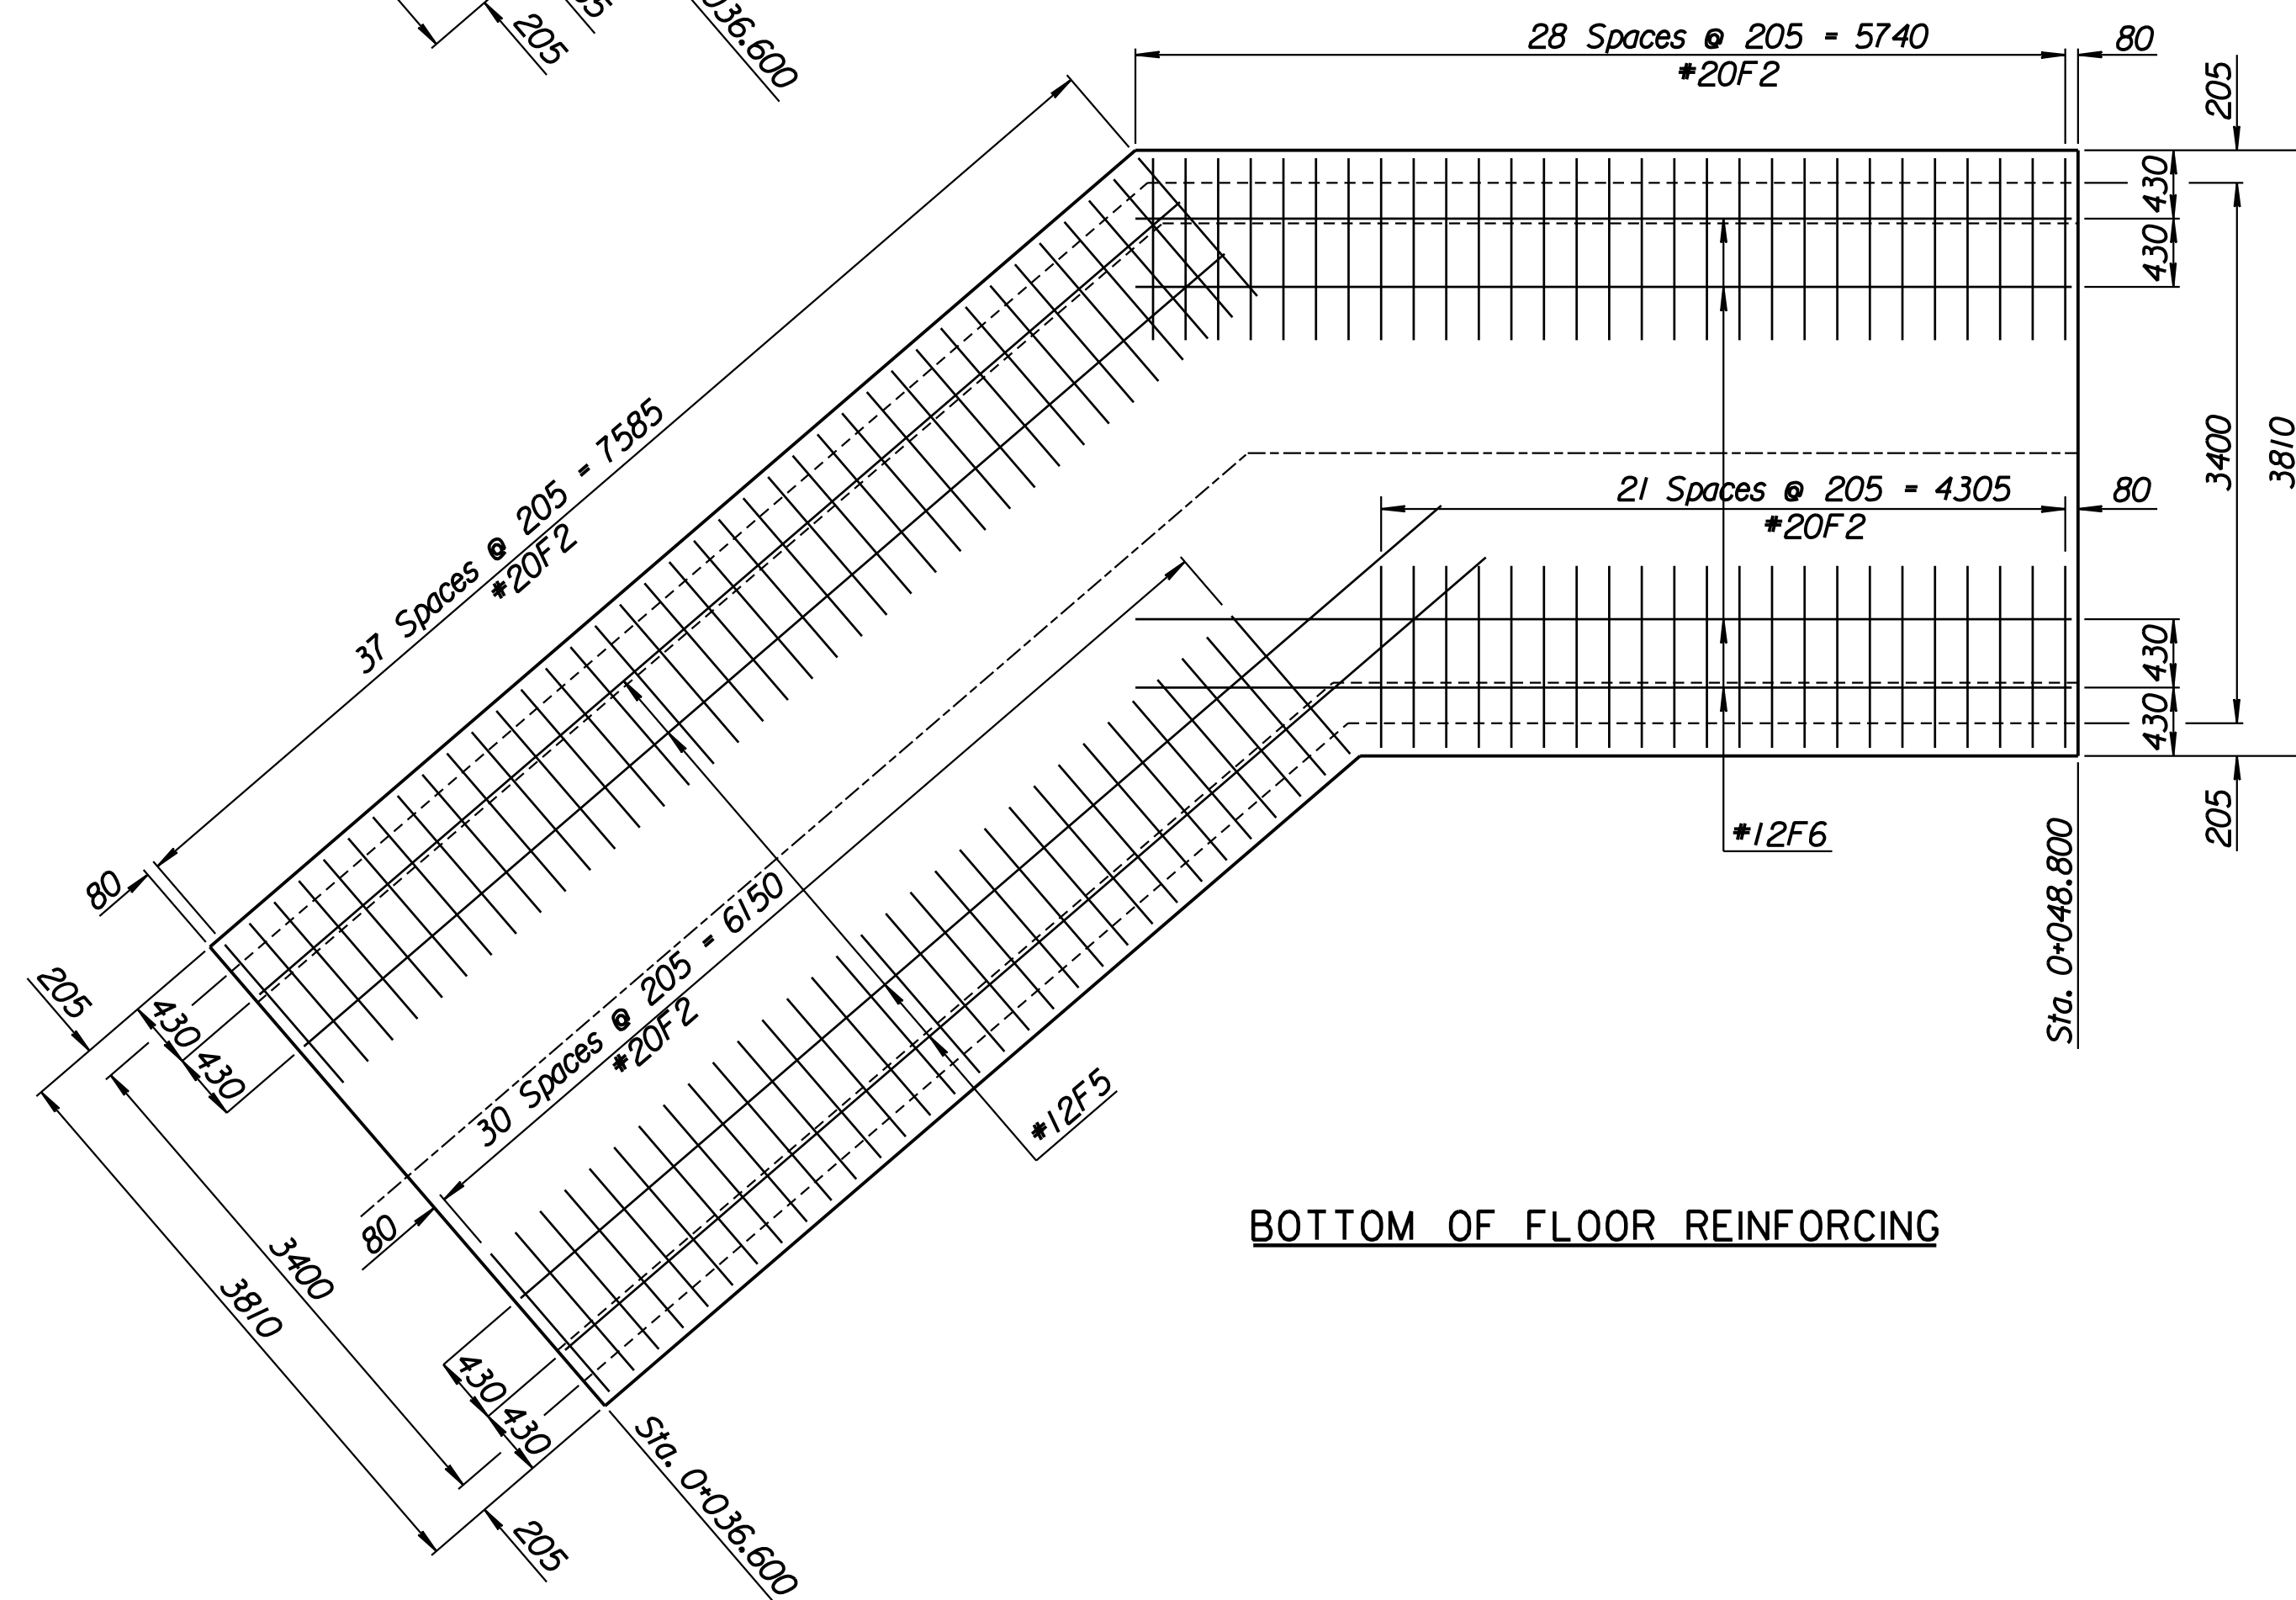

BOTTOM OF FLOOR REINFORCING

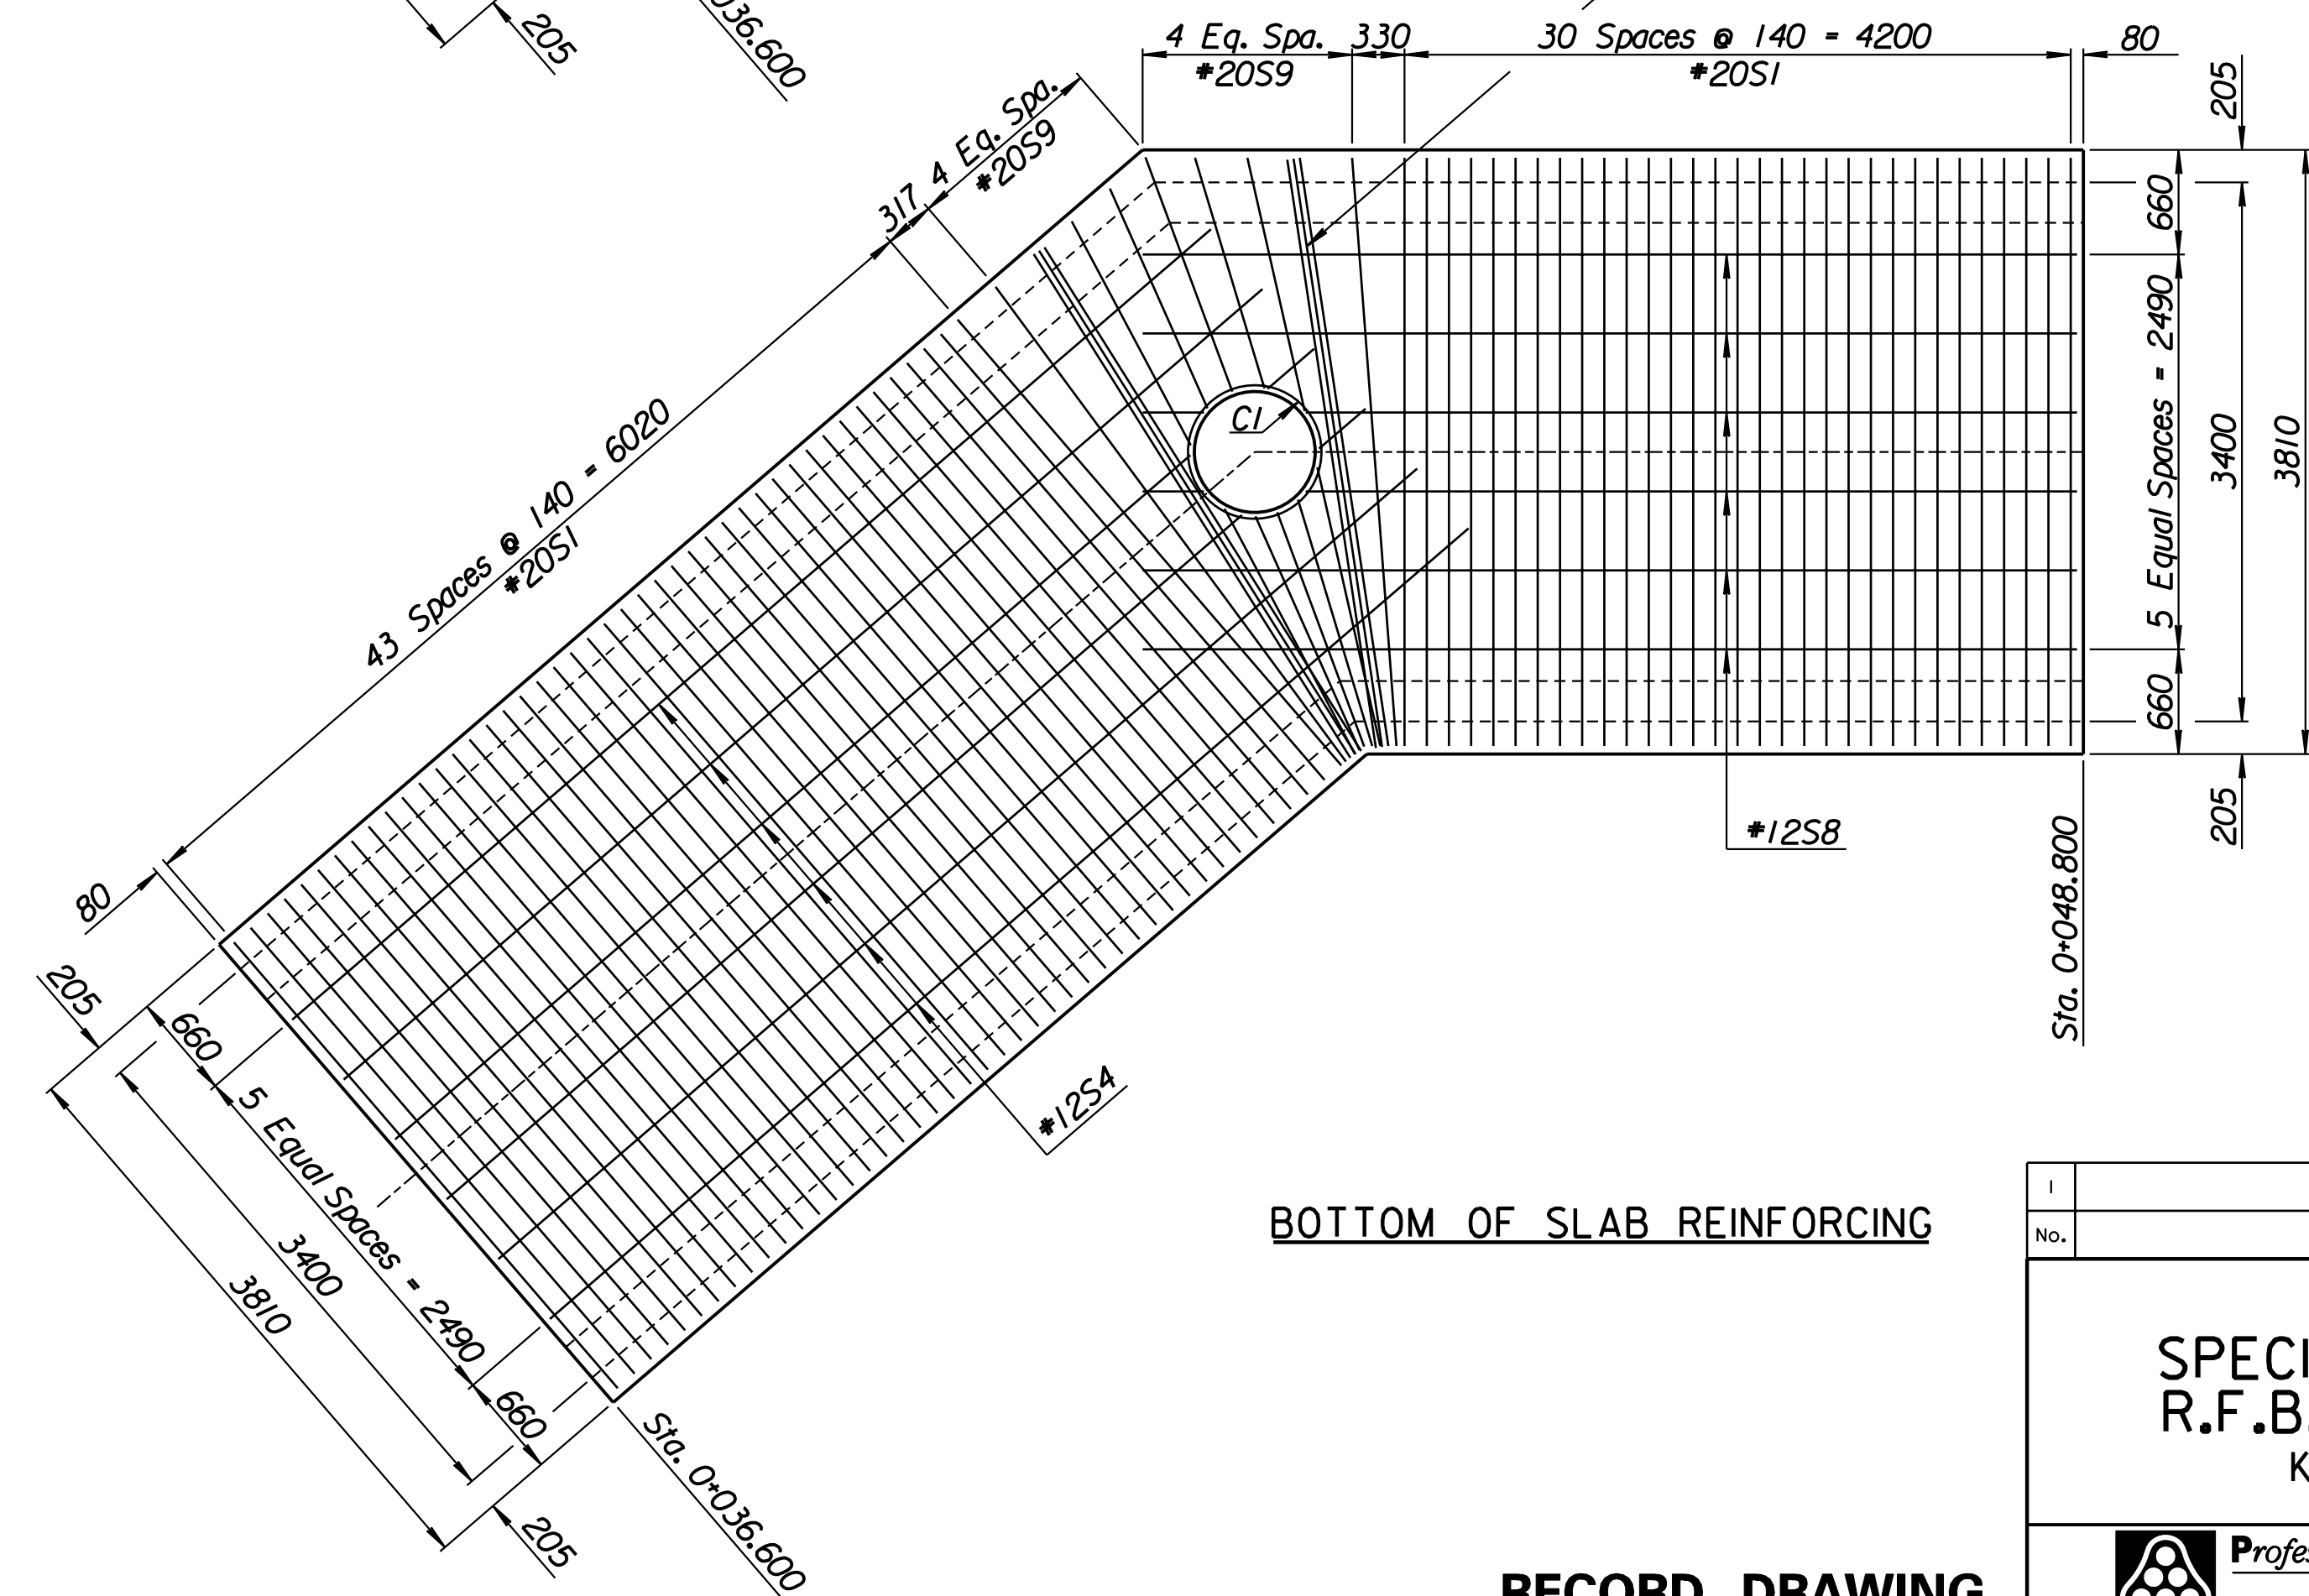

BOTTOM OF SLAB REINFORCING

Drawn by: wil  
 Plotted by: ras 2-9-2002  
 I:/1997/97362/As-Built/dgn/s/Vol\_2/Sh\_415-34BEND.dgn Last Rev: 8-28-07 By: gdr

RECORD DRAWING

1			
No.	Revisions	By	Date
CITY OF WICHITA			
SPECIAL 3.4x2.4x12.2M R.F.B. DETAILS AT P.I. KELLOGG (US-54)			
SEDGWICK COUNTY			
Professional Engineering Consultants, P.A. 303 S. TOPEKA • WICHITA, KANSAS 67202 316-262-2691 • FAX 316-262-3003			
Designed by	R.W.A.	Checked by	R.A.S.
Drawn by	W.L.L.	Date	April, 2002 Job No. 97362