



ELEVATION

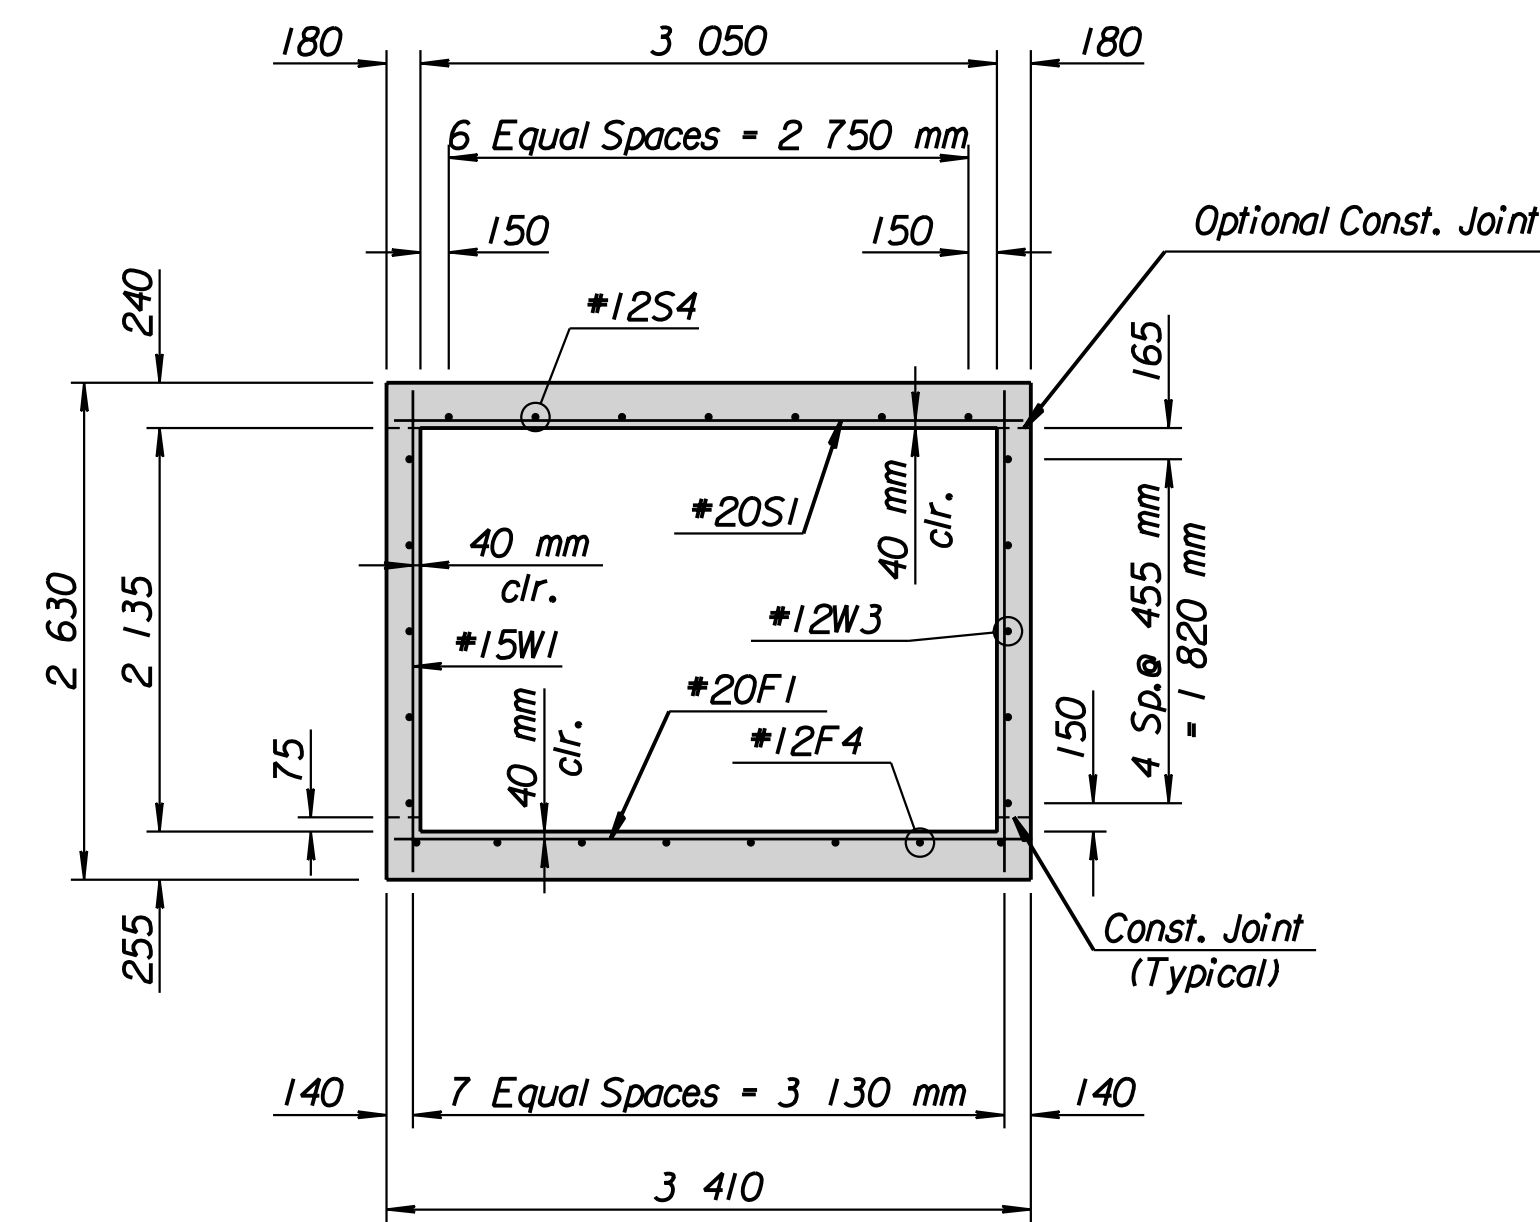

TYPICAL SECTION

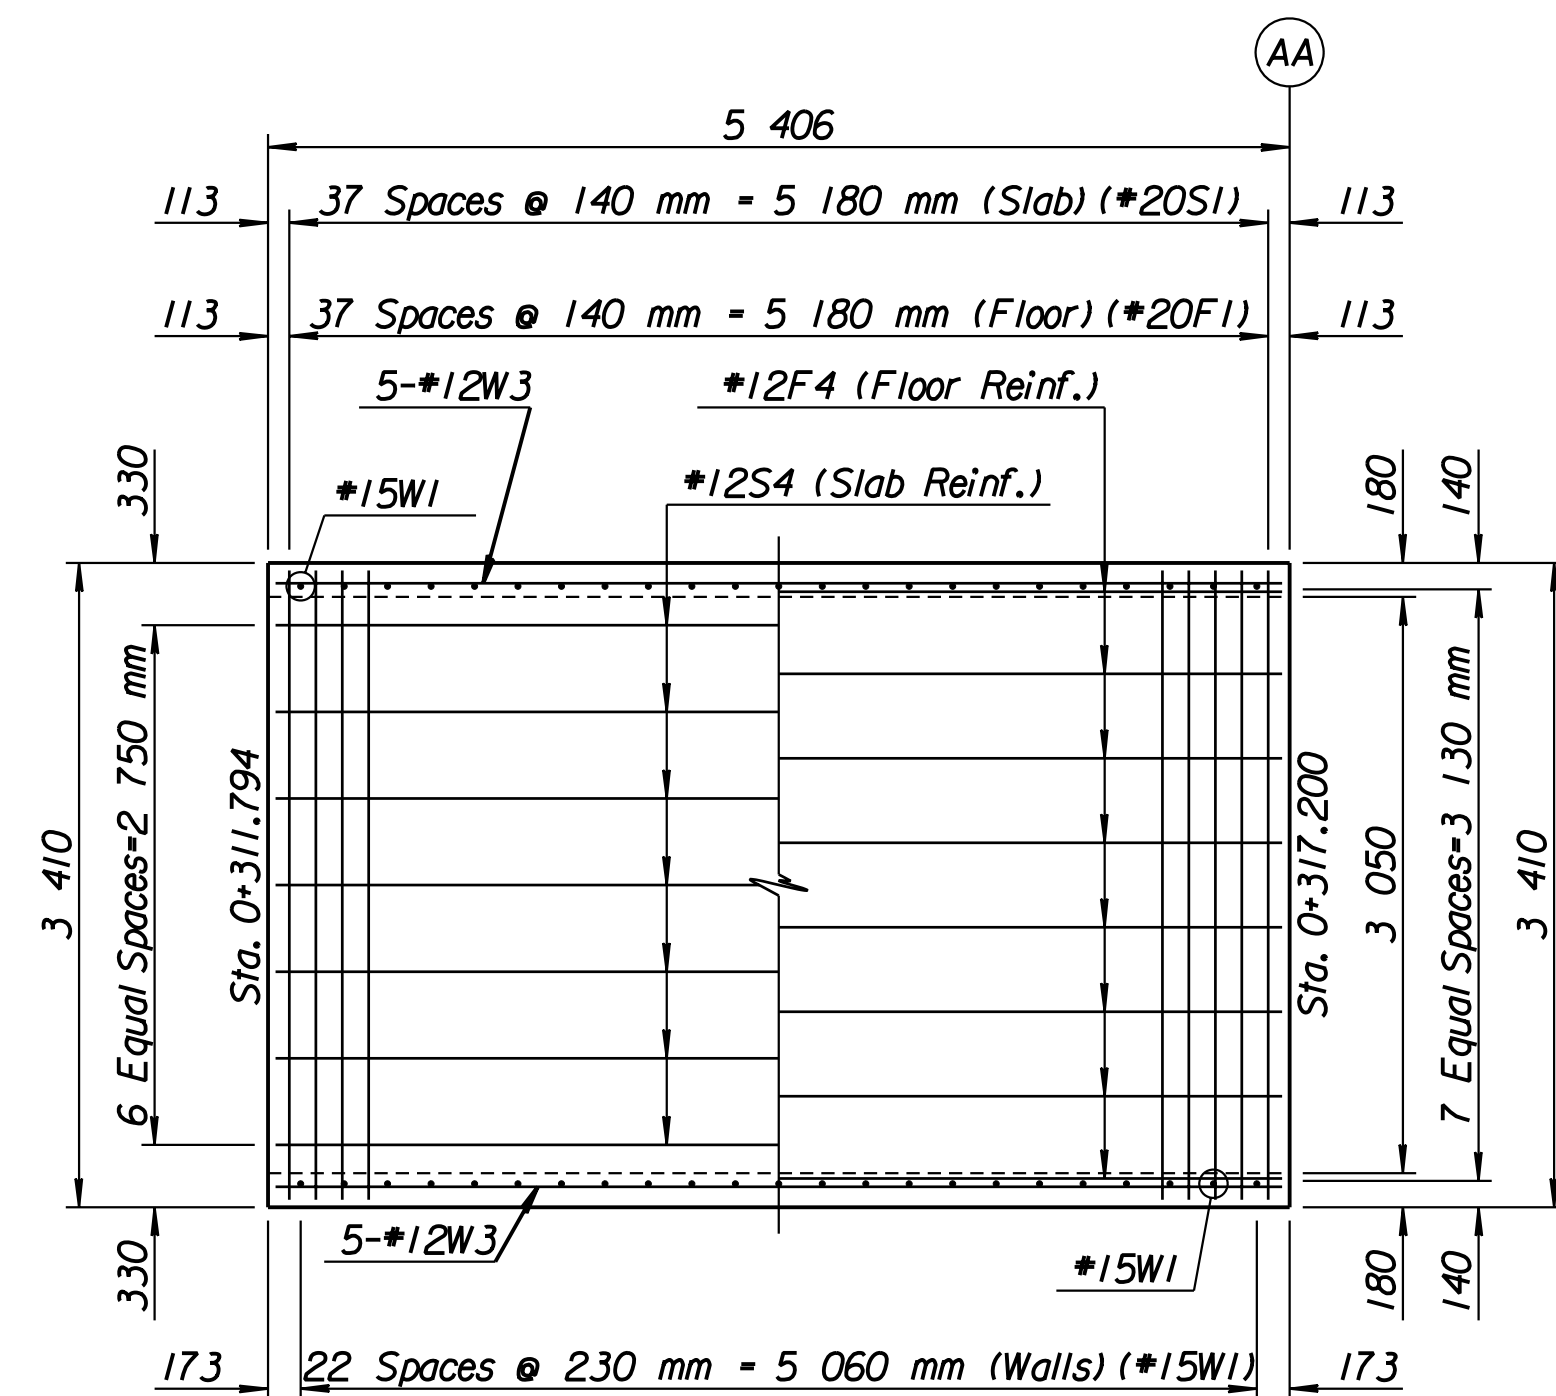

SLAB REINFORCEMENT FLOOR REINFORCEMENT

PLAN

REINFORCING STEEL							
Straight Bars				Bent Bars			
Mark	No.	Size	Length	Mark	No.	Size	Length
S1	38	*20	3 300				
S4	7	*12	5 300				
F1	38	*20	3 300				
F4	8	*12	5 300				
W1	46	*15	2 540				
W3	10	*12	5 300				

SUMMARY OF QUANTITIES		
Item	Quantity	Unit
Class AAA Concrete	13.3	m ³
Reinforcing Steel (Grade 420)	906	kg

Note:
See Plan and Profile Sheets for location of this Special R.C.B. Section.

See Sheet No. 413 for General Notes.

1			
No.	Revisions	By	Date
CITY OF WICHITA			
SPECIAL 3.0 x 2.1 x 5.406 m R.C.B. SECTION KELLOGG (US-54)			
SEDGWICK COUNTY			
Professional Engineering Consultants, P.A. 303 S. TOPEKA • WICHITA, KANSAS 67202 316-262-2691 • FAX 316-262-3003			
Designed by	RWA	Checked by	RAS
Drawn by	GDR	Date	April, 2002
		Job No.	97362

RECORD DRAWING