




STATE	PROJECT NO.	YEAR	SHEET NO.	TOTAL SHEETS
KANSAS	54-87 K-6657-01	2002	423	1122

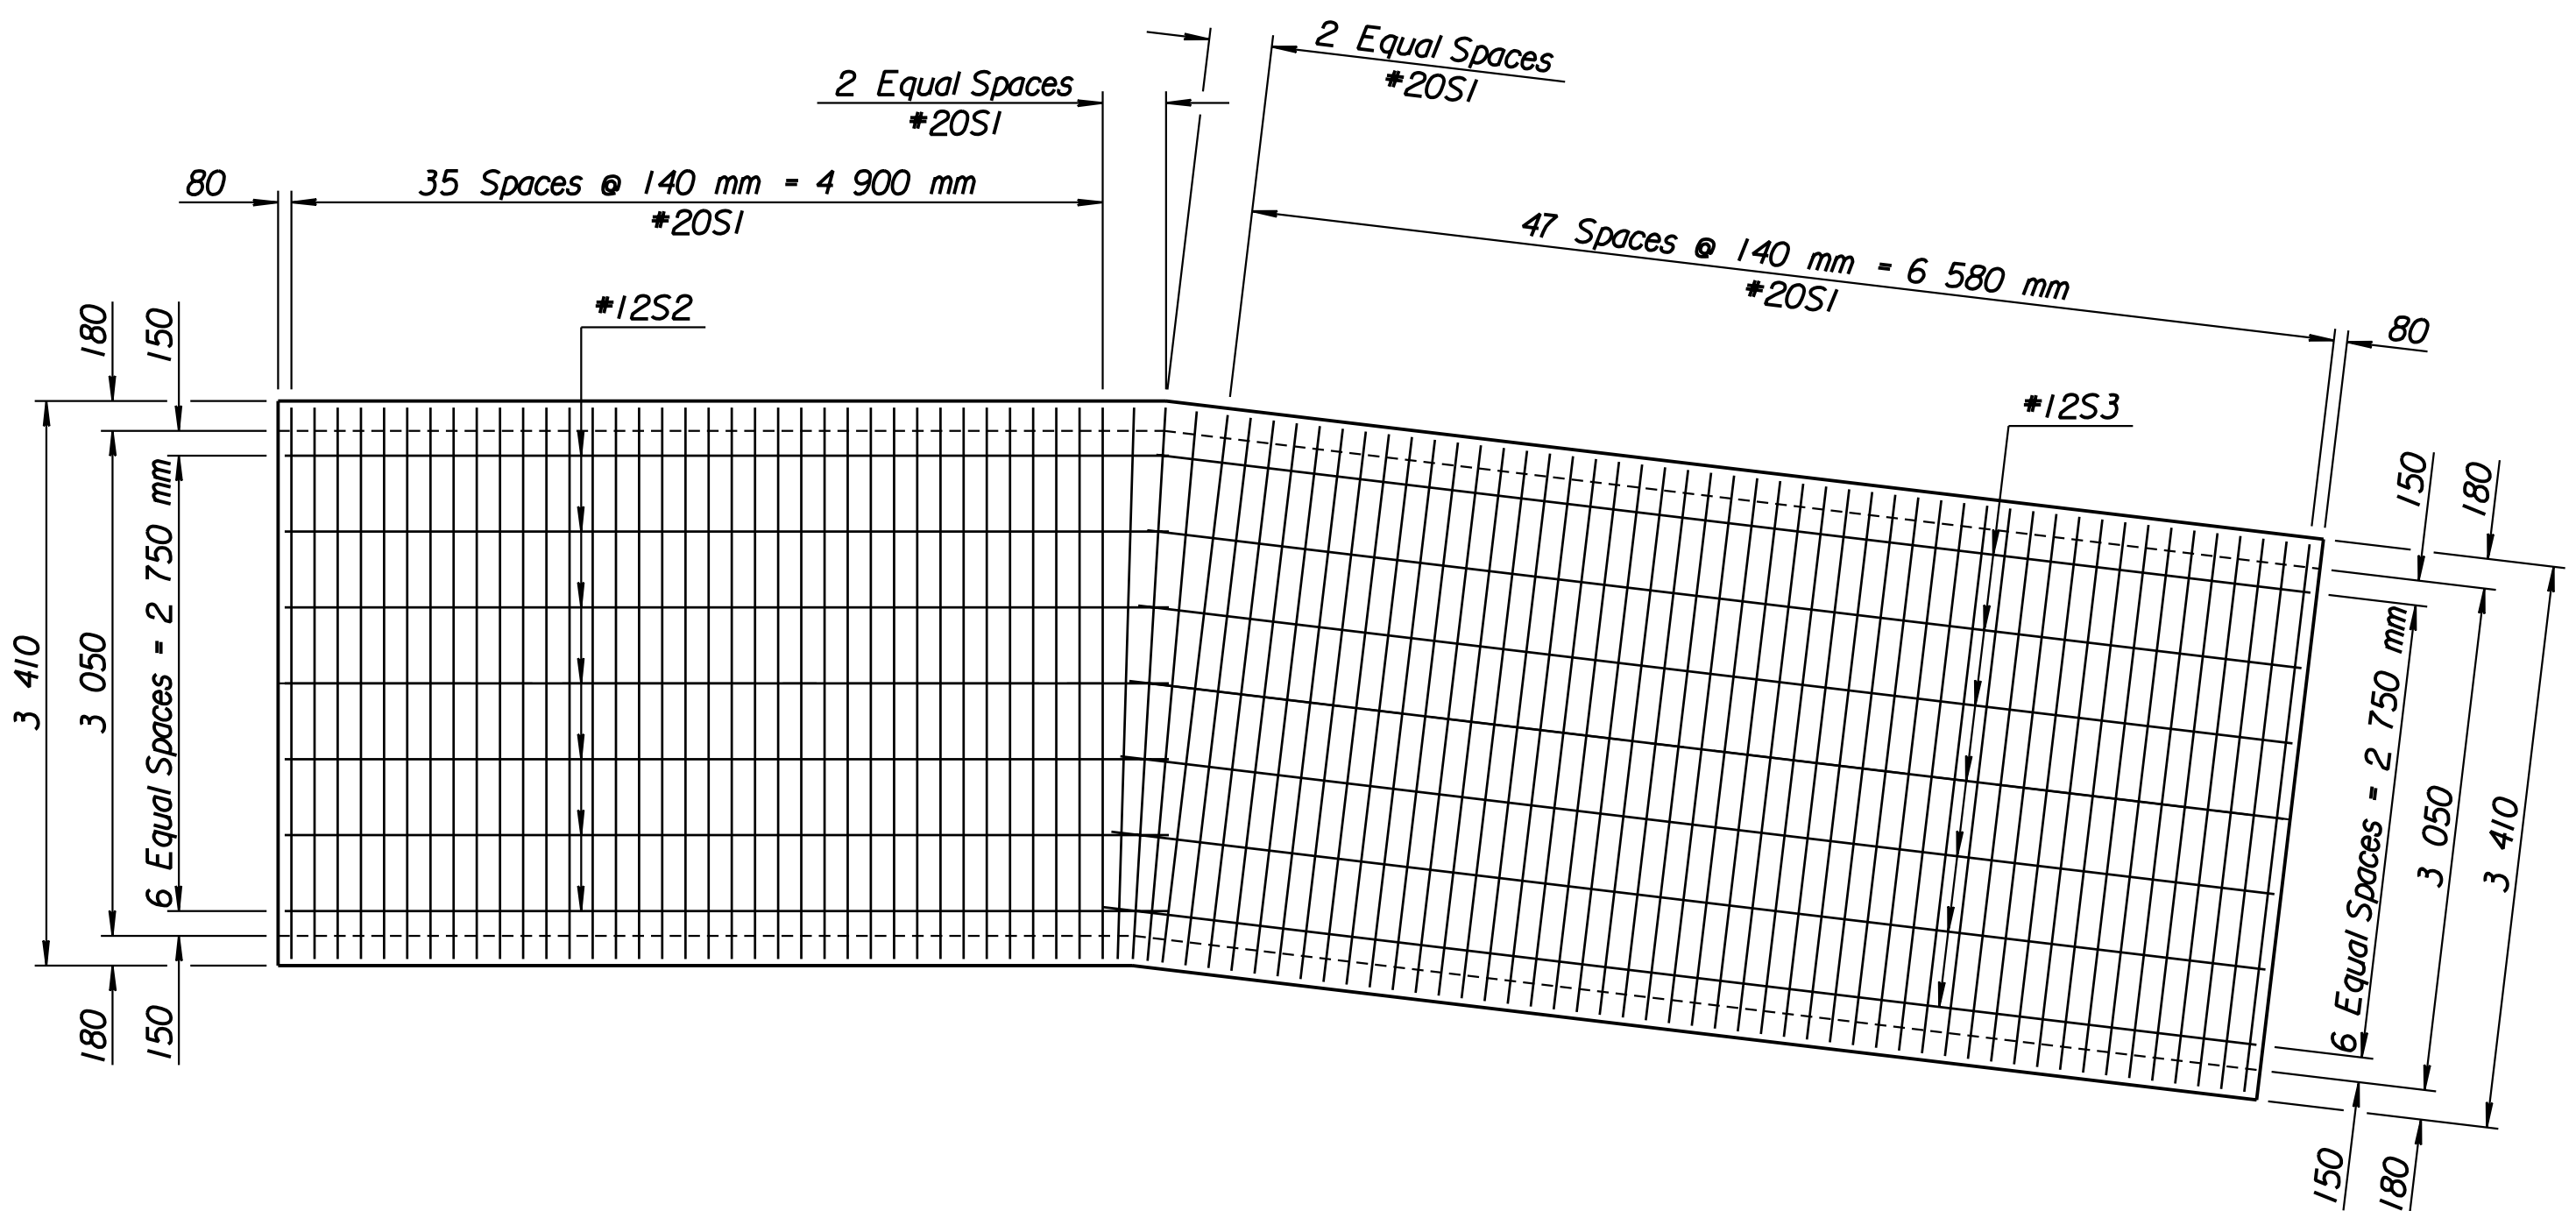

SLAB REINFORCING

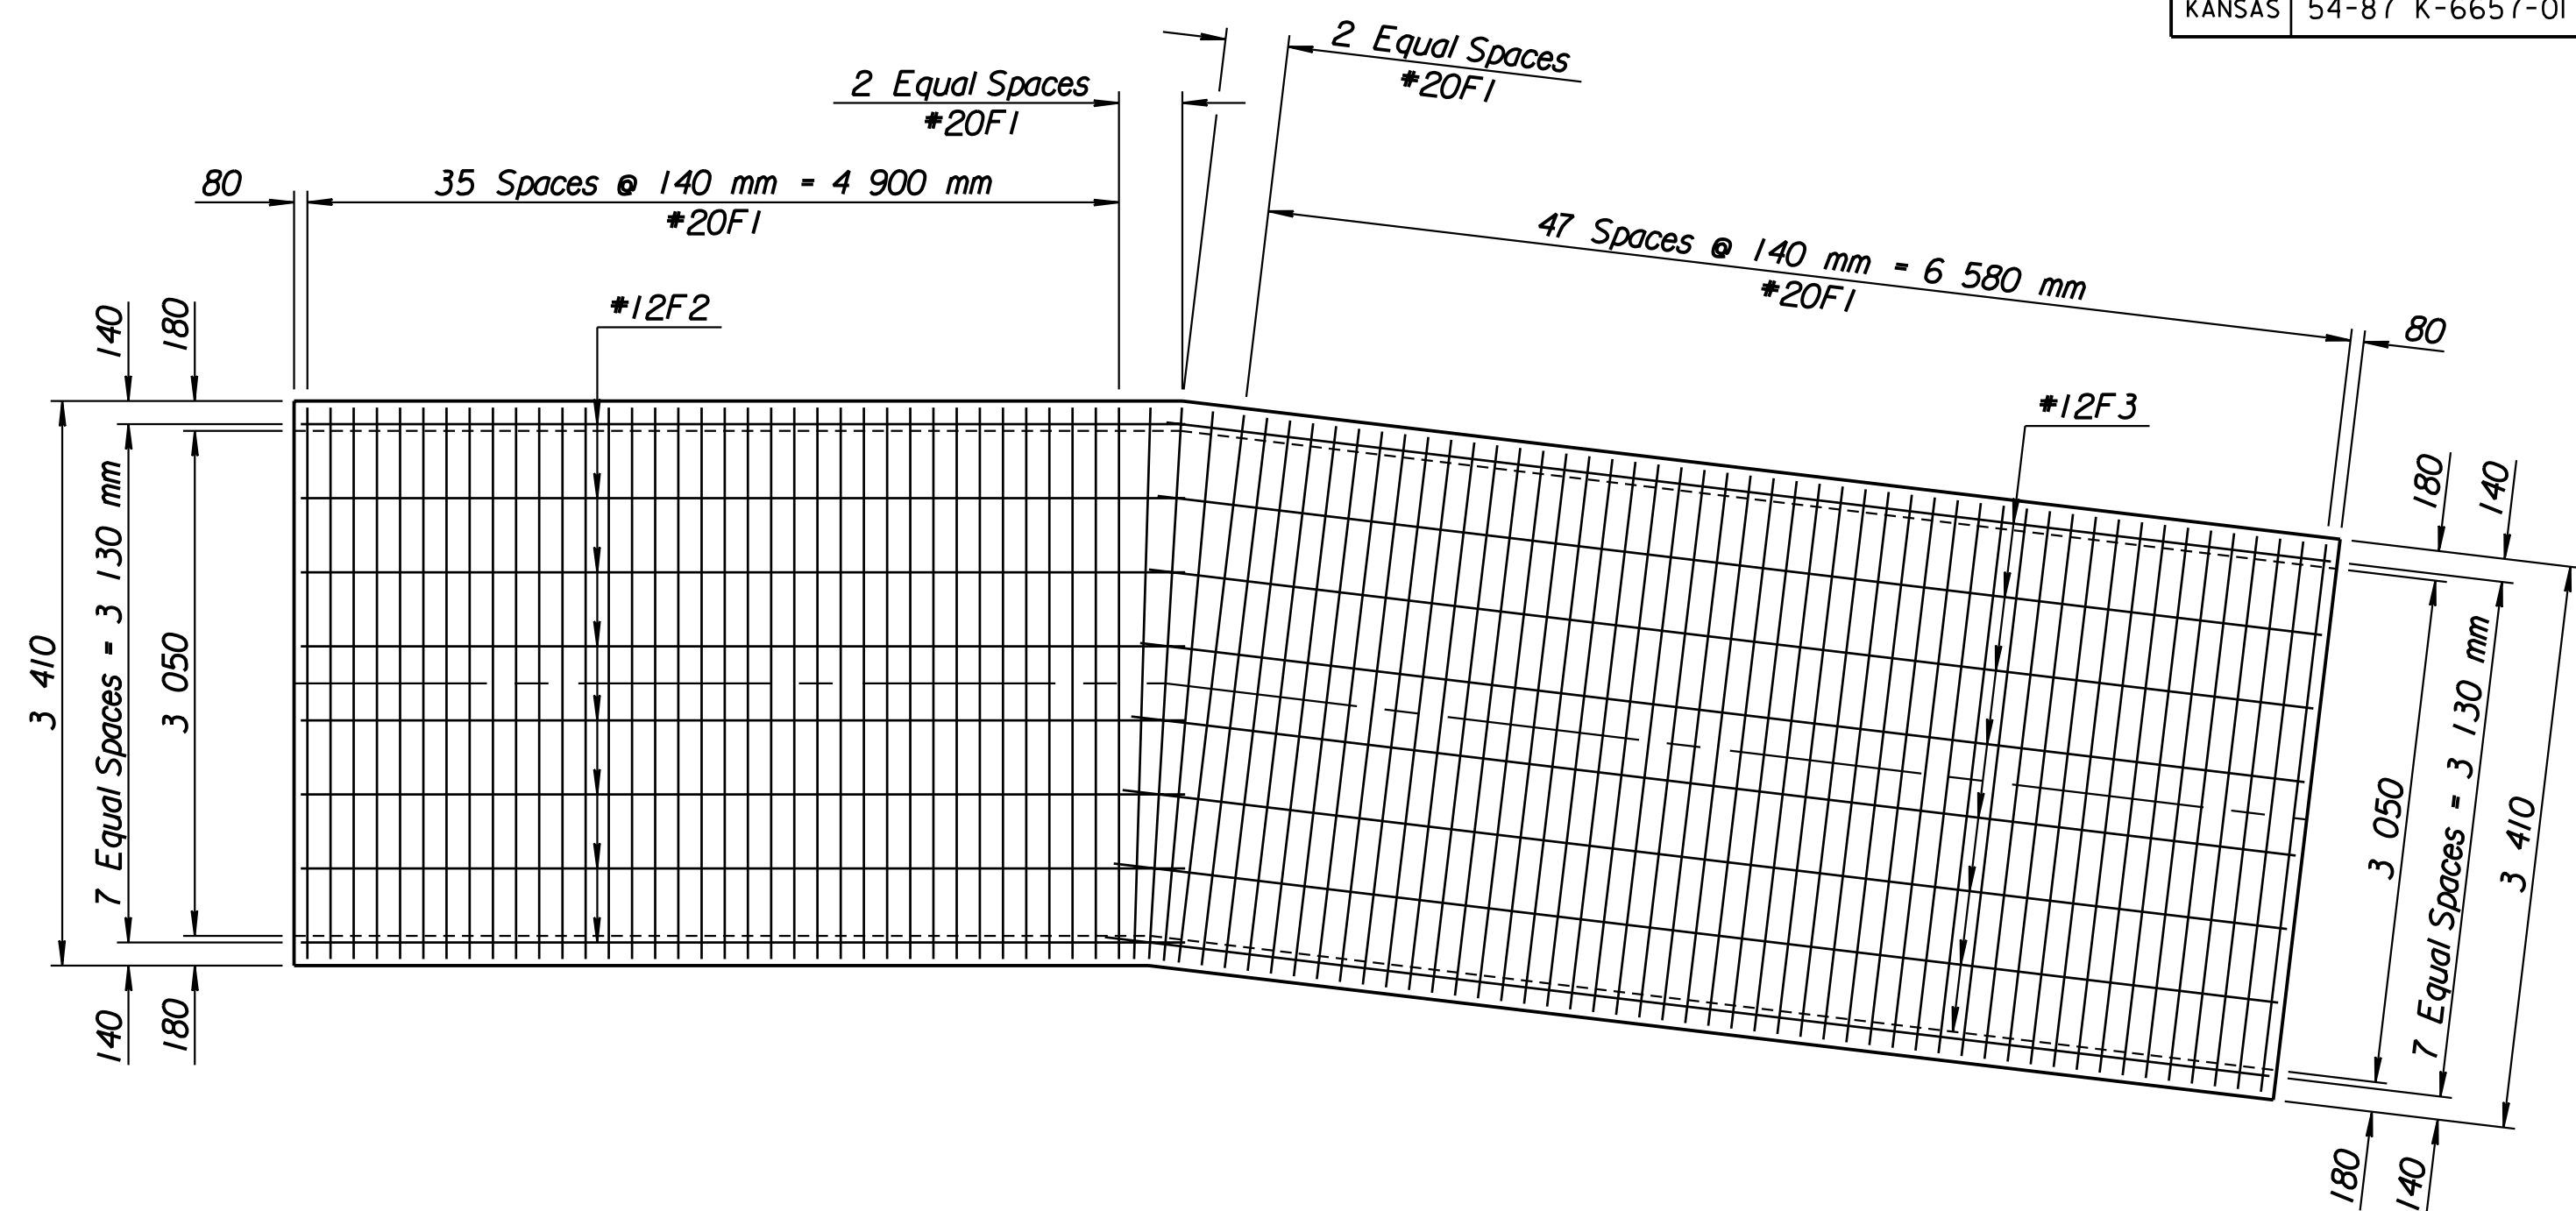

FLOOR REINFORCING

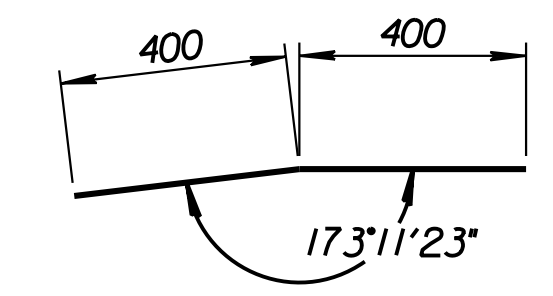


W6

BENDING DIAGRAMS
Dimensions are out to out of bars


REINFORCING STEEL							
Straight Bars			Bent Bars				
Mark	No.	Size	Length	Mark	No.	Size	Length
F1	87	*20	3300	W6	10	*12	800
F2	8	*12	5340				
F3	8	*12	7080				
S1	87	*20	3300				
S2	7	*12	5340				
S3	7	*12	7020				
W1	107	*15	2540				
W2	5	*12	7000				
W3	5	*12	6800				
W4	5	*12	5300				
W5	5	*12	5200				
X2	16	*12	1000				

SUMMARY OF QUANTITIES		
Item	Quantity	Unit
AAA Concrete	30.0	m ³
Reinforcing Steel (Grade 420)	2 090	kg

Note:
See Plan Profile Sheets for location of this R.C.B. Section.
See Sheet 413 for General Notes.

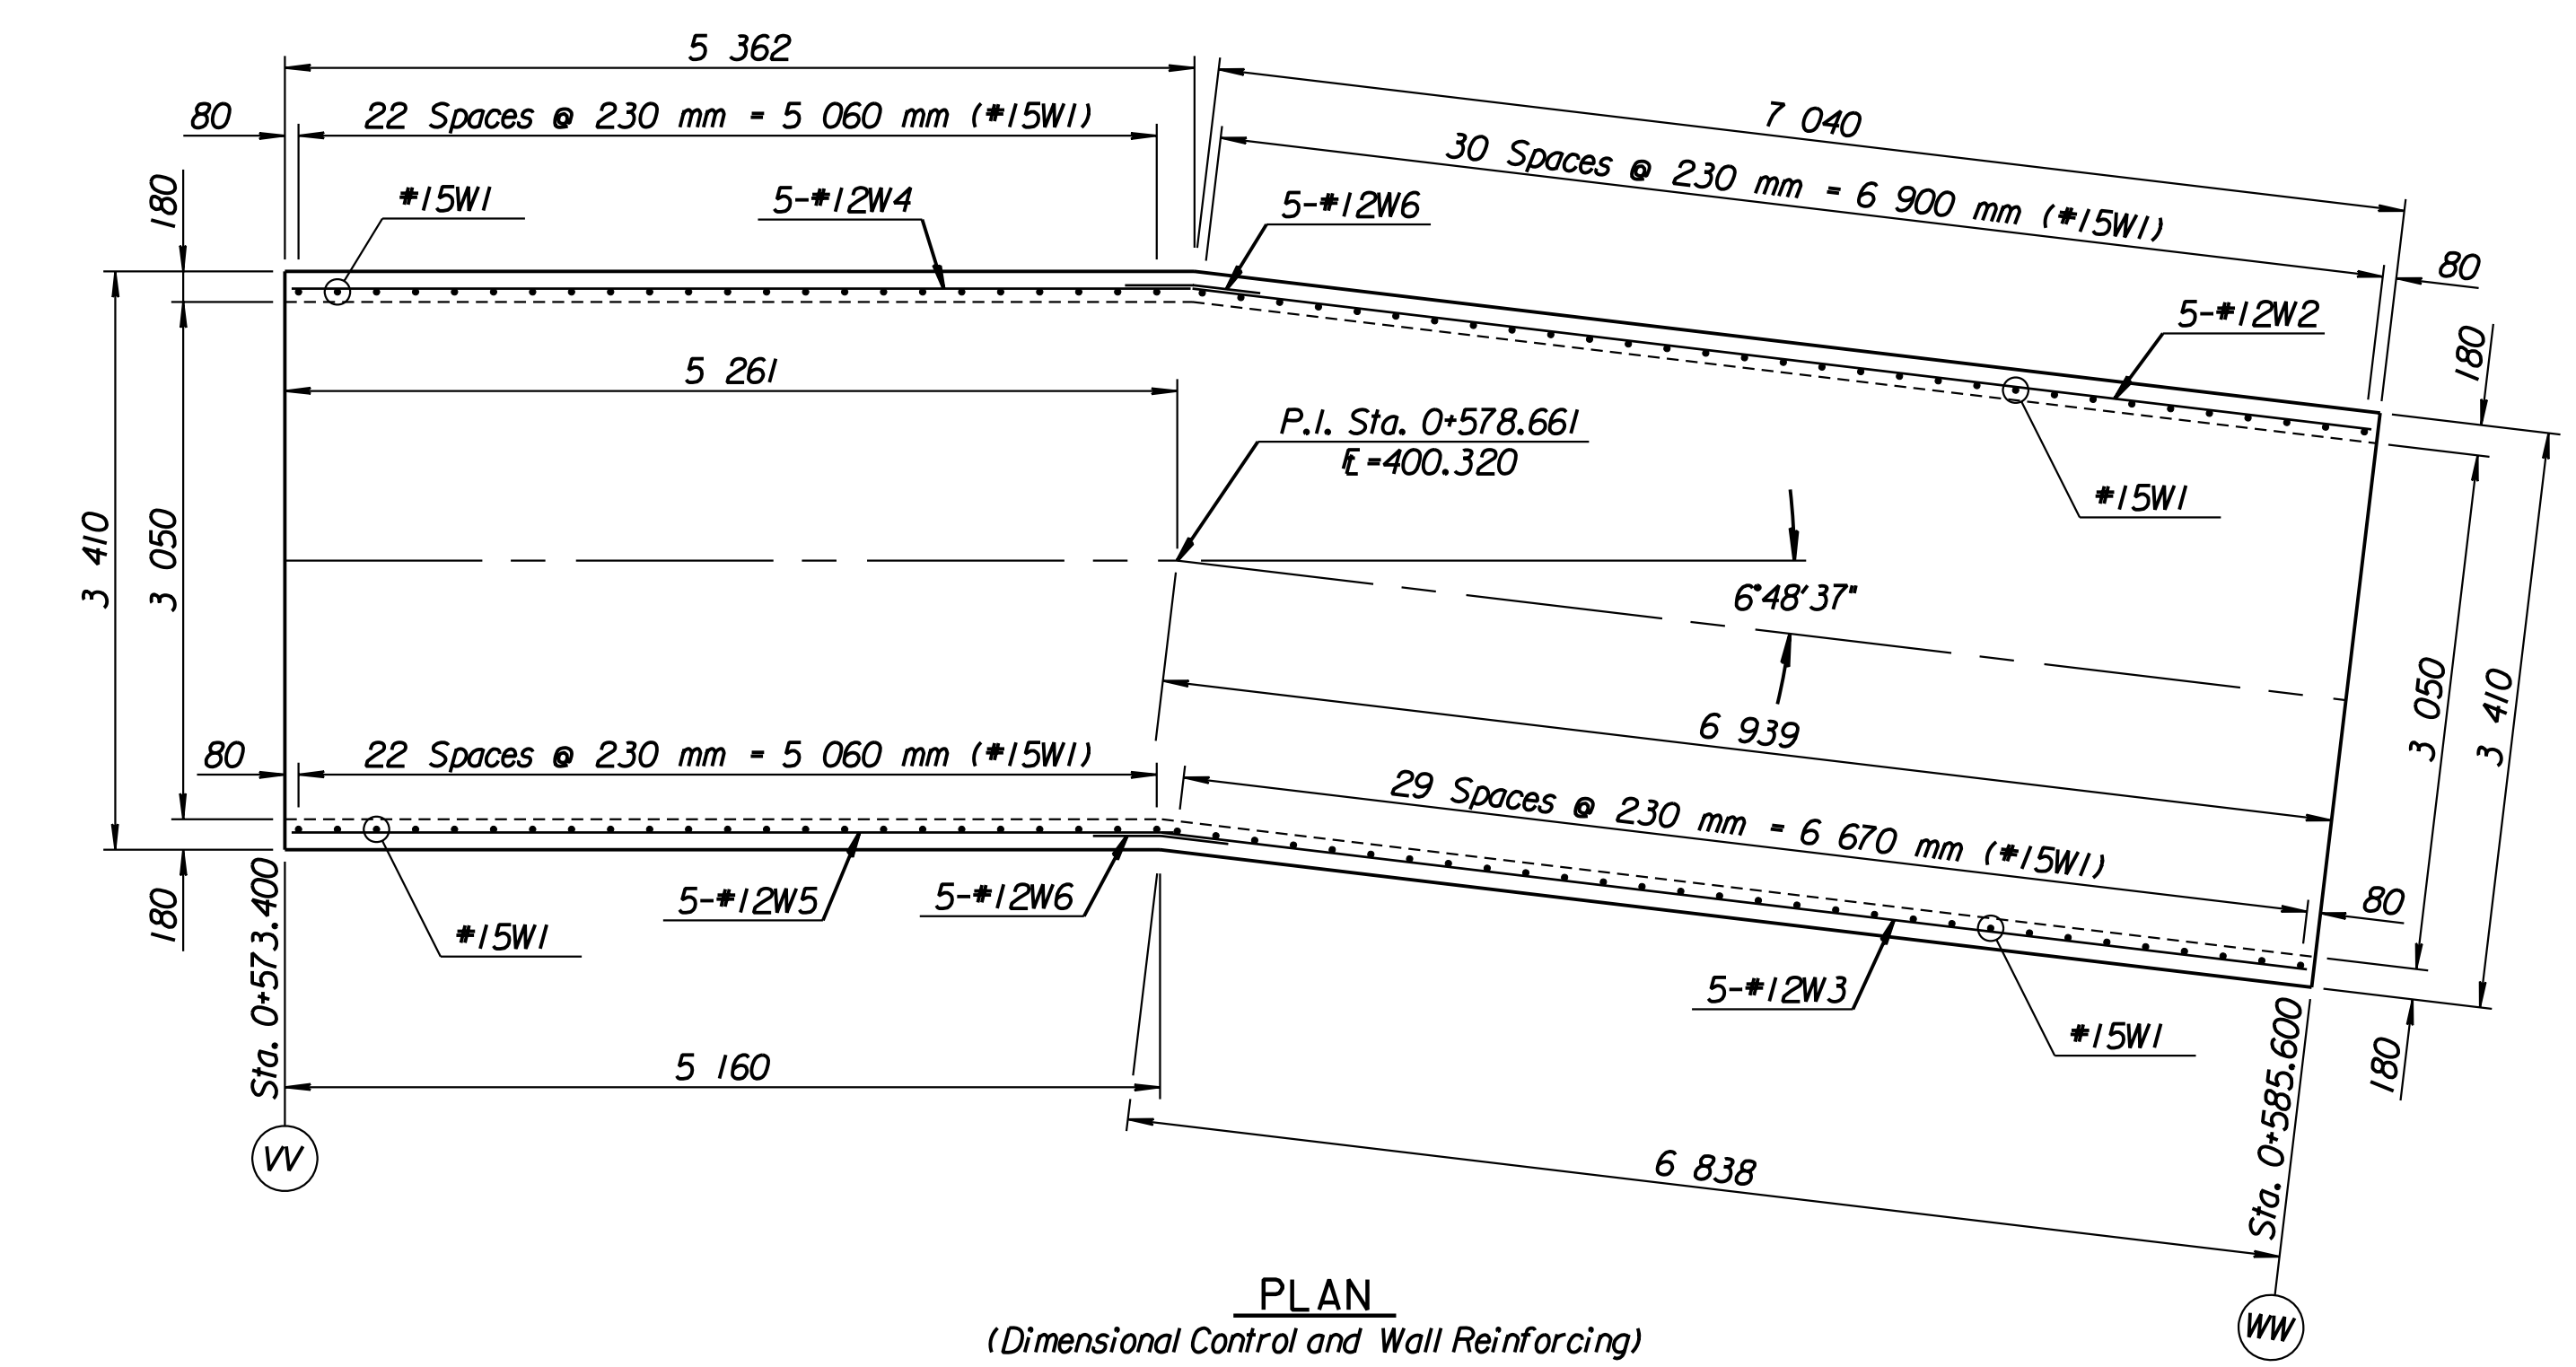

PLAN
(Dimensional Control and Wall Reinforcing)

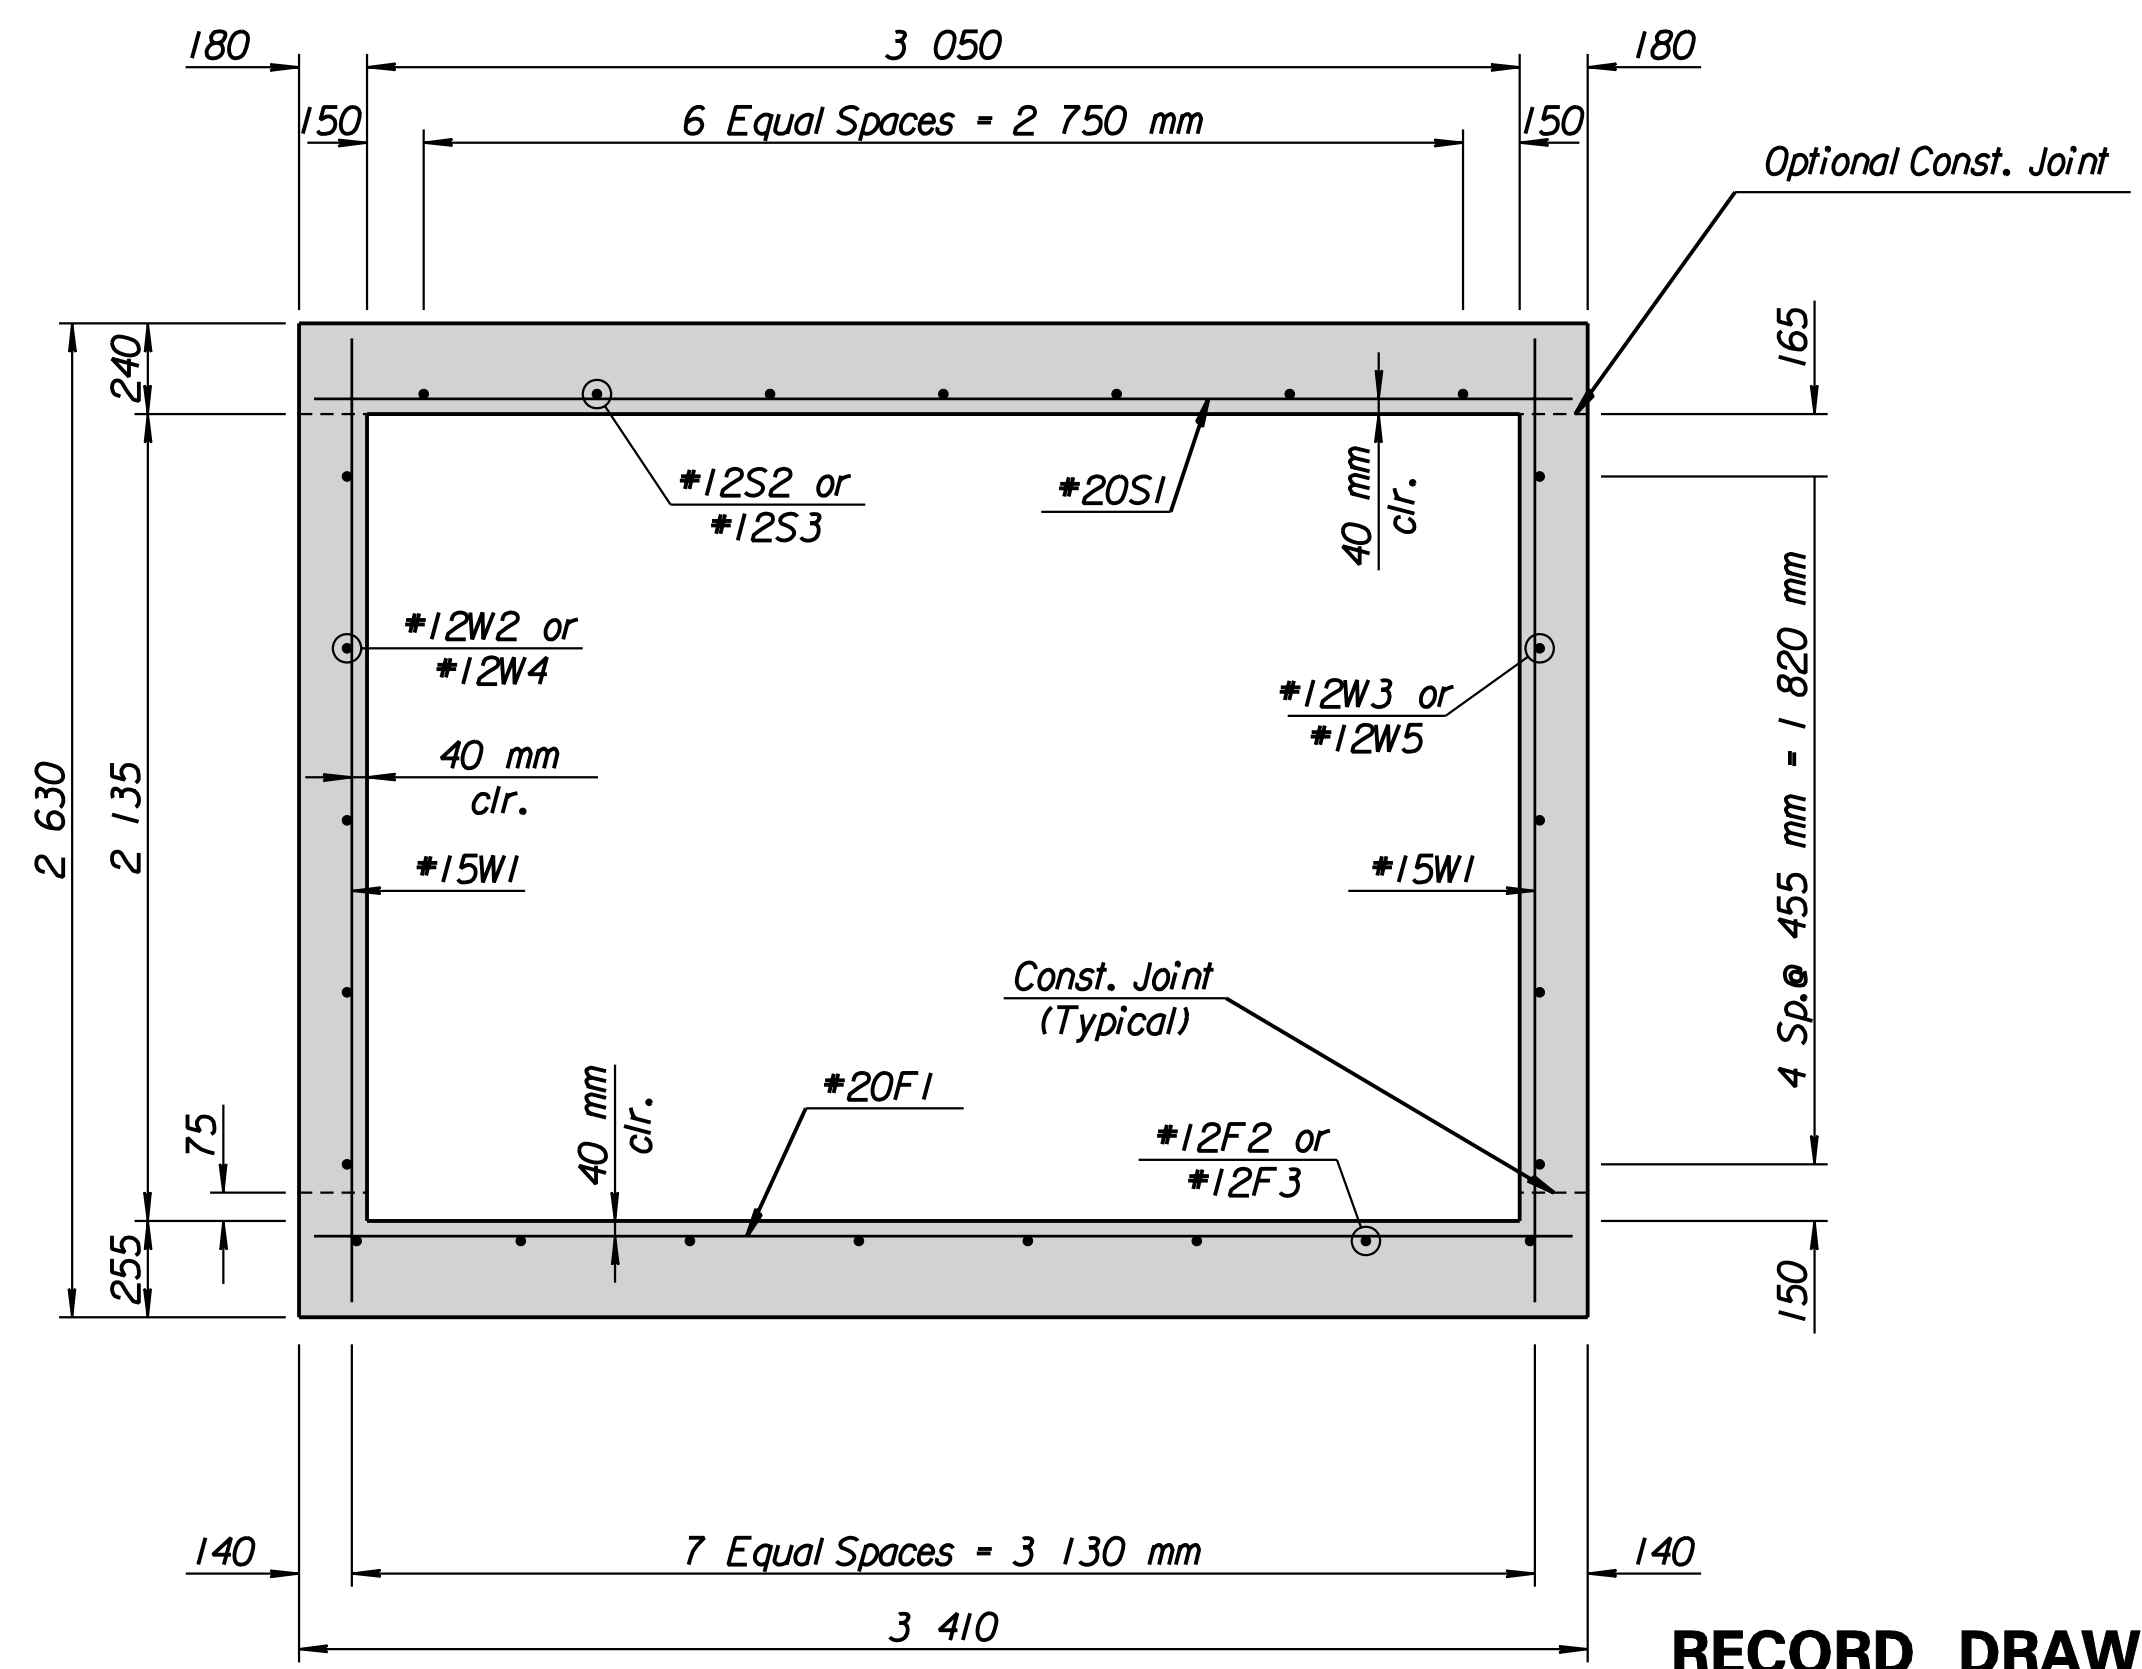

TYPICAL SECTION

RECORD DRAWING

1			
No.	Revisions	By	Date
CITY OF WICHITA			
SPECIAL 3.0 x 2.1 x 12.2 m			
R.C.B. SECTION AT P.I.			
KELLOGG (US-54)			
SEDGWICK COUNTY			
Professional Engineering Consultants, P.A. 303 S. TOPEKA • WICHITA, KANSAS 67202 316-262-2691 • FAX 316-262-3003			
Designed by	RWA	Checked by	RAS
Drawn by	GDR	Date	April 11, 2002
		Job No.	97362

Plotted by: ras 2-11-2002
I:/1997/97362/As-Builts/dgn/101_2/Sh_423-30BEND3.dgn Last Rev.: 8-29-07 Bjt: gdr