



STATE	PROJECT NO.	YEAR	SHEET NO.	TOTAL SHEETS
KANSAS	54-87 K-6657-01	2002	457	1122

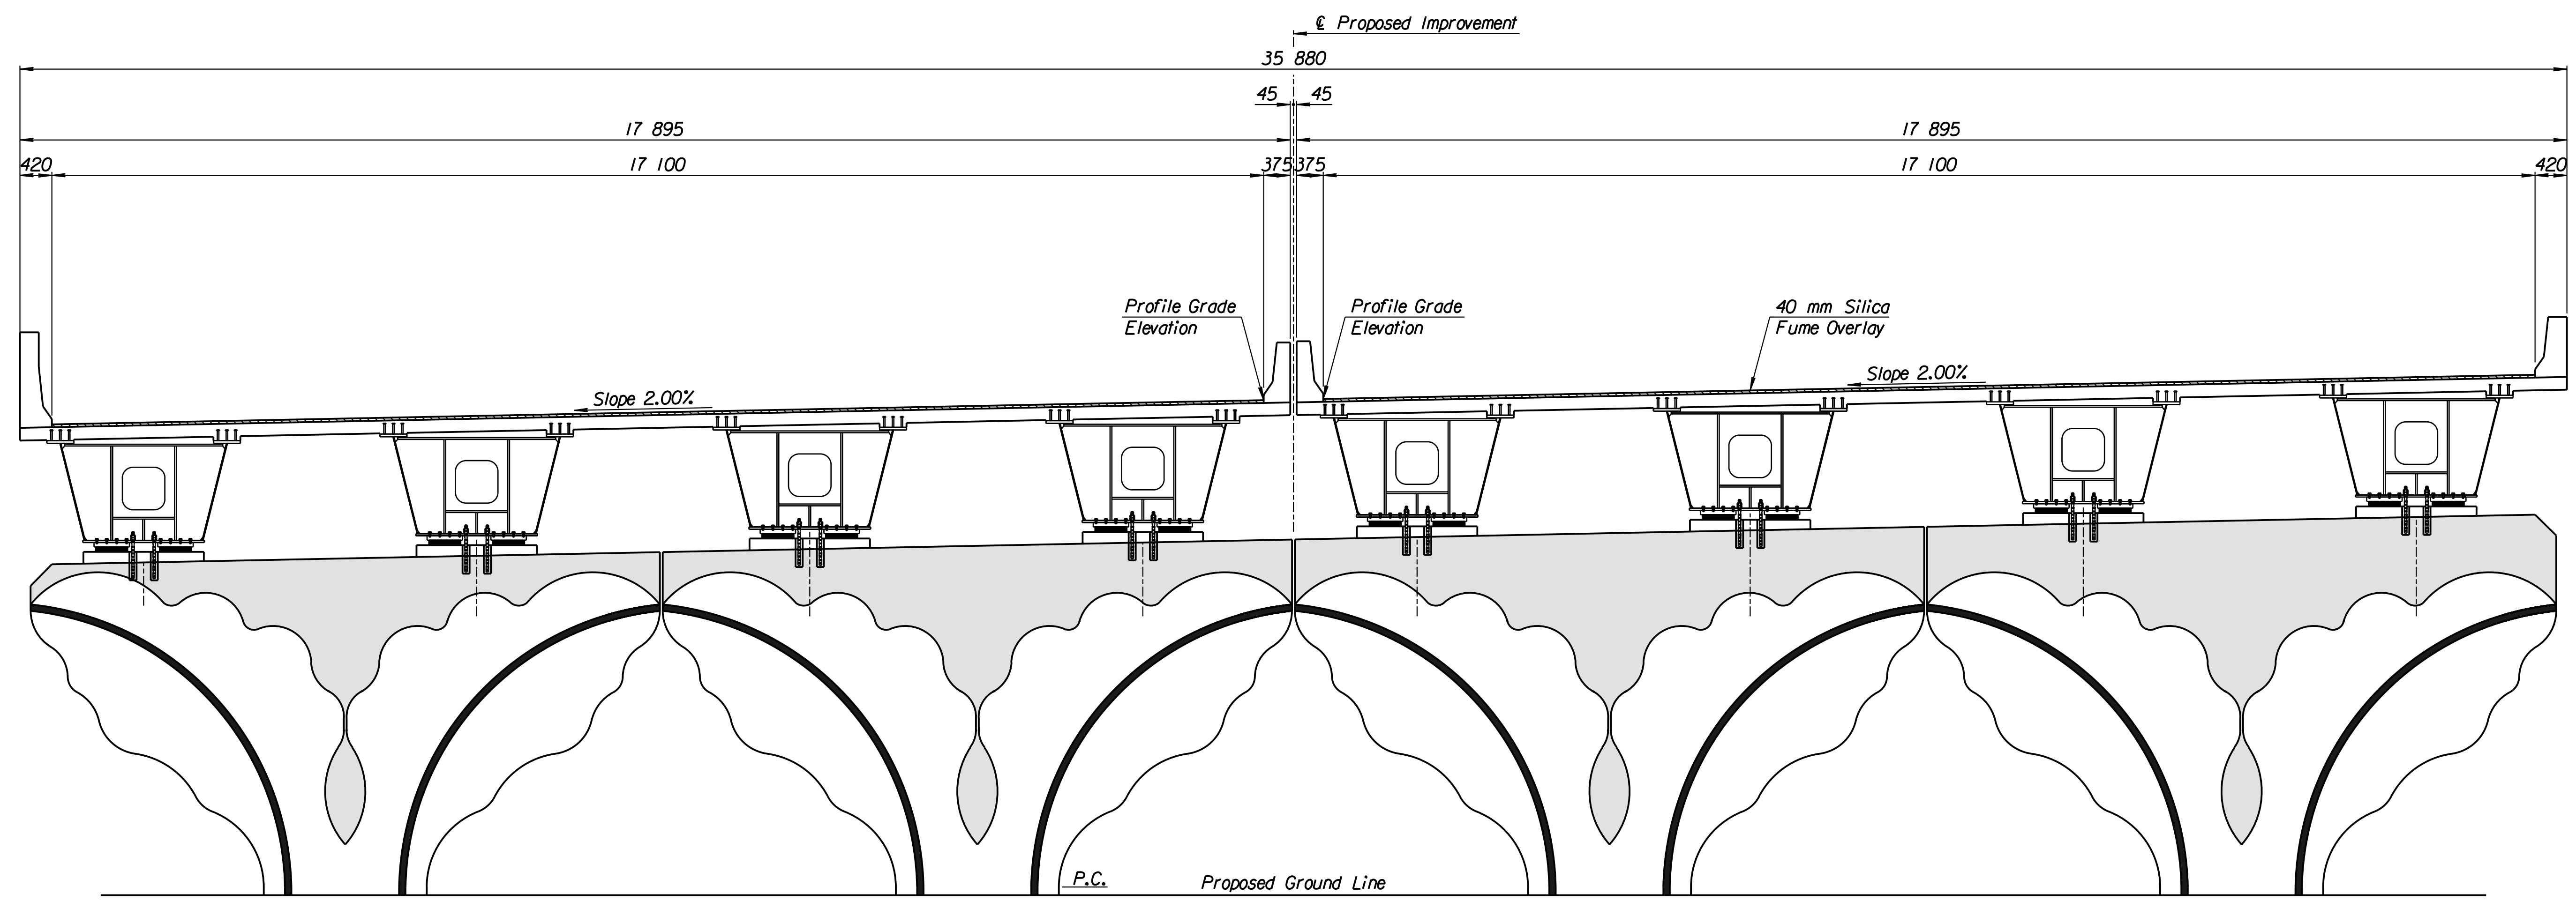

ELEVATION

Drawn by: wll  
 Plotted by: gdr  
 I:/1997/97.362/As-Builts/dgn/s/Vol\_3/Sh\_457-pier.tex.dgn Last Rev: 8-30-07 By: gdr

No.	Revisions	By	Date
CITY OF WICHITA BR. NO. 54-87-19.05 (489) W.B. STA. 15+612.397 BR. NO. 54-87-19.06 (491) E.B. STA. 15+612.397 <b>PIER TEXTURE DETAILS</b> KELLOGG (US-54) OVER MAIZE ROAD SEDGWICK COUNTY			
 <b>Professional Engineering Consultants, P.A.</b> 303 S. TOPEKA • WICHITA, KANSAS 67202 316-262-2691 • FAX 316-262-3003			
Designed by	P.D.F.	Checked by	R.A.S.
Drawn by	W.L.L.	Date	April 2002 Job No. 97362

**RECORD DRAWING**