
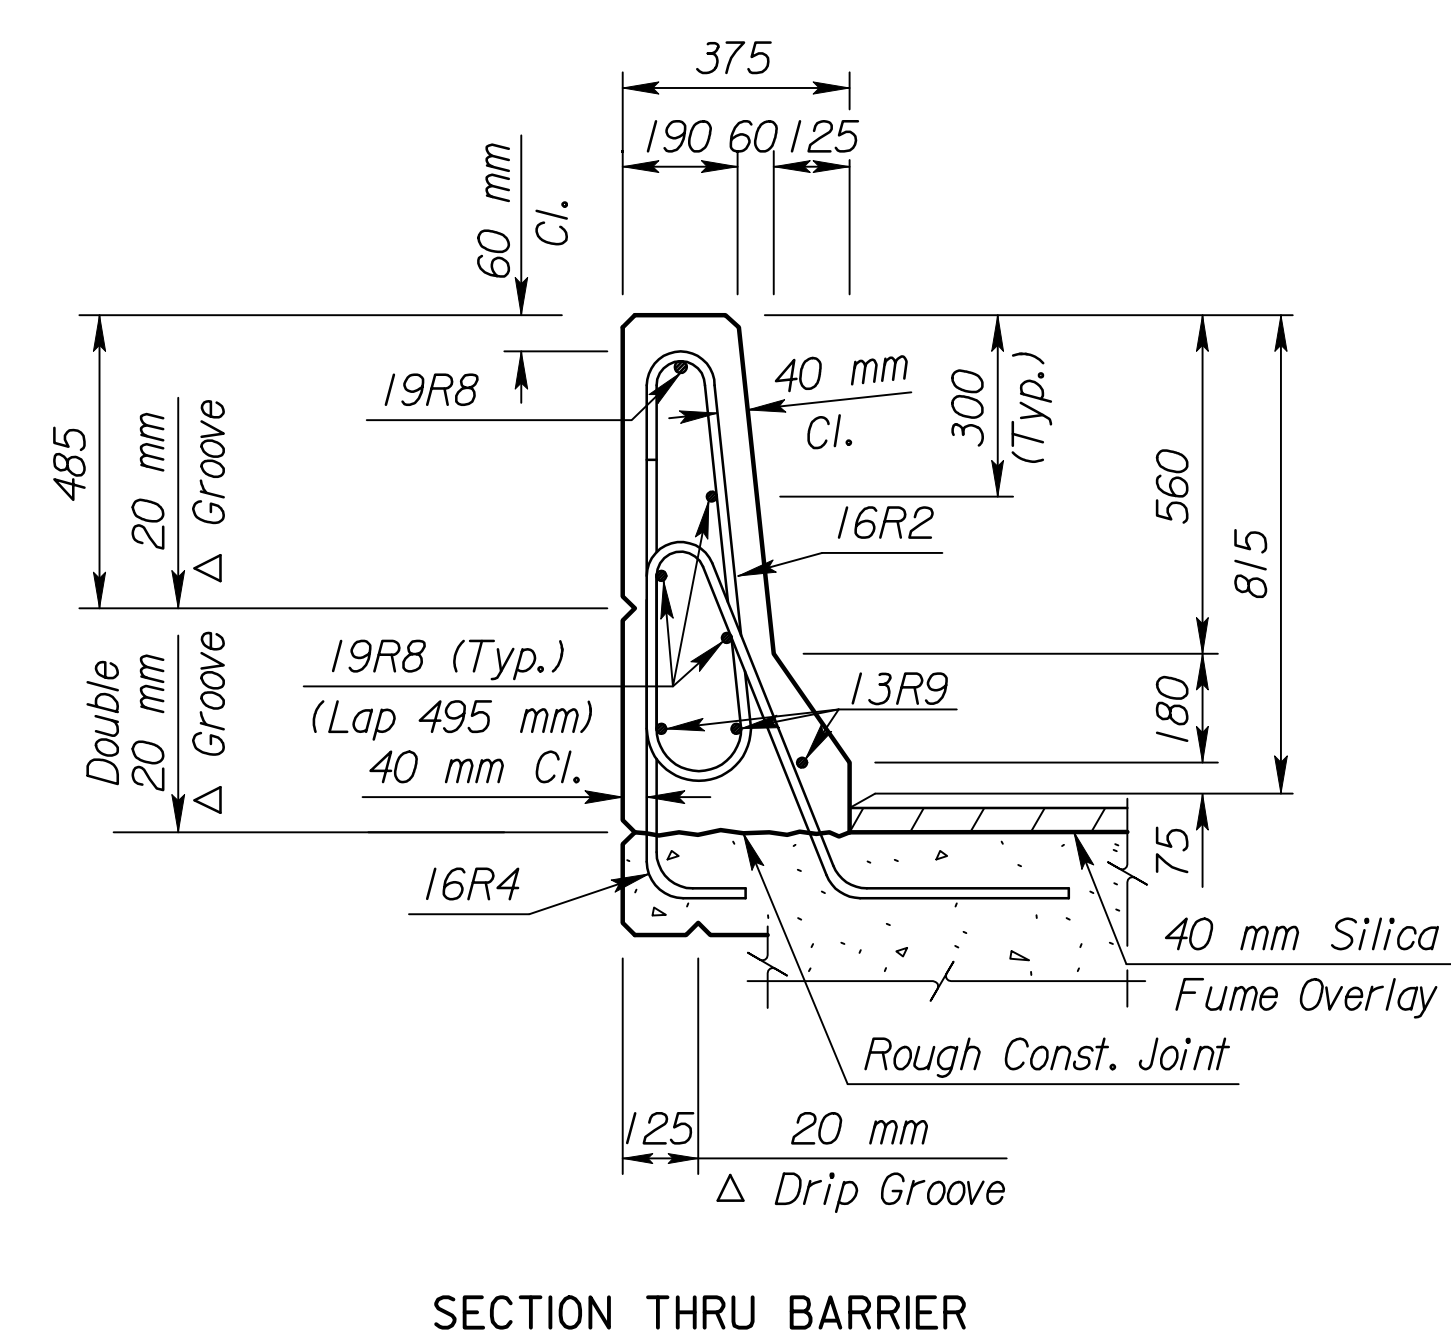
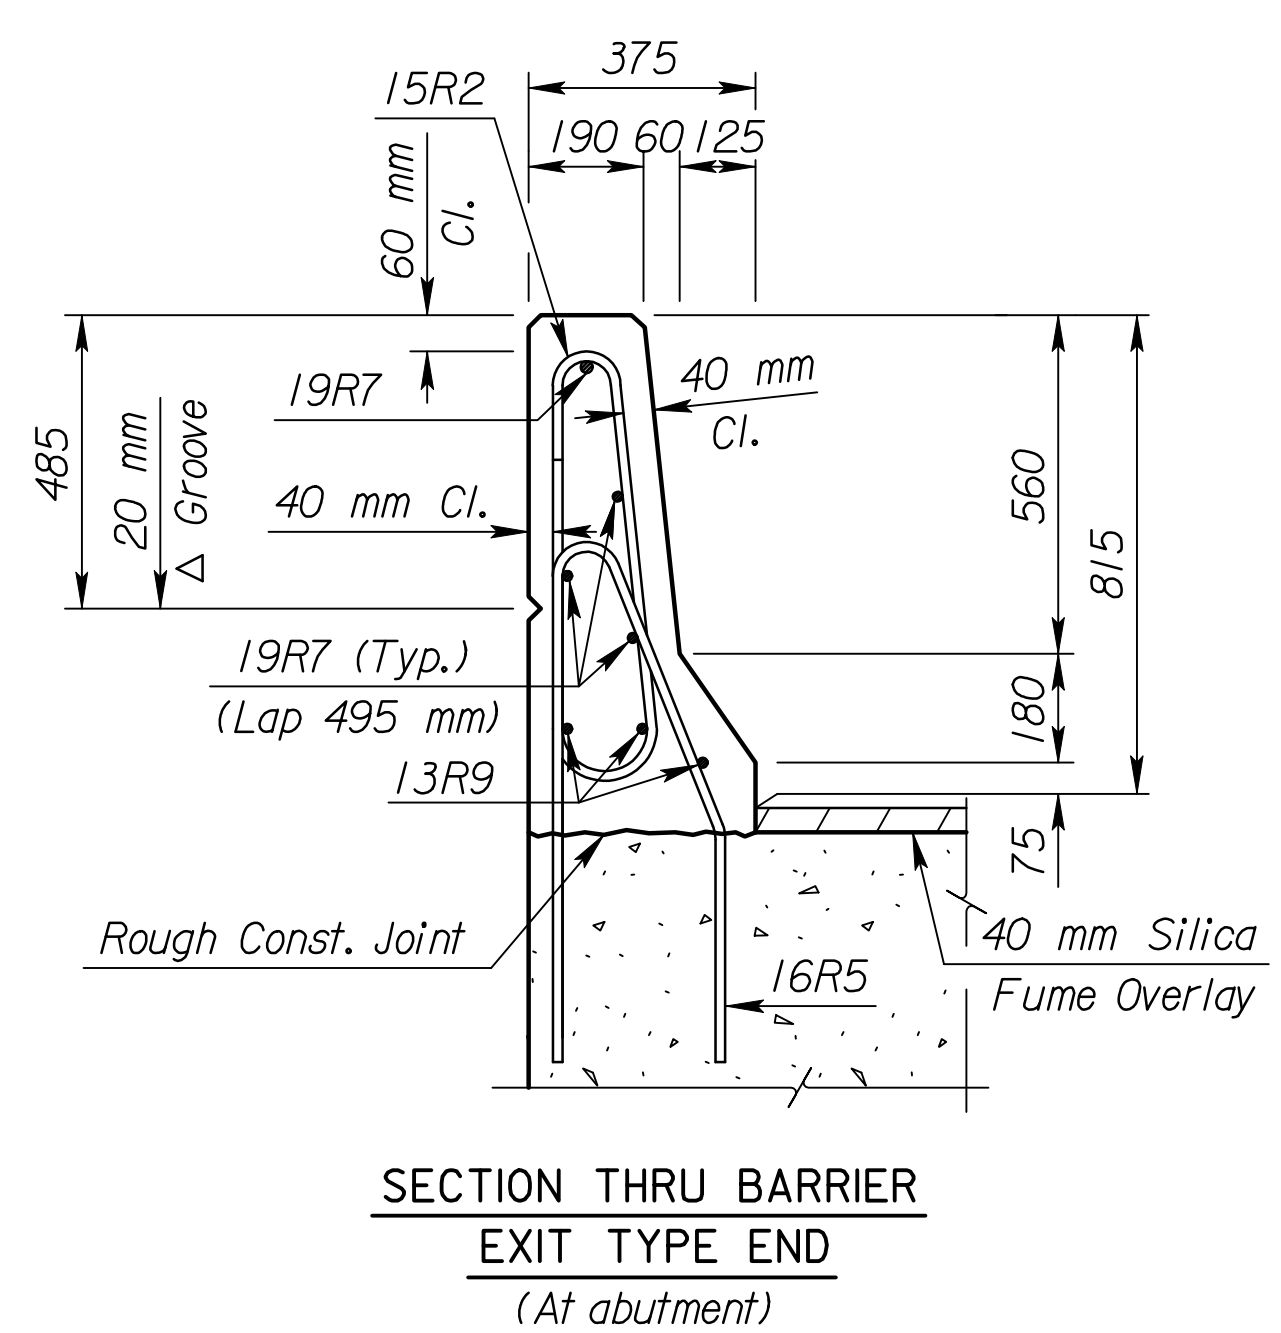
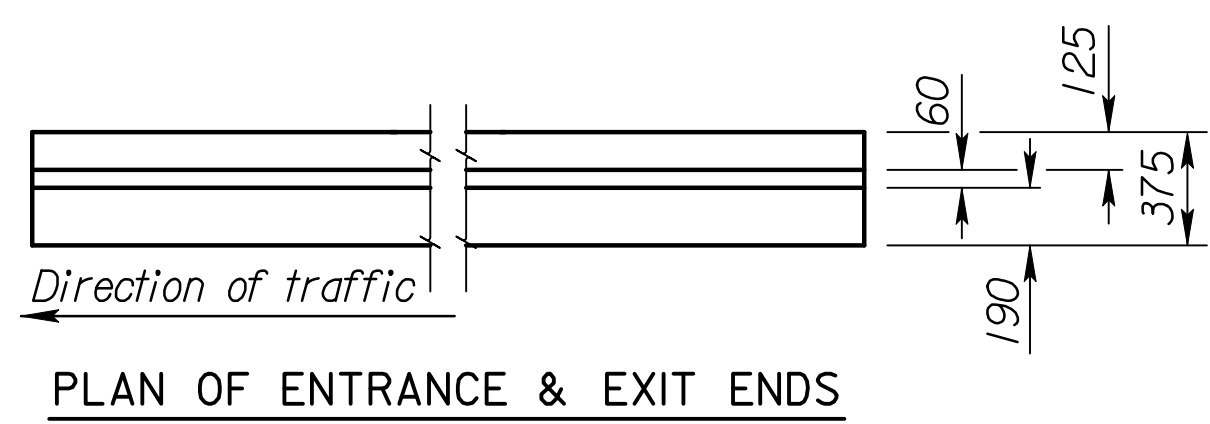


STATE	PROJECT NO.	YEAR	SHEET NO.	TOTAL SHEETS
KANSAS	54-87 K-6657-01	2002	470	1122

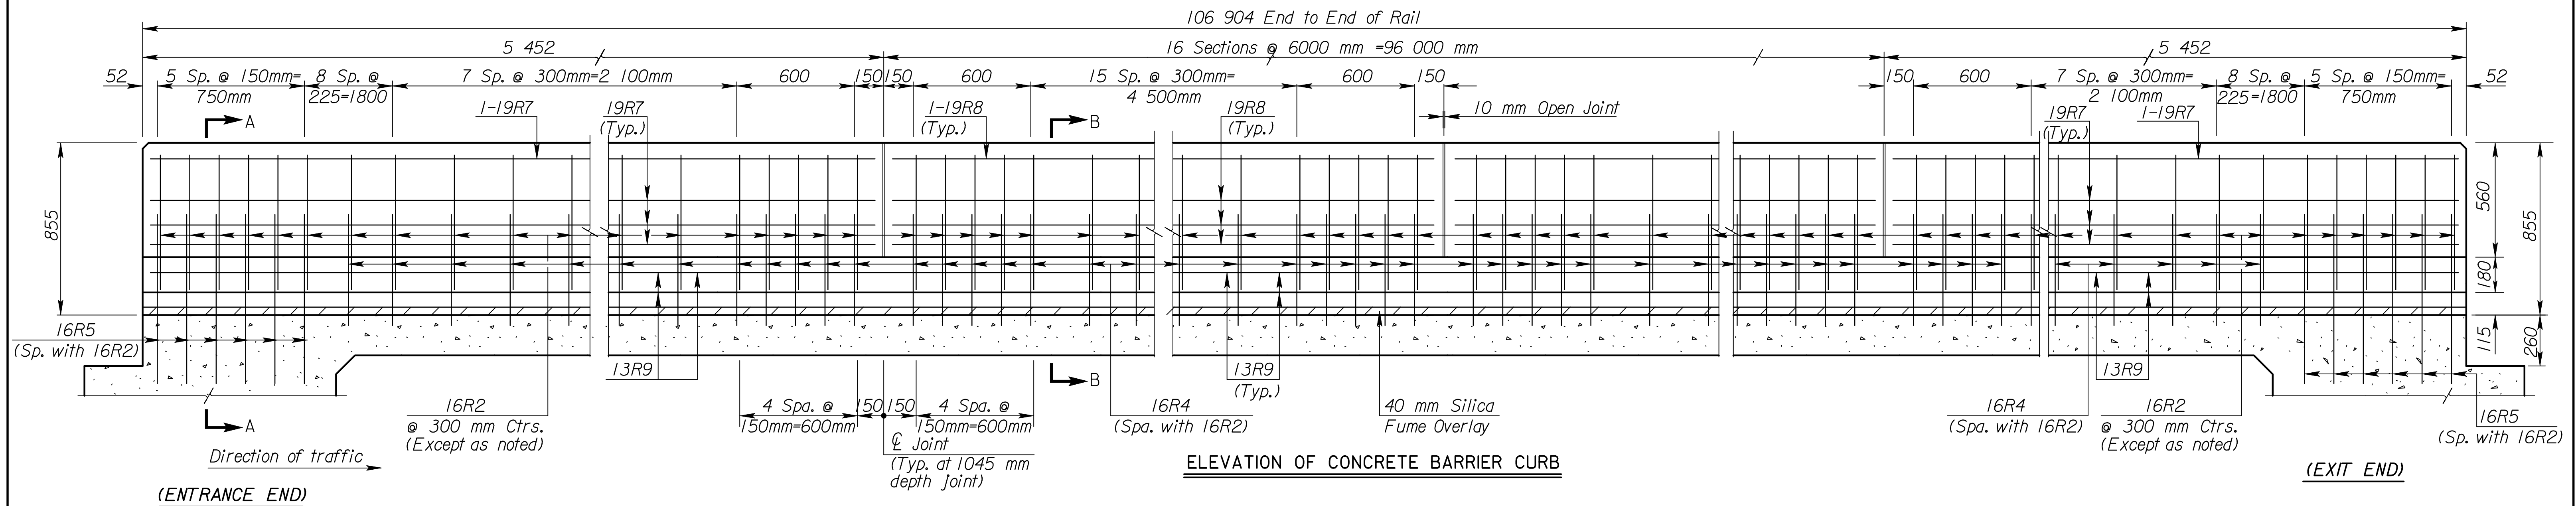

Scale : 1/2.5
 Plotted By : DRP
 Plot File : I:\1997\97362\As-Builts\dgrs\Vol_3\Sh_470-K001_ST-D-81\InteriorRail.dgn Last Rev: 8-31-07 By: gdr
 Plot Date : 3-22-2002

3				
2				
1	10-27-00	Current Release		
NO.	DATE	REVISIONS	BY	APP'D

CITY OF WICHITA
 Br. No. 54-87-19.05(489) W.B. Sta. 15+612.397
 Br. No. 54-87-19.06(491) E.B. Sta. 15+612.397
 815mm F2 BARRIER CURB
 INTERIOR RAIL
 KELLOGG (US 54) OVER MAIZE ROAD
 SEDGWICK Co.

SHEET NO.	OF	SCALE	APP'D
DESIGNED	CK.	DETAILED	QUANTITIES
DESIGN	CK.	DETAIL	QUAN. CK.
			CADD
			CADD CK.

RECORD DRAWING