
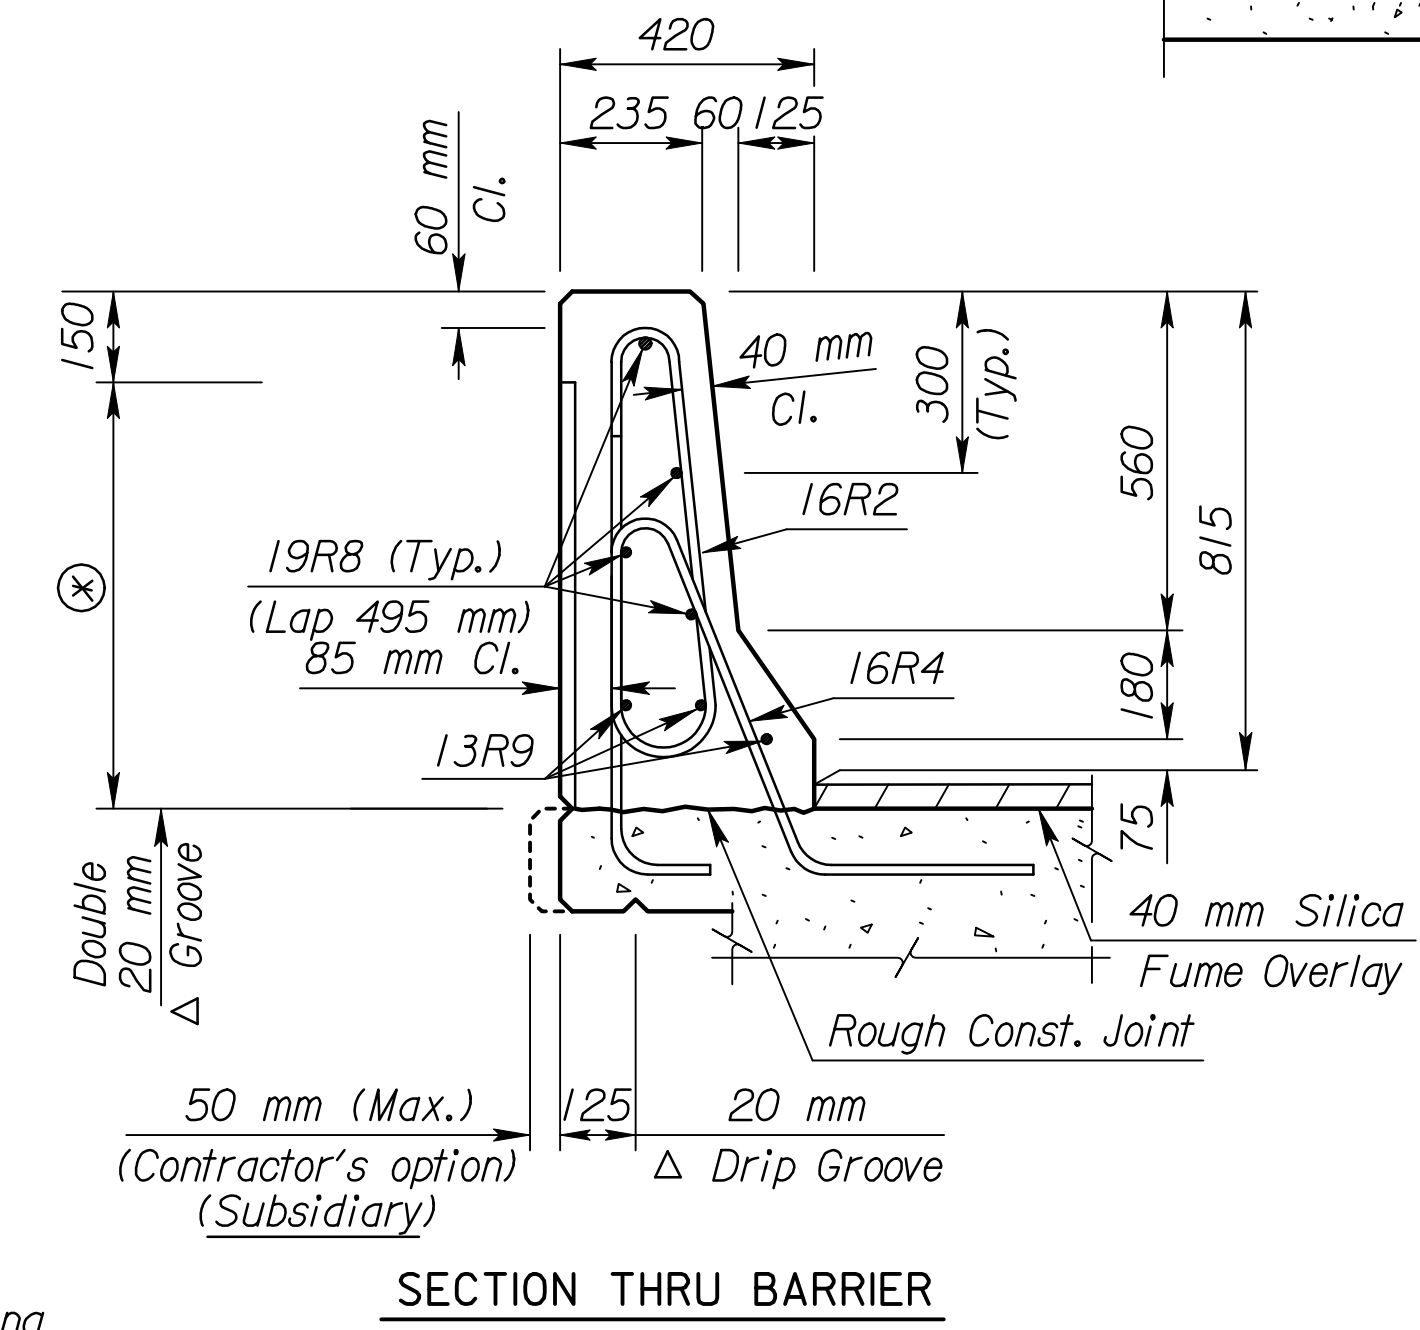
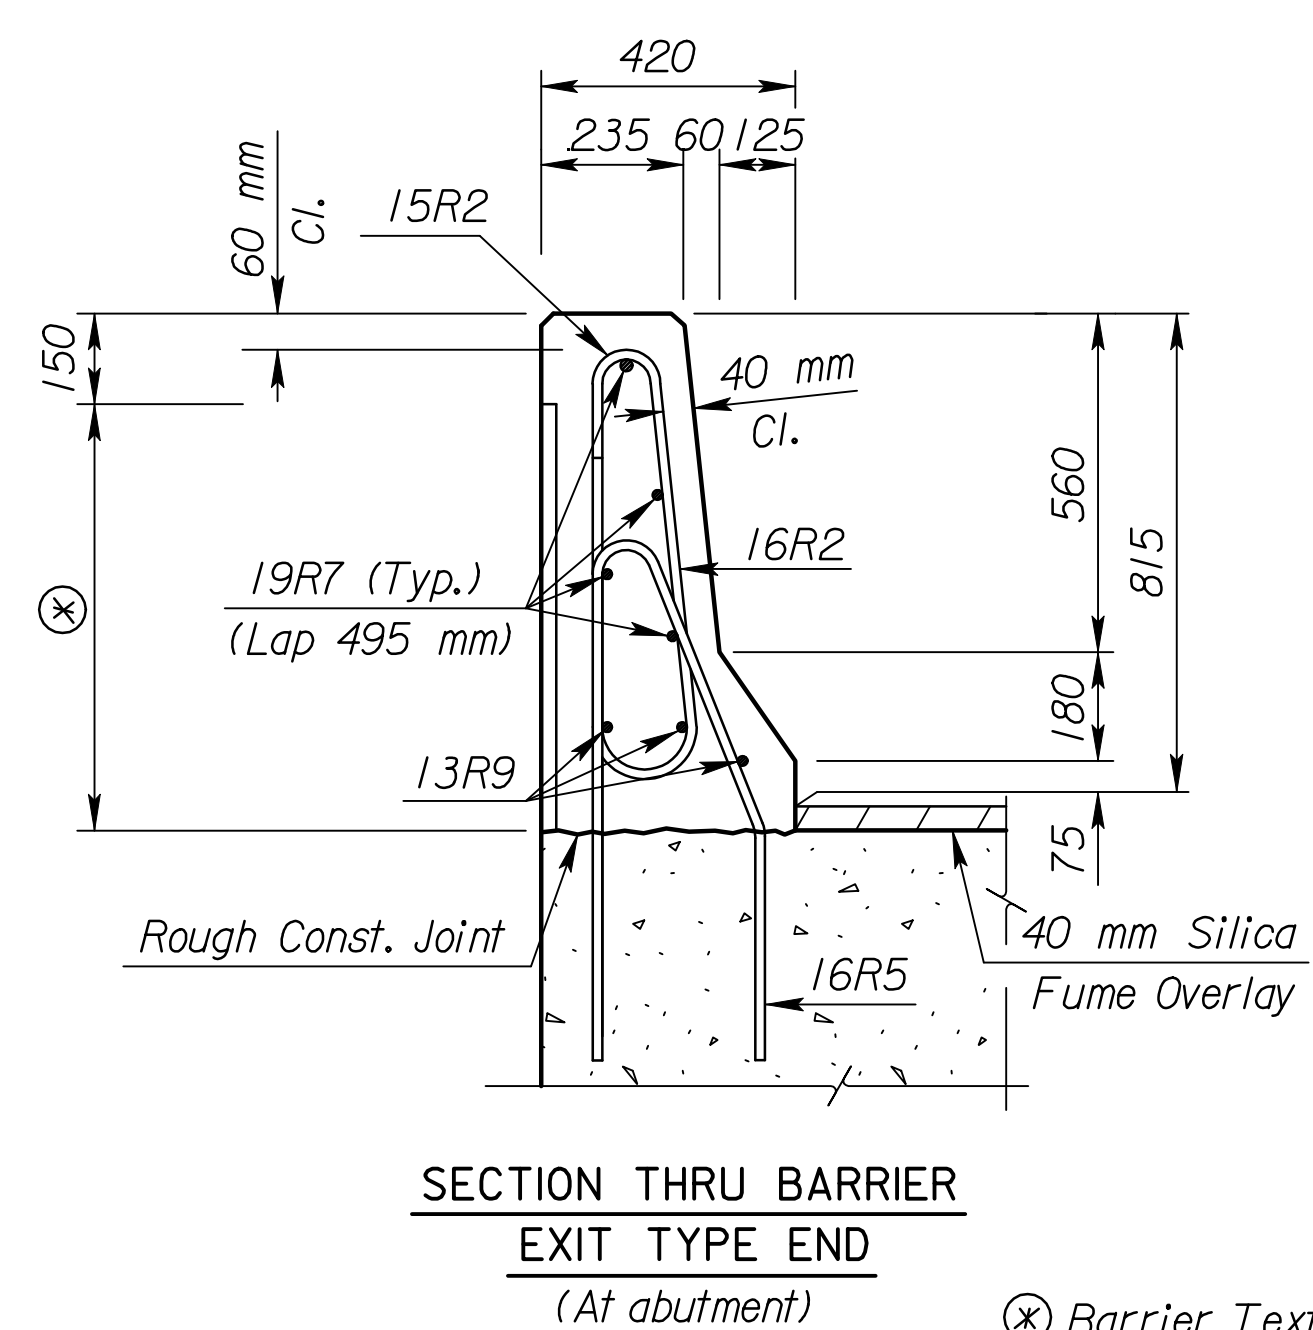
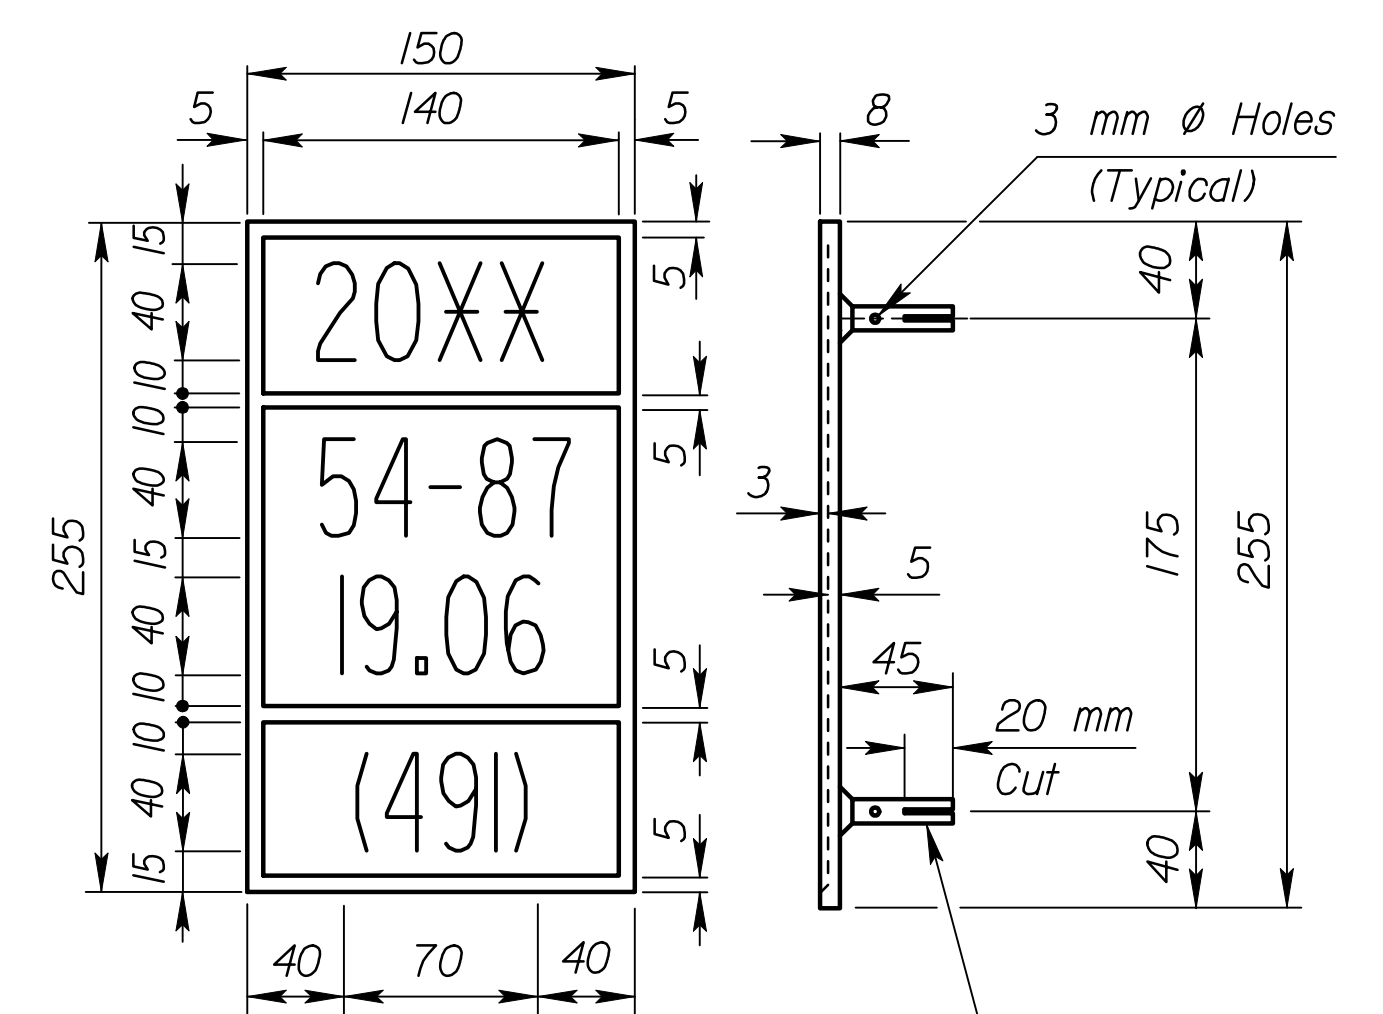
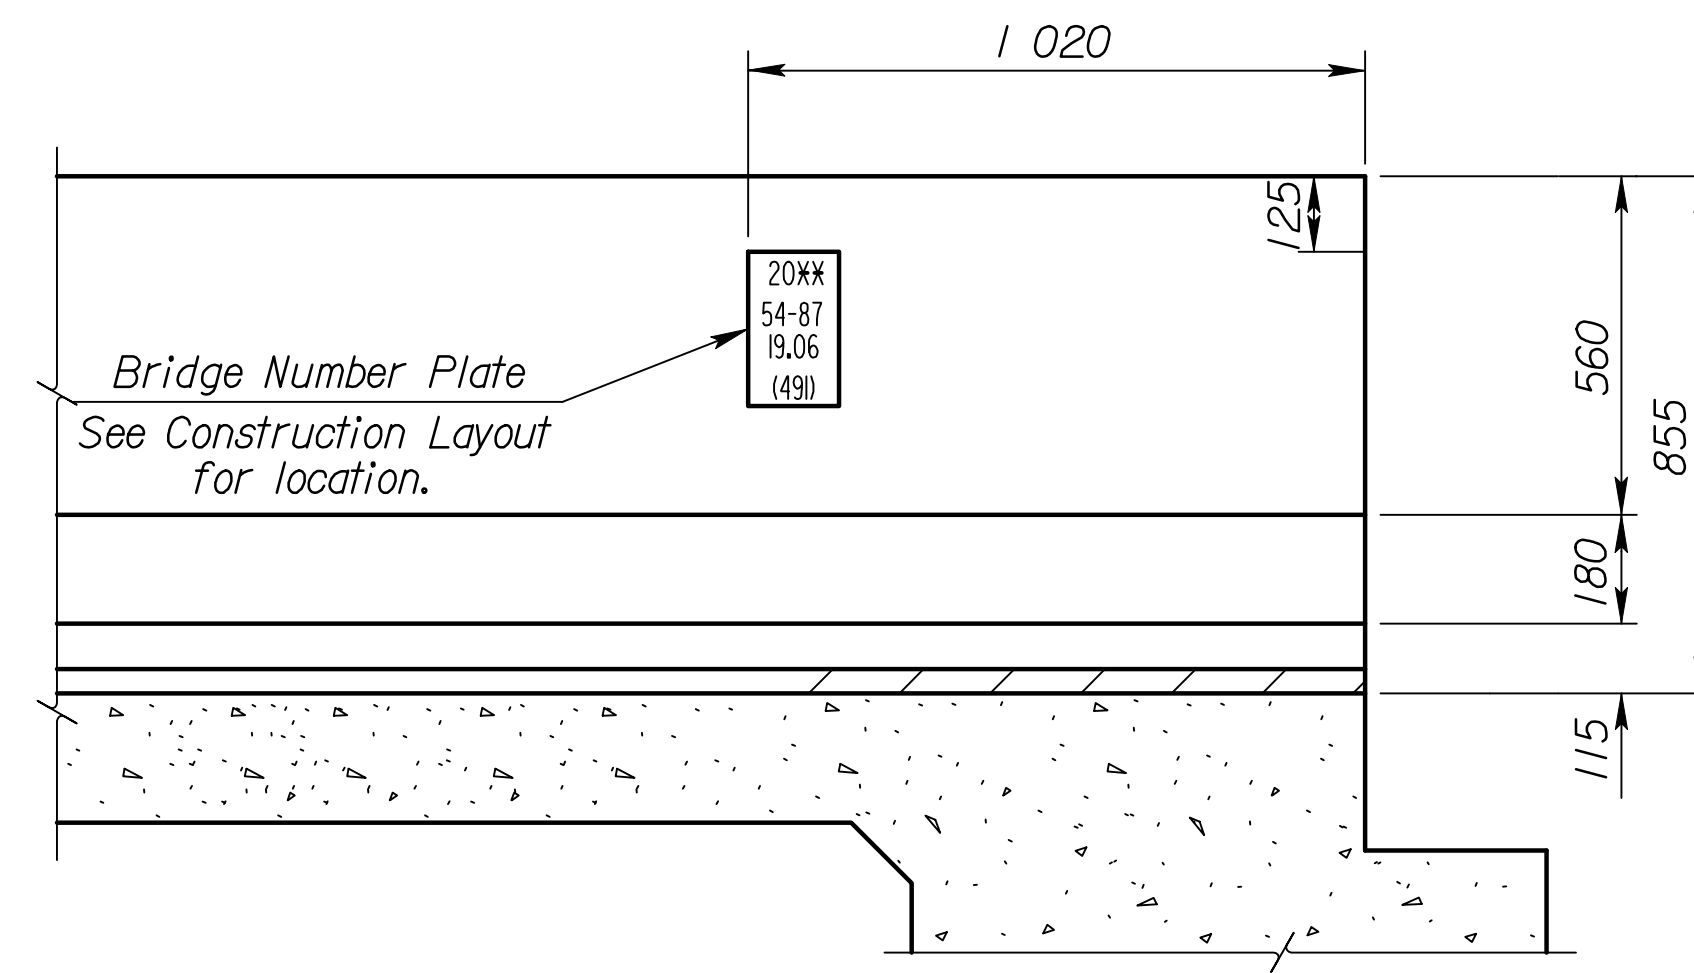
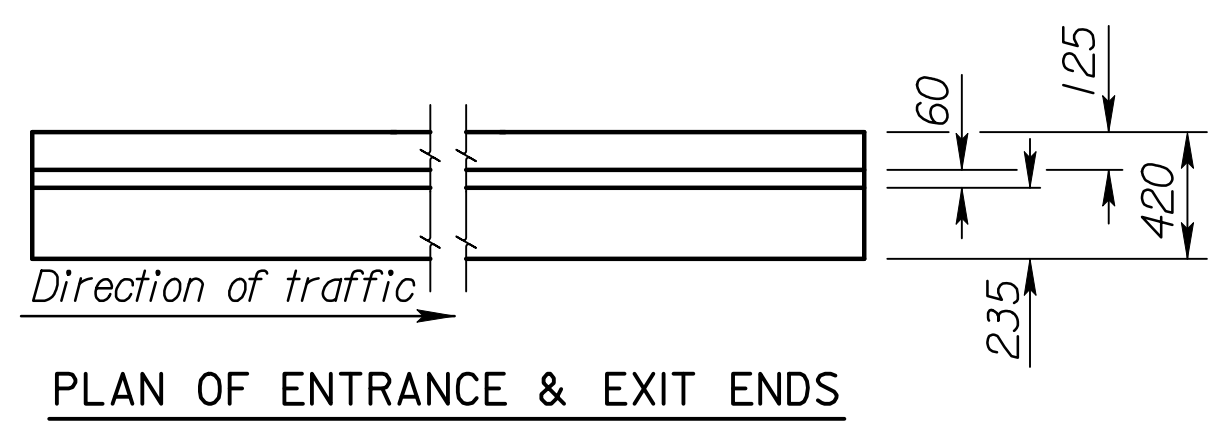


STATE	PROJECT NO.	YEAR	SHEET NO.	TOTAL SHEETS
KANSAS	54-87 K-6657-01	2002	471	1122

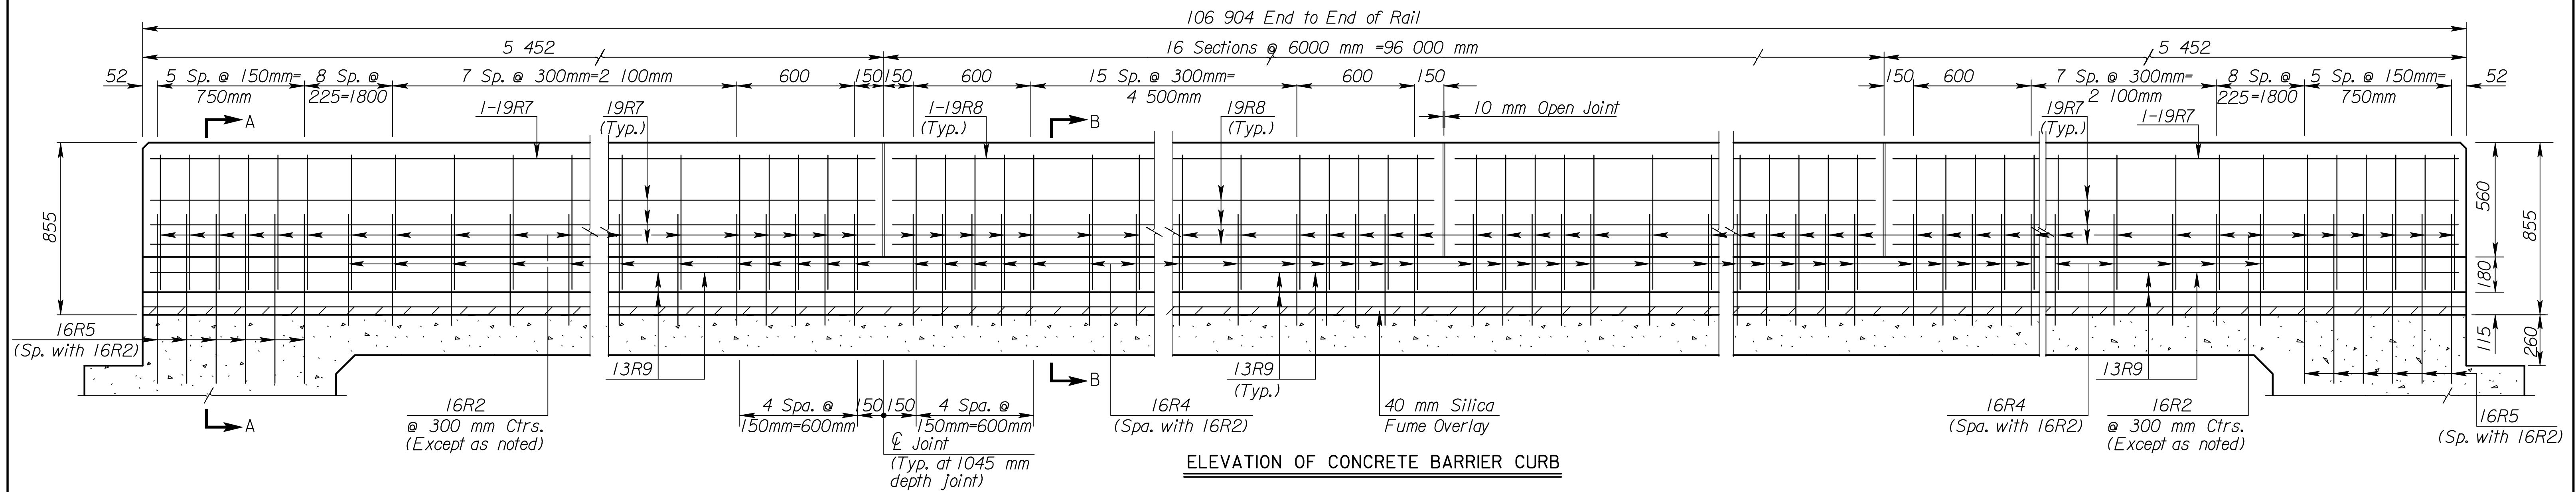

⊗ Barrier Texturizing
See Misc. Barrier Detail Sheet

XX Year Bridge is Completed.
2-10 mm Ø Lugs @ 75 mm
Ctrs. (Top & Bottom)

Scale : 1:2.5
 Plotted By : gdr
 Plot File : I:\1997\97362\As-Builts\dgn\Vol_3\Sh_471-KDOT_STD-P-815SouthRail.dgn
 Last Rev: 8-31-07
 By: gdr
 Plot Date : Sept. 07

3				
2				
1	10-27-00	Current Release		
NO.	DATE	REVISIONS	BY	APP'D

CITY OF WICHITA
 Br. No. 54-87-19.06(491) E.B. Sta. 15+612.397
 815mm F2 BARRIER CURB
 SOUTH RAIL
 KELLOGG (US 54) OVER MAIZE ROAD
 SEDGWICK Co.

SHEET NO.	OF	SCALE	APP'D
DESIGNED	QUANTITIES	DETAILED	CADD
DESIGN CK.	DETAIL CK.	QUAN. CK.	CADD CK.

RECORD DRAWING