
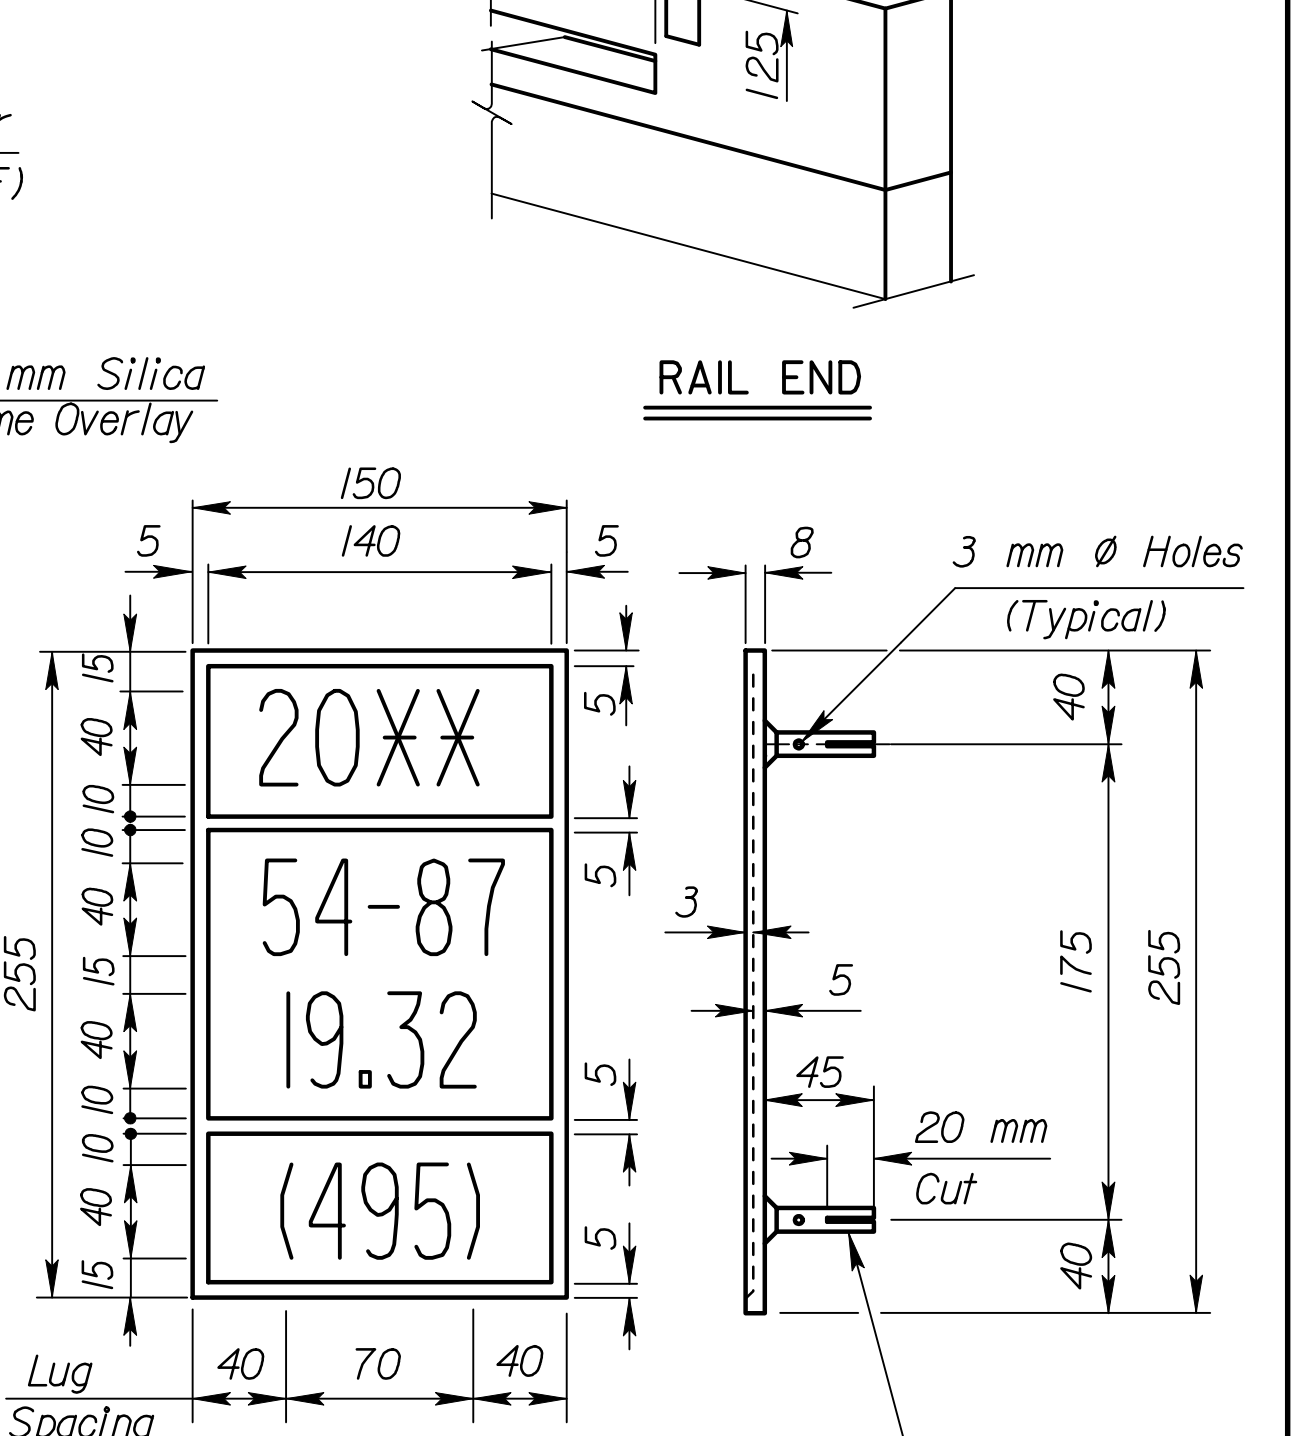
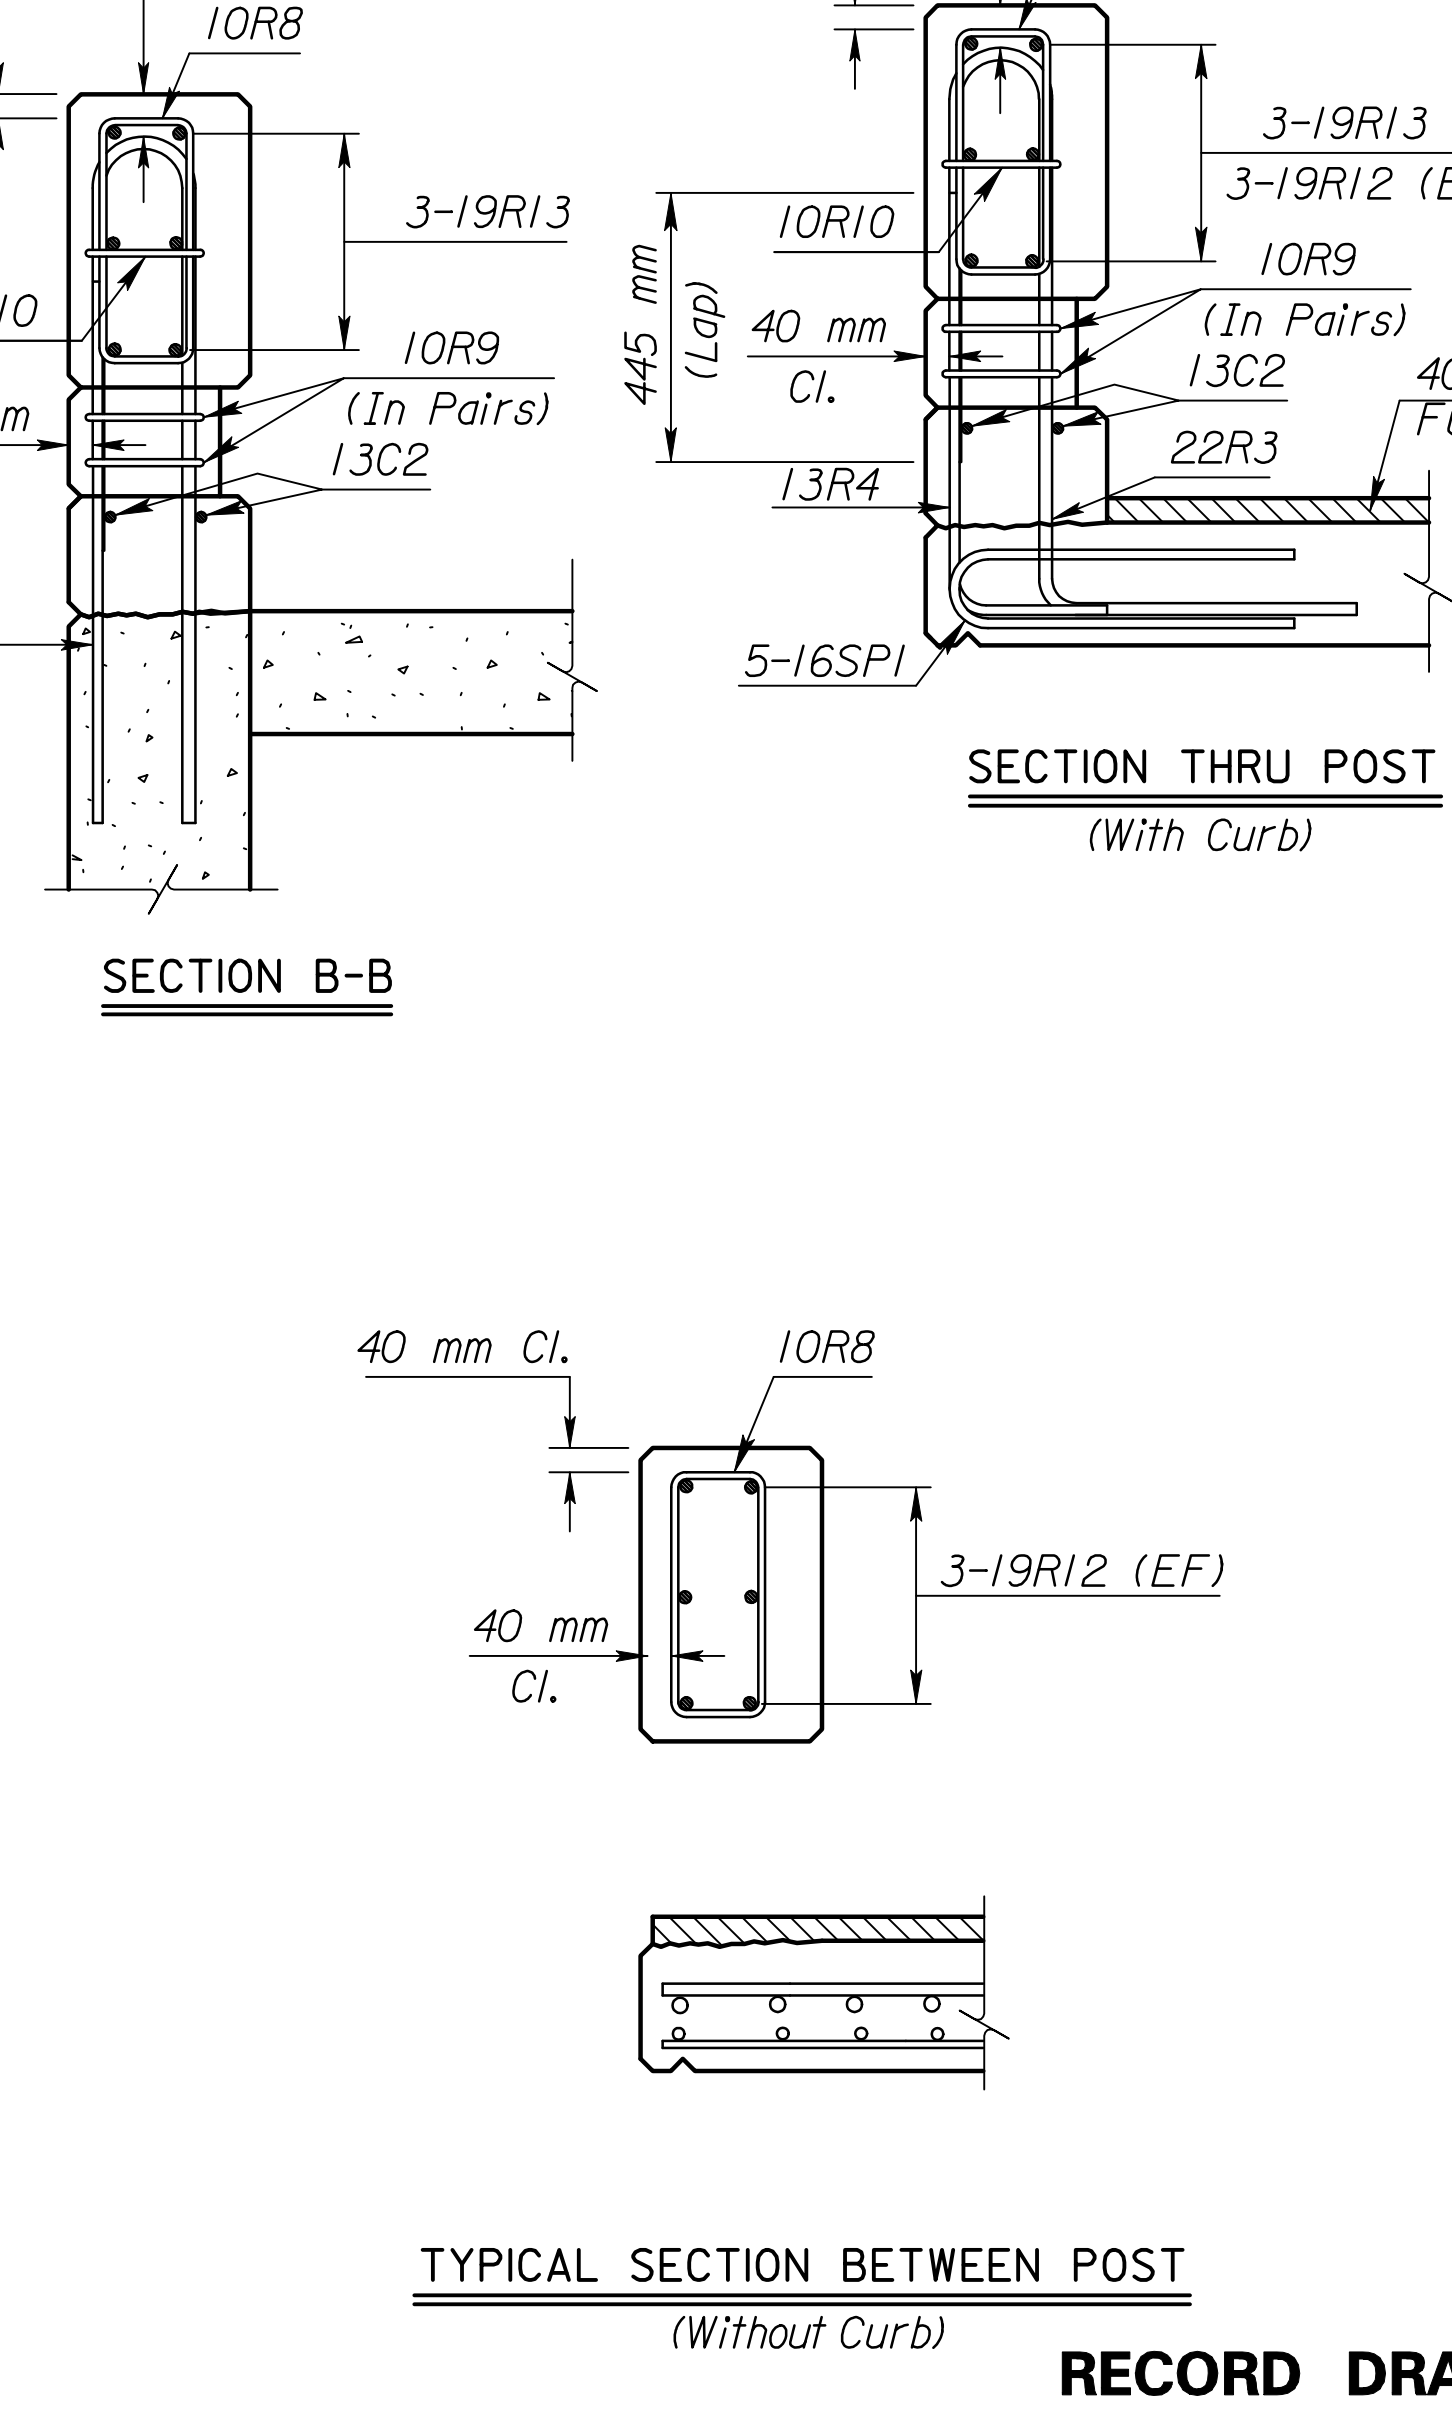
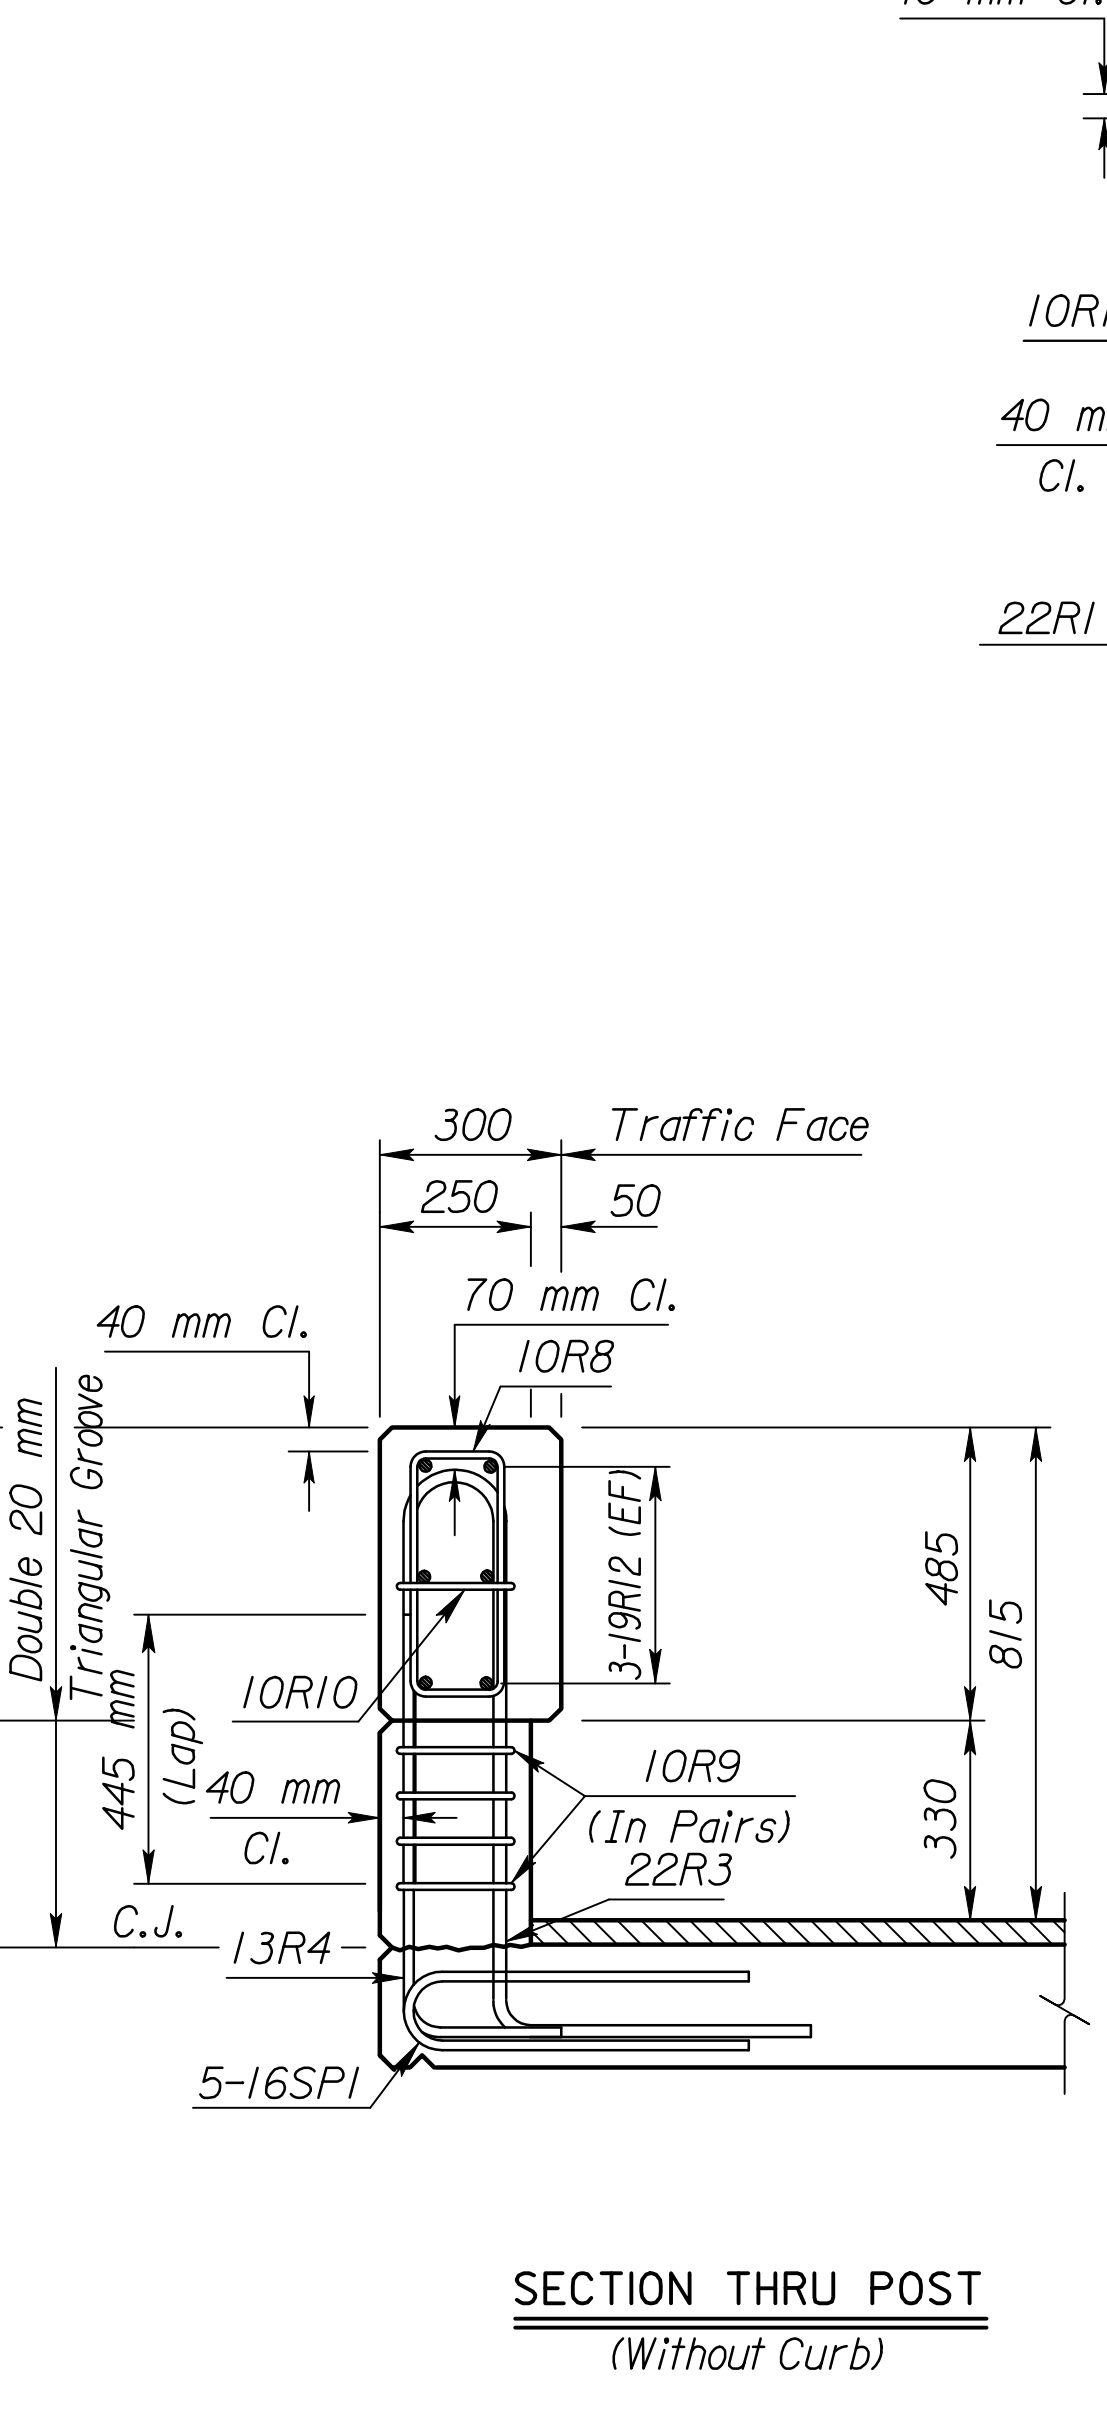
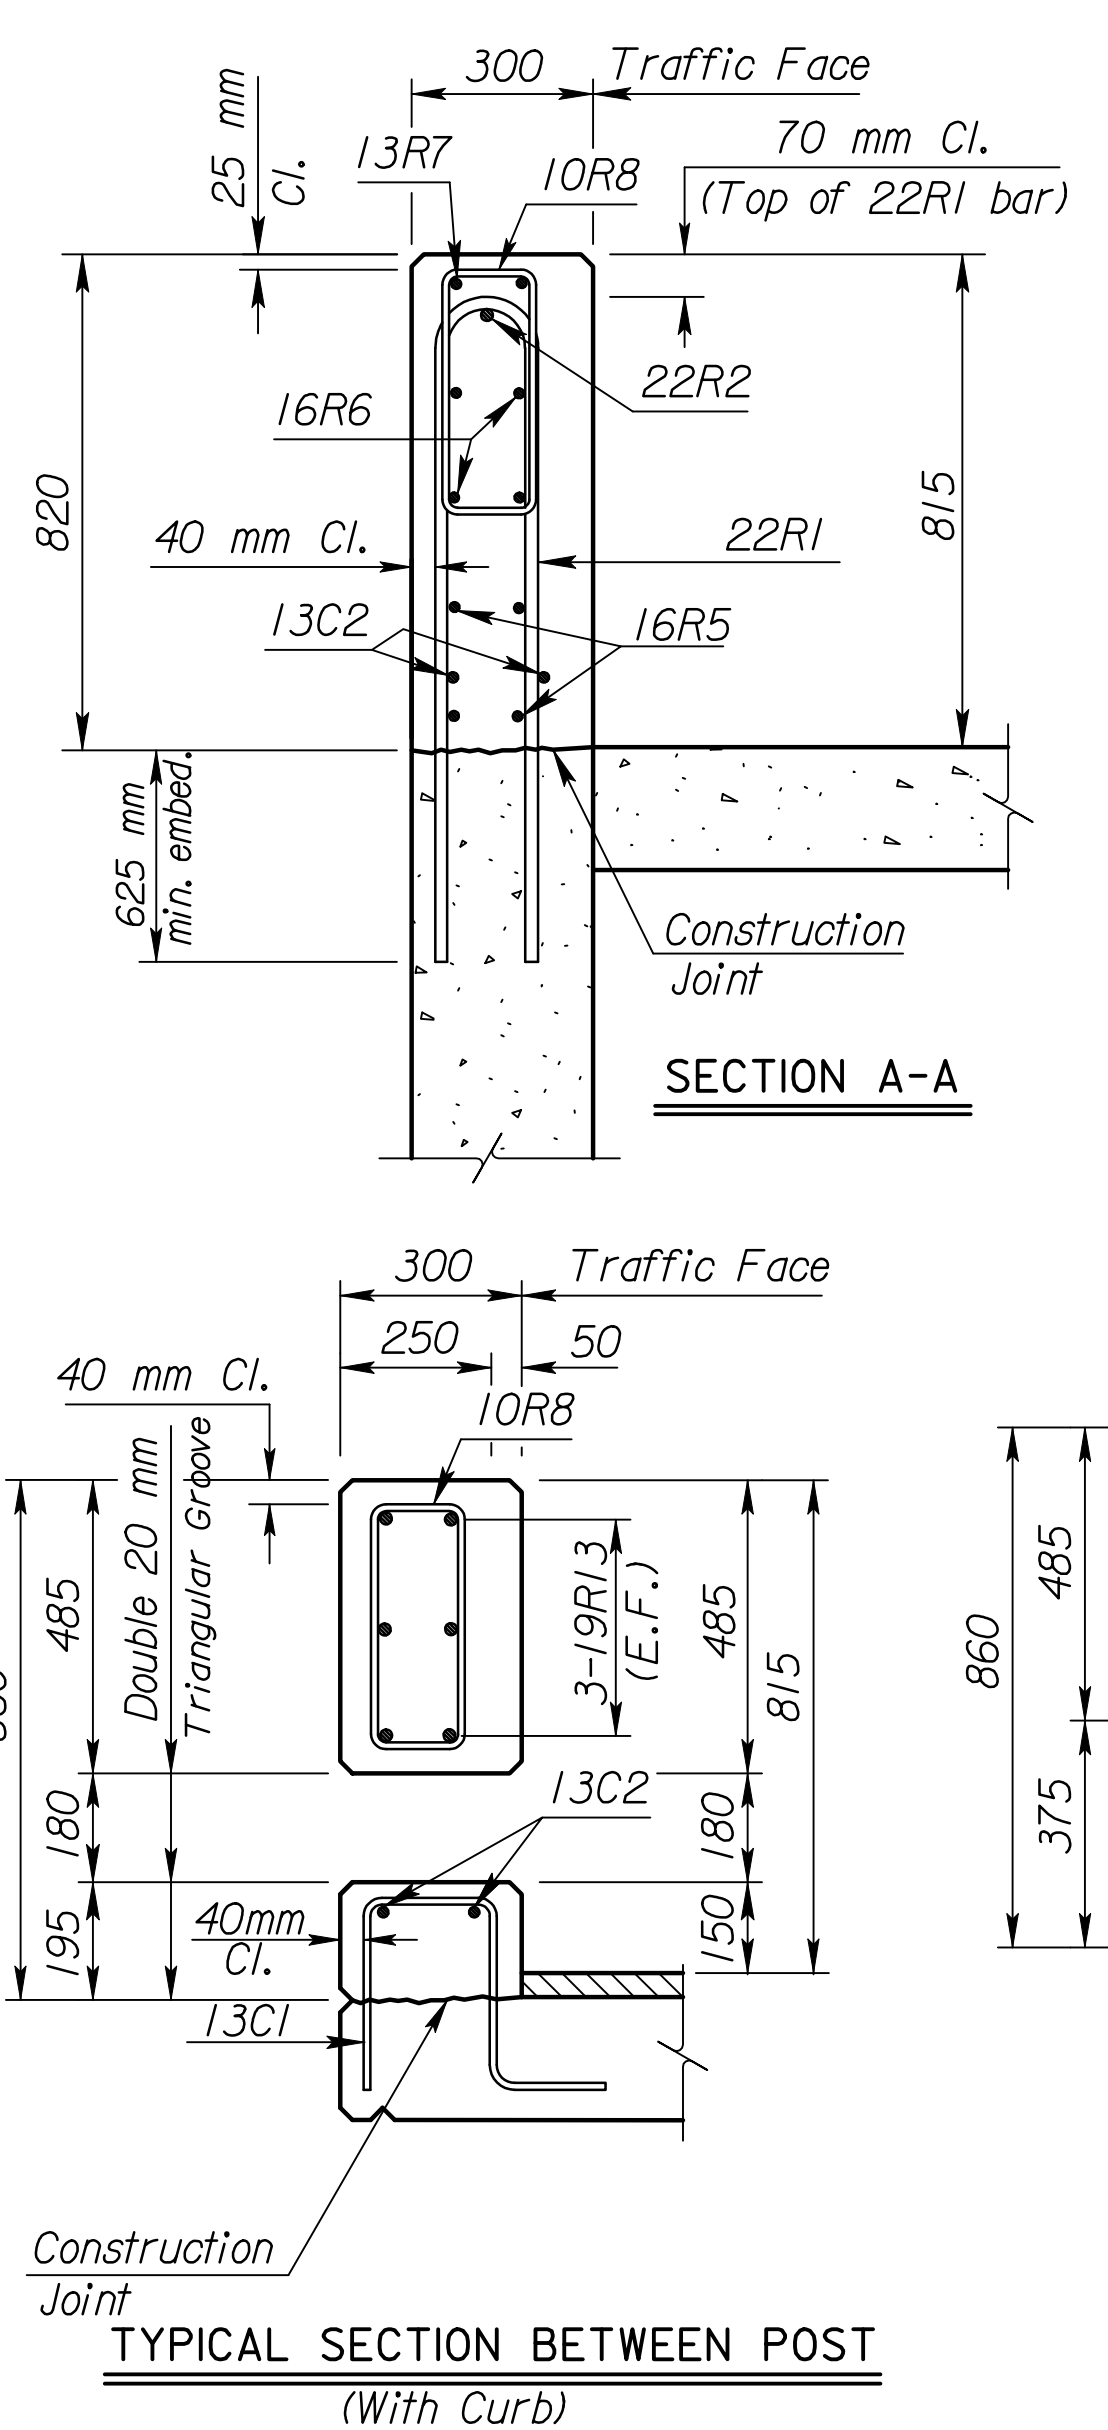
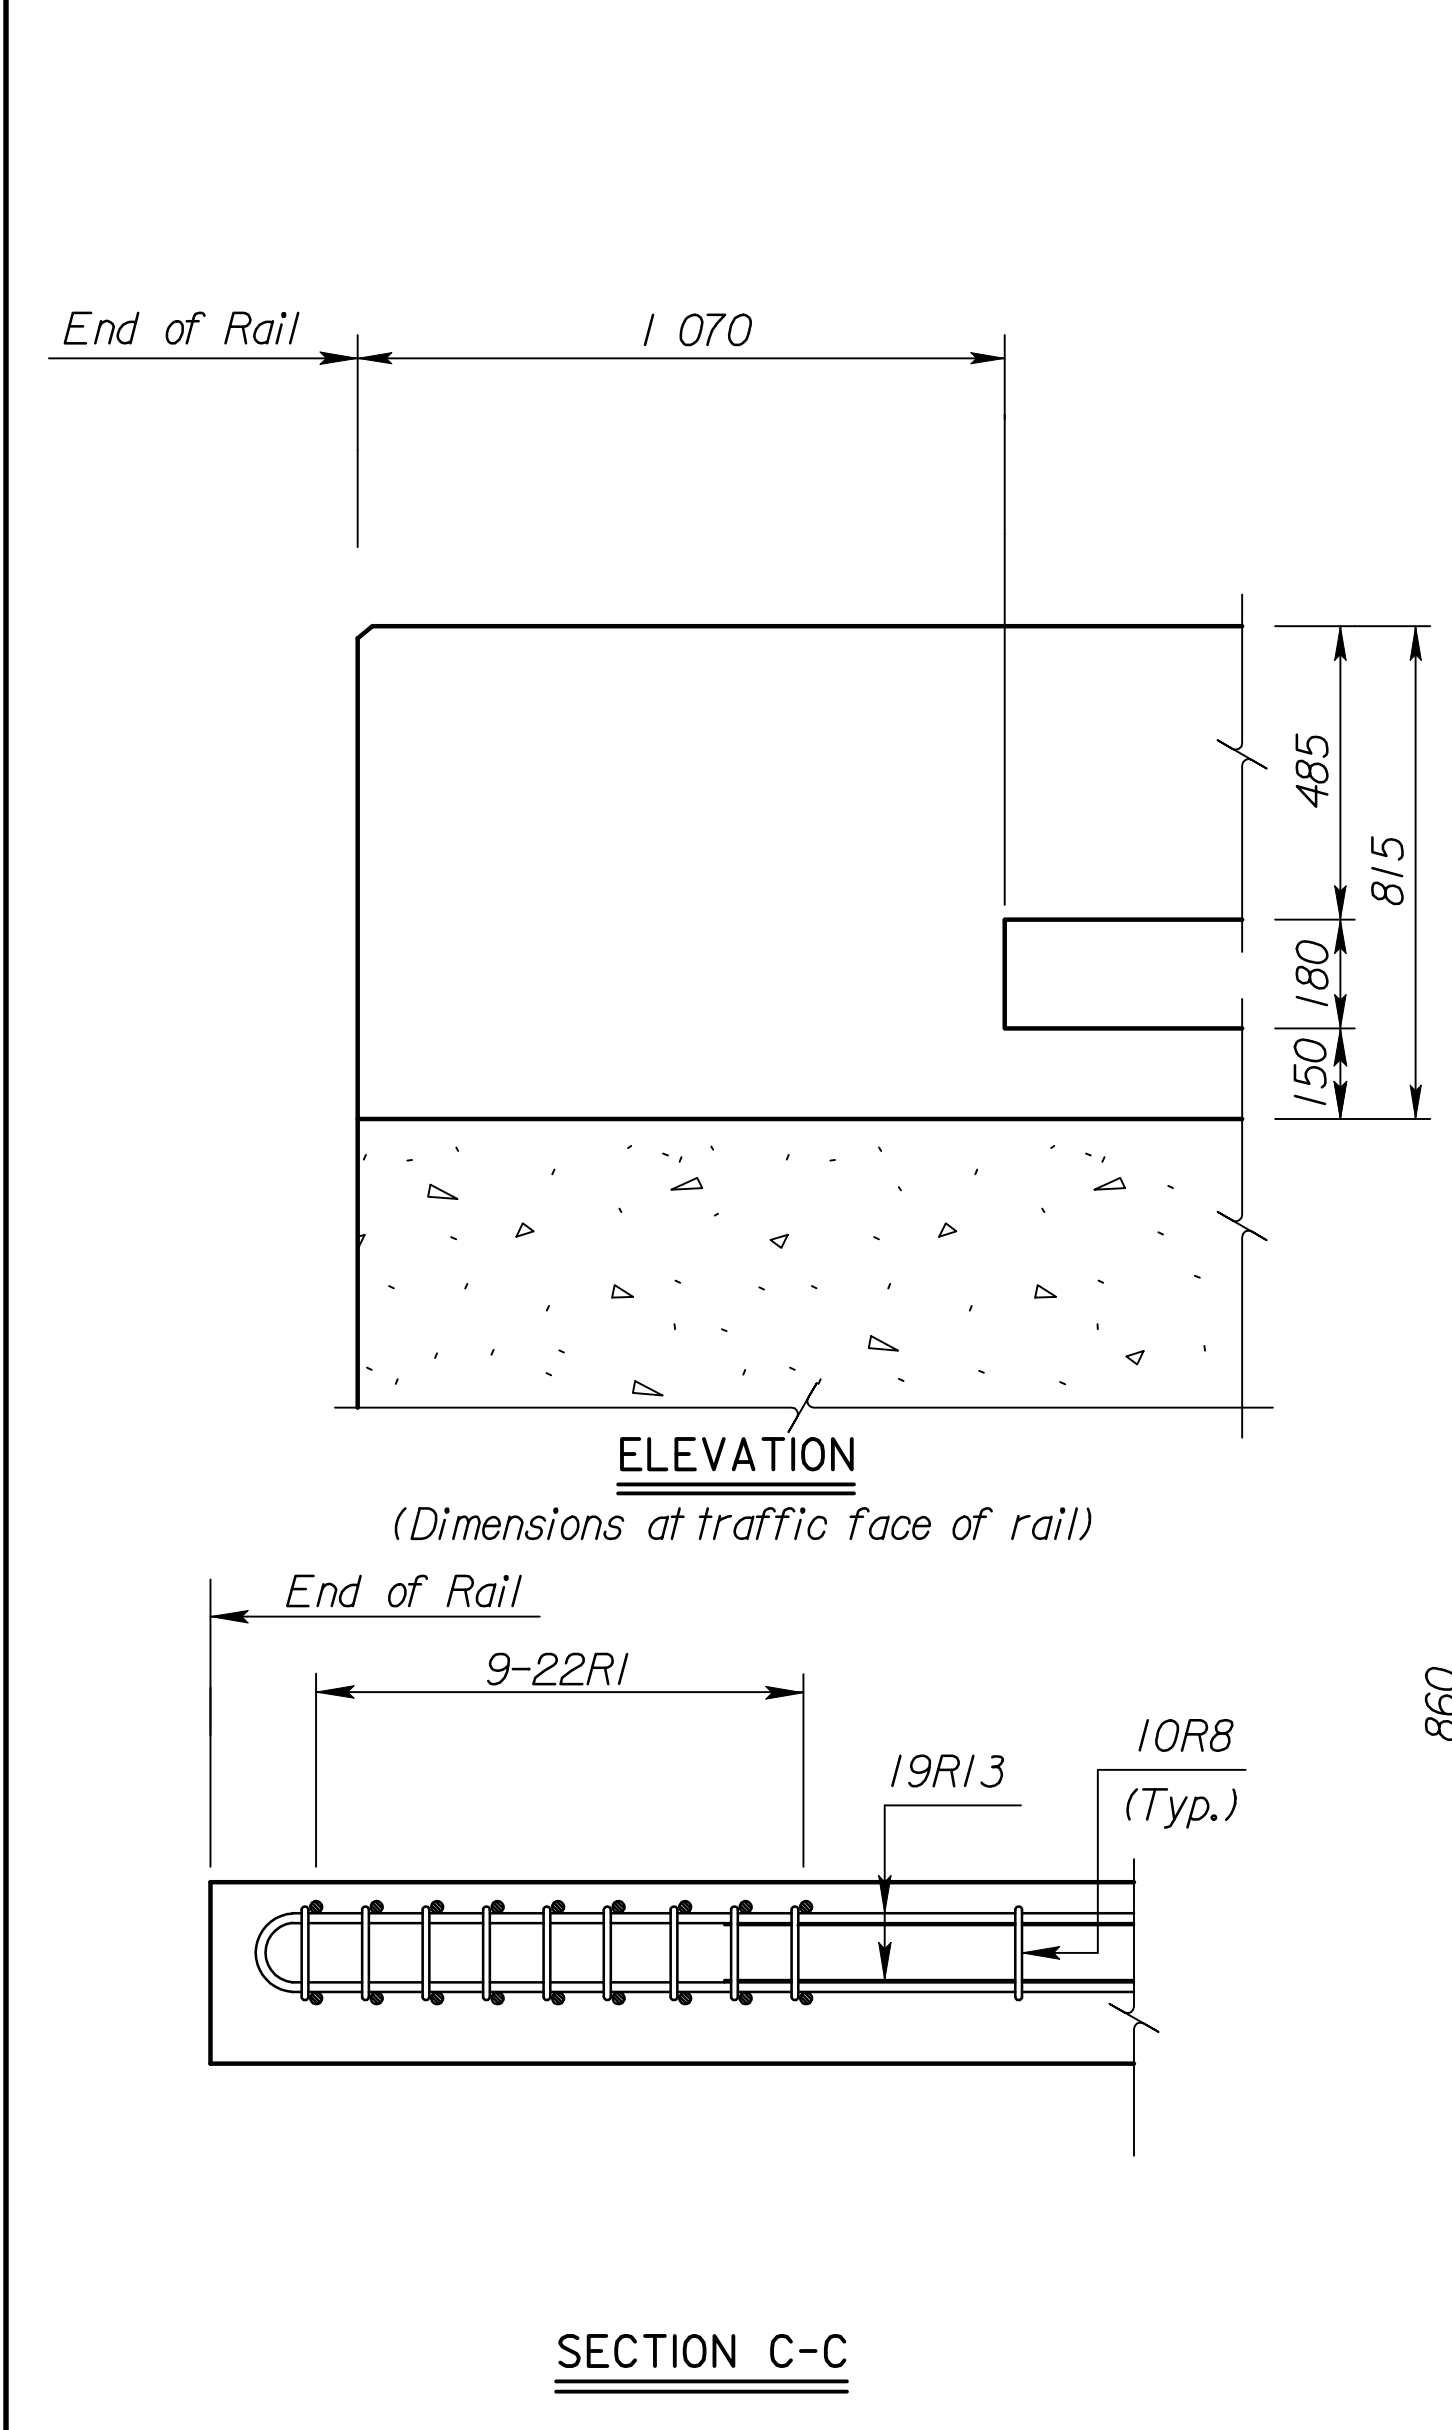


STATE	PROJECT NO.	YEAR	SHEET NO.	TOTAL SHEETS
KANSAS	54-87 K-6657-01	2002	495	1122

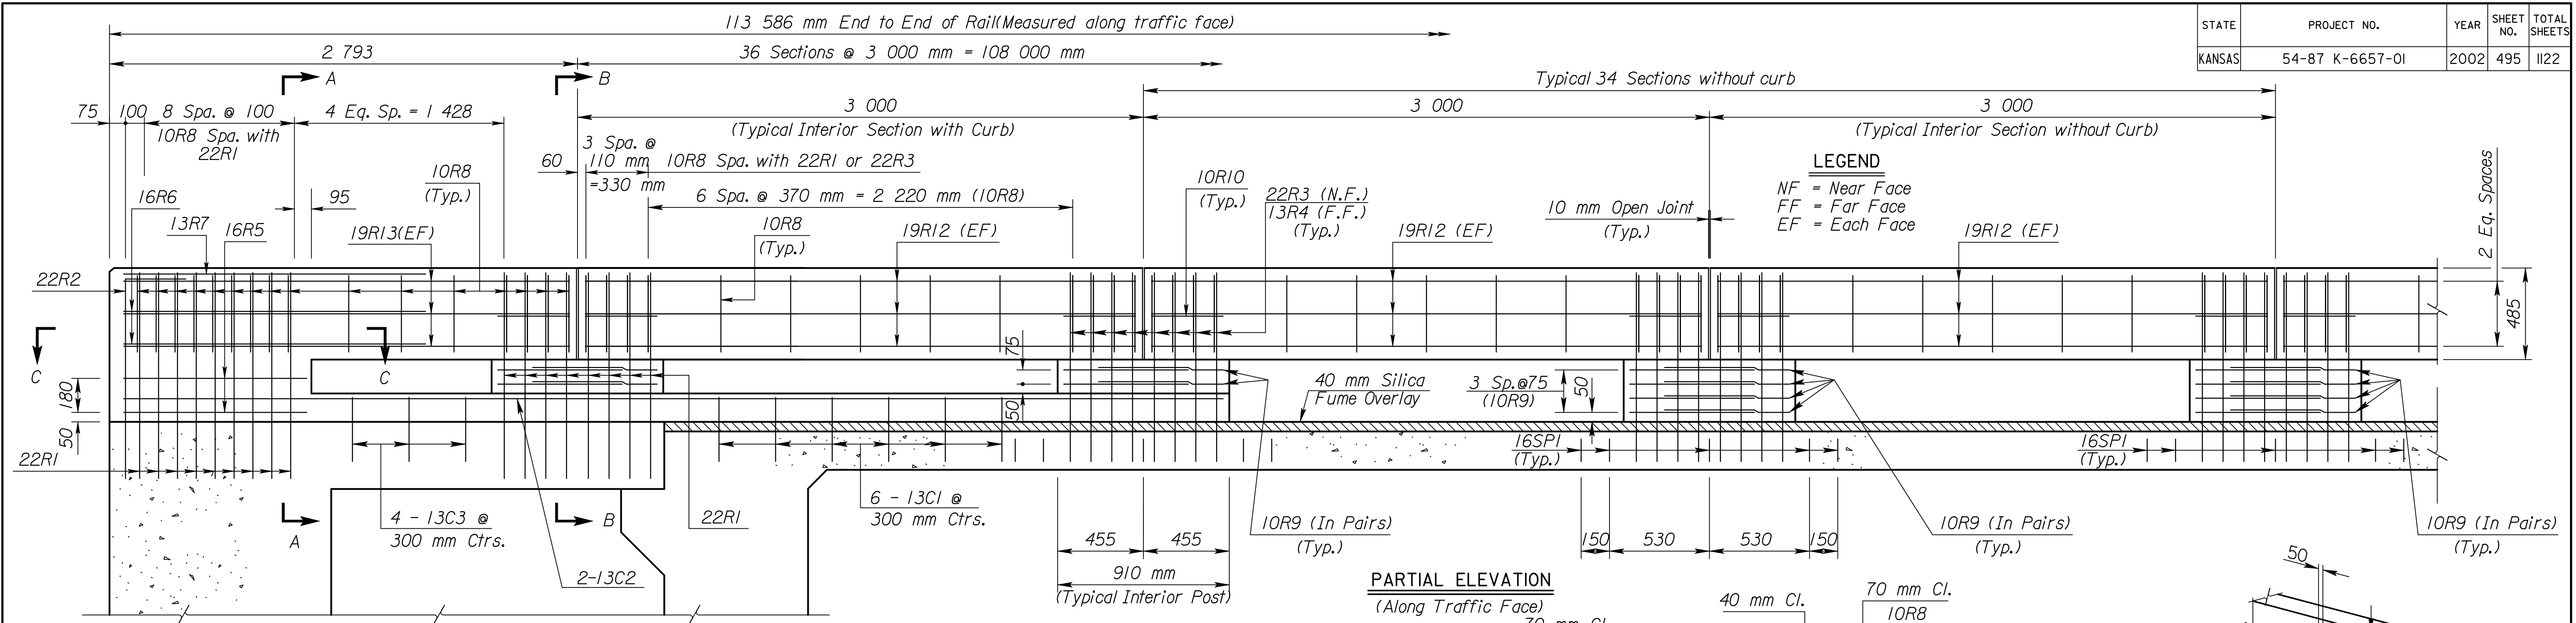

3				
2				
1	6-14-96	Current Release	BY	APP'D
NO.	DATE	REVISIONS		

**CITY OF WICHITA**  
Br. No. 54-87-19.32(495) F.W.B. Sta. 16+016.230

**815 mm KANSAS CORRAL RAIL**  
WB Frontage Rd. North Rail

**Sedgwick Co.**

SHEET NO.	OF	SCALE	APP'D
DESIGNED	DETAILED	QUANTITIES	CADD
DESIGN CK.	DETAIL CK.	QUAN. CK.	CADD CK.

Plotted By : gdr  
 Plot File : I:\1997\91362\As-Builts\dgn\Vol\_3\Sh\_495-KDOT\_ST-D-NorthRail.dgn  
 Last Rev: 9-4-07  
 By: gdr  
 Plot Date : Sept 07