


FHWA REGION NO.	STATE	PROJECT NO.	YEAR	SHEET NO.	TOTAL SHEETS
7	KANSAS	54-87 K-6657-01	2002	5160	1122



BR493, PIER#4

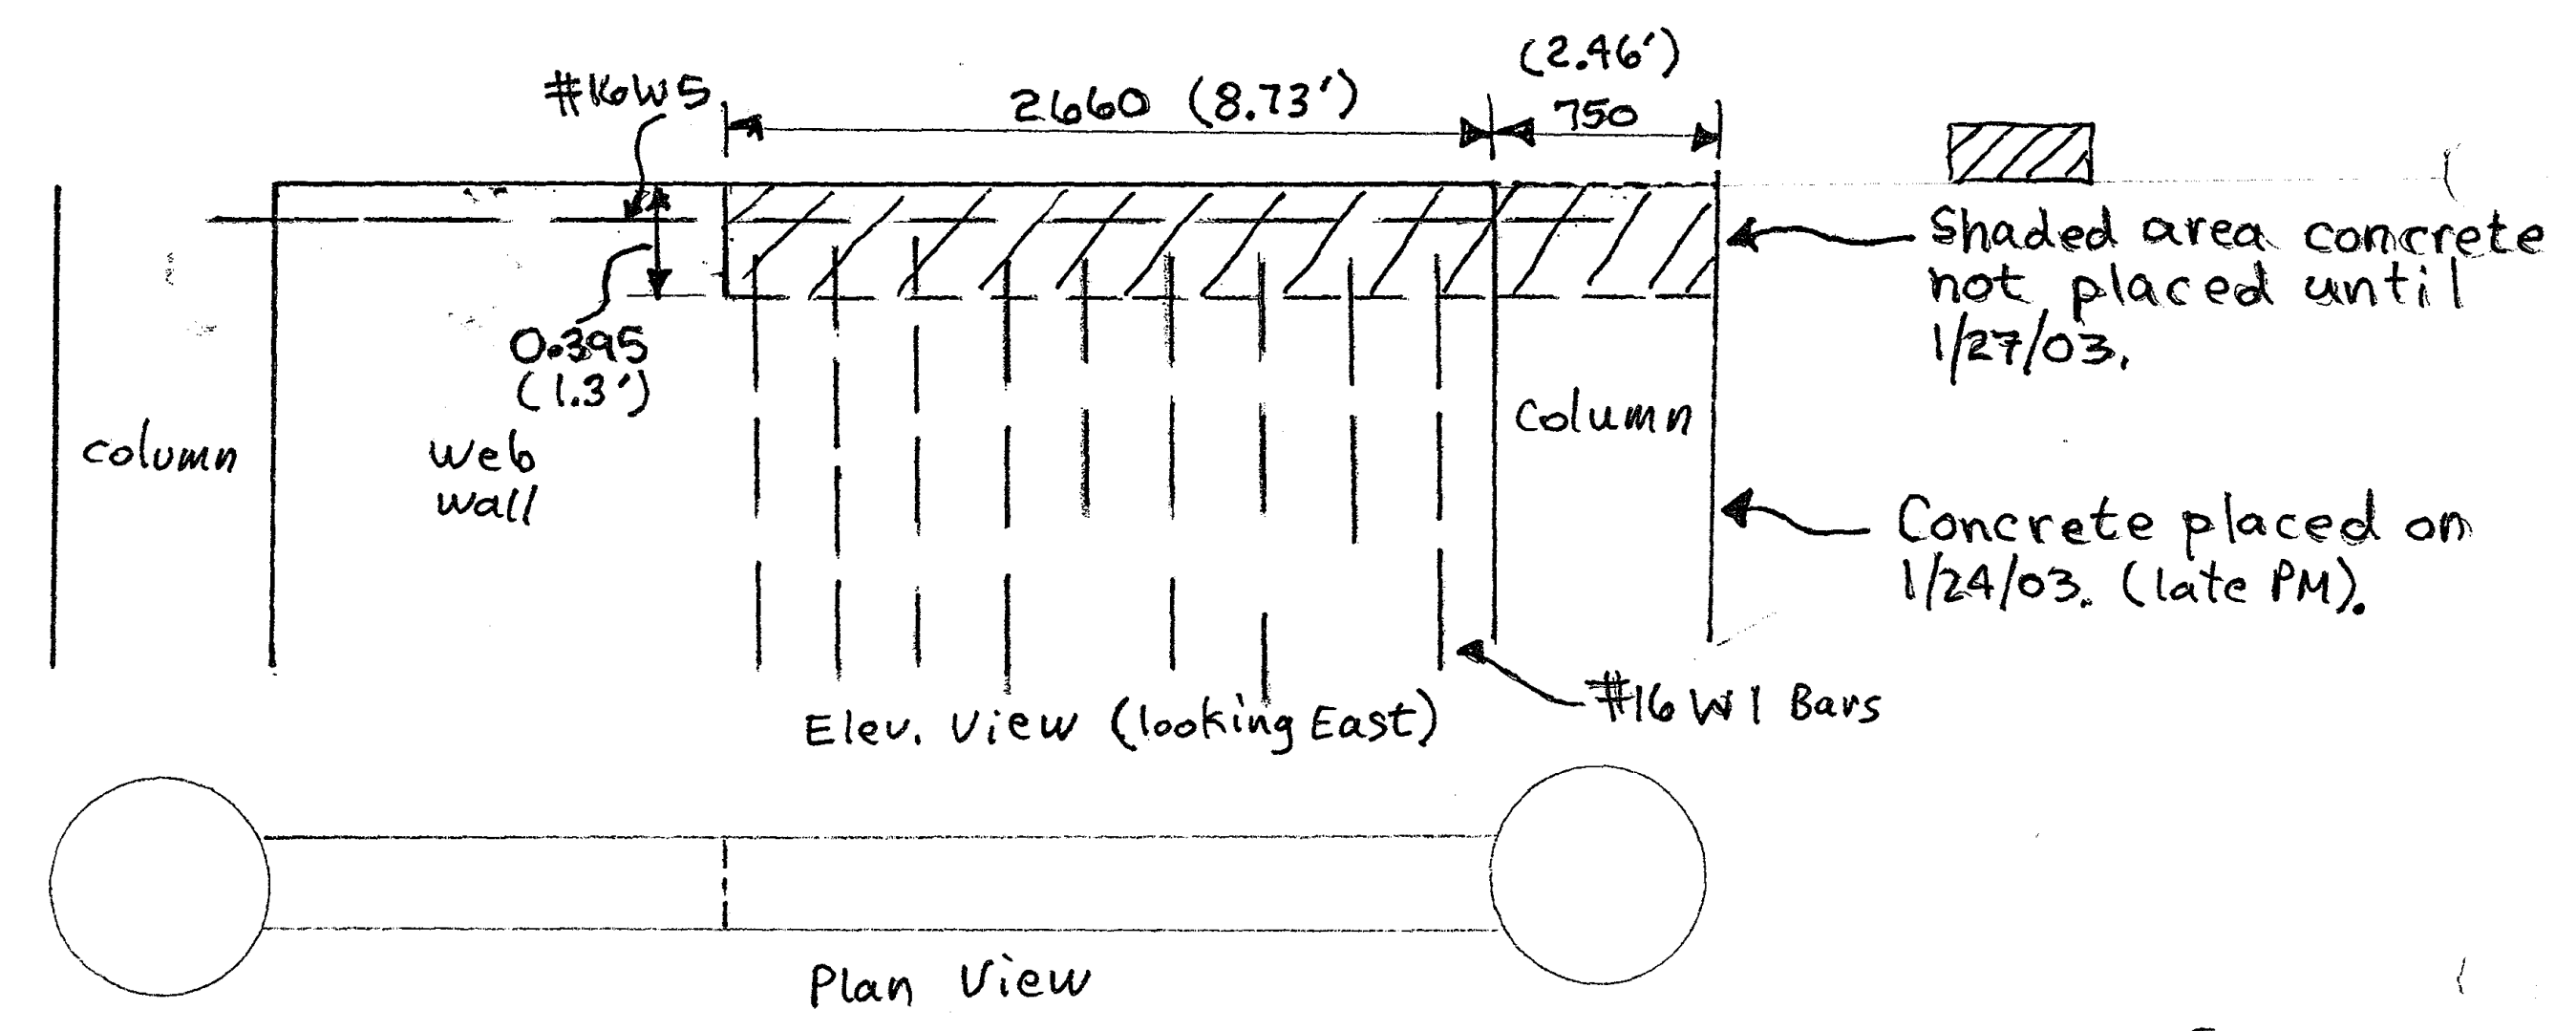


BR# 493 - PIER # 4  
(Mainline E.B. Kellogg)

PC

As-Built Sketch  
West Kellogg Freeway  
(WK)

**RECORD DRAWING**

1			
No.	Revisions	By	Date
CITY OF WICHITA			
BR. NO. 54-87-19.30(493)(E.B.)		STA. 16+01.650	
<b>PIER DETAILS</b>			
WEST KELLOGG (US-54) OVER COWSKIN CREEK SEDGWICK COUNTY			
 <b>Professional Engineering Consultants, P.A.</b> <small>303 S. TOPEKA • WICHITA, KANSAS 67202 316-262-2691 • FAX 316-262-3003</small>			
Designed by		Checked by	
Drawn by		Date	Job No. 97362

i:/1997/97362/As-Built/dgn's/Val 3/V8\_Files\_With\_Rasters/Sh 516a-pierdetails.dgn Last Rev: 9-4-07 By: gdr