
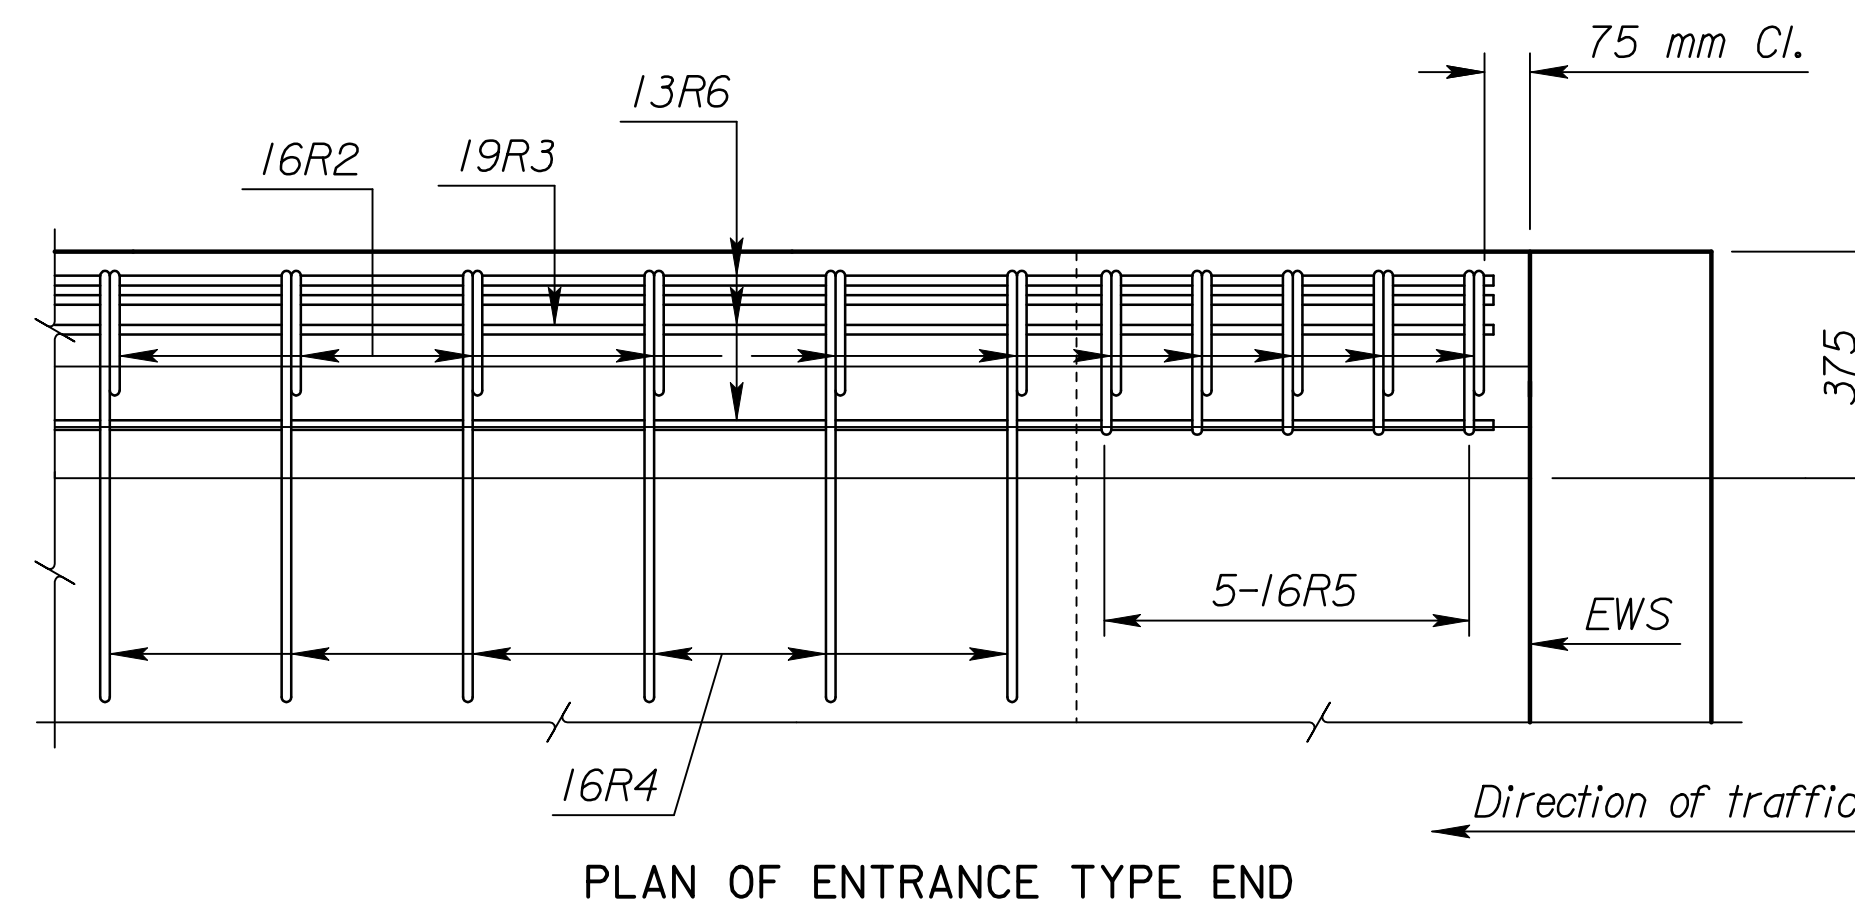
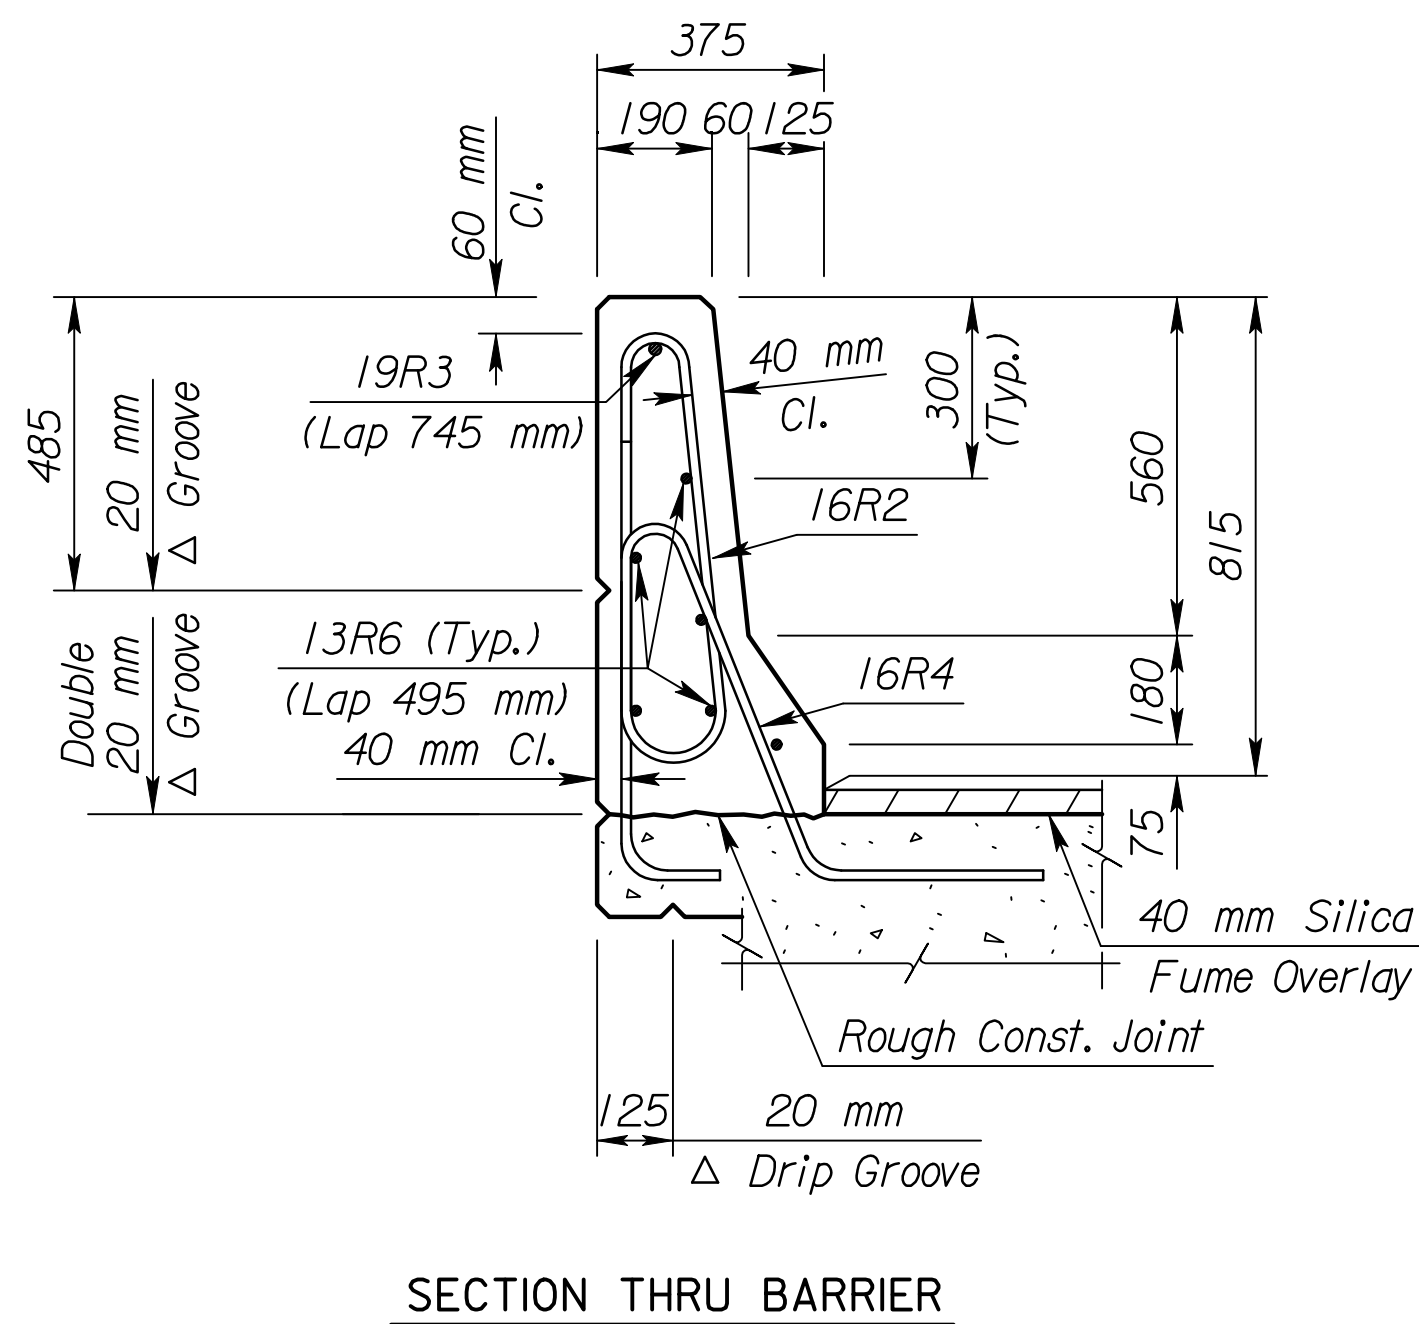
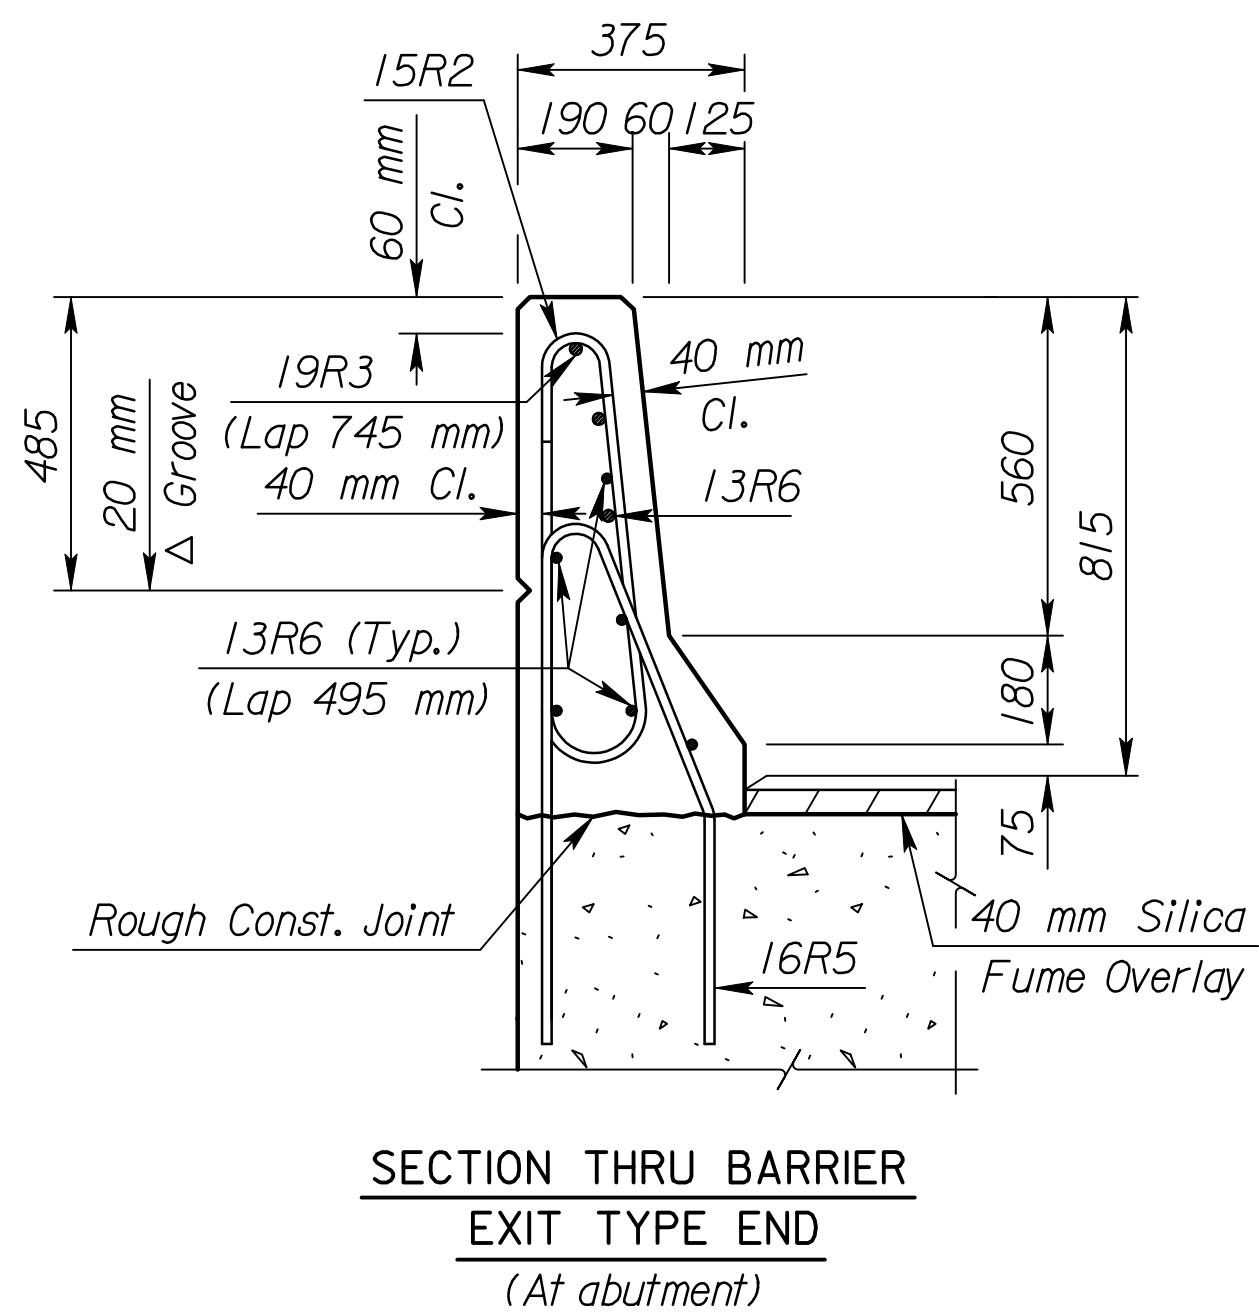


STATE	PROJECT NO.	YEAR	SHEET NO.	TOTAL SHEETS
KANSAS	54-87 K-6657-01	2002	527	1122

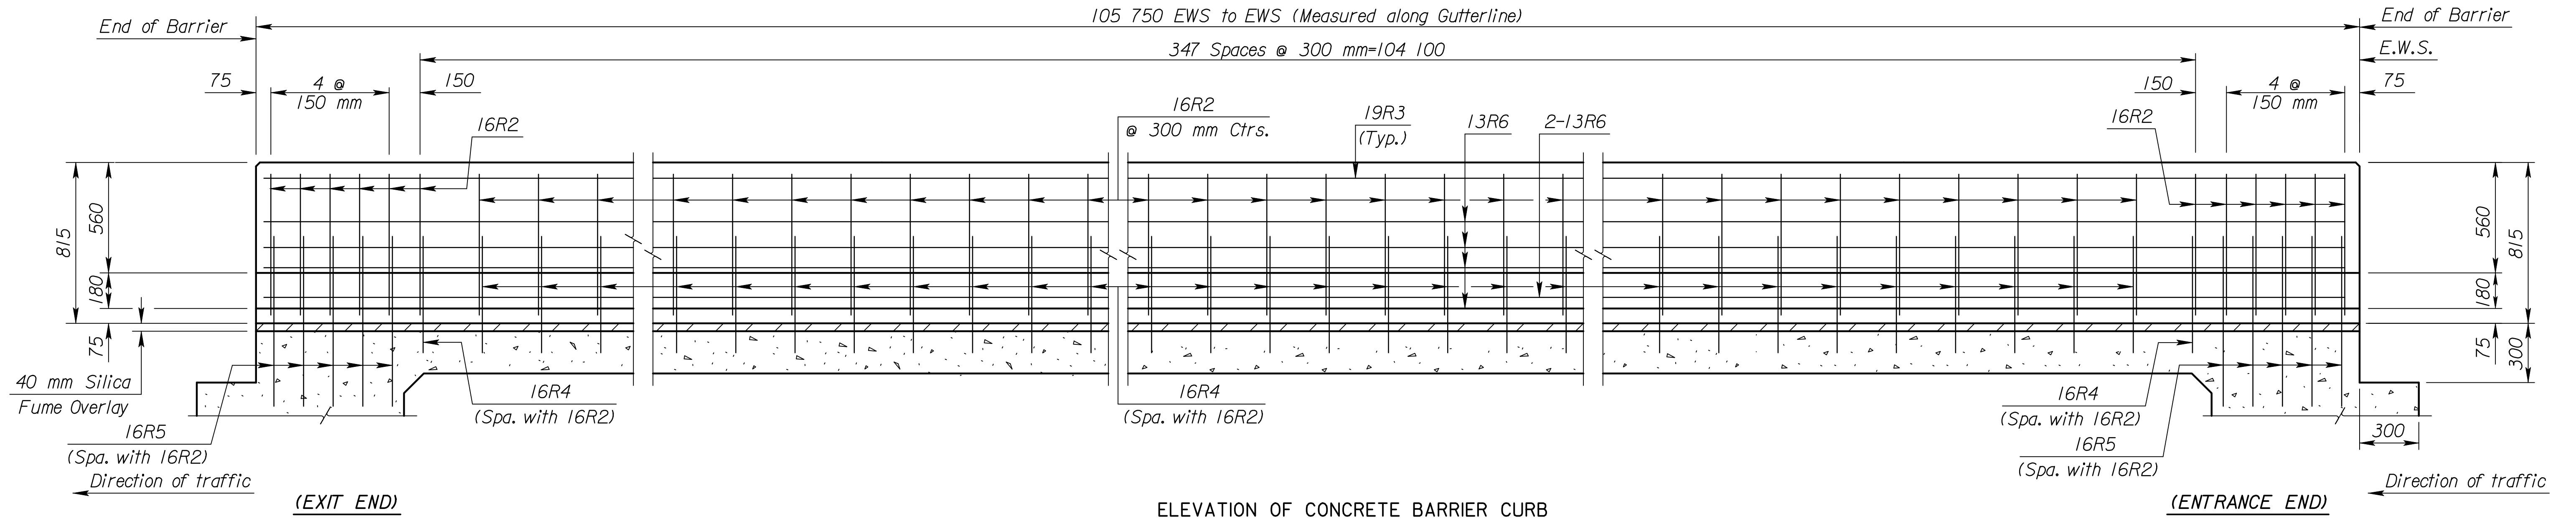

RECORD DRAWING

3					
2					
1	11-30-99	Current Release			
NO.	DATE	REVISIONS	BY	APP'D	
CITY OF WICHITA					
Br. No. 54-87-19.31(494) W.B.			Sta. 16+011.650		
Br. No. 54-87-19.30(493) E.B.			Sta. 16+011.650		
815 mm Interior Rail					
Sedgwick Co.					
SHEET NO.	OF	SCALE	APP'D		
DESIGNED		DETAILED	QUANTITIES	CADD	
DESIGN CK.		DETAIL CK.	QUAN. CK.	CADD CK.	

Scale: 1/000
 Plotted By: gdr
 Plot File: I:\1997\97362\As-Builts\dgrs\Vol_3\Sh 527-KDOT_ST-D-EDMaintenance.dgn Last Rev: 9-5-07 By: gdr
 Plot Date: Sept. 07