
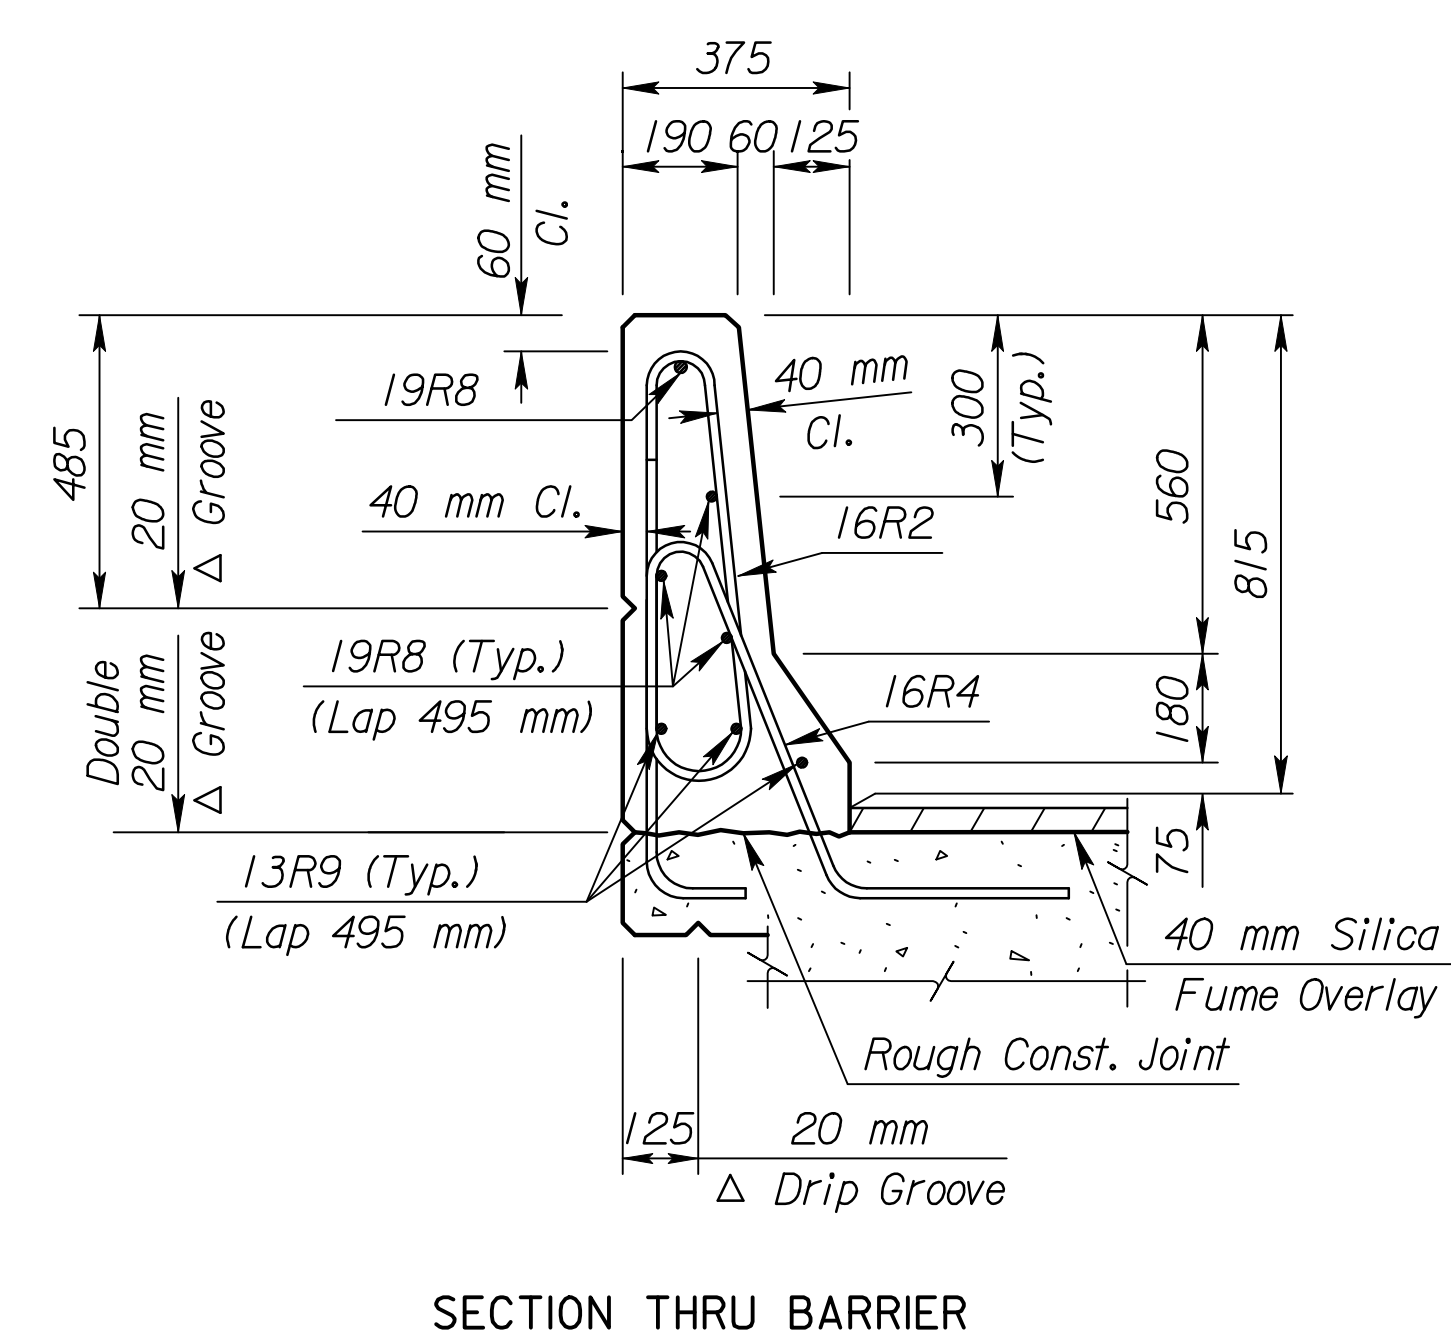
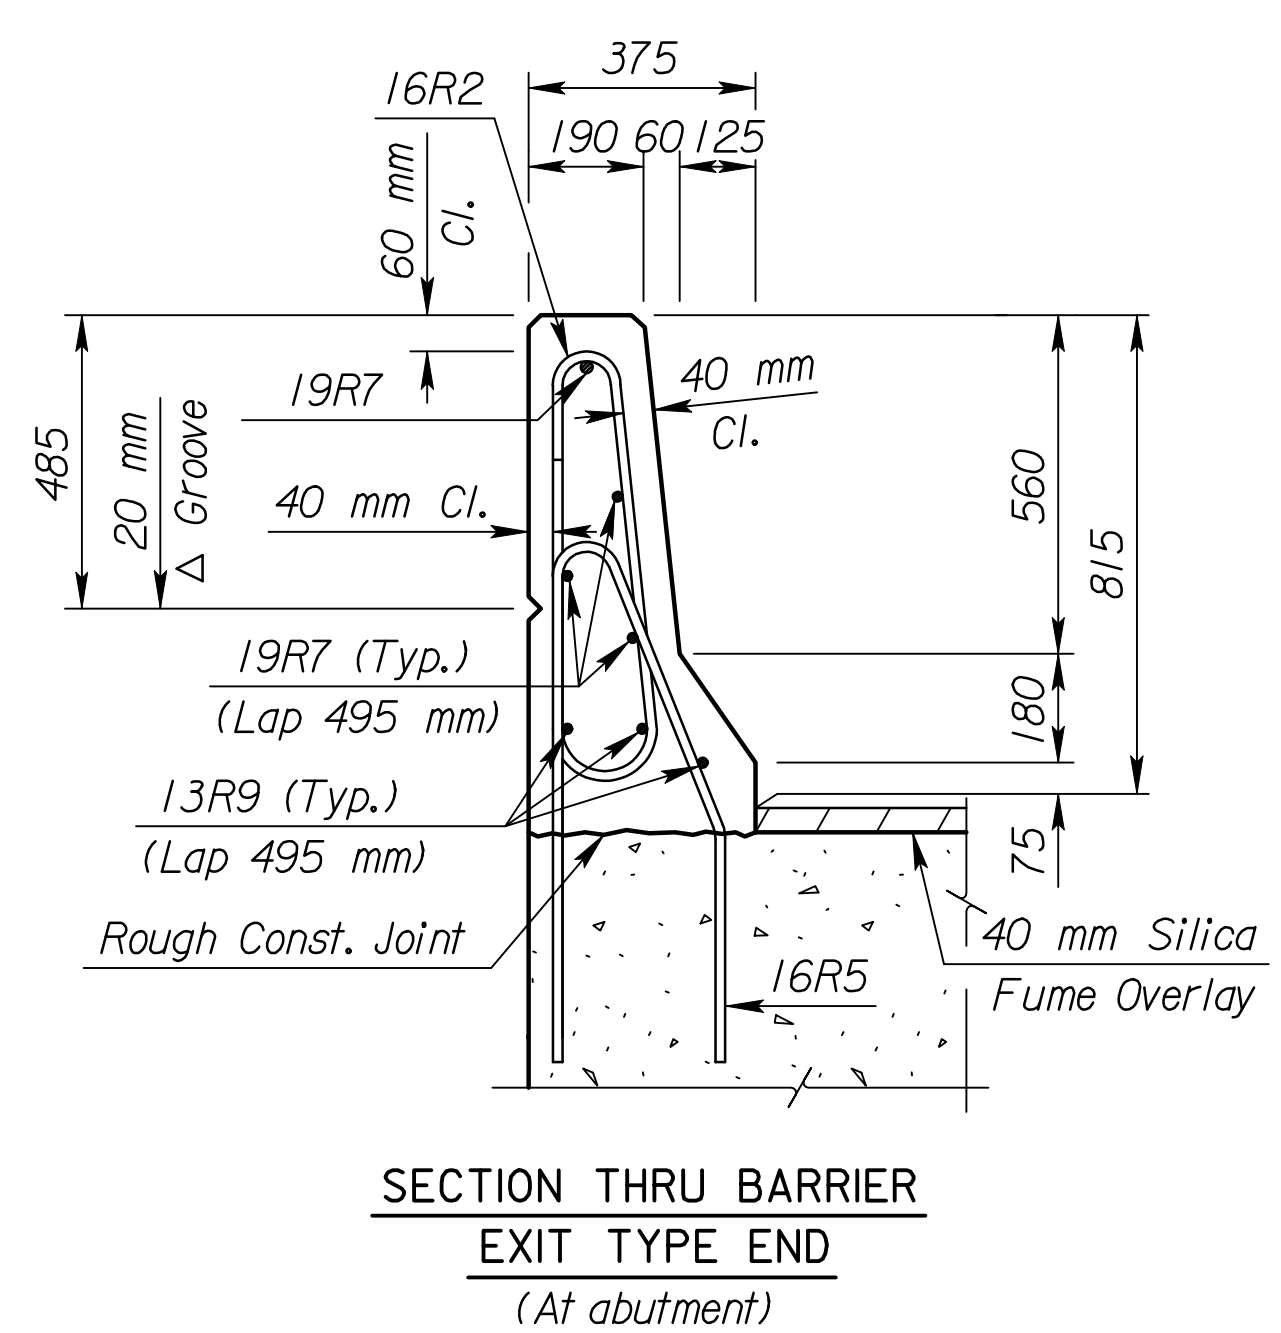
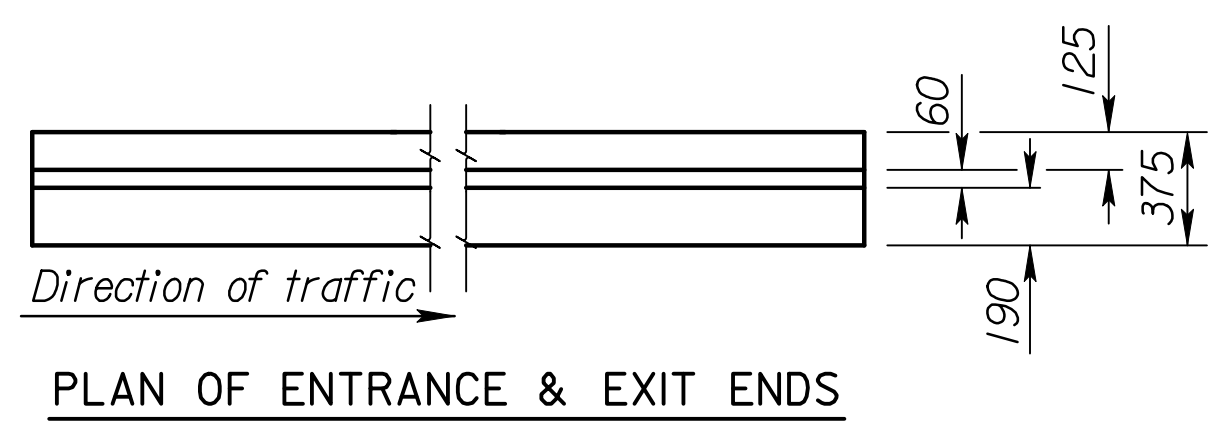


STATE	PROJECT NO.	YEAR	SHEET NO.	TOTAL SHEETS
KANSAS	54-87 K-6657-01	2002	600	1122

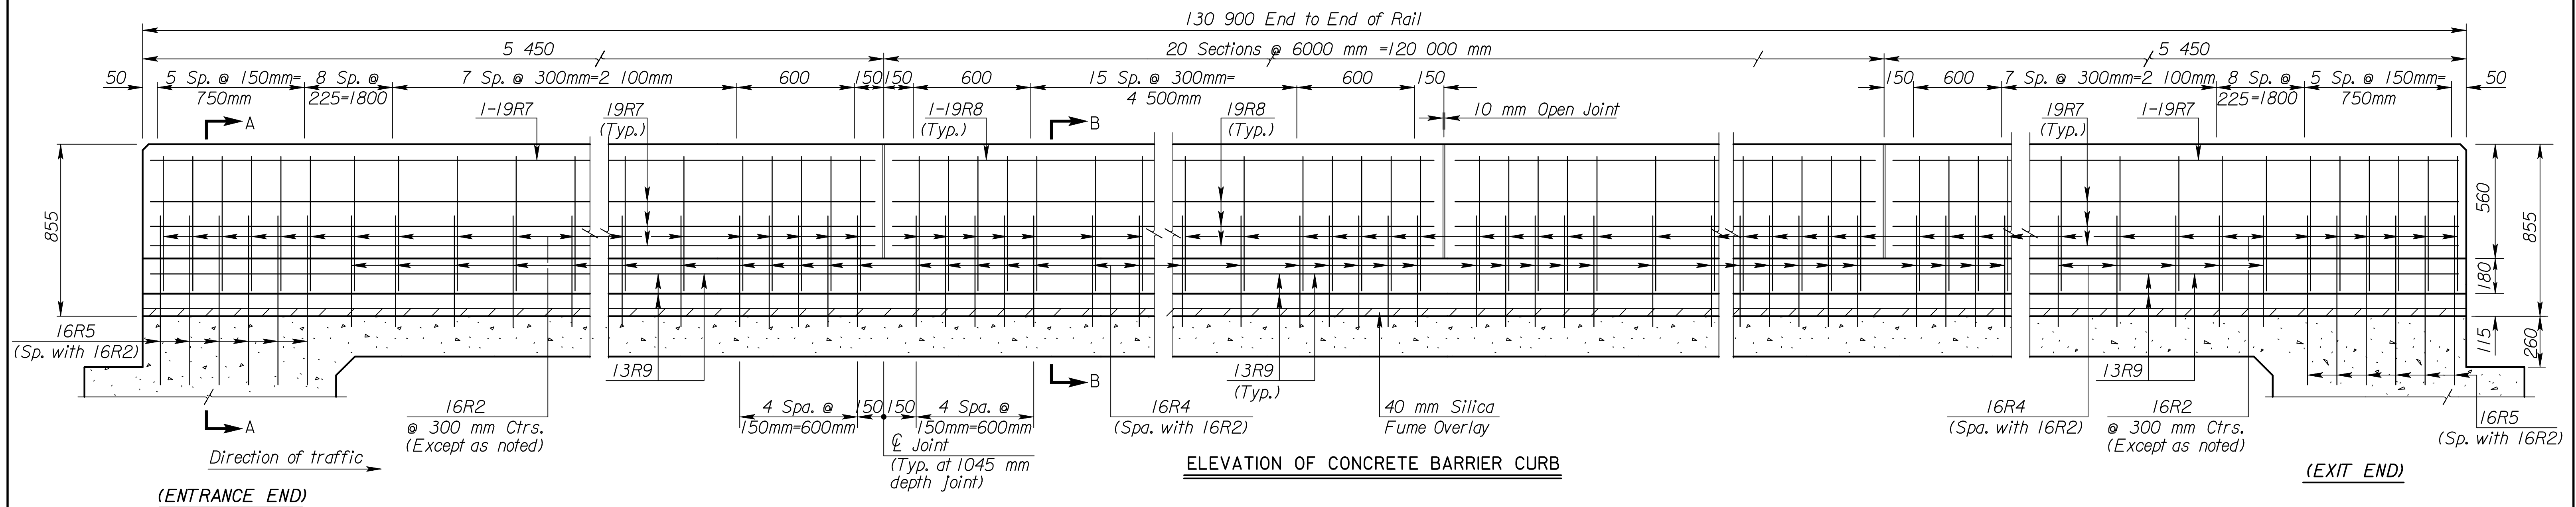

Plotted By : gdr  
 Plot File : I:\1997\97362\As-Builts\dgrs\Vol\_3\Sh 600-KDOT\_ST-D-81\InteriorRail.dgn Last Rev: 9-6-07 By: gdr  
 Plot Date : Sept. 07

3				
2				
1	10-27-00	Current Release		
NO.	DATE	REVISIONS	BY	APP'D

**CITY OF WICHITA**  
 Br. No. 54-87-20.13(496) W.B. Sta. 17+332.607  
 Br. No. 54-87-20.12(497) E.B. Sta. 17+332.607  
 815mm F2 BARRIER CURB  
 INTERIOR RAIL  
 KELLOGG (US 54) OVER TYLER ROAD  
 SEDGWICK Co.

SHEET NO.	OF	SCALE	APP'D
DESIGNED	BY	DATE	QUANTITIES
DESIGN CK.	DETAIL CK.	QUAN. CK.	CADD CK.

**RECORD DRAWING**