
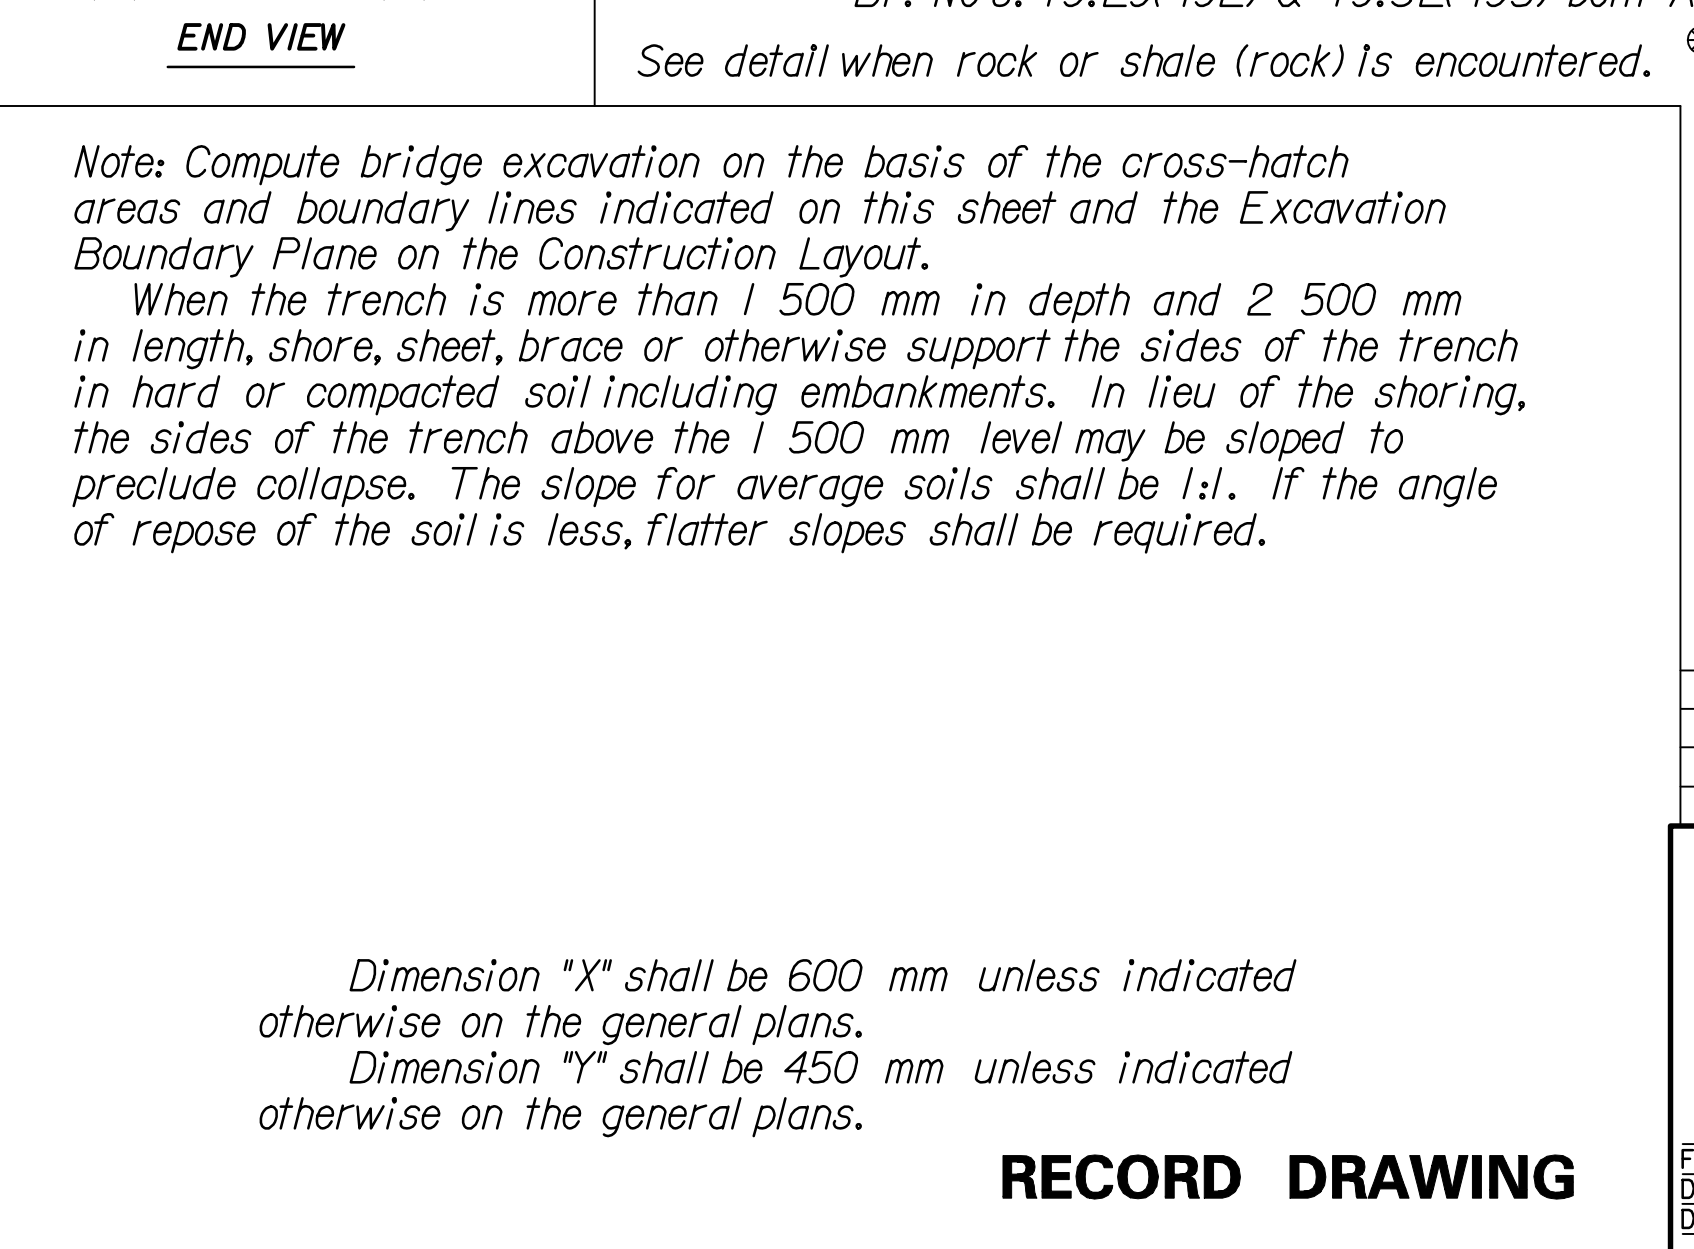
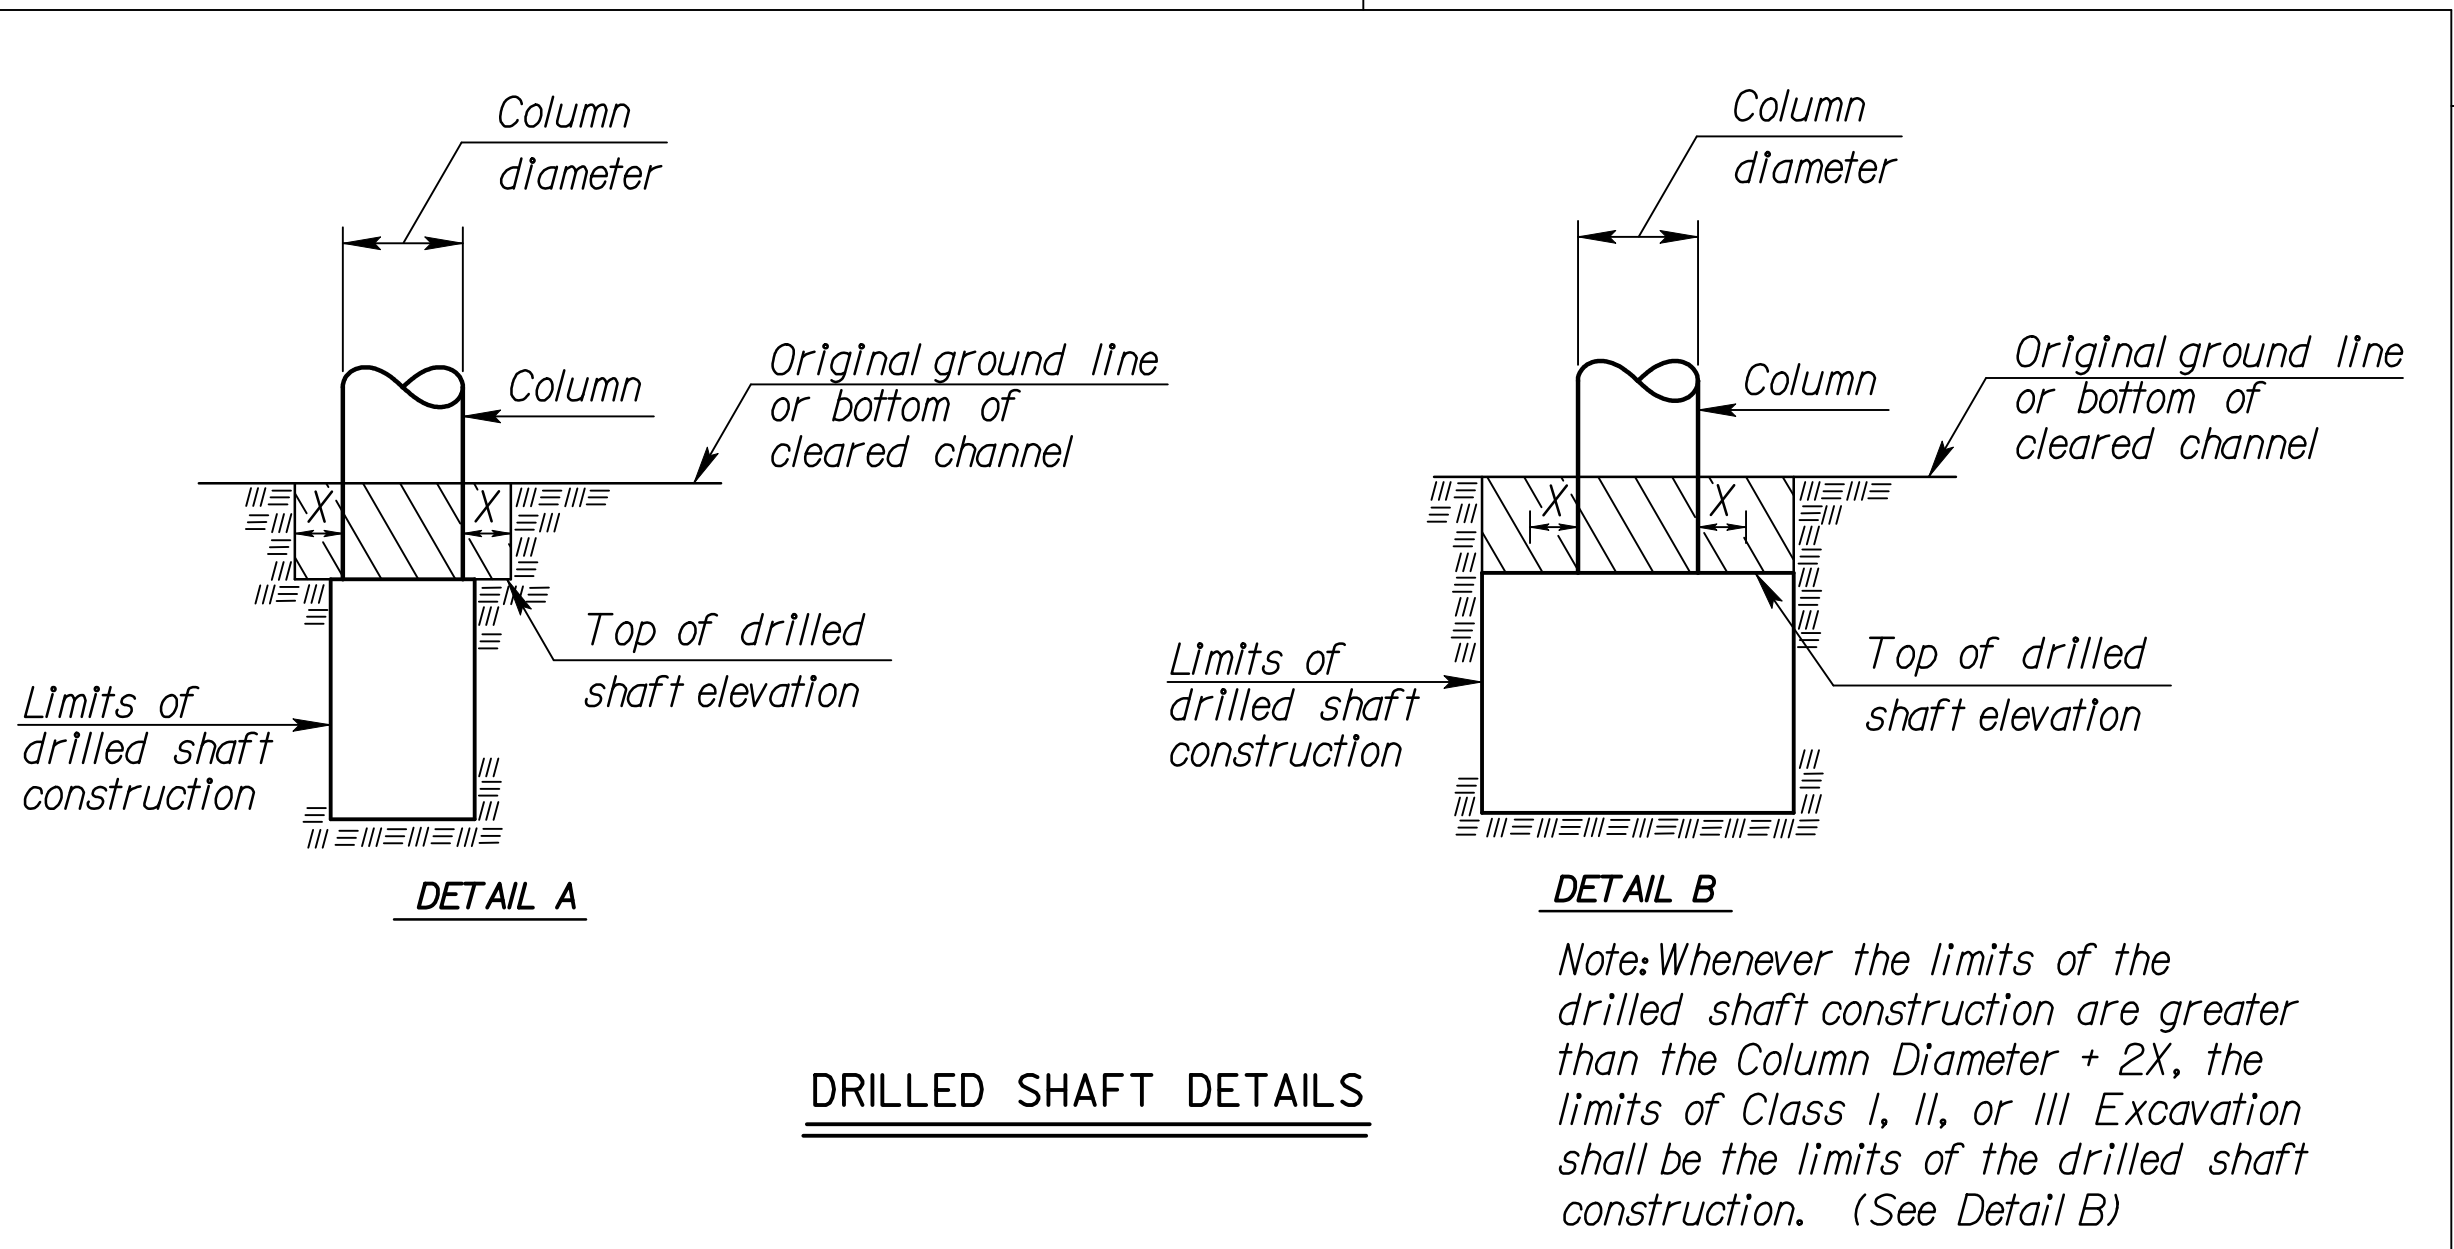
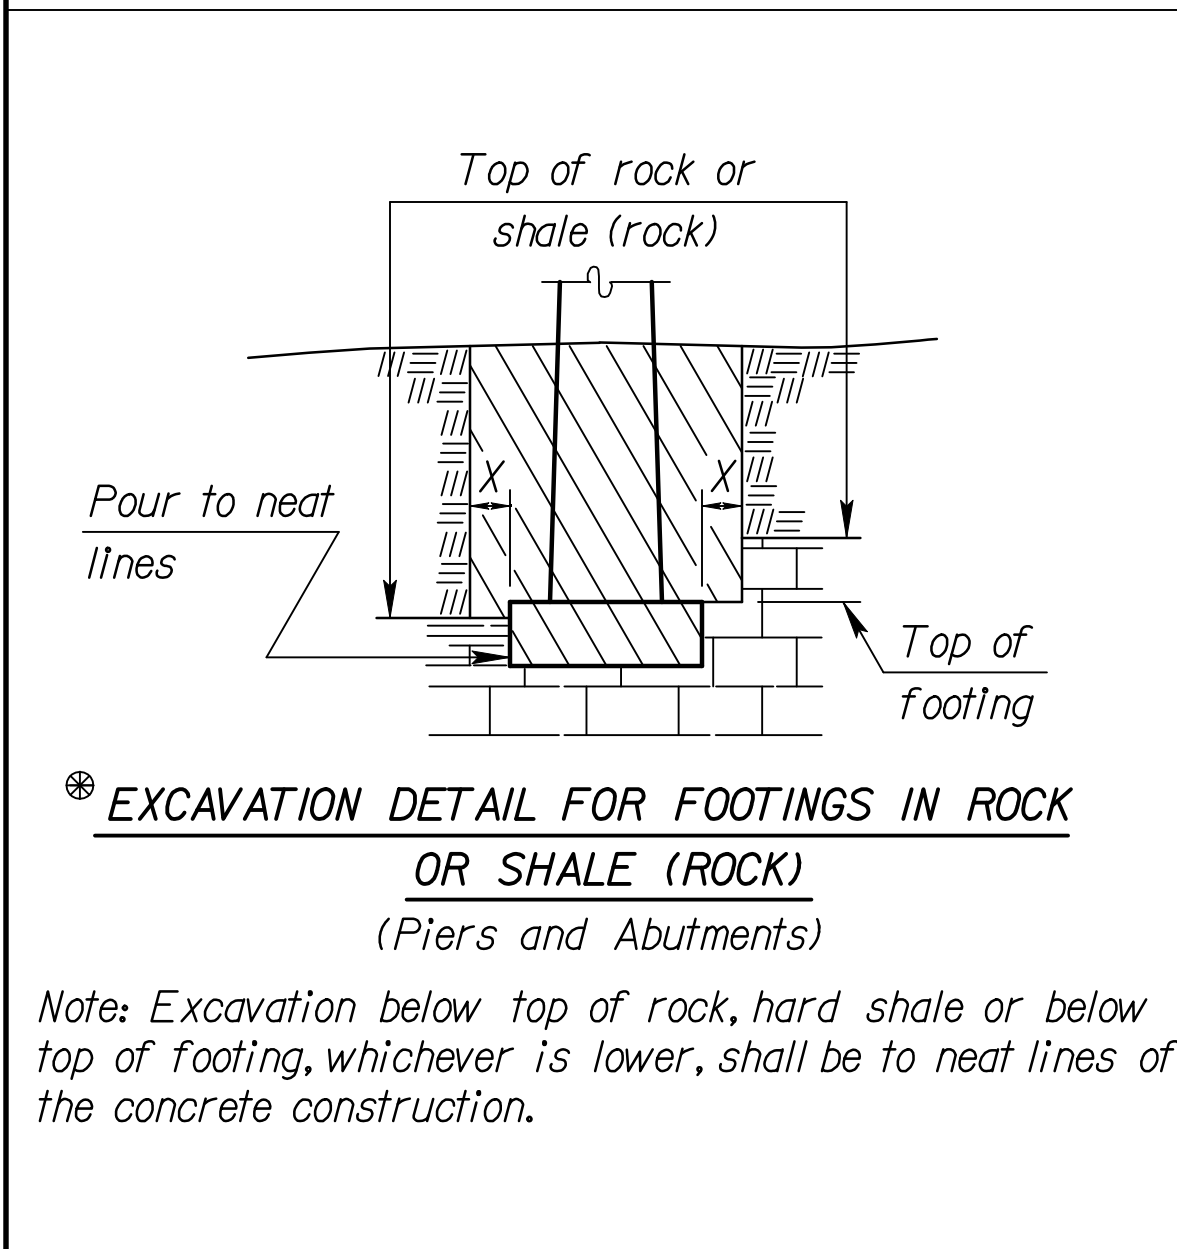
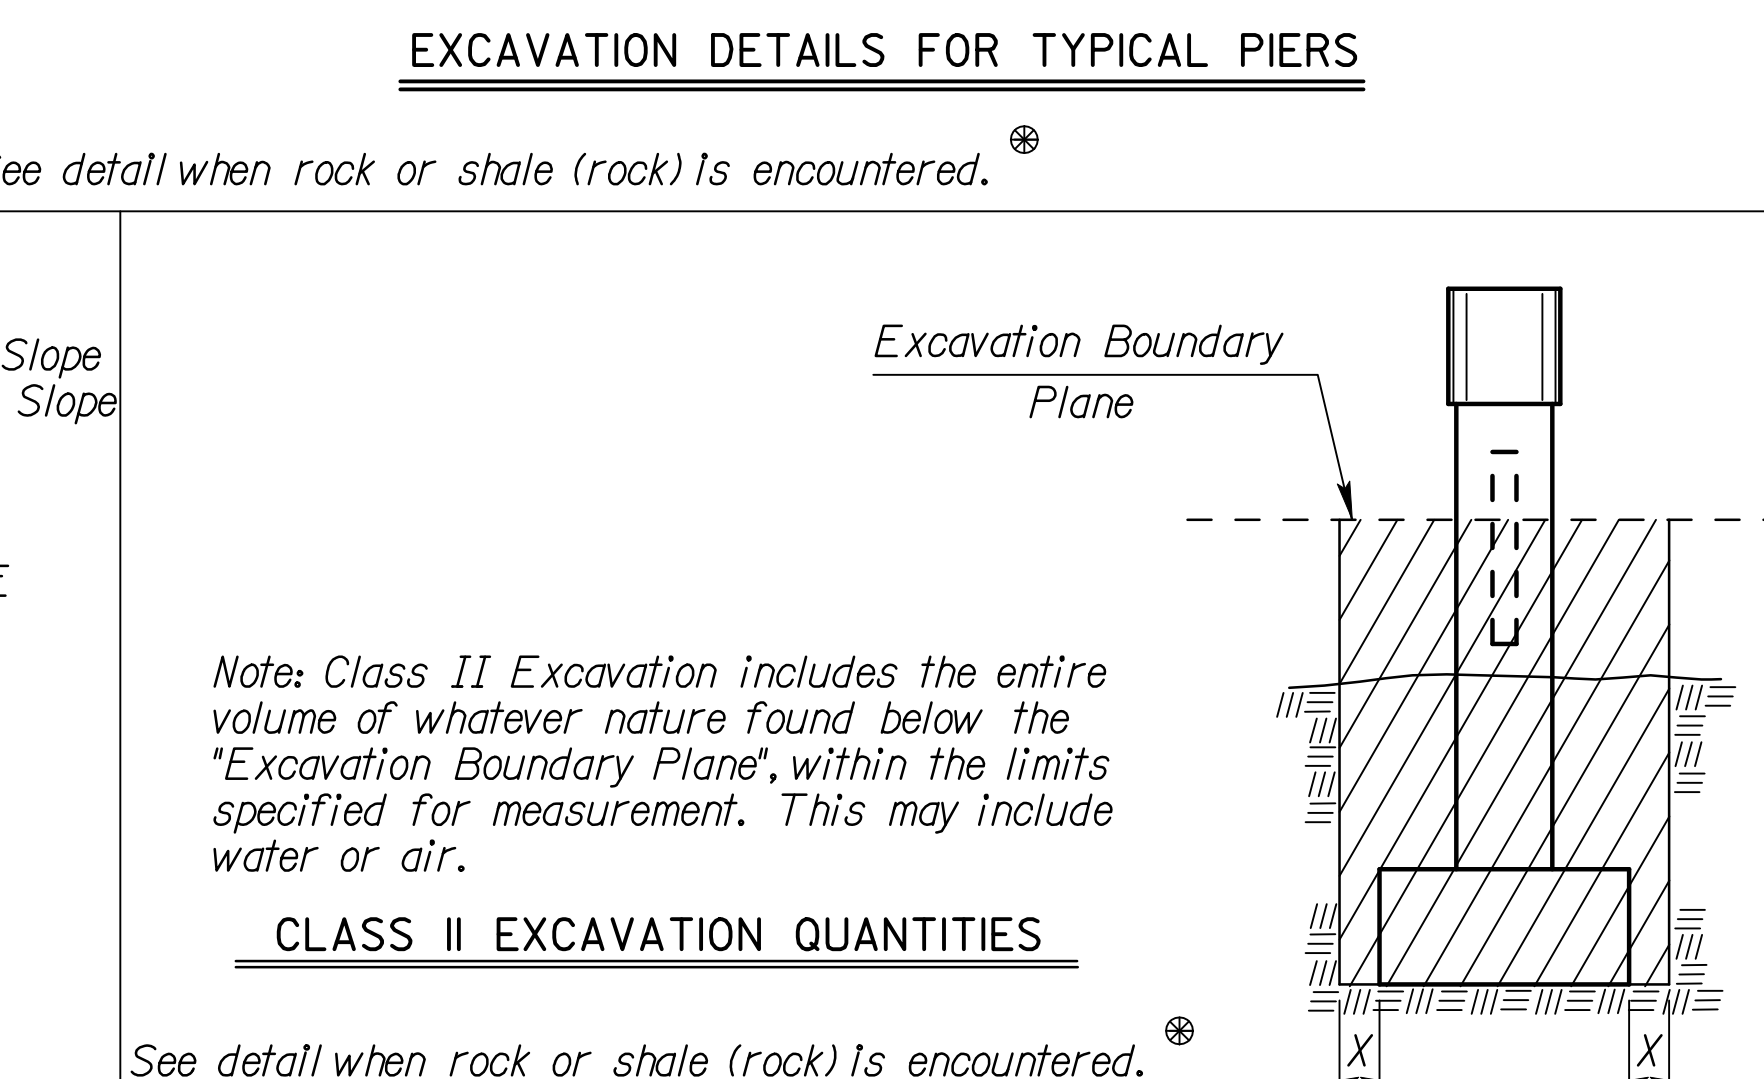
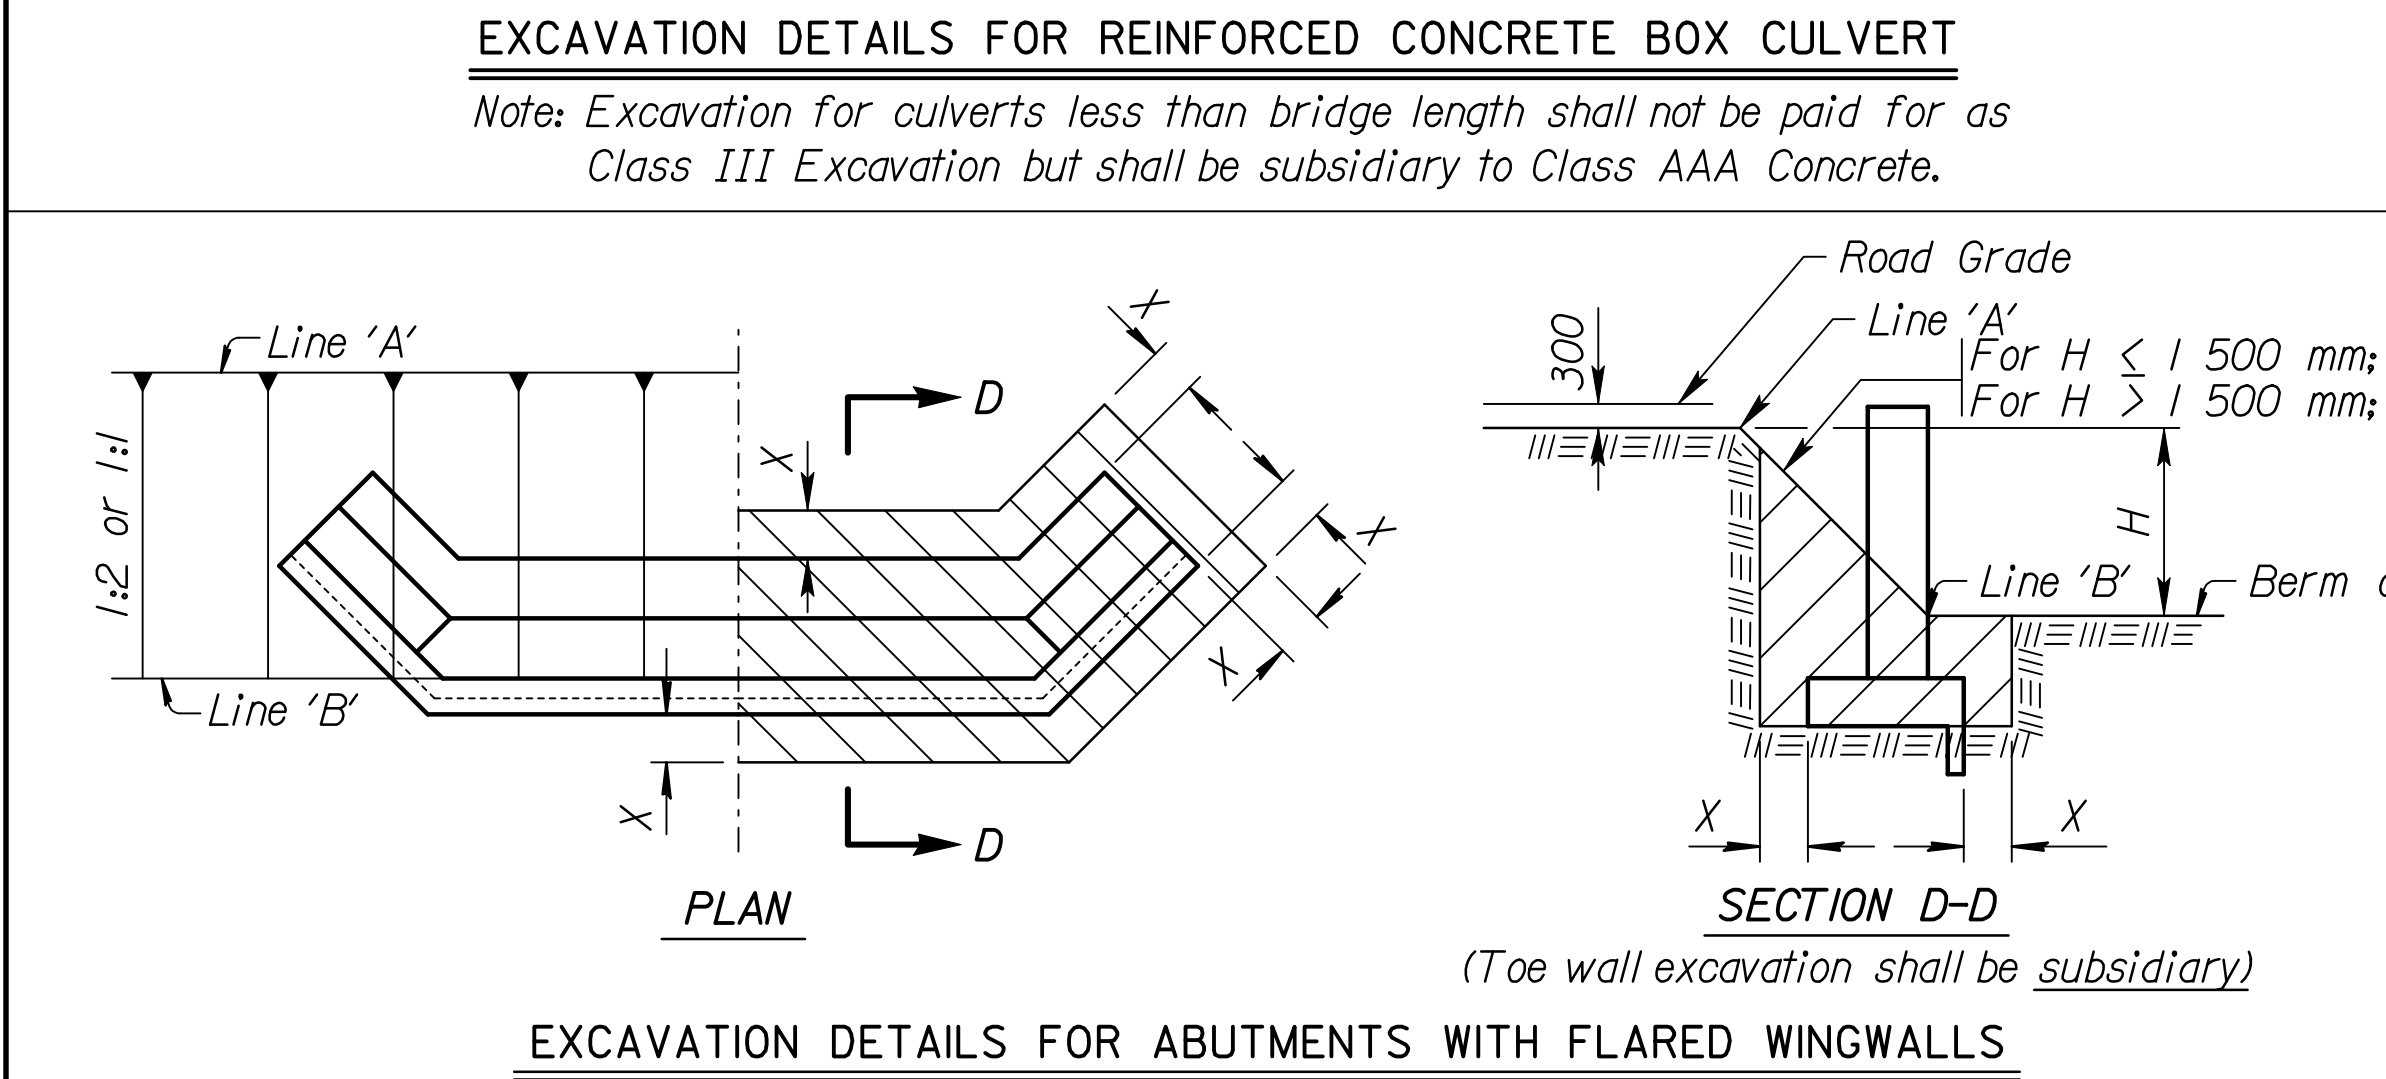
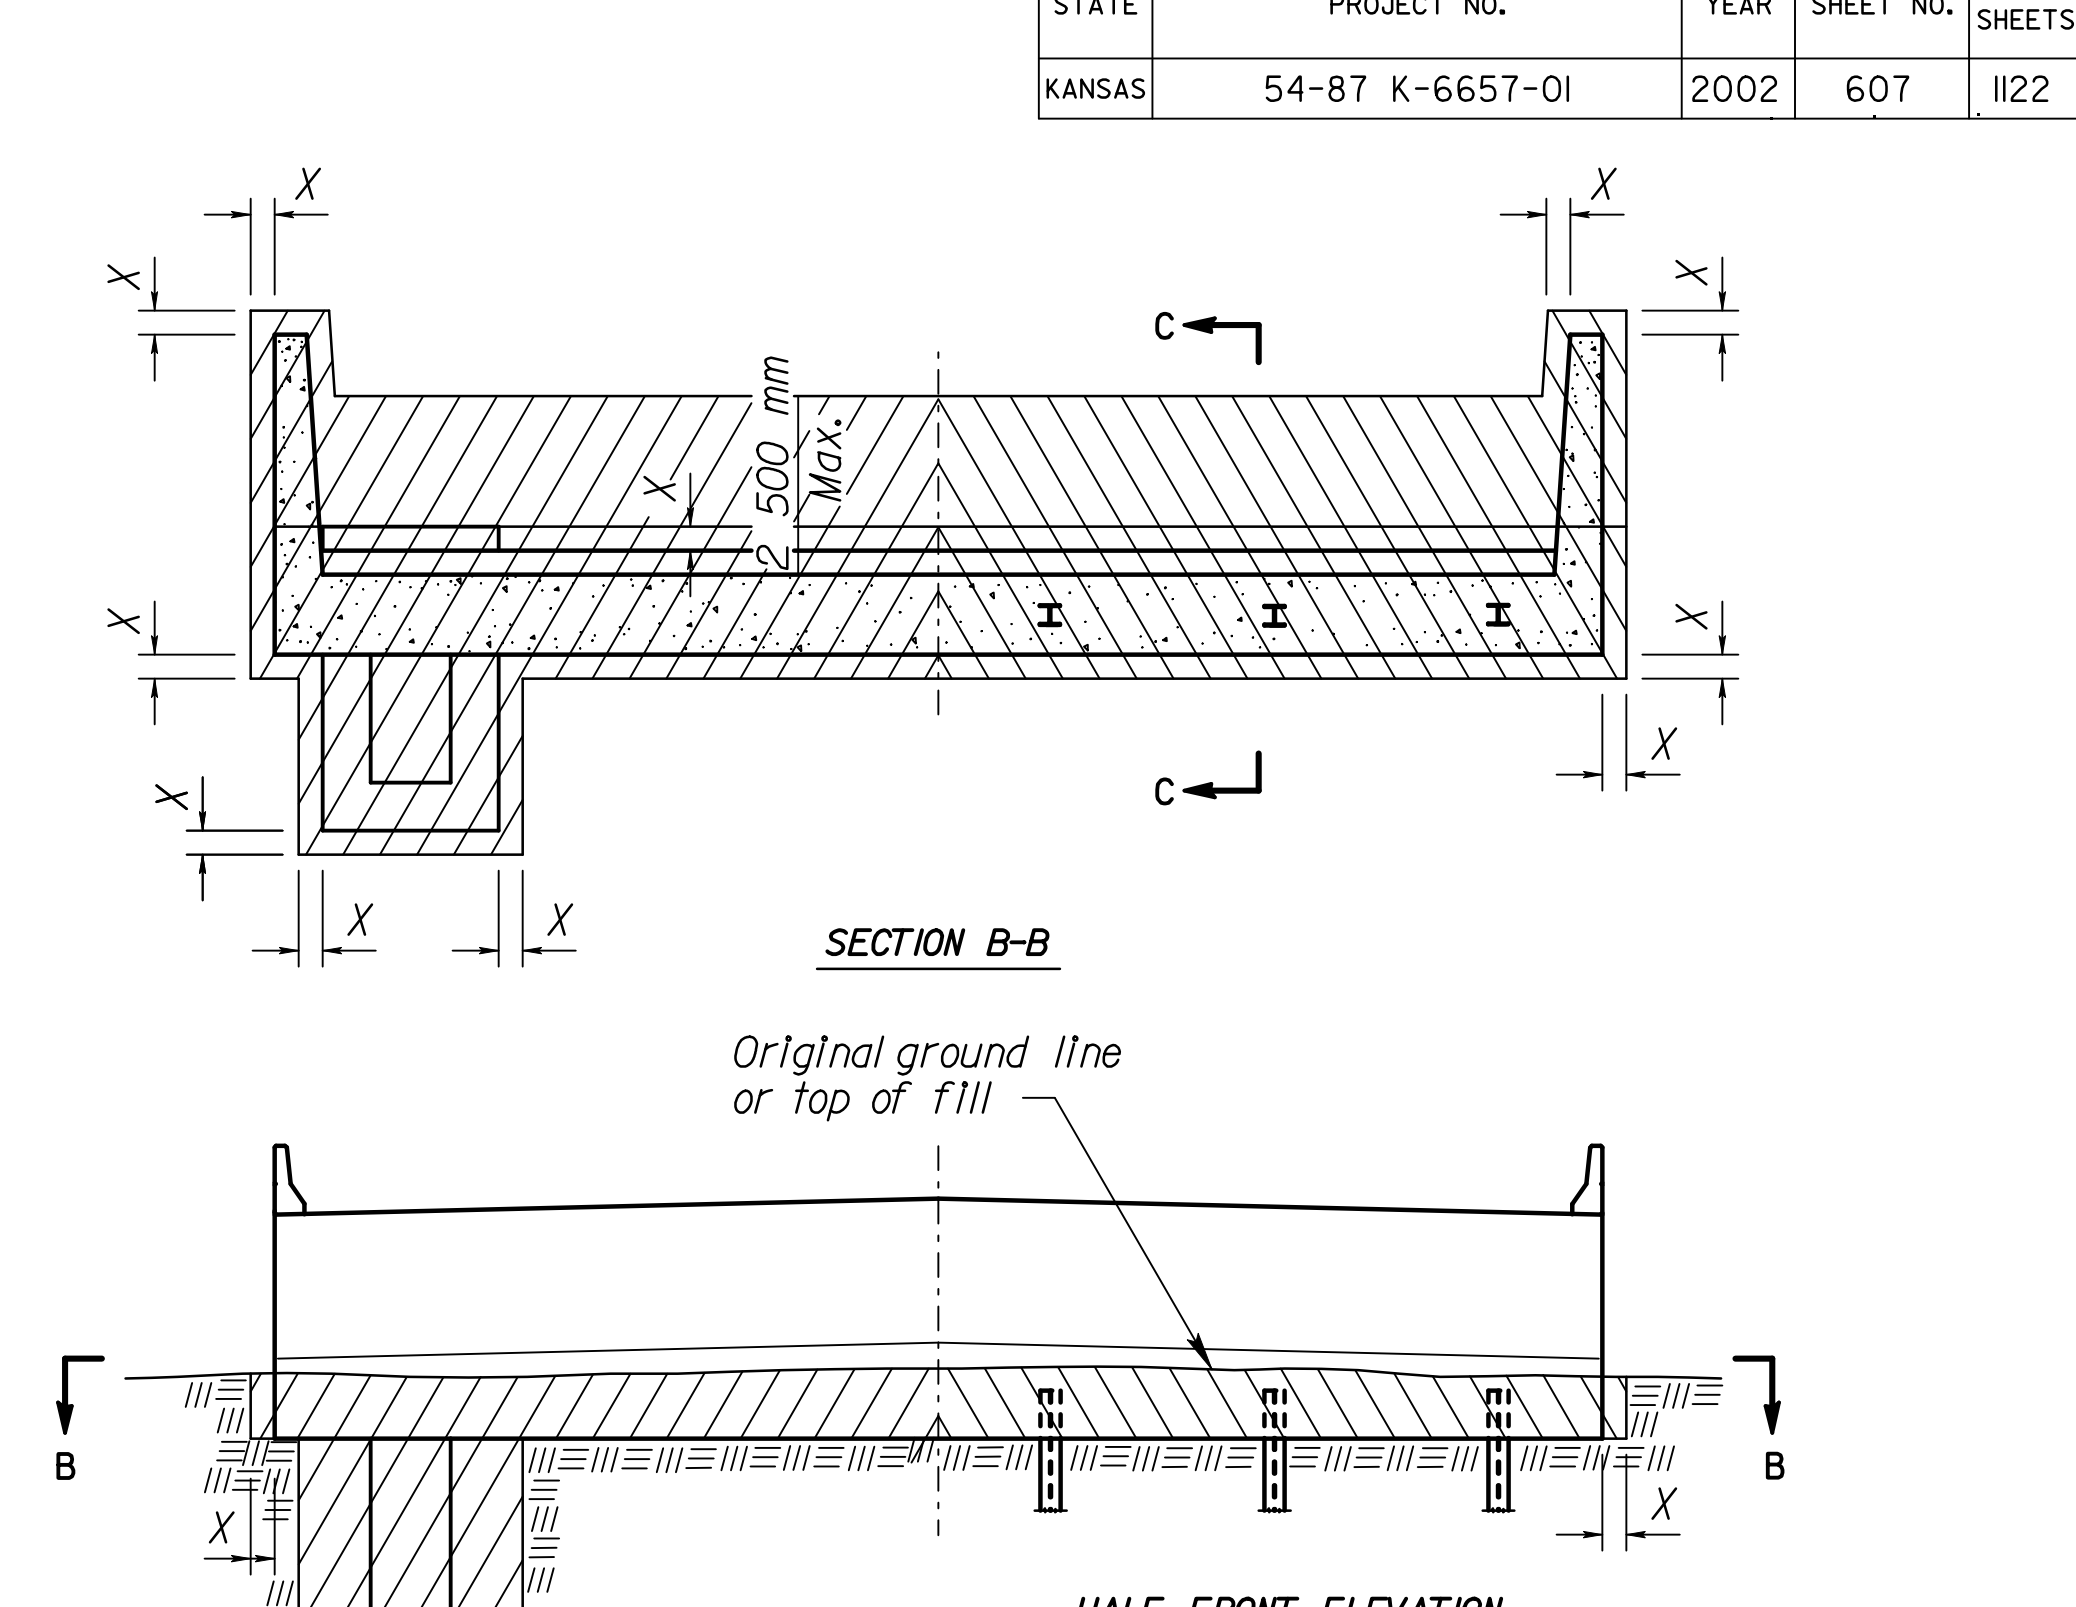
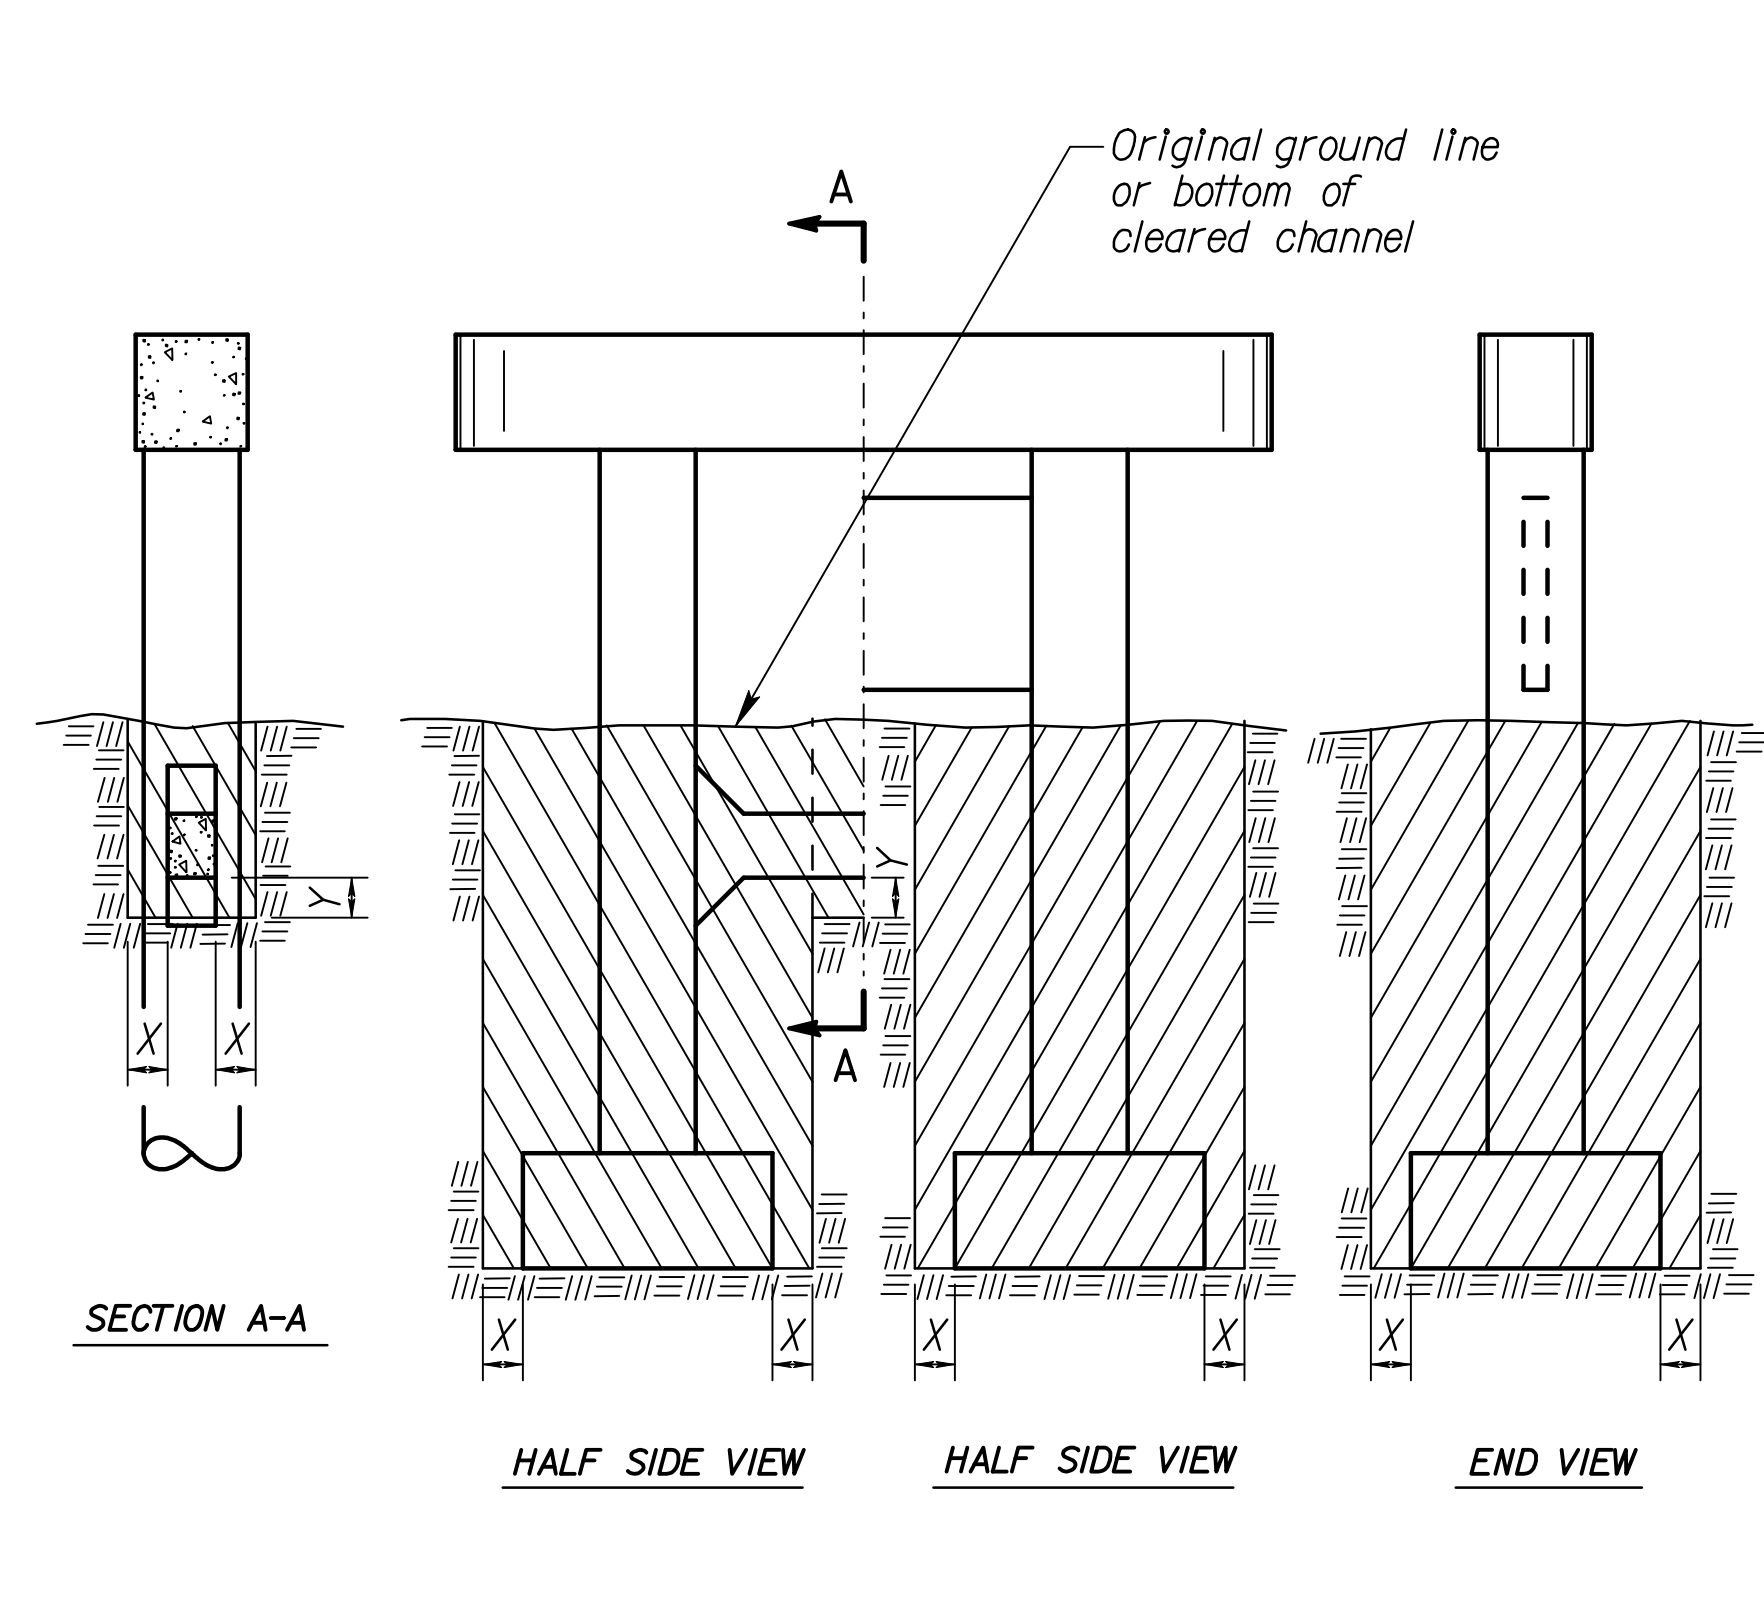


STATE	PROJECT NO.	YEAR	SHEET NO.	TOTAL SHEETS
KANSAS	54-87 K-6657-01	2002	607	1122

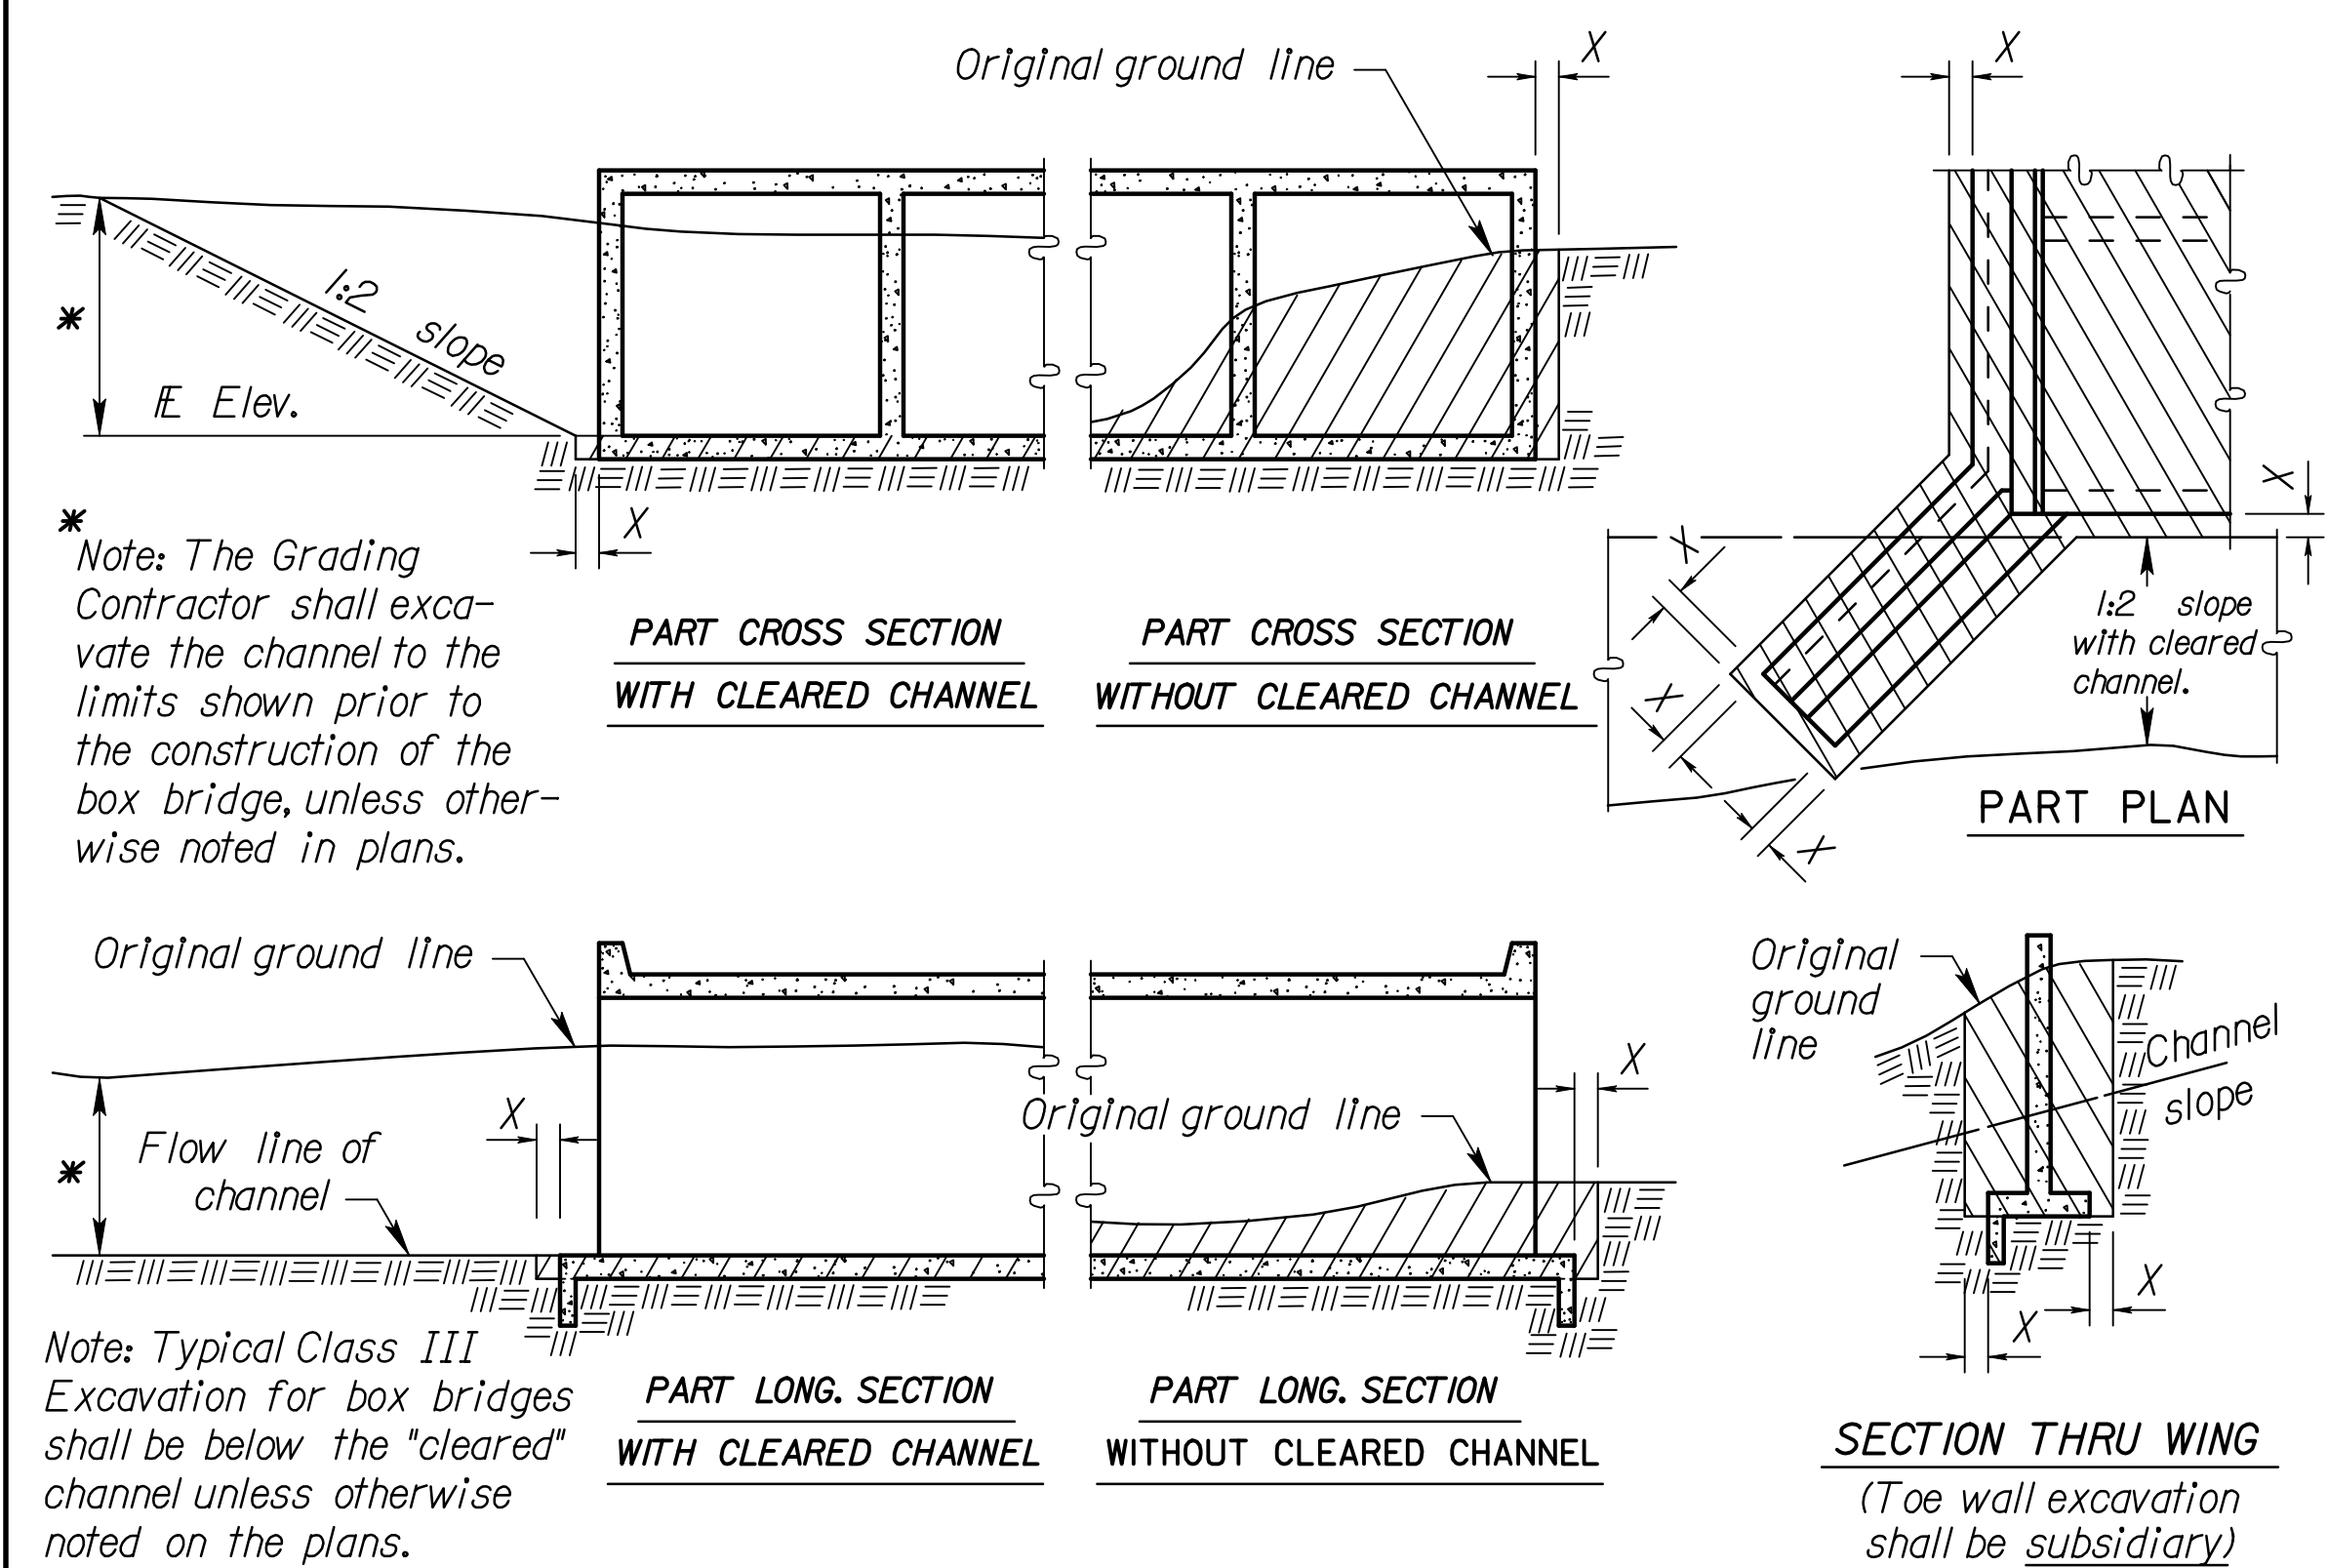

**RECORD DRAWING**

NO.	DATE	REVISIONS	BY	APP'D
3				
2	8-12-95	Correct Section BB at abutment	LRR	KFH
1	1-30-95	Drilled Shaft Excavation	LRR	KFH

**KANSAS DEPARTMENT OF TRANSPORTATION**

**BRIDGE EXCAVATION**

FHWA APPROVAL	9-8-95	APP'D	KENNETH F. HURST
DESIGNED	DETAILED	JKI QUANTITIES	CADD
DESIGN CK.	DETAIL CK.	LRR QUAN. CK.	CADD CK.

Plotted By : gdr  
 Plot File : I:\1997\97362\As-Builts\dgn\Vol\_3\Sh\_607-KDOT\_ST-D-BR100SI.dgn  
 Plot Date : Sept. 07  
 Last Rev: 9-7-07 By: gdr