


FHWA REGION NO.	STATE	PROJECT NO.	YEAR	SHEET NO.	TOTAL SHEETS
7	KANSAS	54-87 K-6657-01	2002	645g	1122


BRIDGE LIGHTING CONDUIT WB KELLOGG @ MAIZE ROAD (BR 489)

WEST KELLOGG FREEWAY - MAIZE AND TYLER ROAD INTERCHANGES
 CITY OF WICHITA PROJECT NO.: 472 - 83533
 KDOT PROJECT NO.: 54 - 87K 6657 - 01

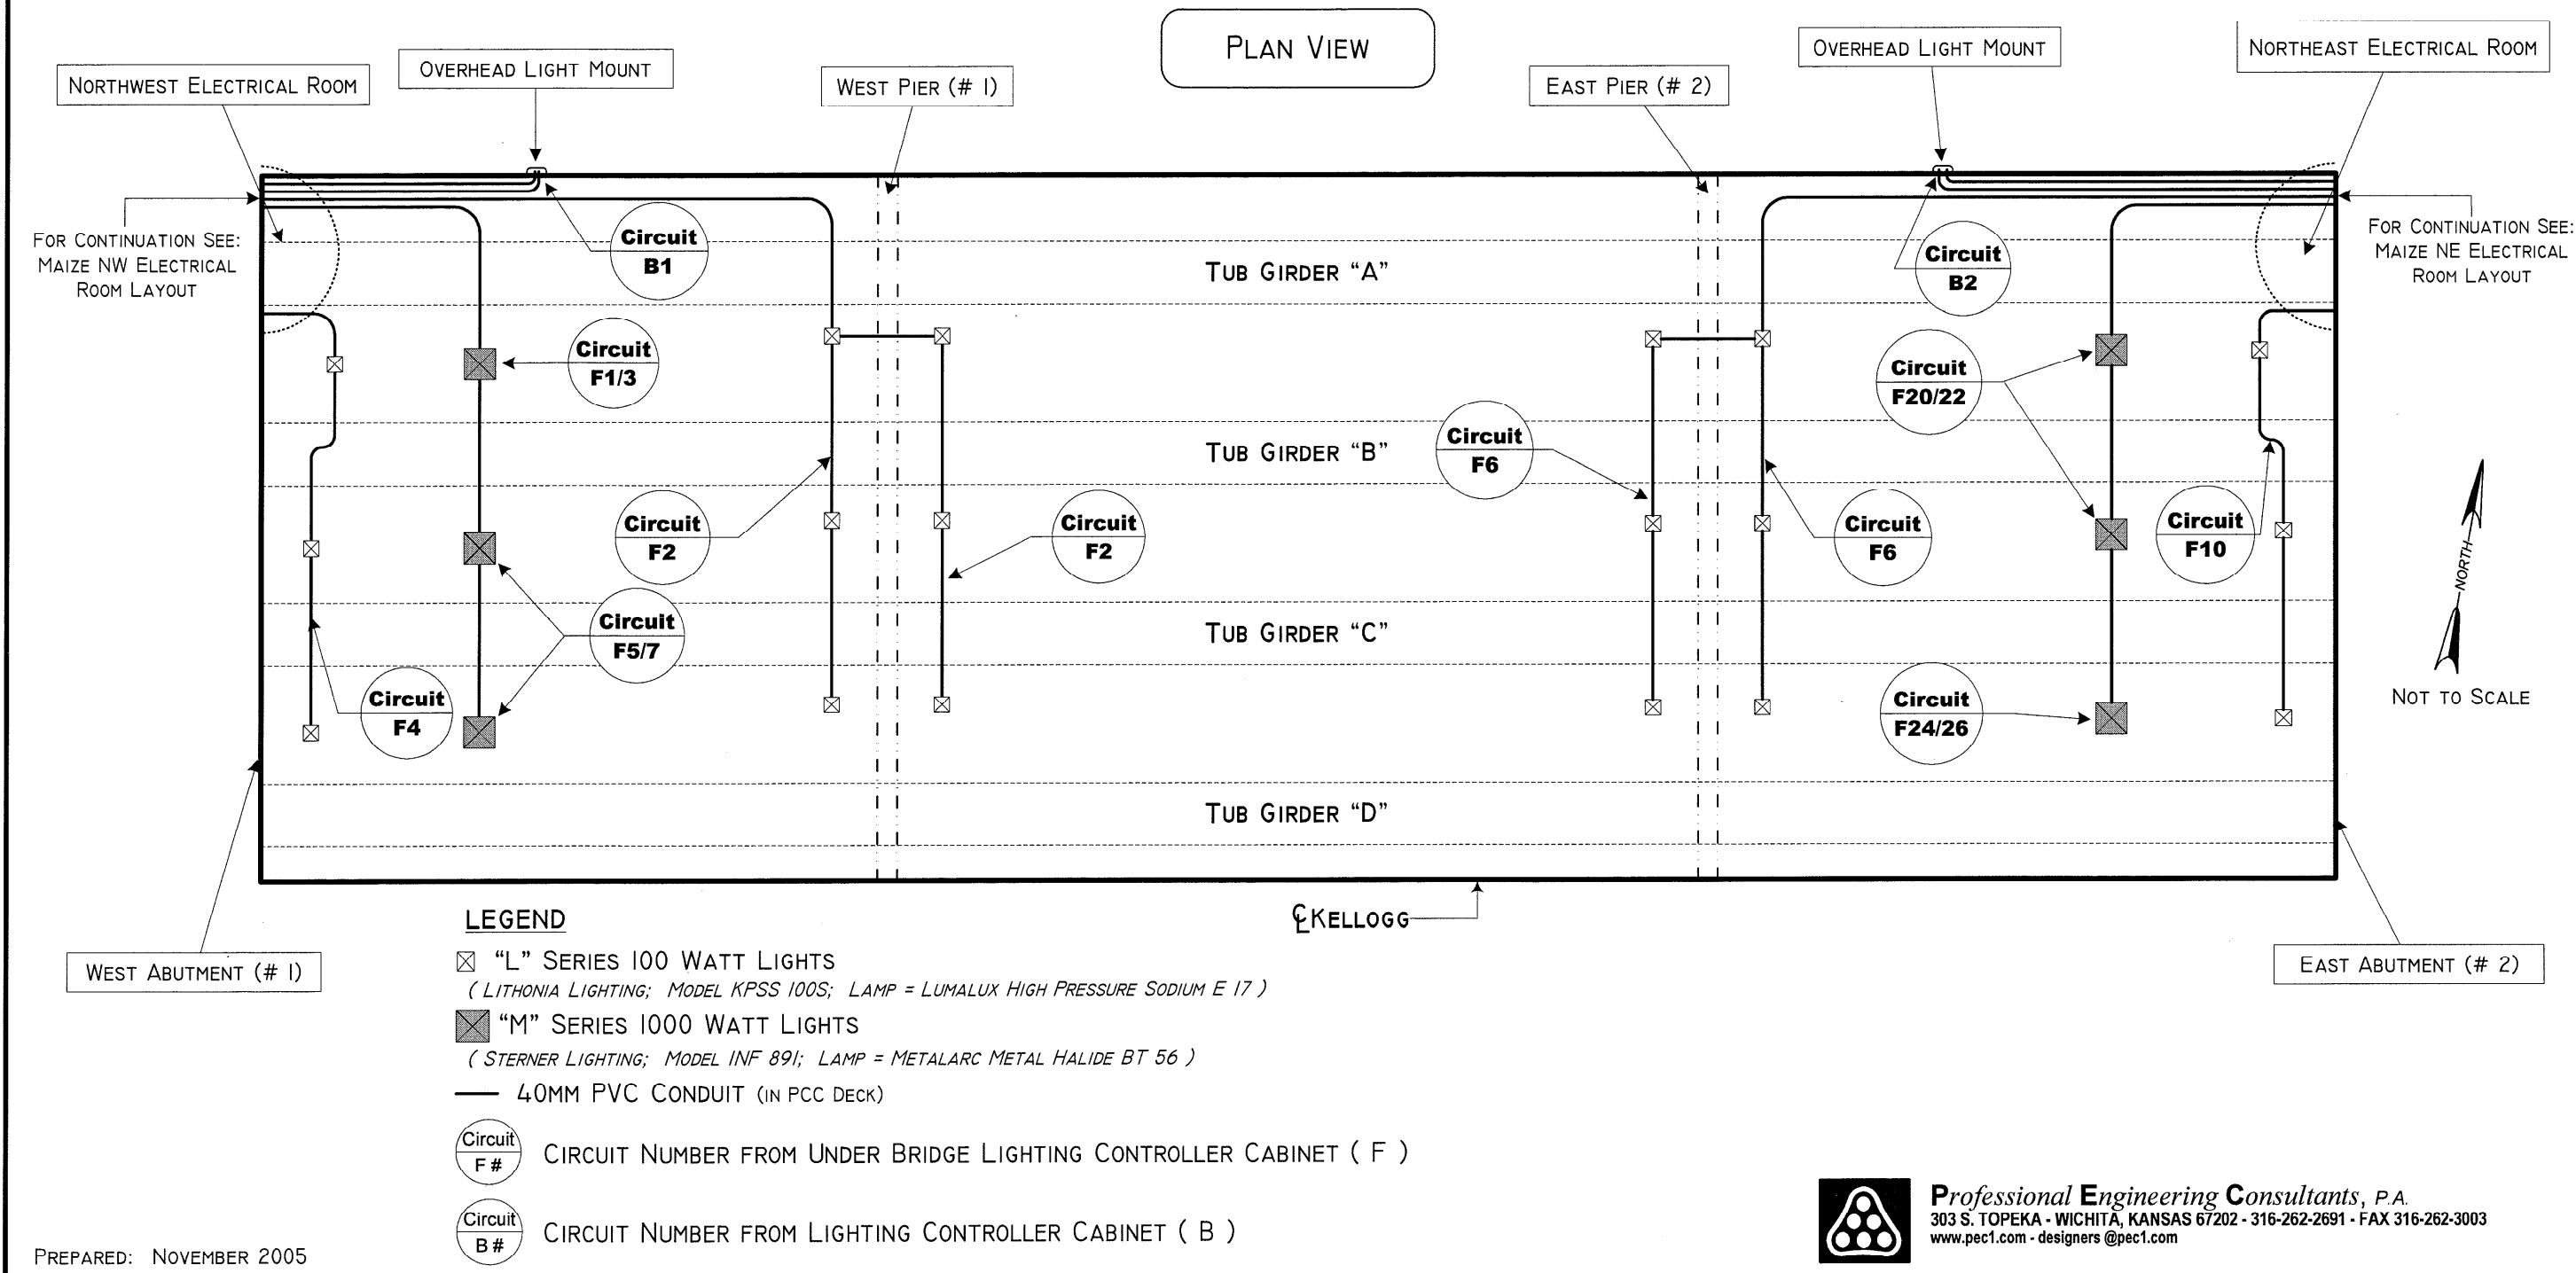


UNDER BRIDGE LIGHTING @ MAIZE ROAD

WEST KELLOGG FREEWAY - MAIZE AND TYLER ROAD INTERCHANGES
 CITY OF WICHITA PROJECT NO.: 472 - 83533
 KDOT PROJECT NO.: 54 - 87K 6657 - 01

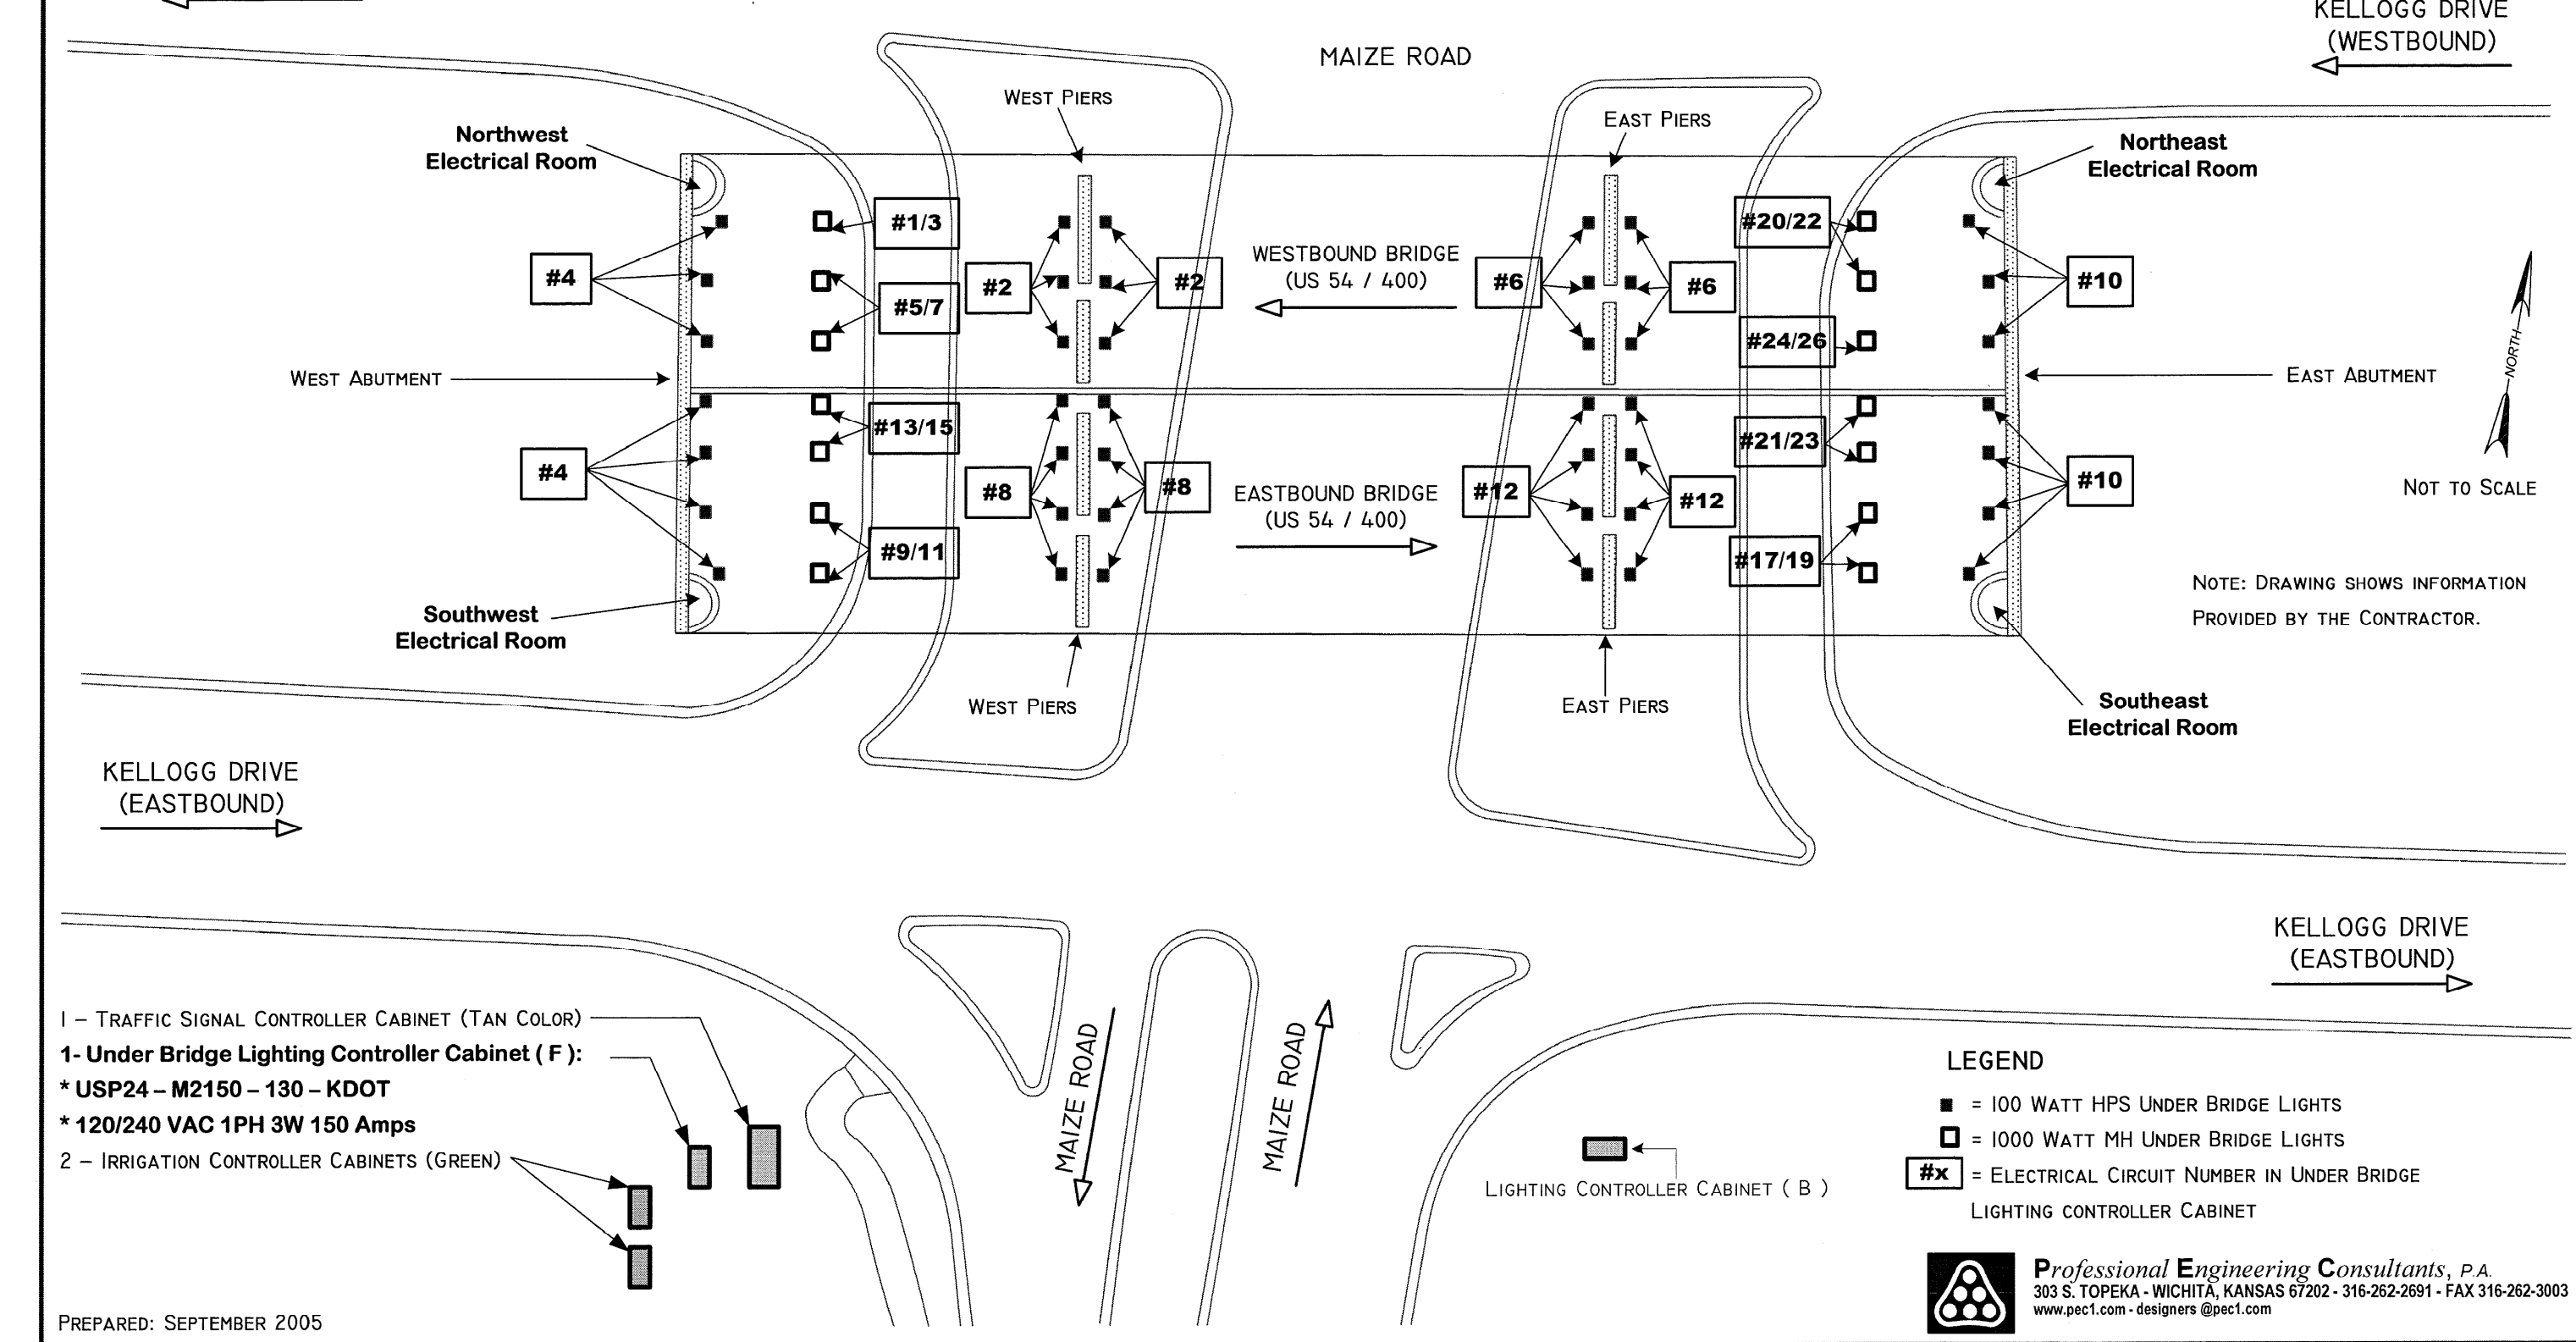

BRIDGE LIGHTING CONDUIT EB KELLOGG @ MAIZE ROAD (BR 491)

WEST KELLOGG FREEWAY - MAIZE AND TYLER ROAD INTERCHANGES
 CITY OF WICHITA PROJECT NO.: 472 - 83533
 KDOT PROJECT NO.: 54 - 87K 6657 - 01

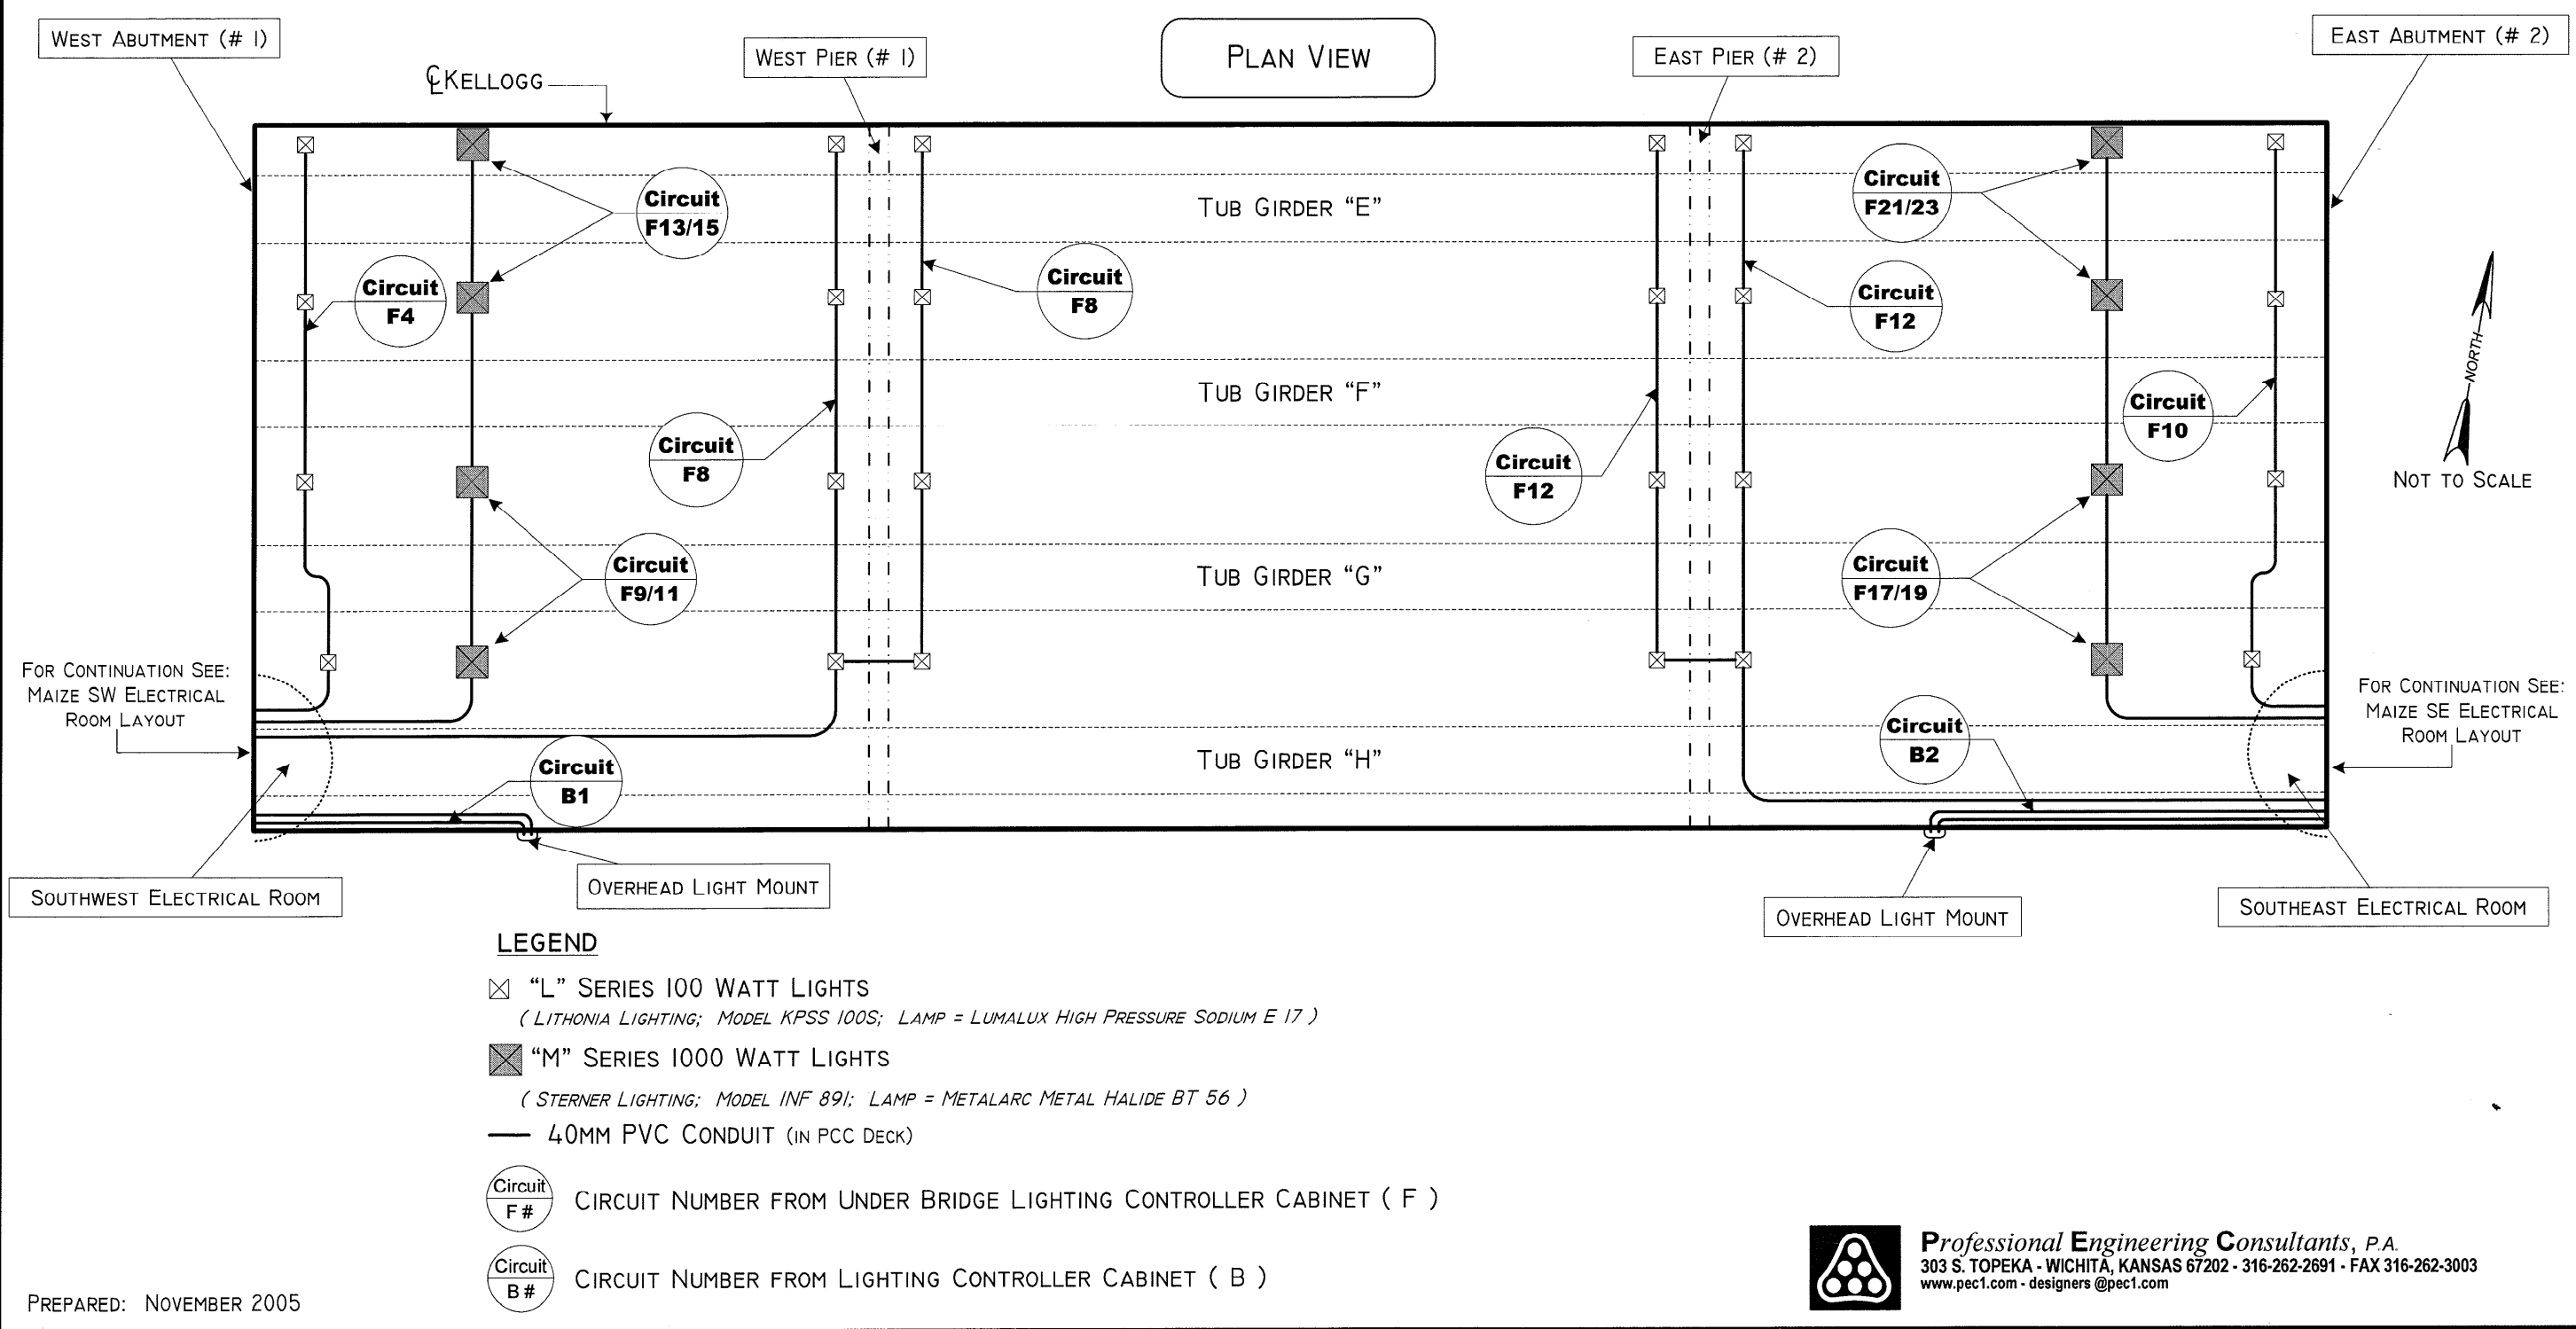

DSNP: WDH OPER: JGP SCALE: i:/1997/97362/As-Builts/dgn/s/108_3/V8_Files_With_Rasters/Sh 645a-Maize-br-Lighting.dgn Last Rev: 9-18-07 By: gdr

RECORD DRAWING

1			
No.	Revisions	By	Date
CITY OF WICHITA			
BRIDGE LIGHTING MAIZE ROAD			
SEDGWICK COUNTY			
Professional Engineering Consultants, P.A. 303 S. TOPEKA • WICHITA, KANSAS 67202 316-262-2691 • FAX 316-262-3003			
Designed by		Checked by	
Drawn by		Date	Job No. 97362