


FHWA REGION NO.	STATE	PROJECT NO.	YEAR	SHEET NO.	TOTAL SHEETS
7	KANSAS	54-87 K-6657-01	2002	645b	1122

# BRIDGE ELECTRICAL ROOM LAYOUT @ MAIZE ROAD

WEST KELLOGG FREEWAY – MAIZE AND TYLER ROAD INTERCHANGES  
 CITY OF WICHITA PROJECT NO: 472 – 83533  
 K.D.O.T. PROJECT NO: 54 – 87 K 6657 – 01

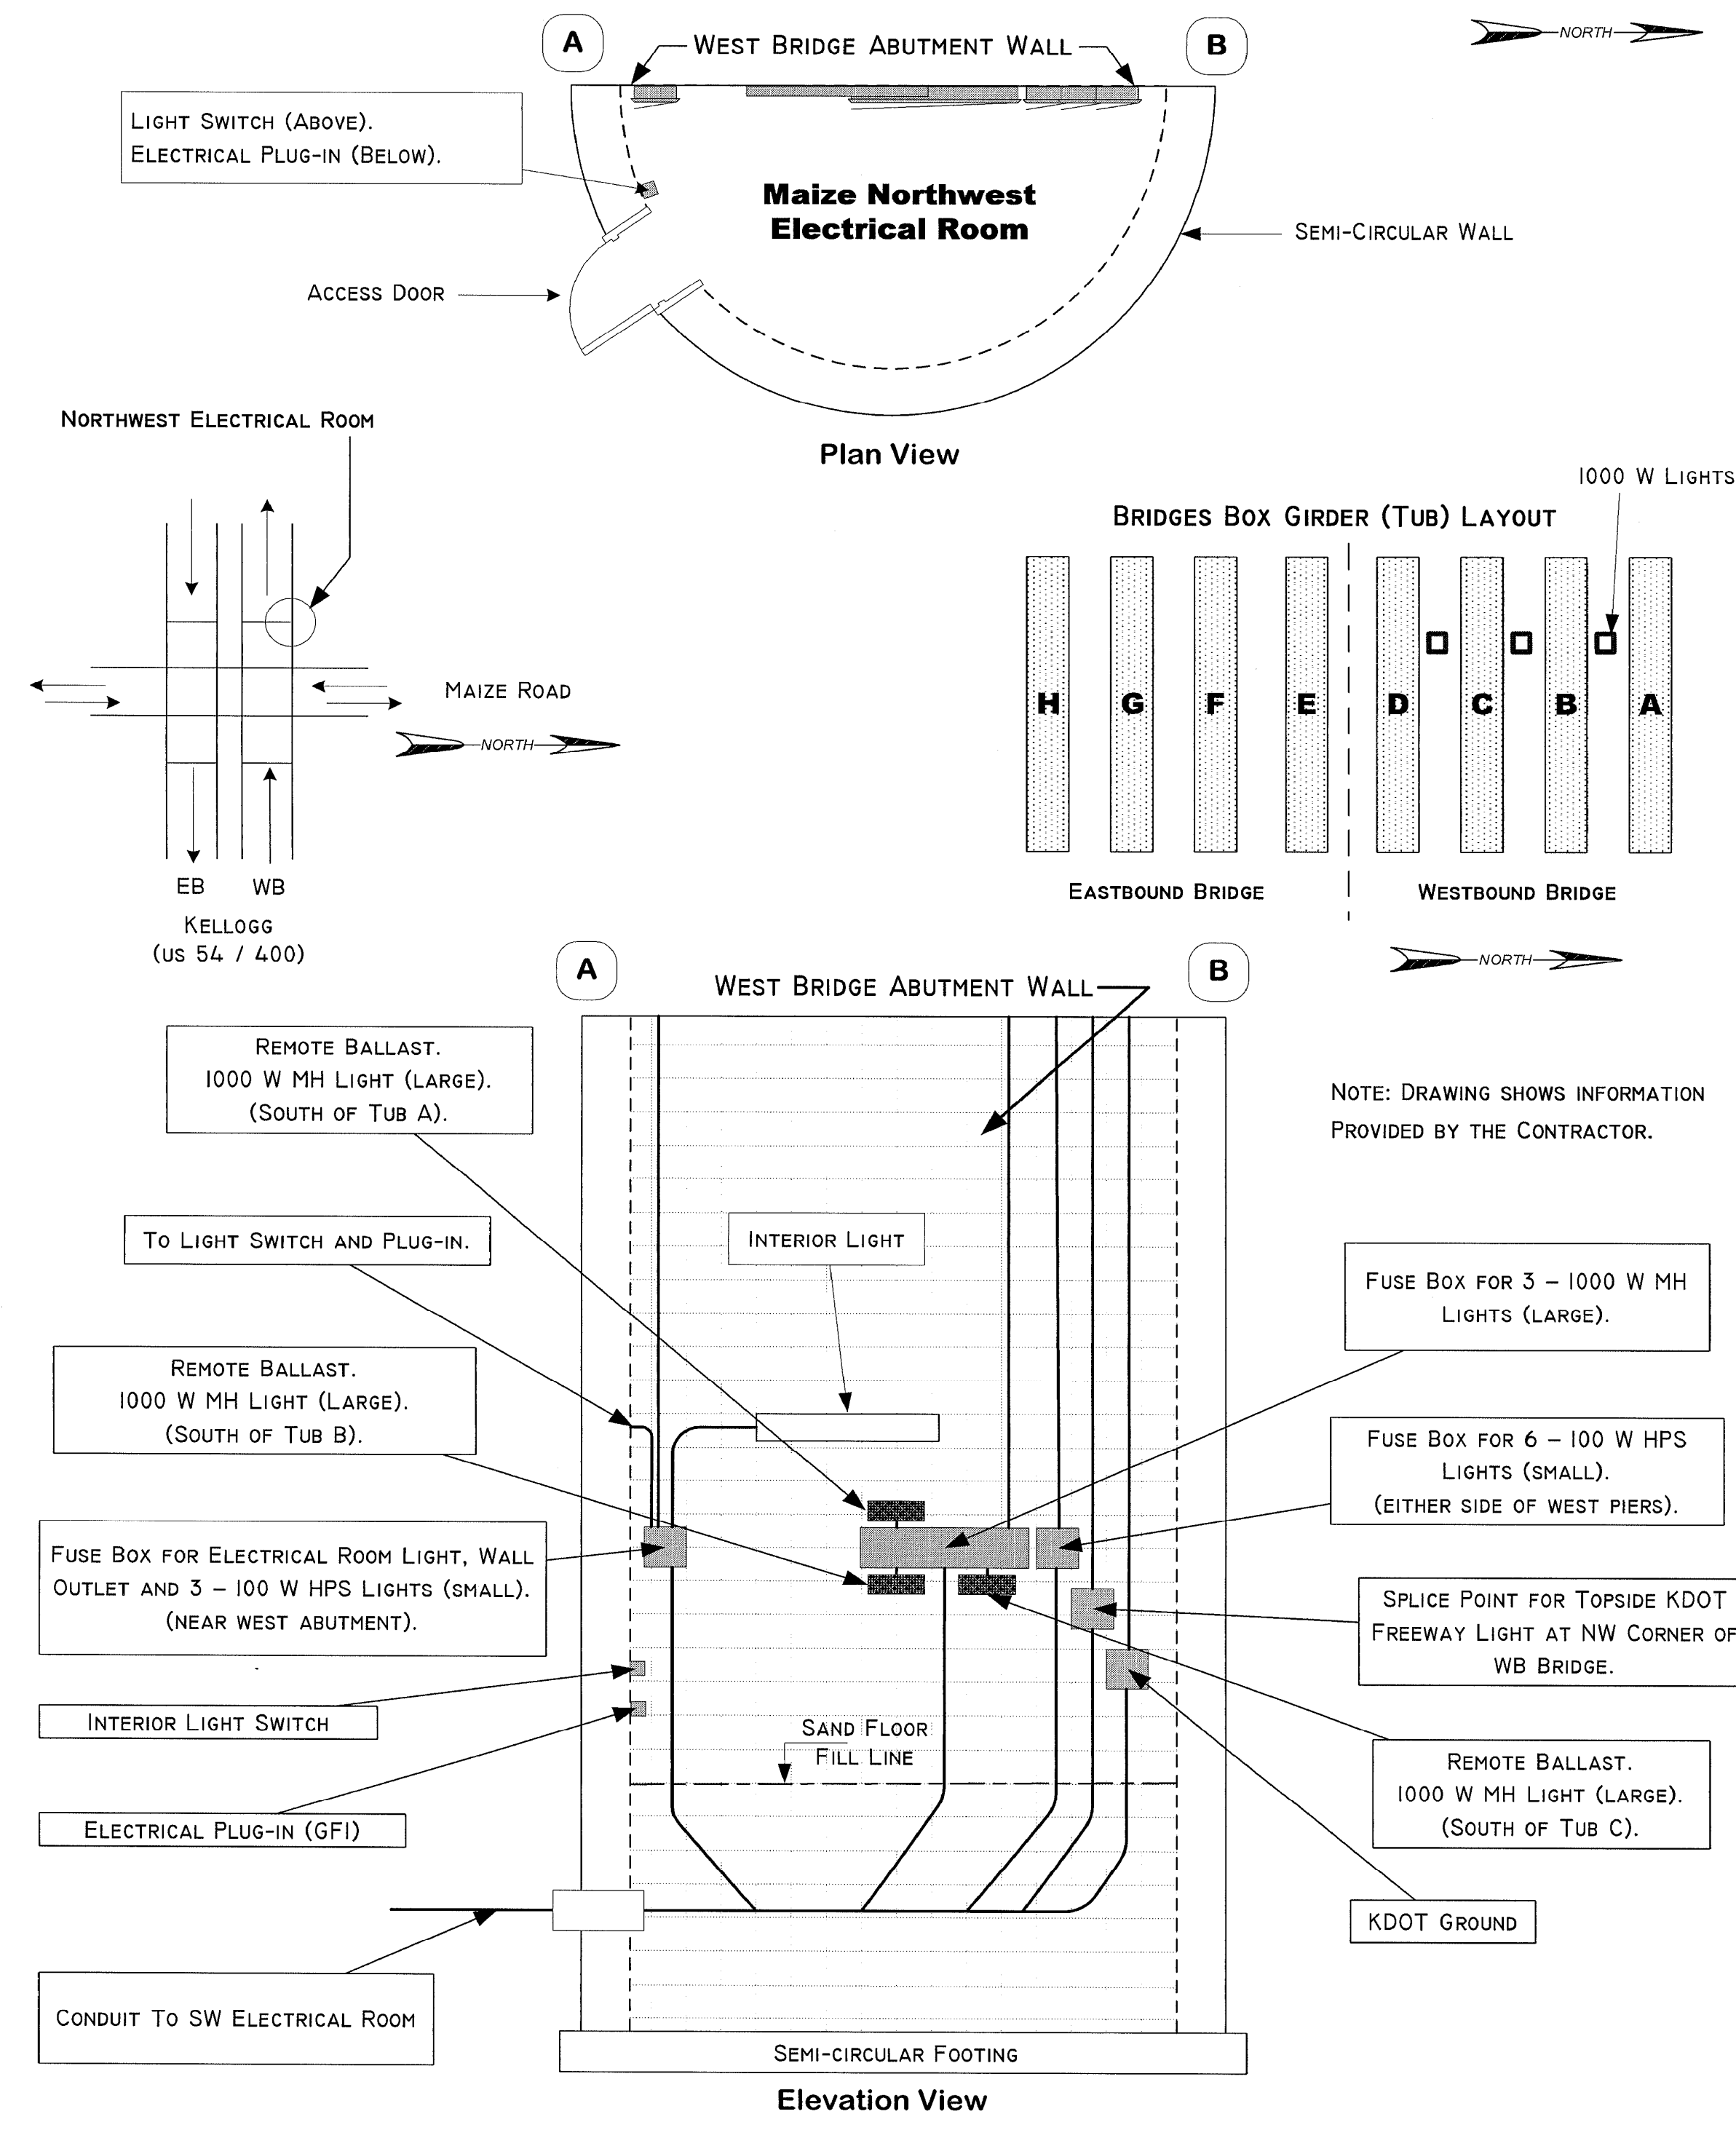


NOTE: 1000 W MH AND 100 W HPS LIGHTS ARE "UNDER BRIDGE LIGHTS" BELOW WEST HALF OF BRIDGE No. 54 – 87 – 19.05 (489) WB KELLOGG.

Professional Engineering Consultants, P.A.  
 303 S. TOPEKA - WICHITA, KANSAS 67202 - 316-262-2691 - FAX 316-262-3003  
 www.pec1.com - designers@pec1.com

# BRIDGE ELECTRICAL ROOM LAYOUT @ MAIZE ROAD

WEST KELLOGG FREEWAY – MAIZE AND TYLER ROAD INTERCHANGES  
 CITY OF WICHITA PROJECT NO: 472 – 83533  
 K.D.O.T. PROJECT NO: 54 – 87 K 6657 – 01

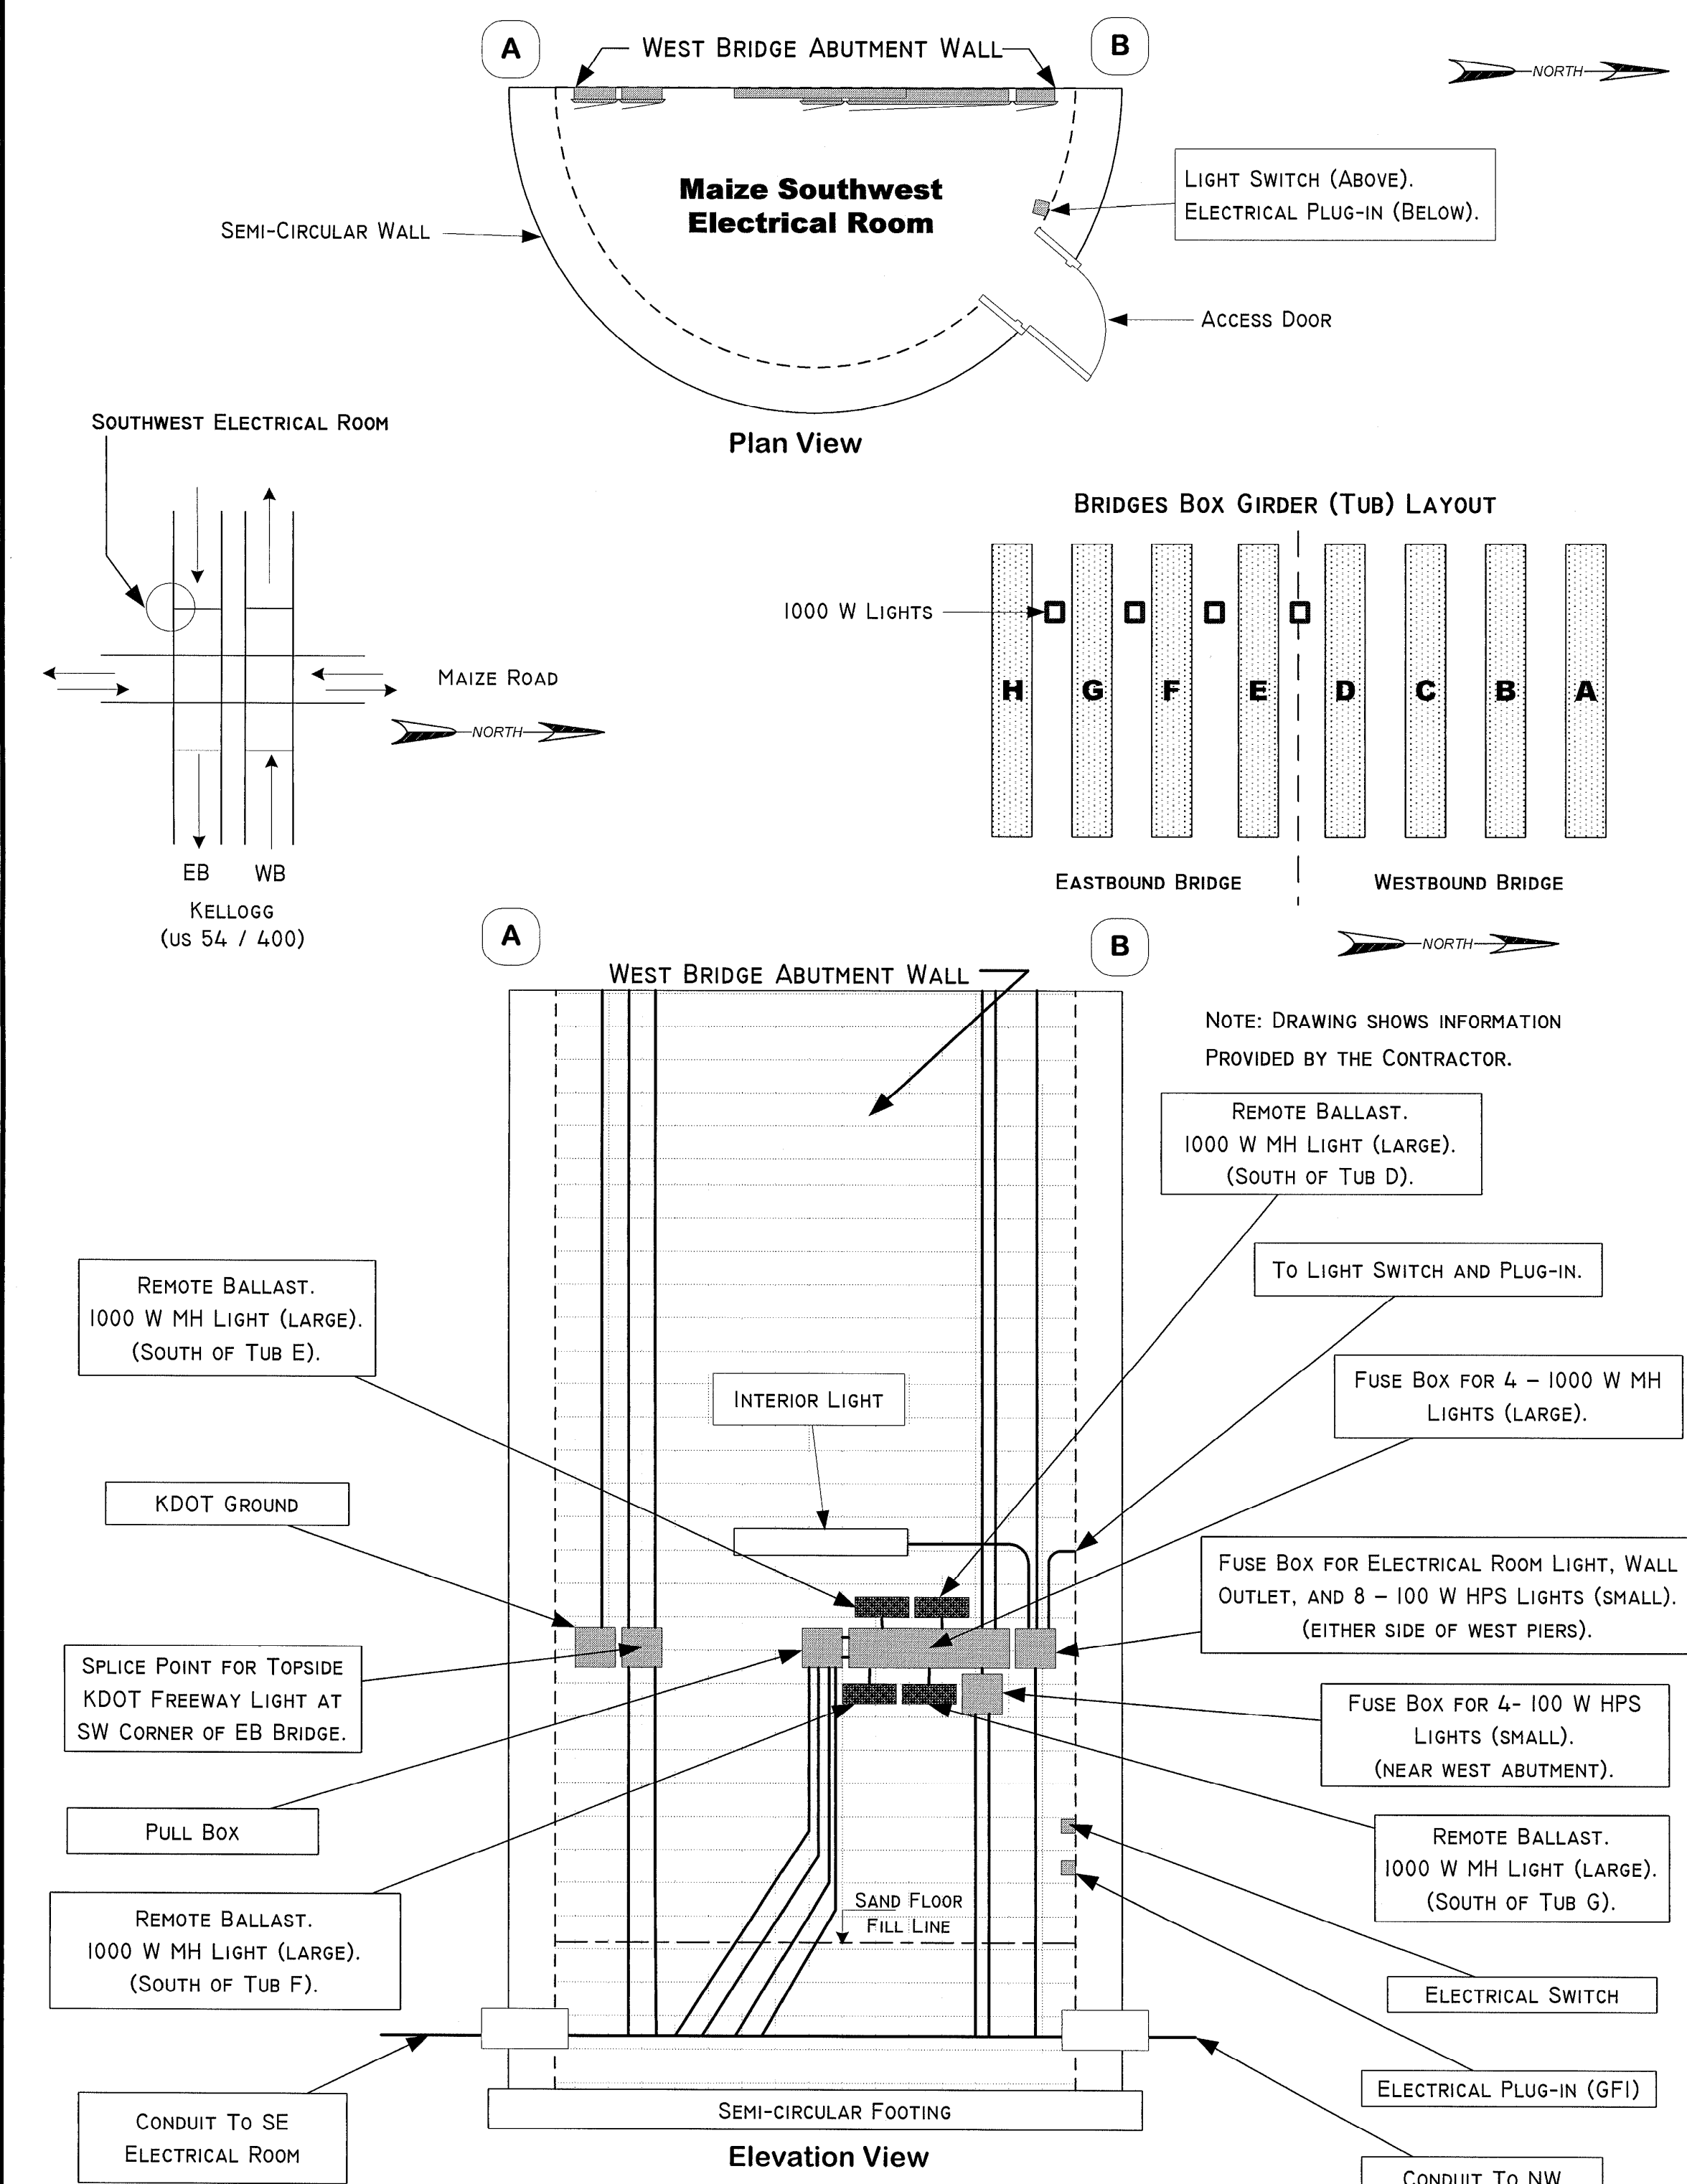

NOTE: 1000 W MH AND 100 W HPS LIGHTS ARE "UNDER BRIDGE LIGHTS" BELOW WEST HALF OF BRIDGE No. 54 – 87 – 19.06 (491) EB KELLOGG.

Professional Engineering Consultants, P.A.  
 303 S. TOPEKA - WICHITA, KANSAS 67202 - 316-262-2691 - FAX 316-262-3003  
 www.pec1.com - designers@pec1.com

## RECORD DRAWING

CITY OF WICHITA			
BRIDGE ELECTRICAL ROOM LAYOUT MAIZE ROAD			
SEDGWICK COUNTY			
Professional Engineering Consultants, P.A. 303 S. TOPEKA • WICHITA, KANSAS 67202 316-262-2691 • FAX 316-262-3003			
Designed by	Checked by	Date	
Drawn by	Date	Job No.	97362

DSNR: WDH OPER: JGP SCALE: i:/1997/97362/As-Builts/dgn/s/108\_Files\_With\_Rasters/Sh 645b-Maize\_Elec\_Room.dgn Last Rev: 9-18-07 By: gdr