


FHWA REGION NO.	STATE	PROJECT NO.	YEAR	SHEET NO.	TOTAL SHEETS
7	KANSAS	54-87 K-6657-01	2002	6460	1122


### BRIDGE LIGHTING CONDUIT WB KELLOGG @ TYLER ROAD (BR 496)

WEST KELLOGG FREEWAY - MAIZE AND TYLER ROAD INTERCHANGES  
 CITY OF WICHITA PROJECT NO.: 472 - 83533  
 KDOT PROJECT NO.: 54 - 87K 6657 - 01

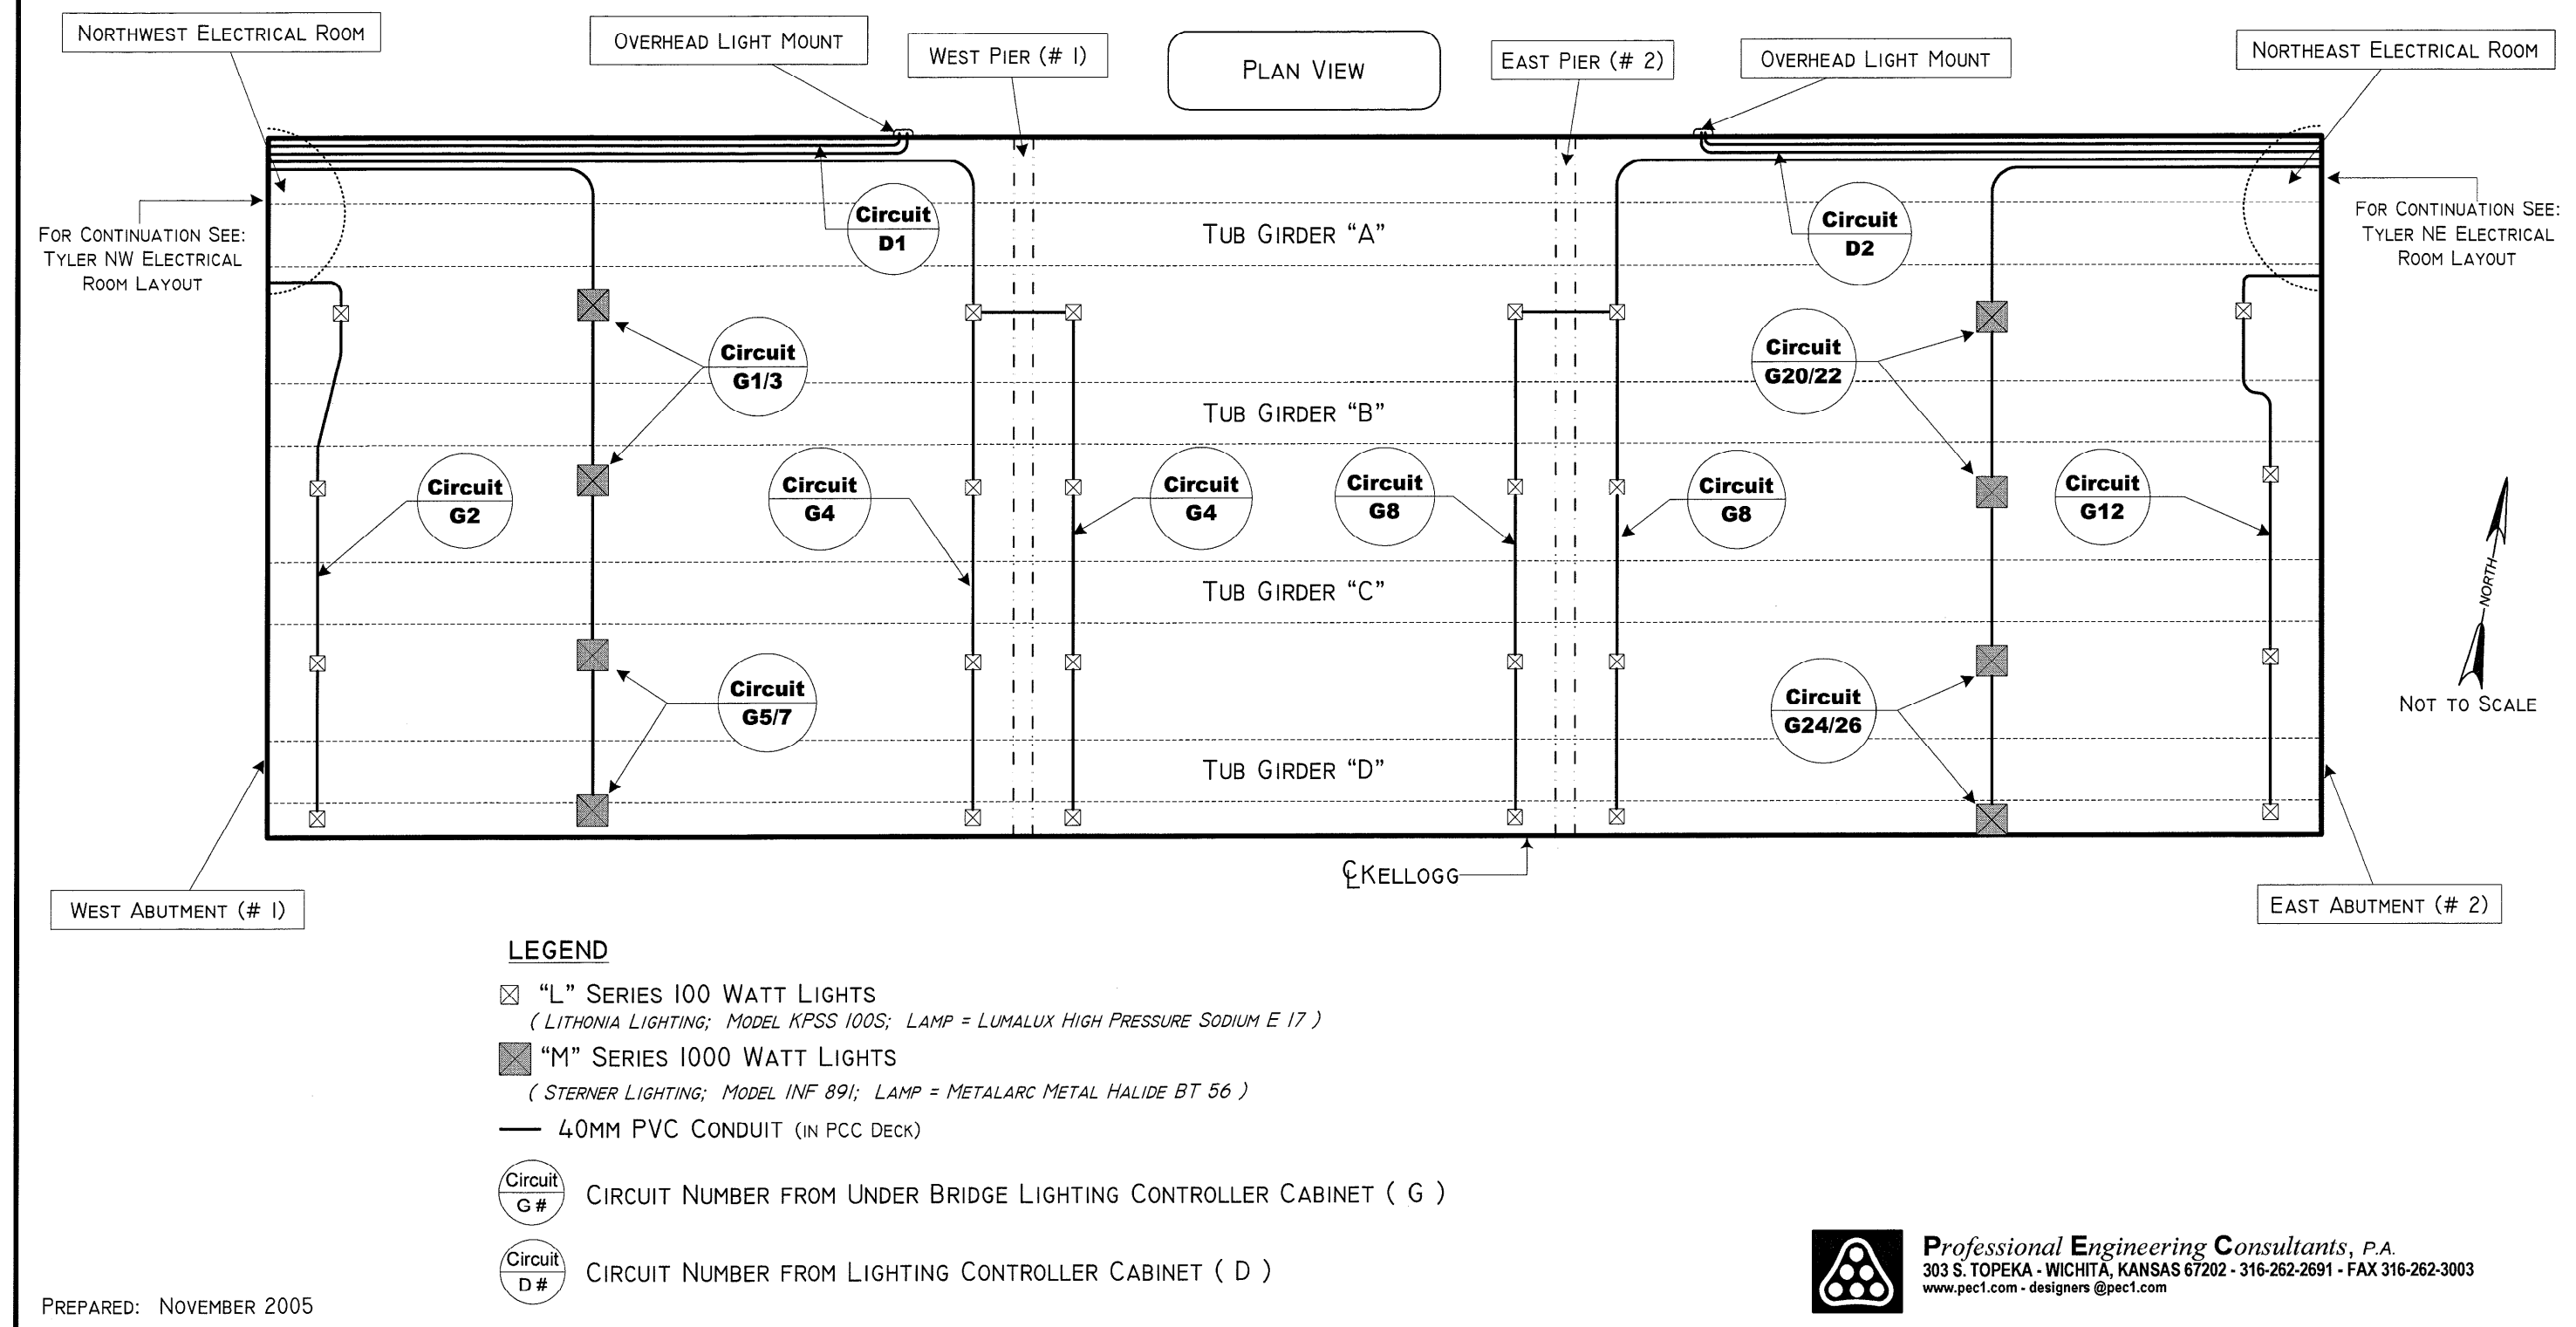


### UNDER BRIDGE LIGHTING @ TYLER ROAD

WEST KELLOGG FREEWAY - MAIZE AND TYLER ROAD INTERCHANGES  
 CITY OF WICHITA PROJECT NO.: 472 - 83533  
 KDOT PROJECT NO.: 54 - 87K 6657 - 01

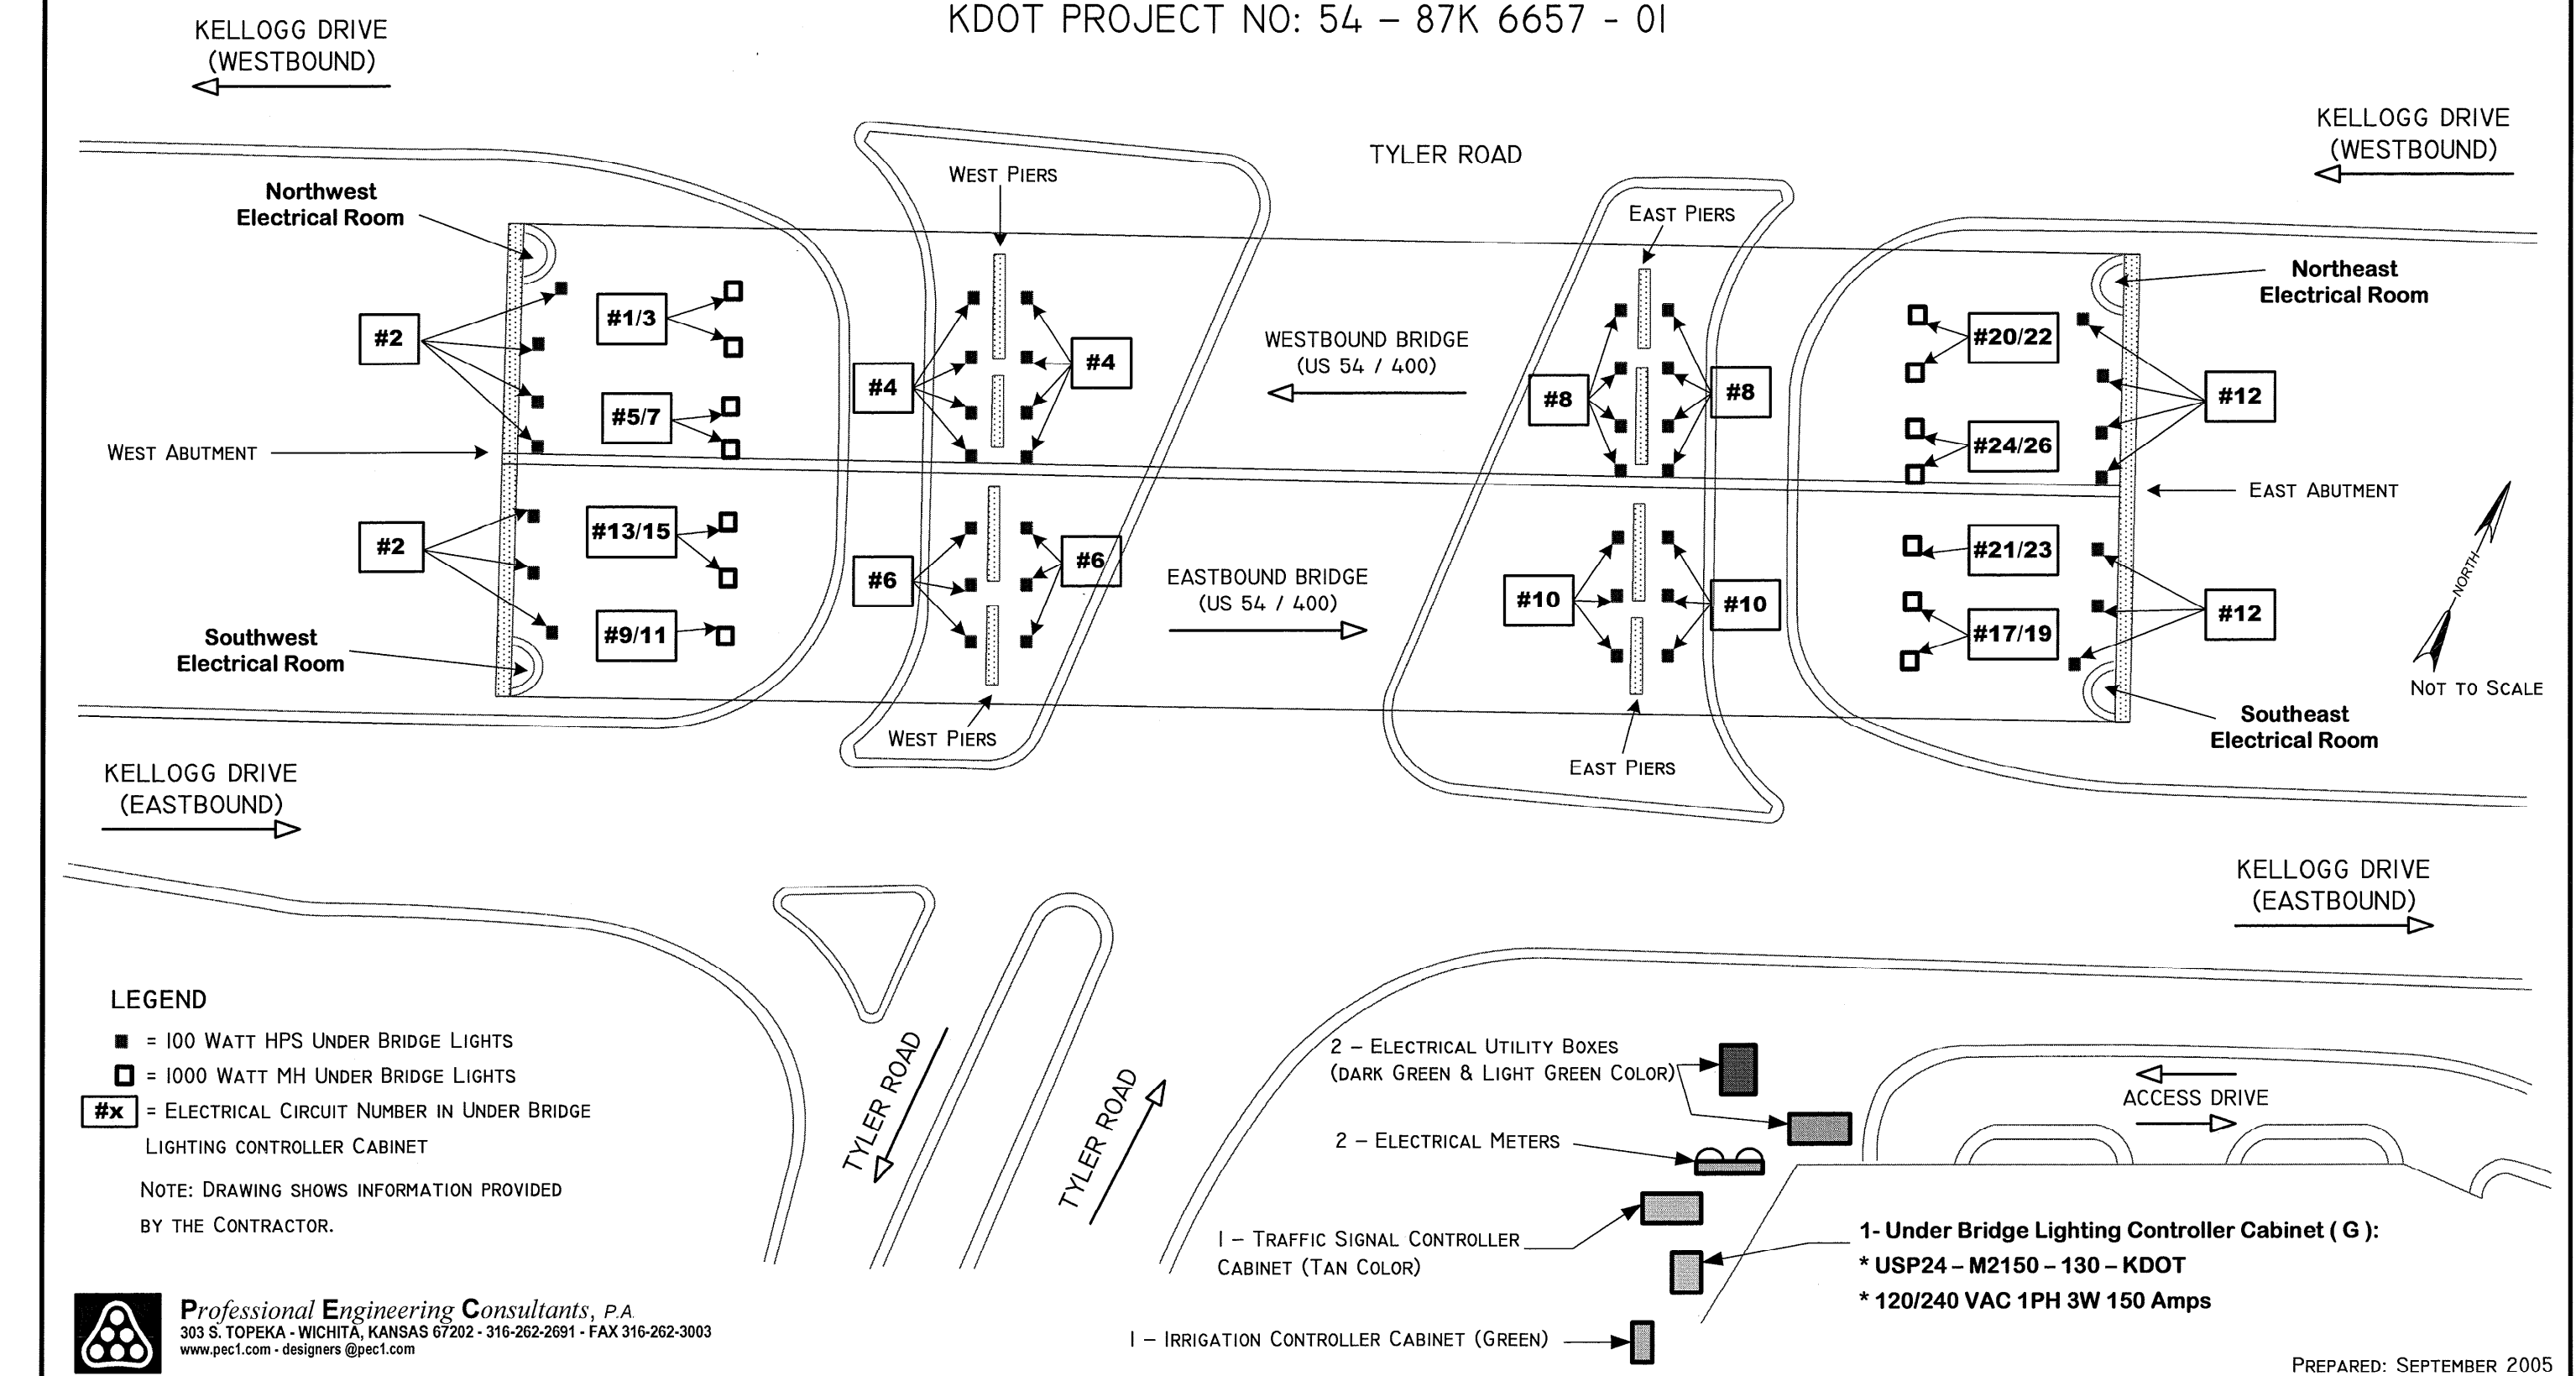

### BRIDGE LIGHTING CONDUIT EB KELLOGG @ TYLER ROAD (BR 497)

WEST KELLOGG FREEWAY - MAIZE AND TYLER ROAD INTERCHANGES  
 CITY OF WICHITA PROJECT NO.: 472 - 83533  
 KDOT PROJECT NO.: 54 - 87K 6657 - 01

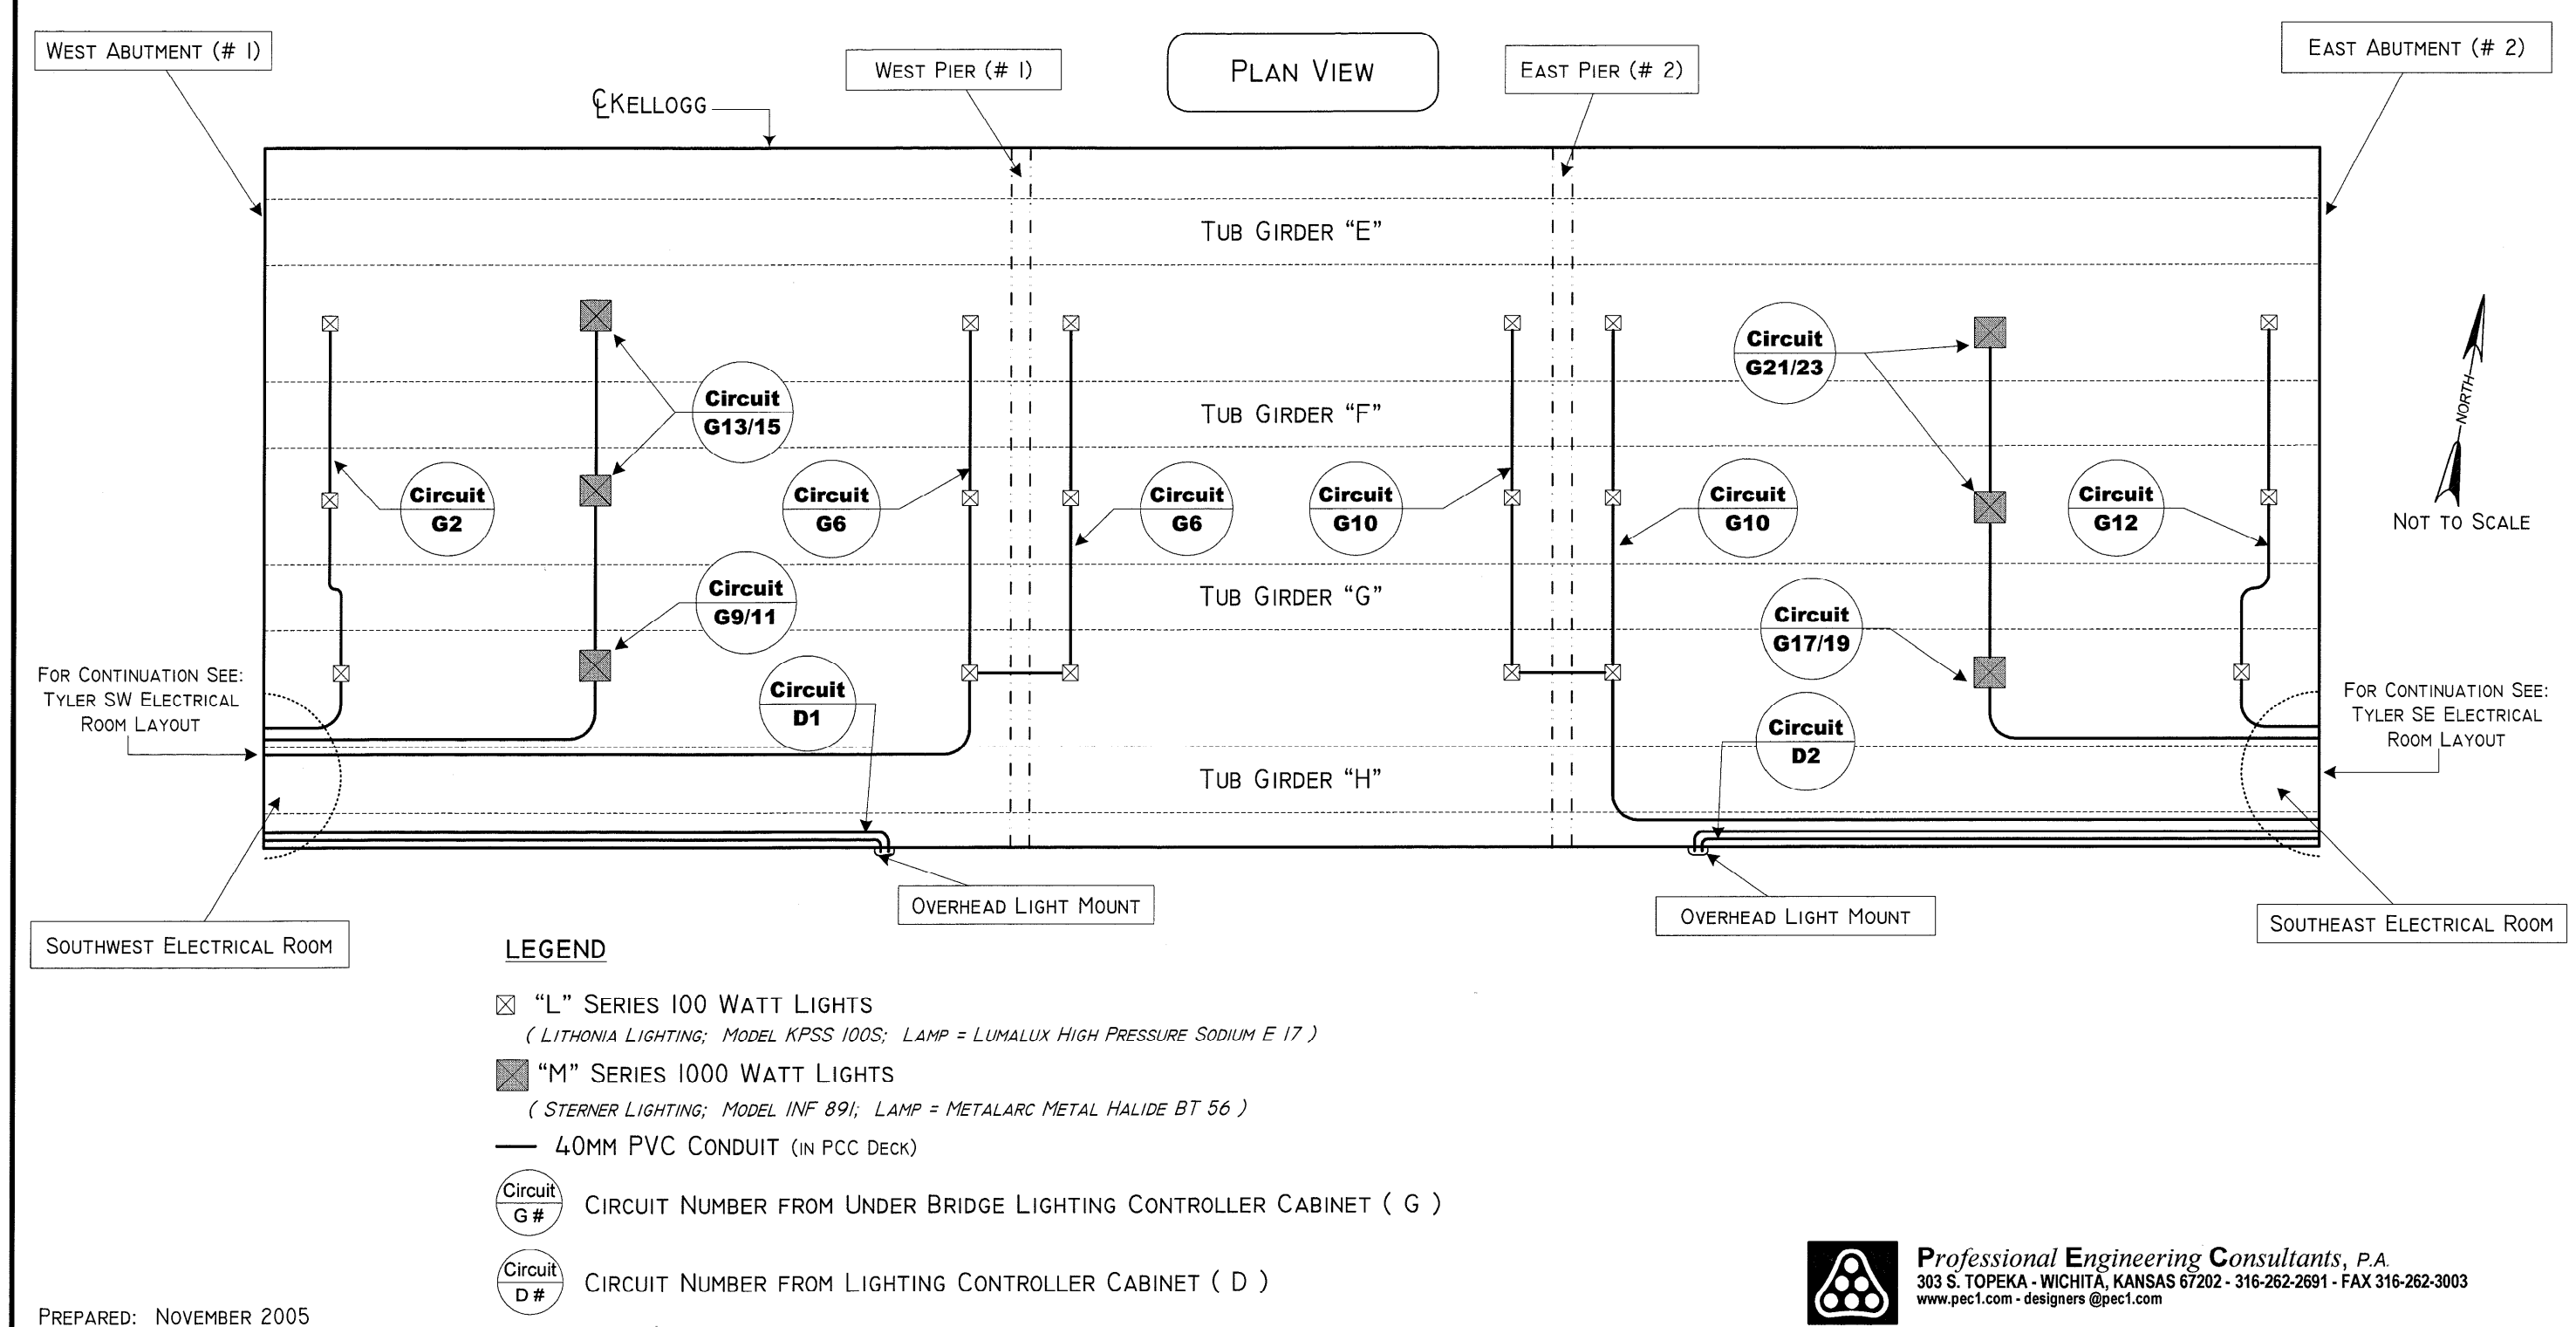

### RECORD DRAWING

1			
No.	Revisions	By	Date
CITY OF WICHITA			
BRIDGE LIGHTING TYLER ROAD			
SEDGWICK COUNTY			
<b>Professional Engineering Consultants, P.A.</b> 303 S. TOPEKA • WICHITA, KANSAS 67202 316-262-2691 • FAX 316-262-3003			
Designed by		Checked by	
Drawn by		Date	Job No. 97362

DSNR: WDH OPER: JGP SCALE: i:/1997/97362/As-Builts/dgn/3/V8\_Files\_With\_Rasters/Sh\_646a-Tyler-br-Lighting.dgn Last Rev: 9-18-07 By: gdr