


FHWA REGION NO.	STATE	PROJECT NO.	YEAR	SHEET NO.	TOTAL SHEETS
7	KANSAS	54-87 K-6657-01	2002	646b	1122


BRIDGE ELECTRICAL ROOM LAYOUT @ TYLER ROAD

WEST KELLOGG FREEWAY - MAIZE AND TYLER ROAD INTERCHANGES
 CITY OF WICHITA PROJECT NO: 472 - 83533
 K.D.O.T. PROJECT NO: 54 - 87 K 6657 - 01

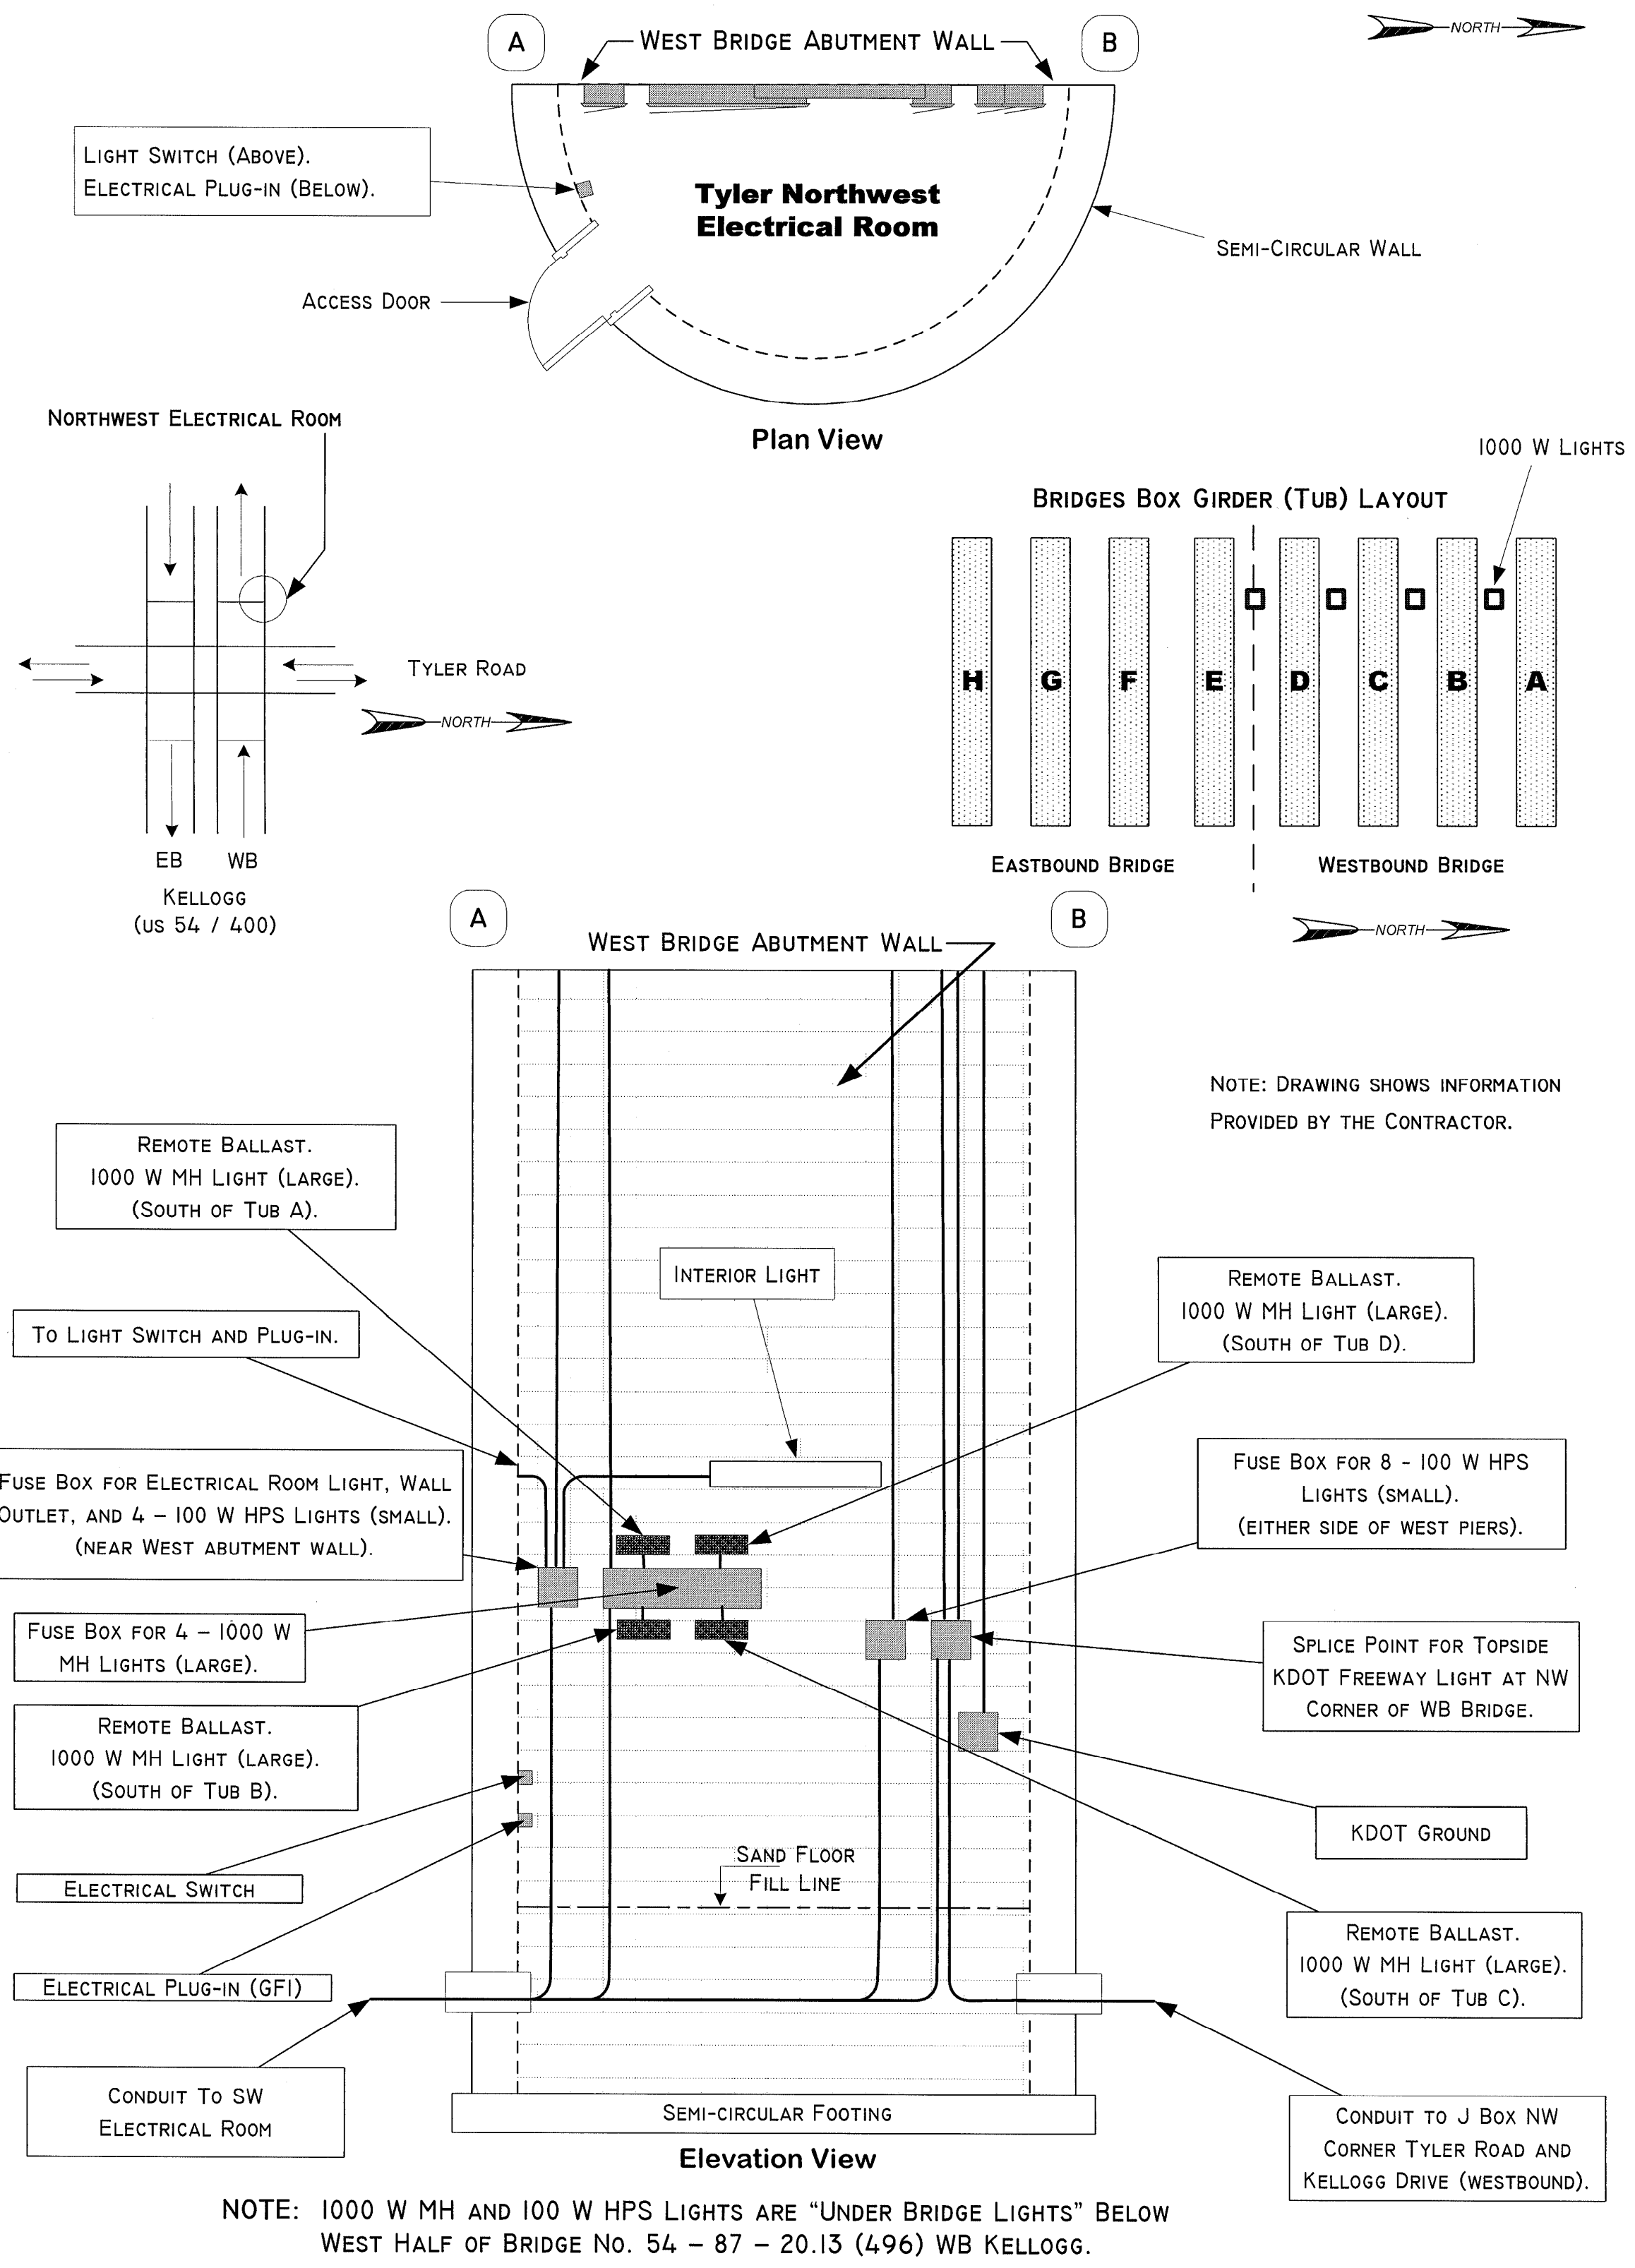

BRIDGE ELECTRICAL ROOM LAYOUT @ TYLER ROAD

WEST KELLOGG FREEWAY - MAIZE AND TYLER ROAD INTERCHANGES
 CITY OF WICHITA PROJECT NO: 472 - 83533
 K.D.O.T. PROJECT NO: 54 - 87 K 6657 - 01

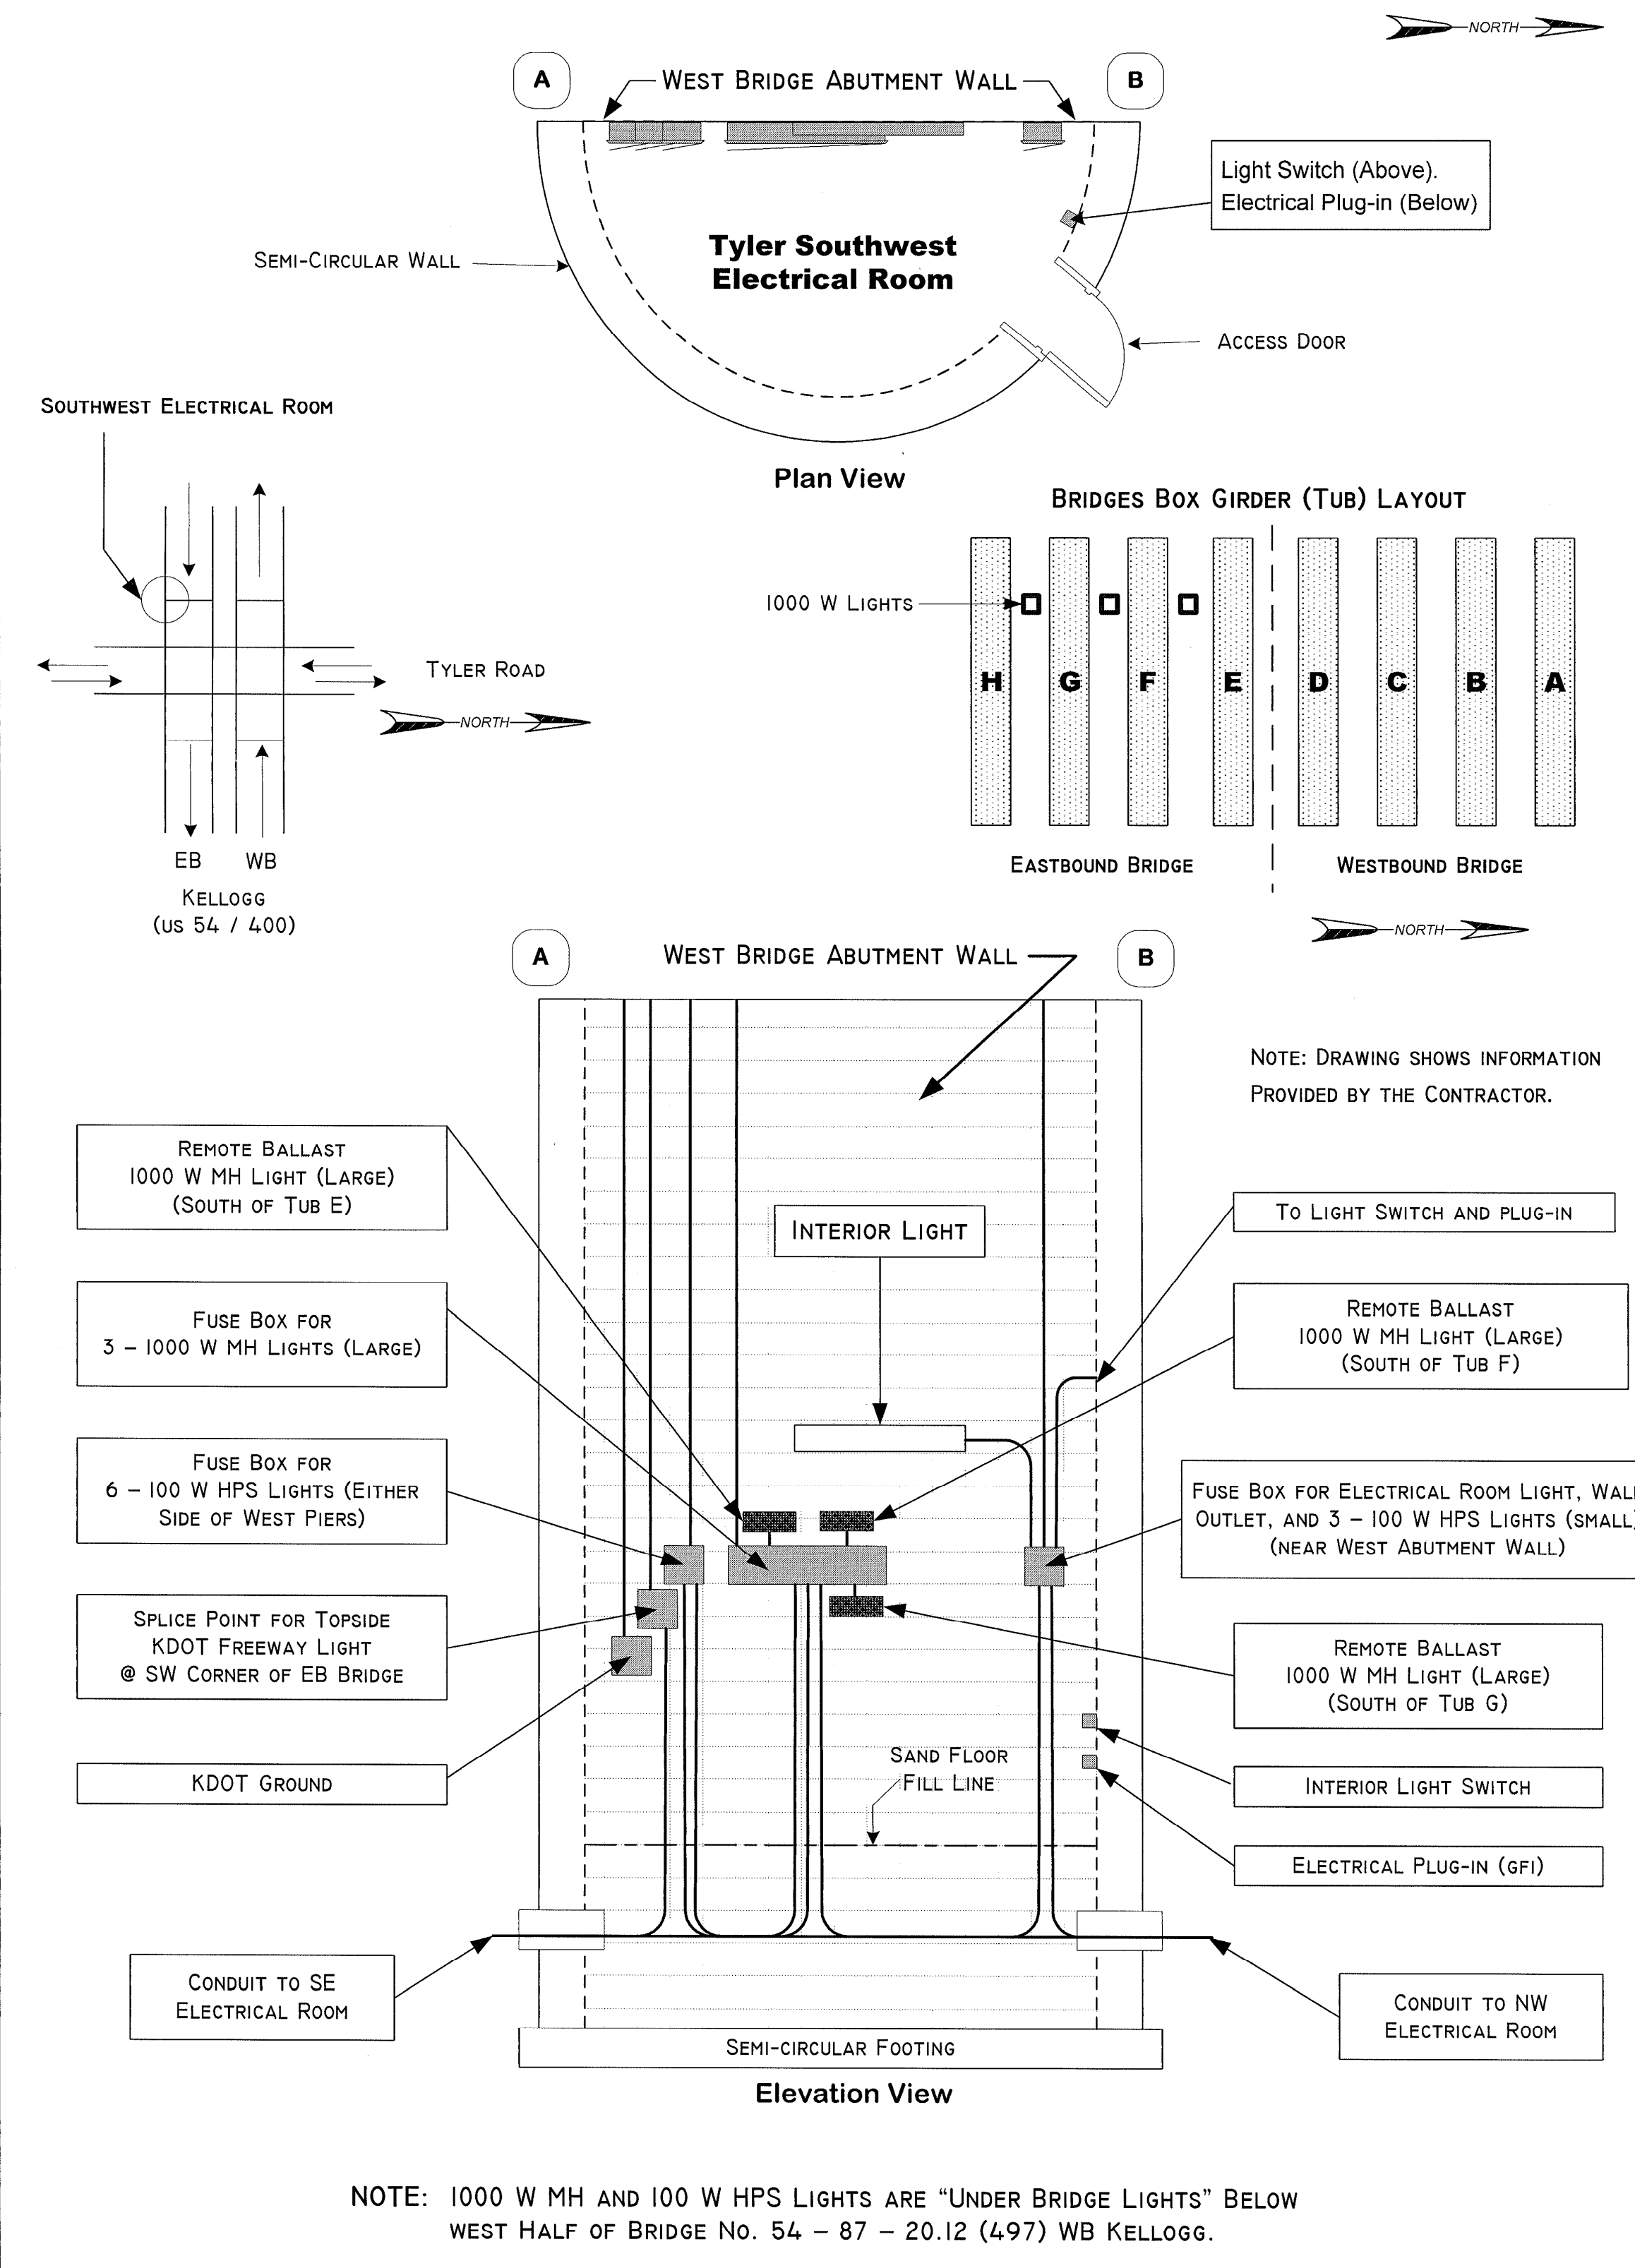

DSNR: WDH OPER: JGP SCALE: i:/1997/97362/As-Builts/dgn/s/Vol_3/V8_Files_With_Rasters/Sh_646b-Tyler_Elect_Room.dgn Last Rev: 9-18-07 By: gdr

RECORD DRAWING

CITY OF WICHITA			
BRIDGE ELECTRICAL ROOM LAYOUT TYLER ROAD			
SEDGWICK COUNTY			
Professional Engineering Consultants, P.A. 303 S. TOPEKA - WICHITA, KANSAS 67202 316-262-2691 • FAX 316-262-3003			
Designed by	Checked by		
Drawn by	Date	Job No.	97362