
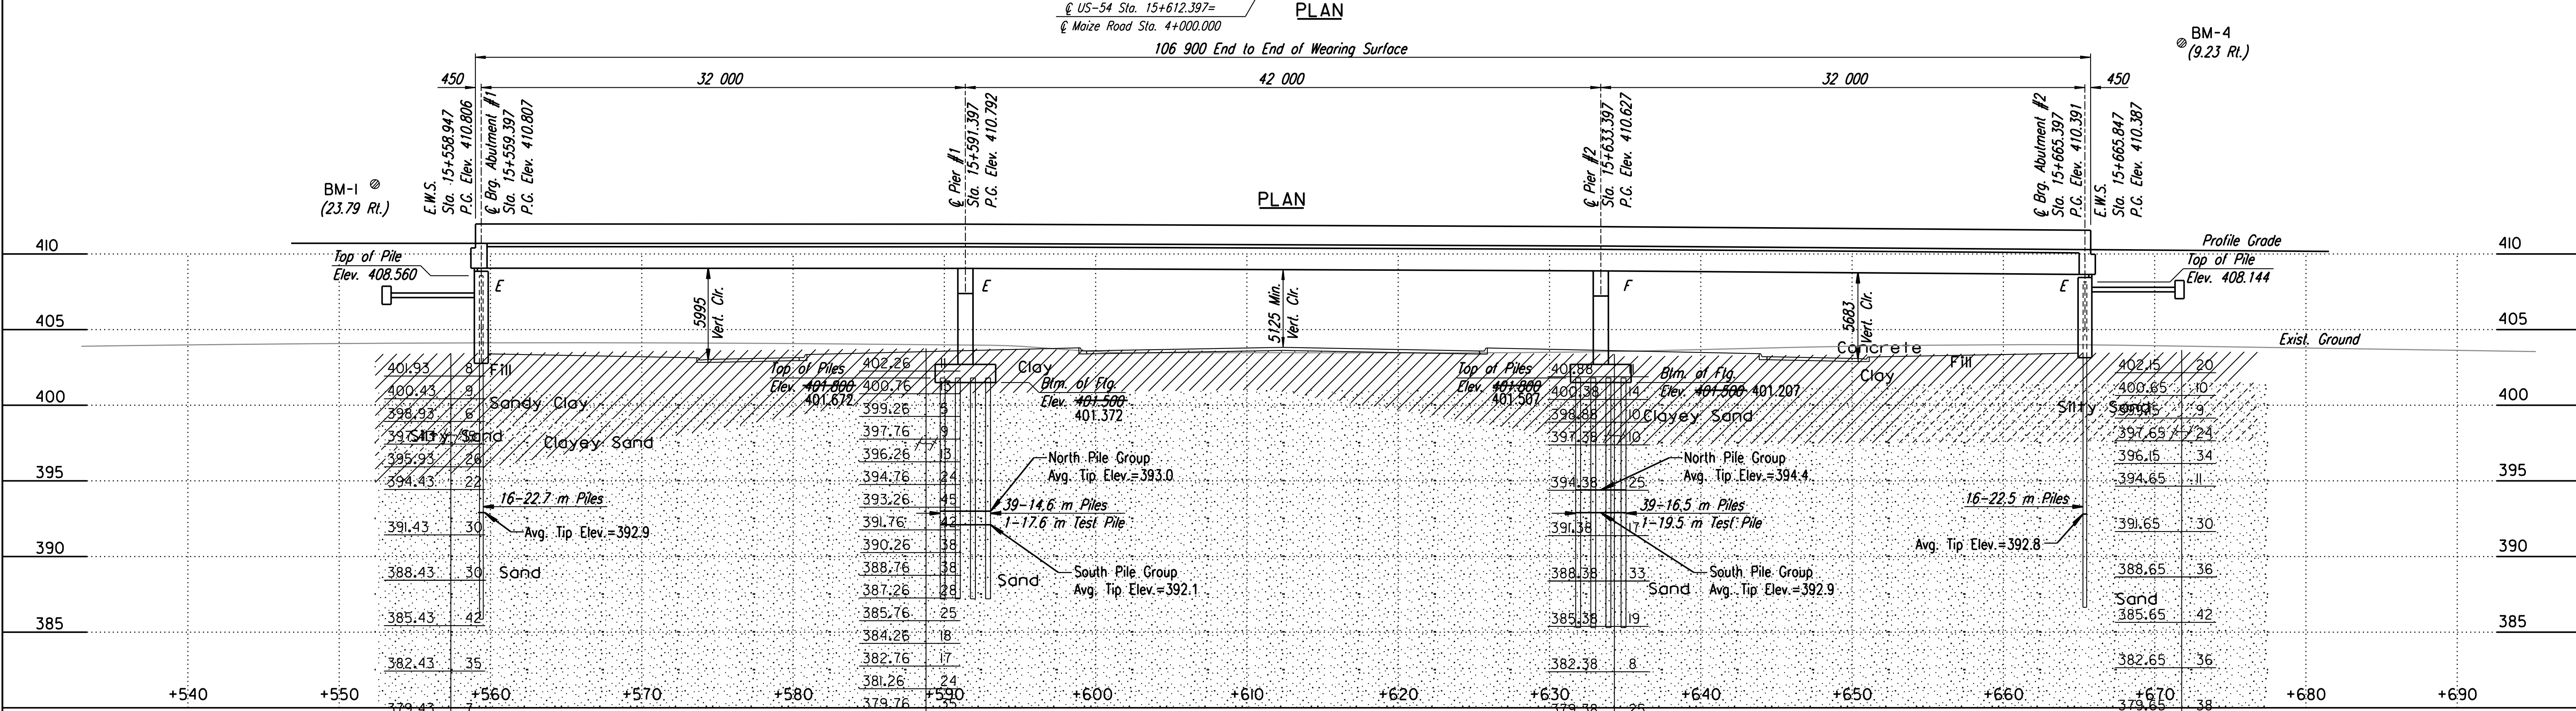
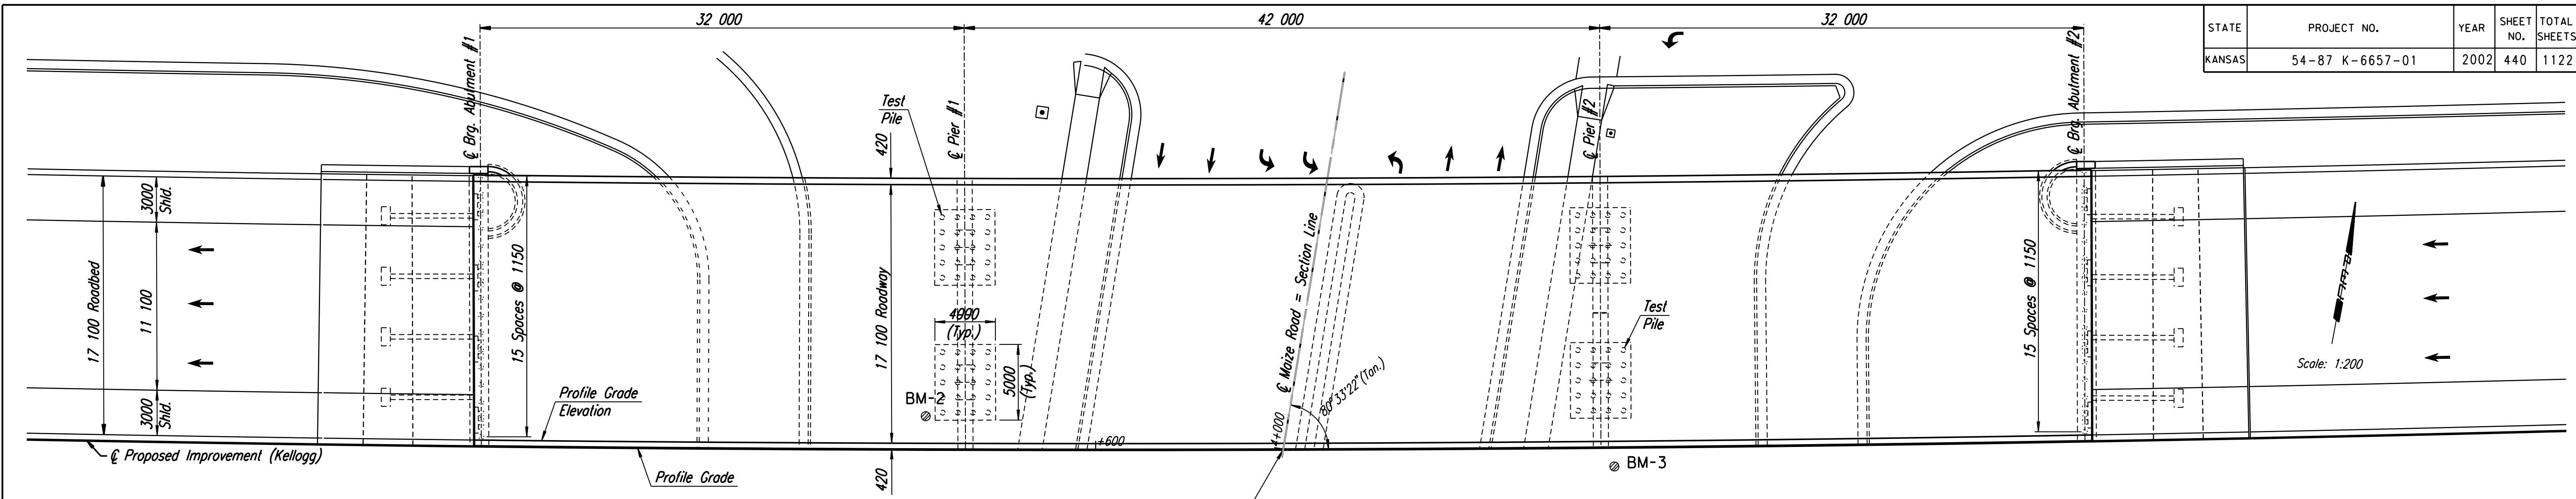


STATE	PROJECT NO.	YEAR	SHEET NO.	TOTAL SHEETS
KANSAS	54-87-K-6657-01	2002	440	1122

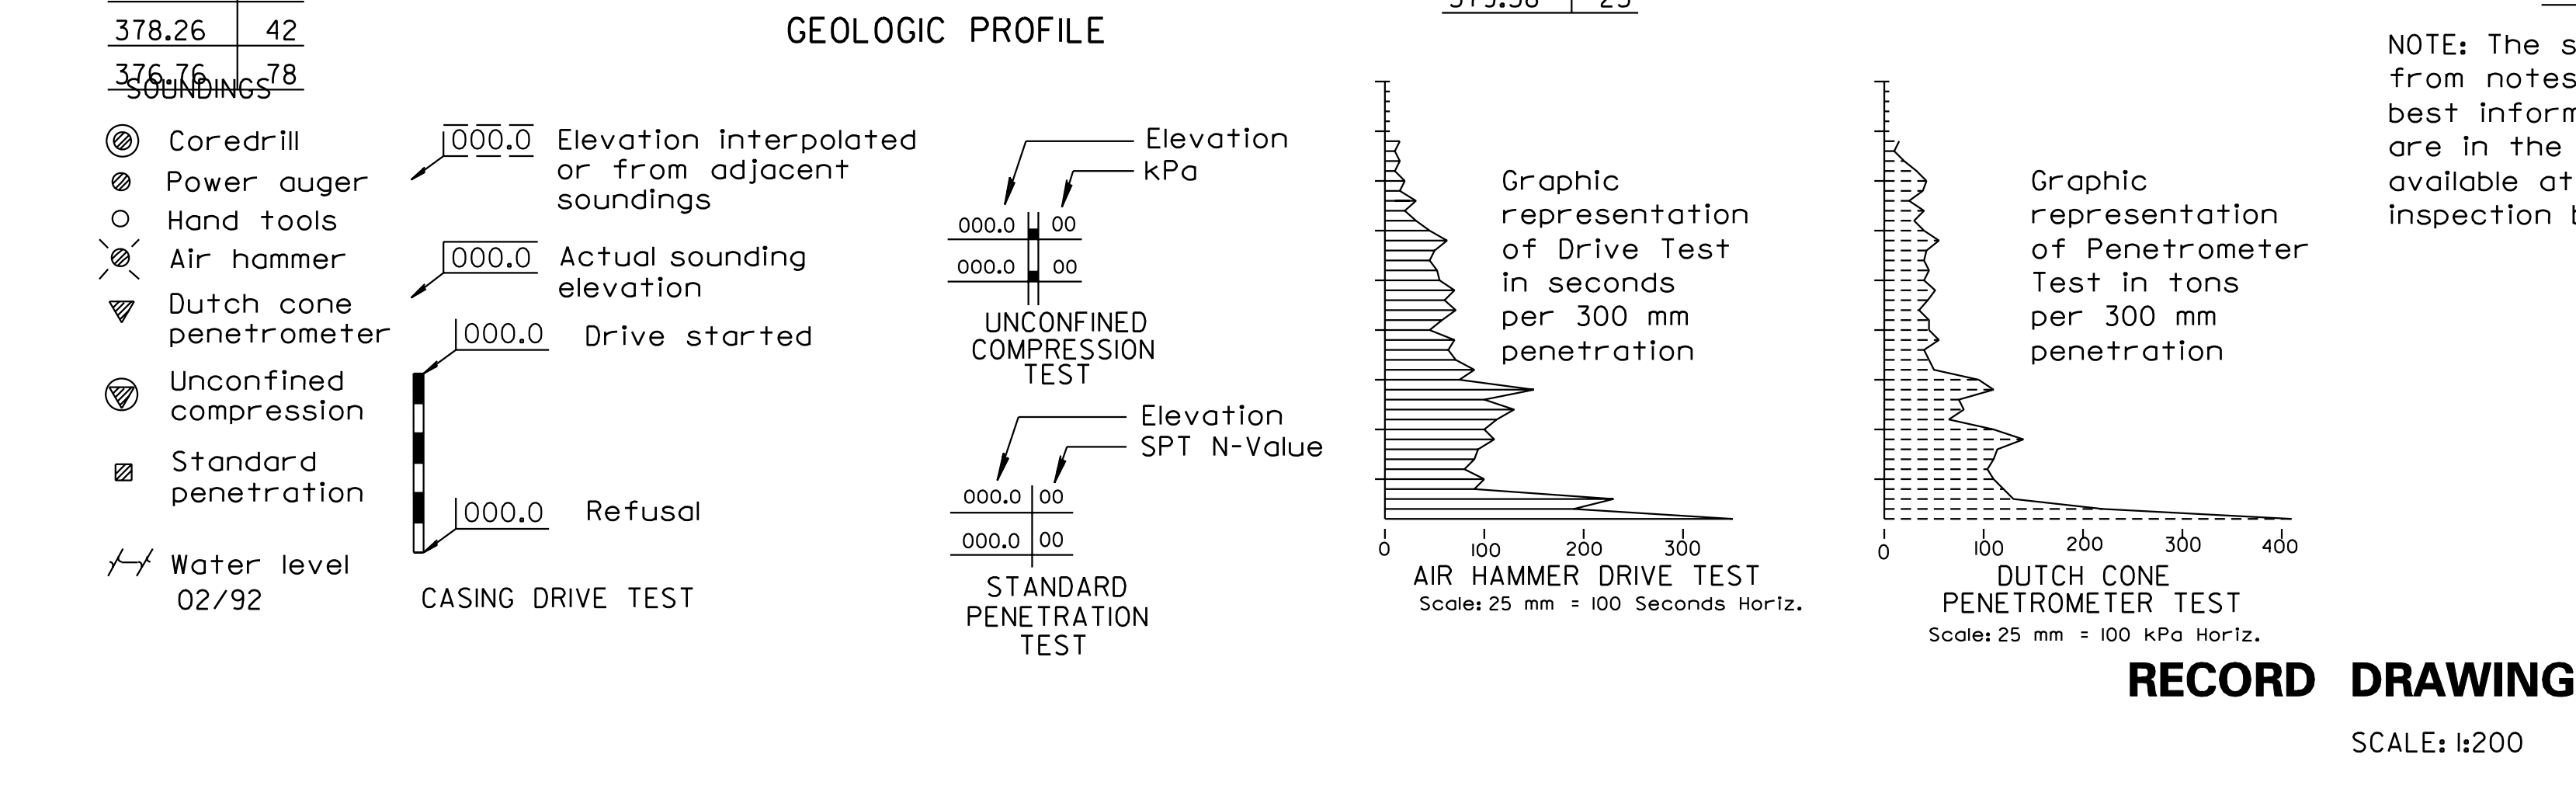

**STANDARD GEOLOGIC SYMBOLS**

**RECORD DRAWING**

SCALE: 1:200

Designed by	P.D.F.	Checked by	R.A.S.
Drawn by	W.L.L.	Date	April, 2002
Job No.	97362		

**Professional Engineering Consultants, P.A.**  
 303 S. TOPEKA • WICHITA, KANSAS 67202  
 316-262-2691 • FAX 316-262-3003

drawn by: wil  
 1/1997/97362/As-Builts/dgr/s/Vol.3/Sh.440-geologyWB.dgn  
 Last Rev: 8-30-07 By: gdr