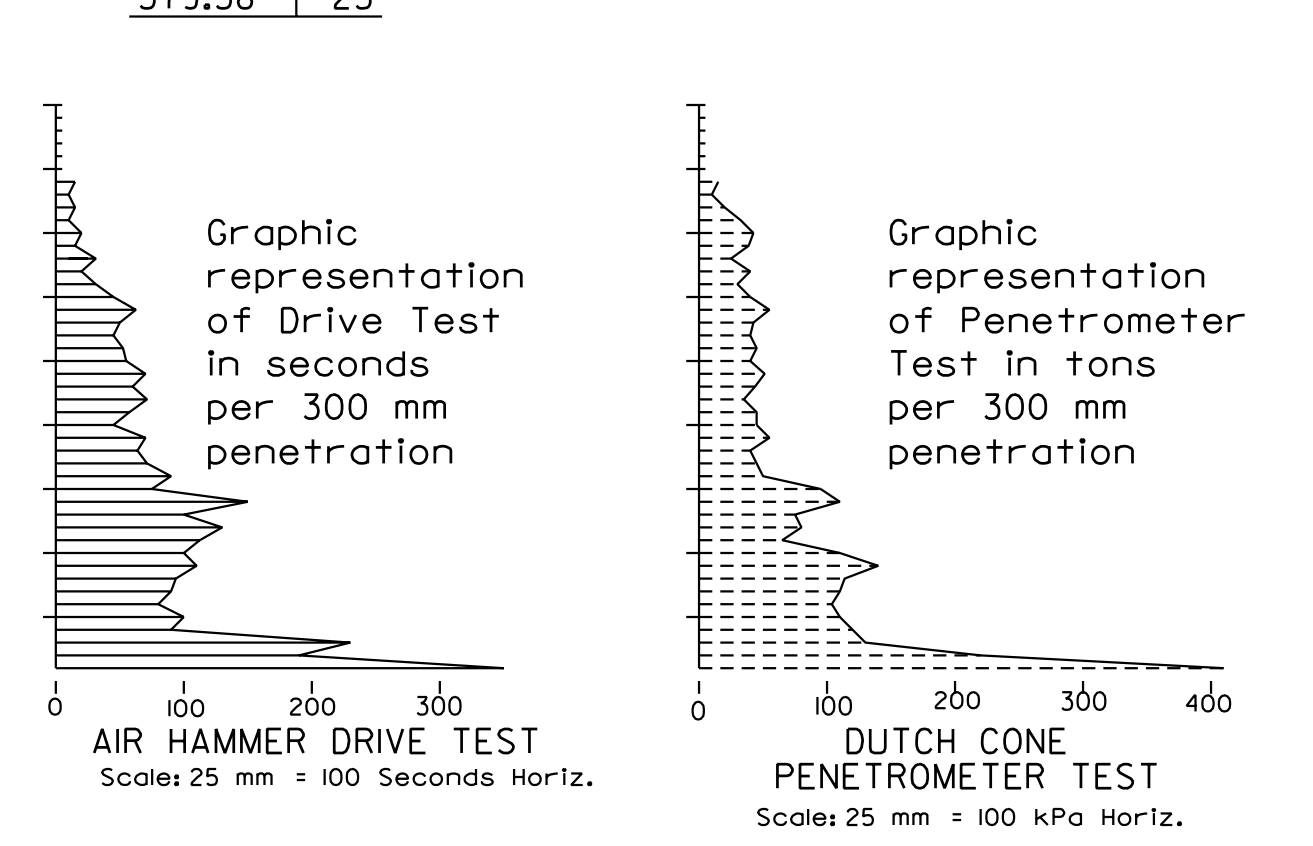
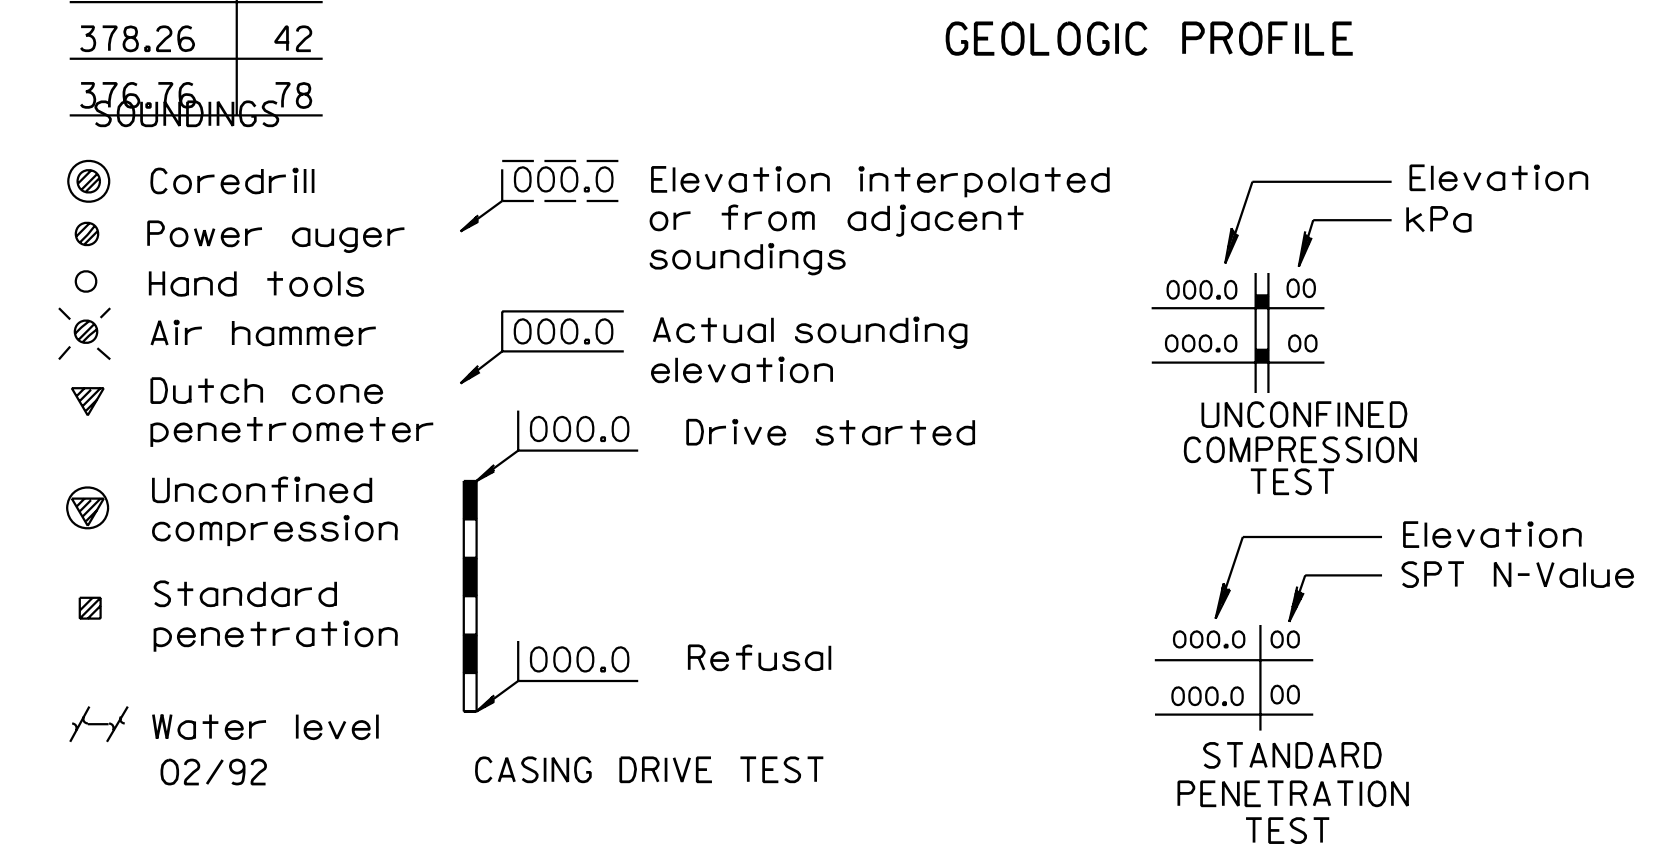


**STANDARD GEOLOGIC SYMBOLS**

NOTE: The soundings shown on these plans are taken from notes obtained in the field and represent the best information available. The logs of these soundings are in the files of Allied Laboratories and are available at their offices at Wichita, Kansas for inspection by interested and qualified bidders.

No.	Revisions	By	Date
CITY OF WICHITA BR. NO. 54-87-19.06 (49)E.B. STA. 15+612.397			
<b>ENGINEERING GEOLOGY</b> KELLOGG (US-54) OVER MAIZE ROAD SEDGWICK COUNTY			
<b>Professional Engineering Consultants, P.A.</b> 303 S. TOPEKA • WICHITA, KANSAS 67202 316-262-2691 • FAX 316-262-3003			
Designed by	P.D.F.	Checked by	R.A.S.
Drawn by	W.L.L.	Date	April, 2002
		Job No.	97362

**RECORD DRAWING**  
SCALE: 1:200

drawn by: wil  
 1/1997/97362/As-Builts/dgr/s/Vol.3/Sh 44-geology/EBdgm  
 Last Rev: 8-30-07 By: gdr