



STATE	PROJECT NO.	YEAR	SHEET NO.	TOTAL SHEETS
KANSAS	54-87 K-6657-01	2002	455	1122

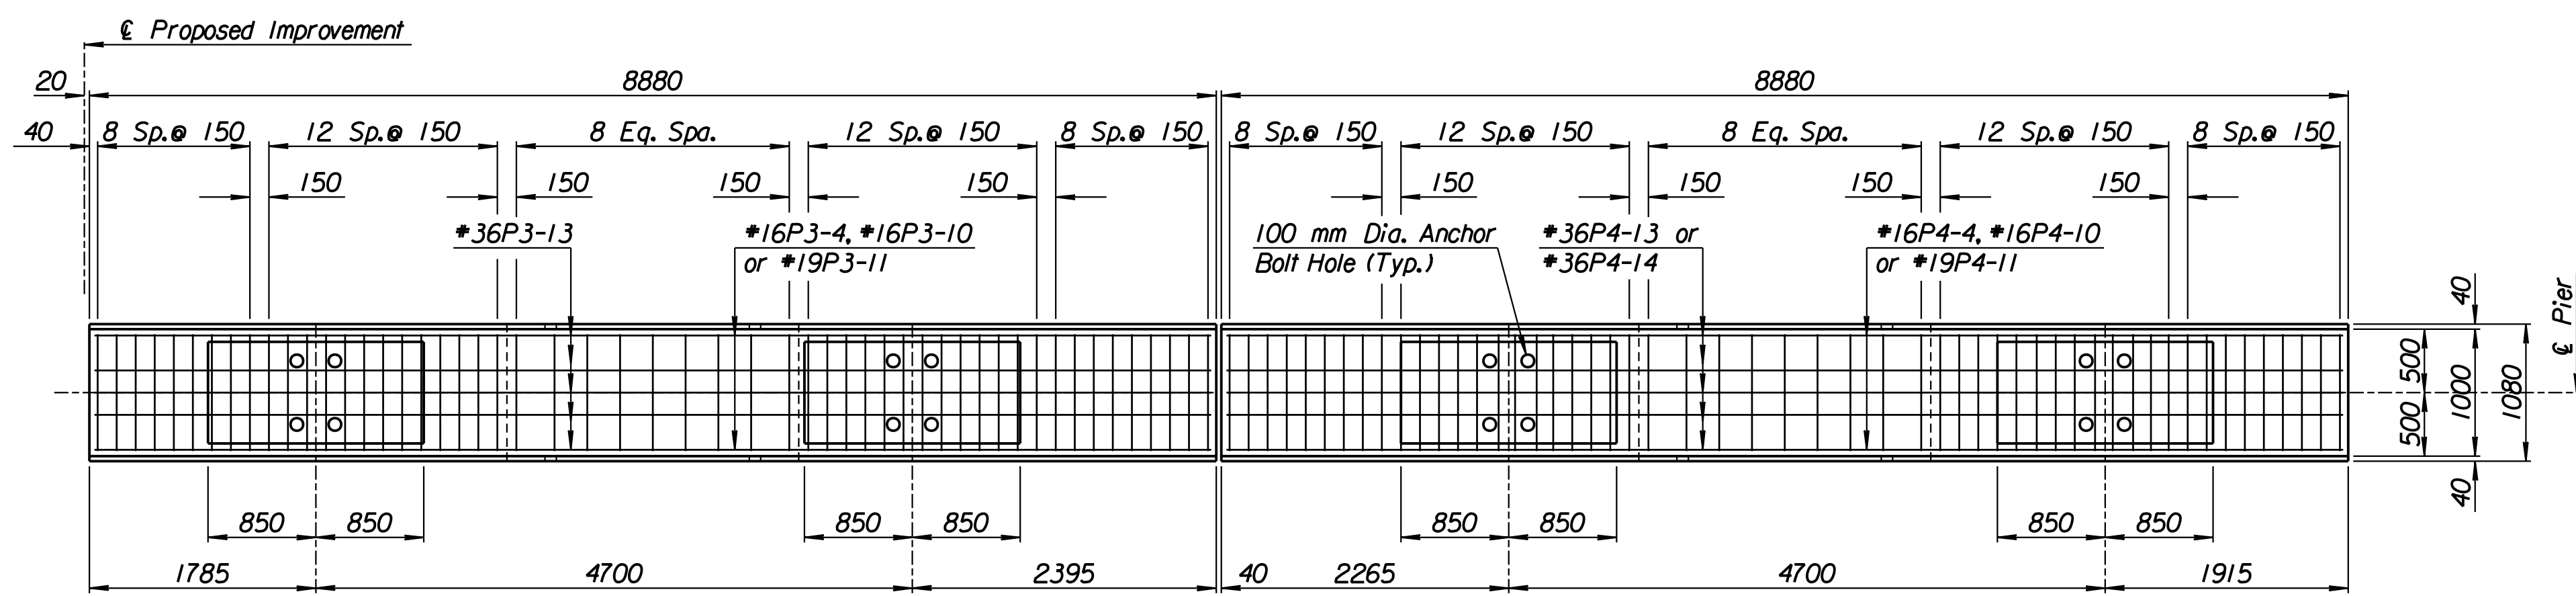


PLAN

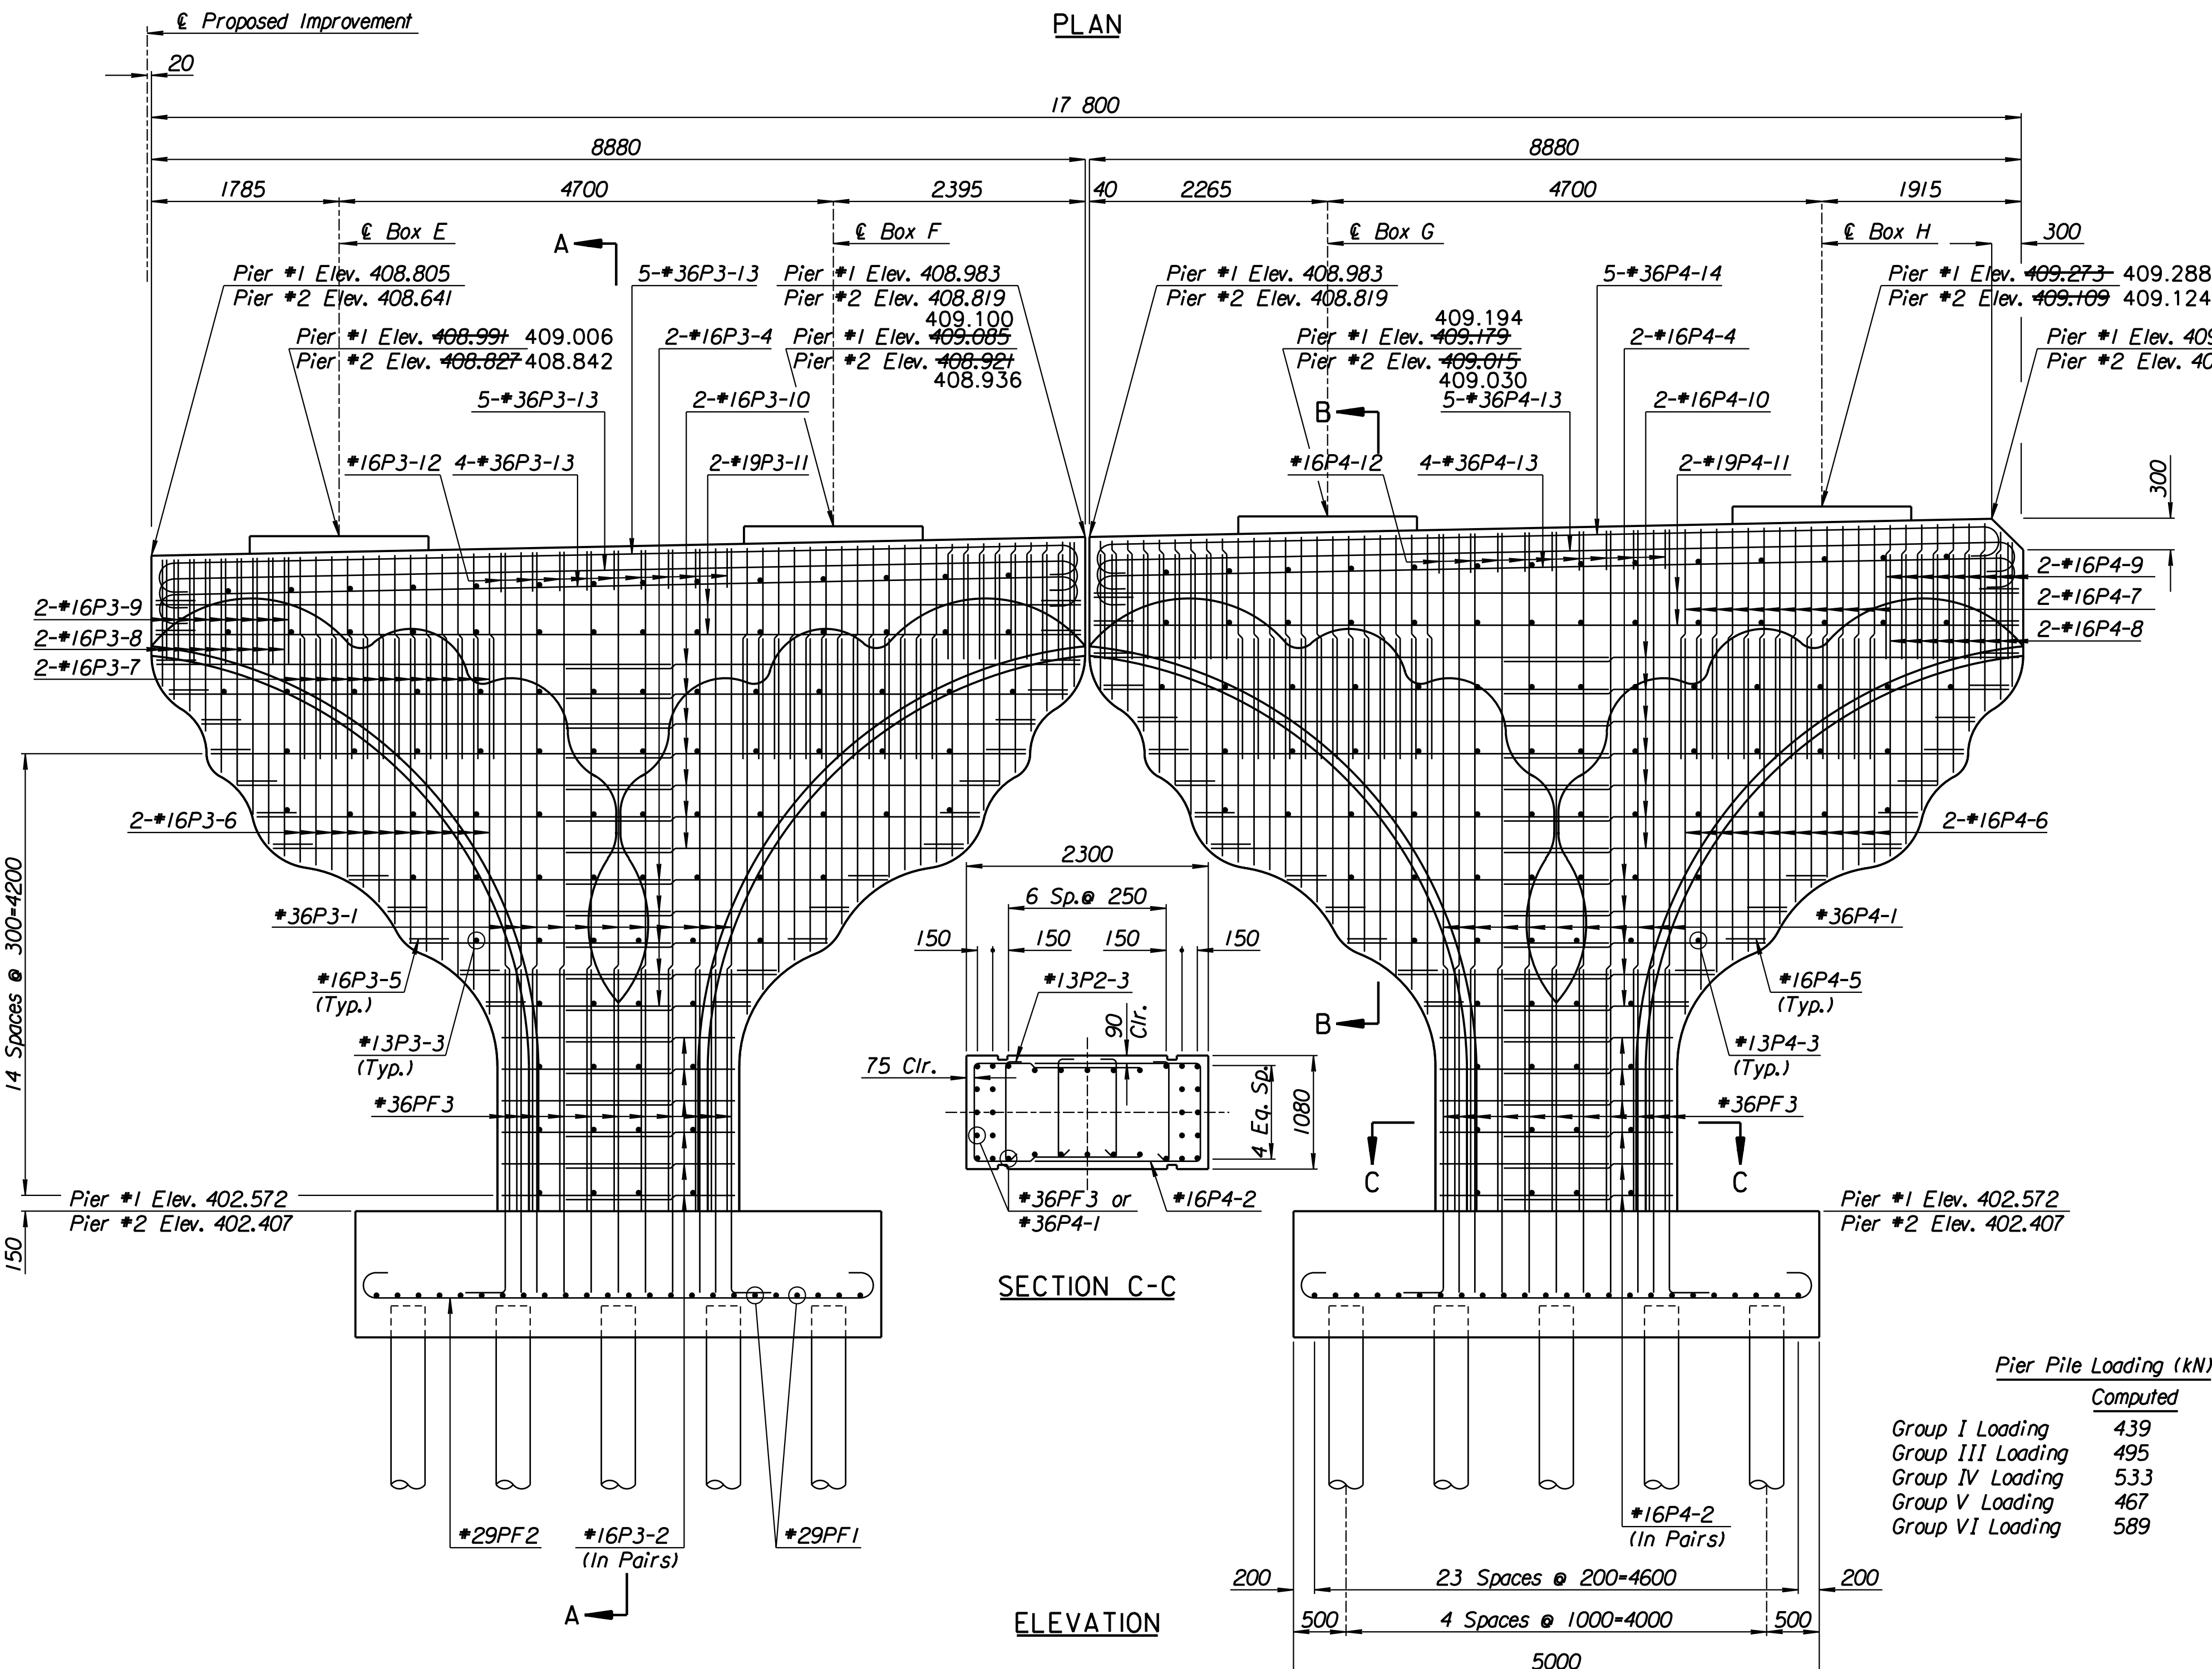


SECTION C-C

ELEVATION

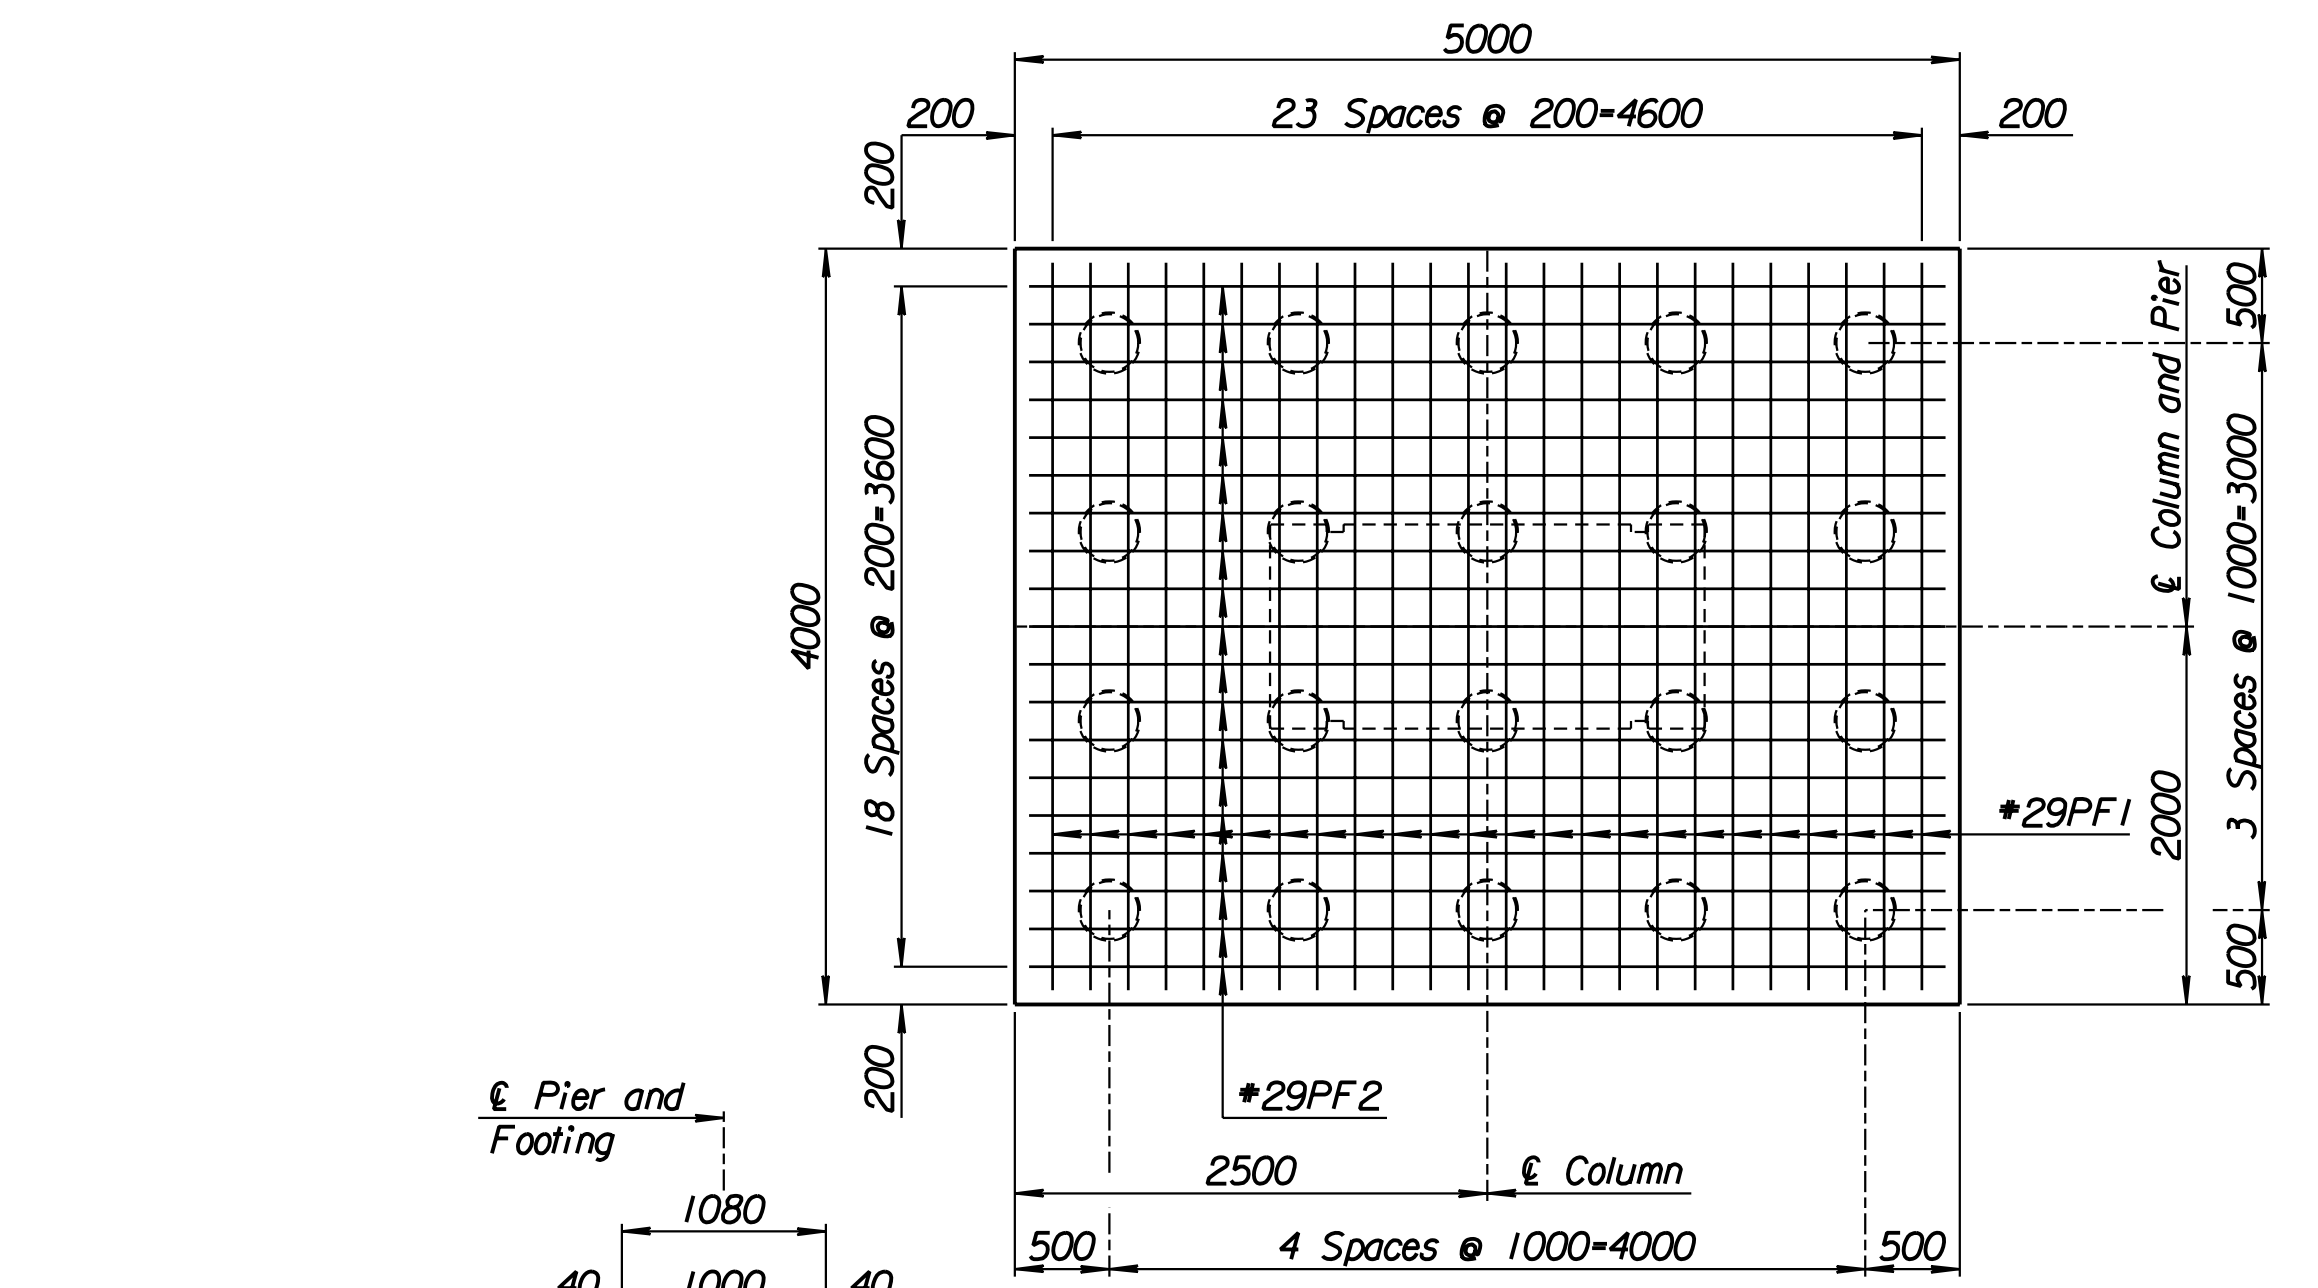

FOOTING PLAN

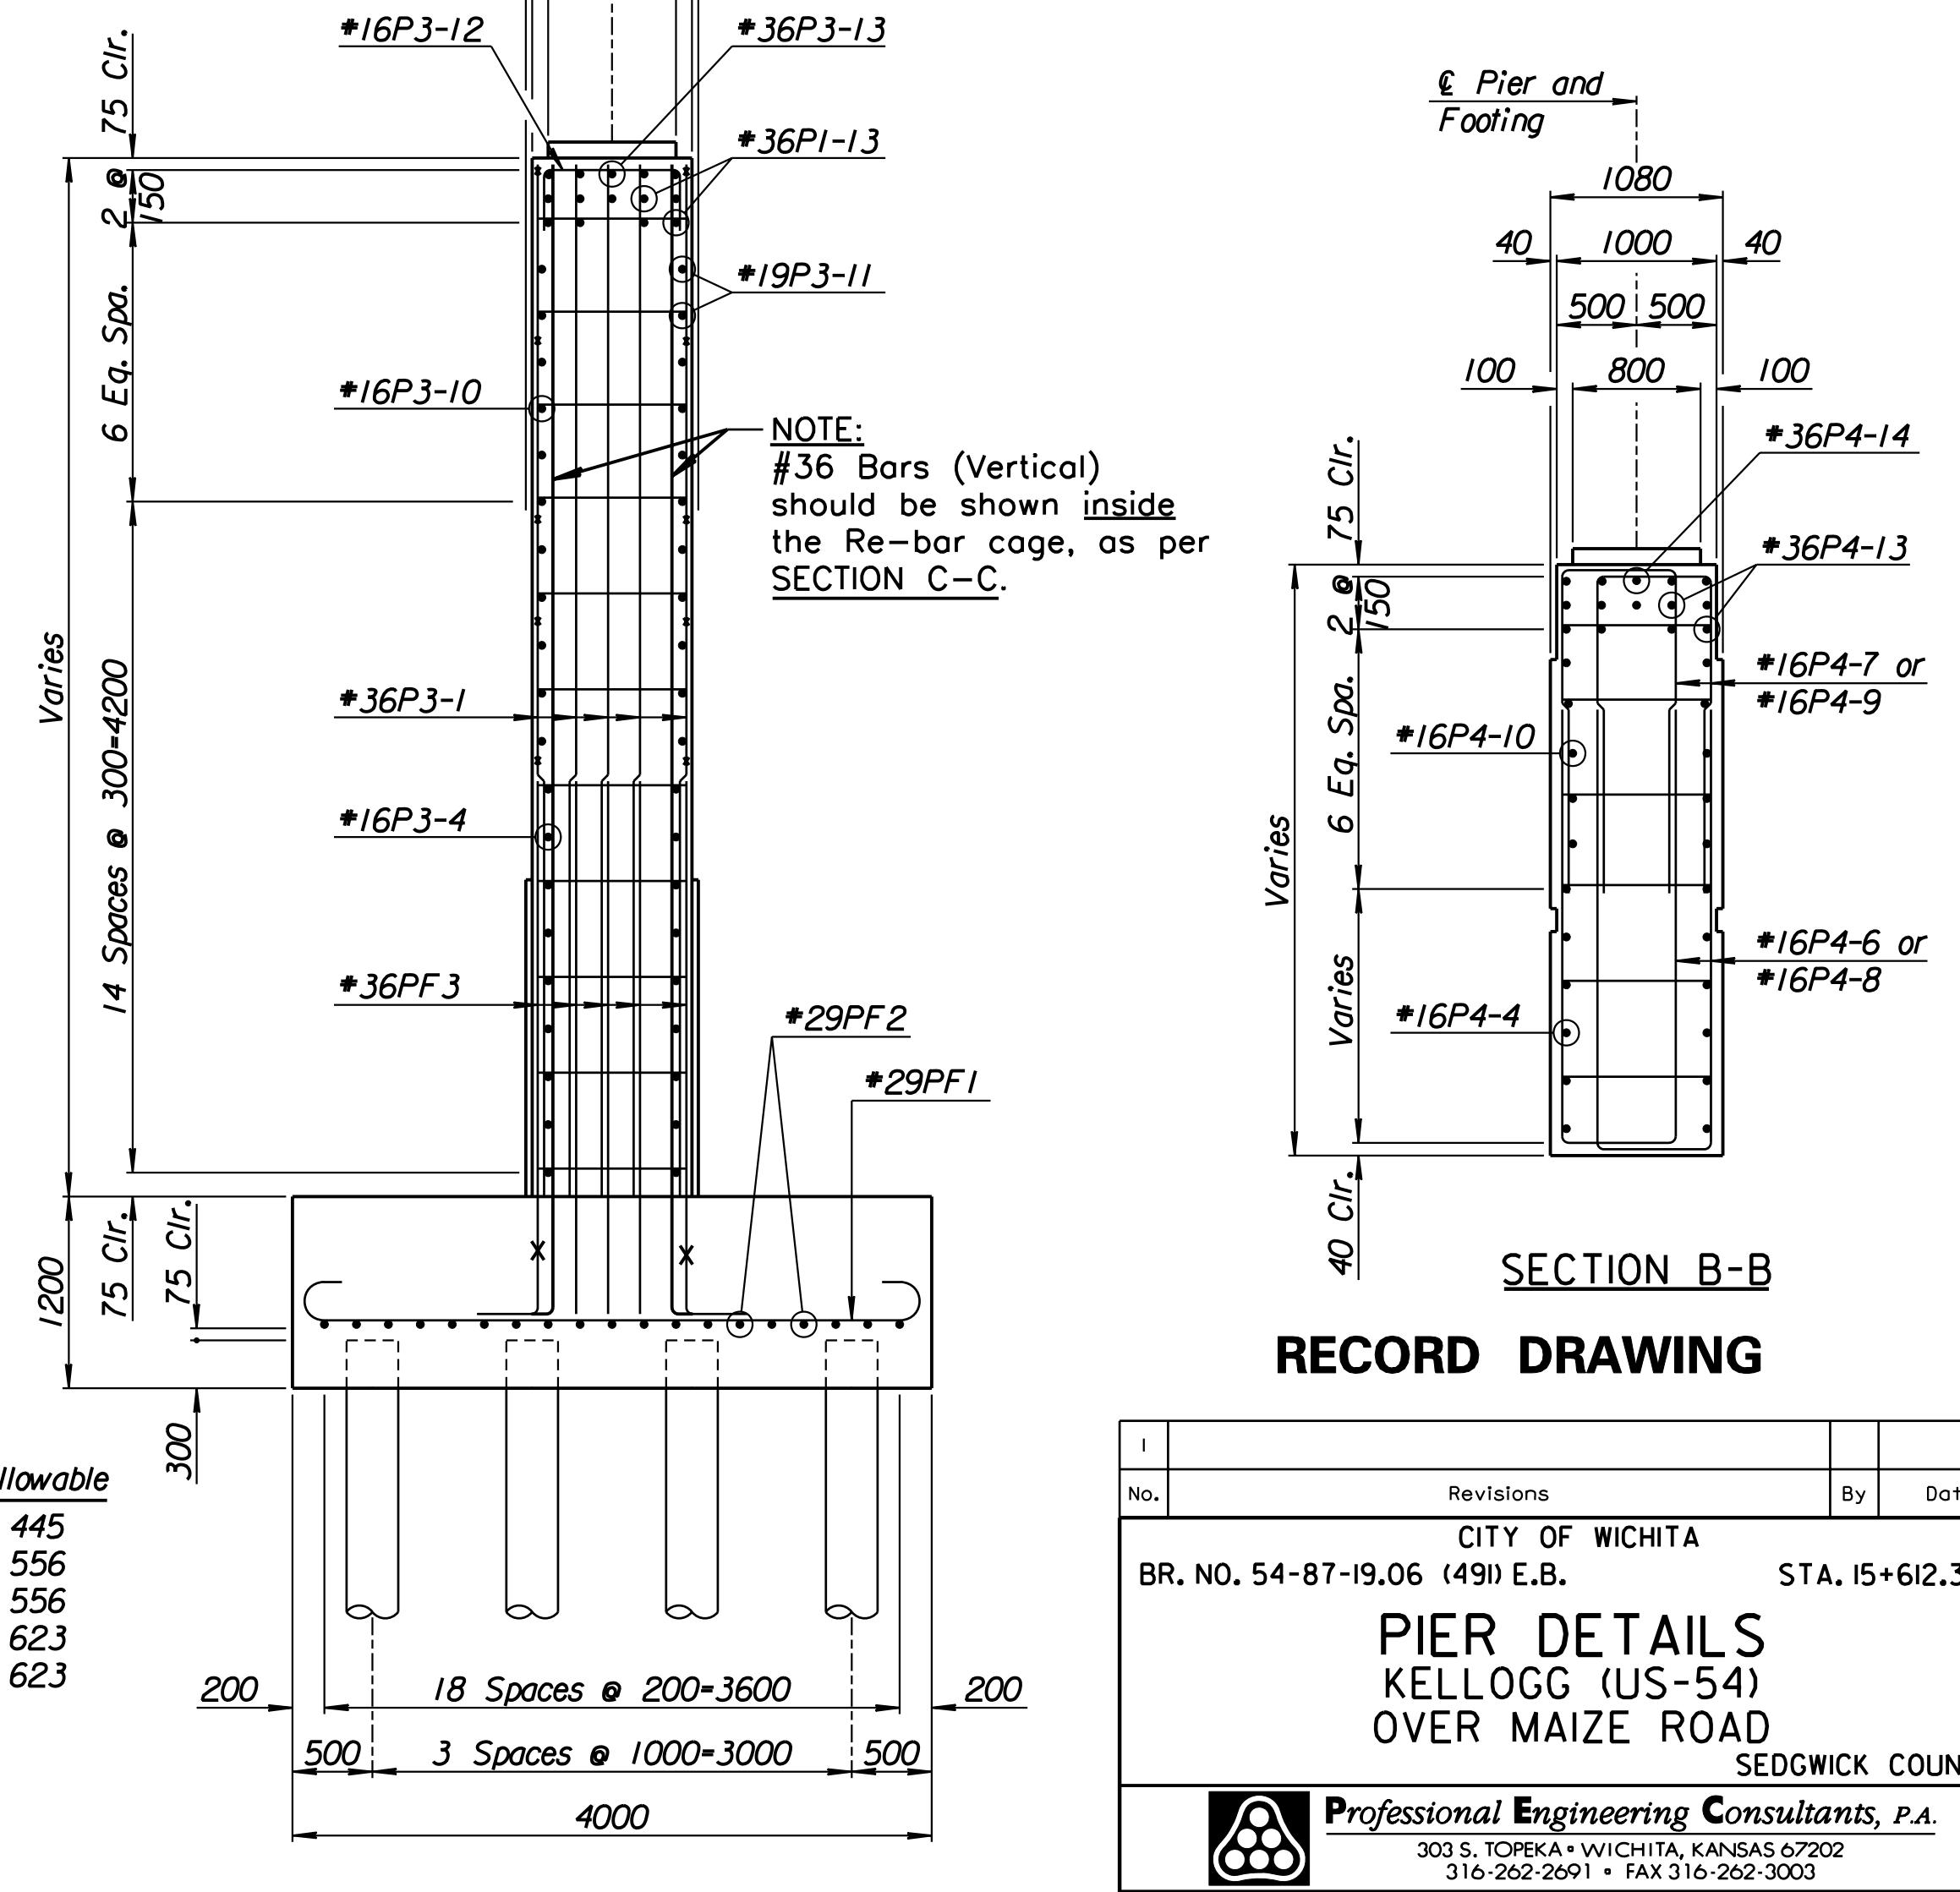

SECTION B-B

RECORD DRAWING

SECTION A-A

	Pier Pile Loading (kN)	
	Computed	Allowable
Group I Loading	439	445
Group III Loading	495	556
Group IV Loading	533	556
Group V Loading	467	623
Group VI Loading	589	623

Drawn by: wil  
 Scale: 40  
 1/1997/97362/As-Built/dgn/vol\_3/Sh 455-pier.dgn Last Rev: 8-30-07 By: gdr

1			
No.	Revisions	By	Date
CITY OF WICHITA BR. NO. 54-87-19.06 (49) E.B. STA. 15+612.397 <b>PIER DETAILS</b> KELLOGG (US-54) OVER MAIZE ROAD SEDGWICK COUNTY			
<b>Professional Engineering Consultants, P.A.</b> 303 S. TOPEKA • WICHITA, KANSAS 67202 316-262-2691 • FAX 316-262-3003			
Designed by	P.D.F.	Checked by	R.A.S.
Drawn by	W.L.L.	Date	April 11, 2002 Job No. 97362