



STATE	PROJECT NO.	YEAR	SHEET NO.	TOTAL SHEETS
KANSAS	54-87 K-6657-01	2002	456	1122

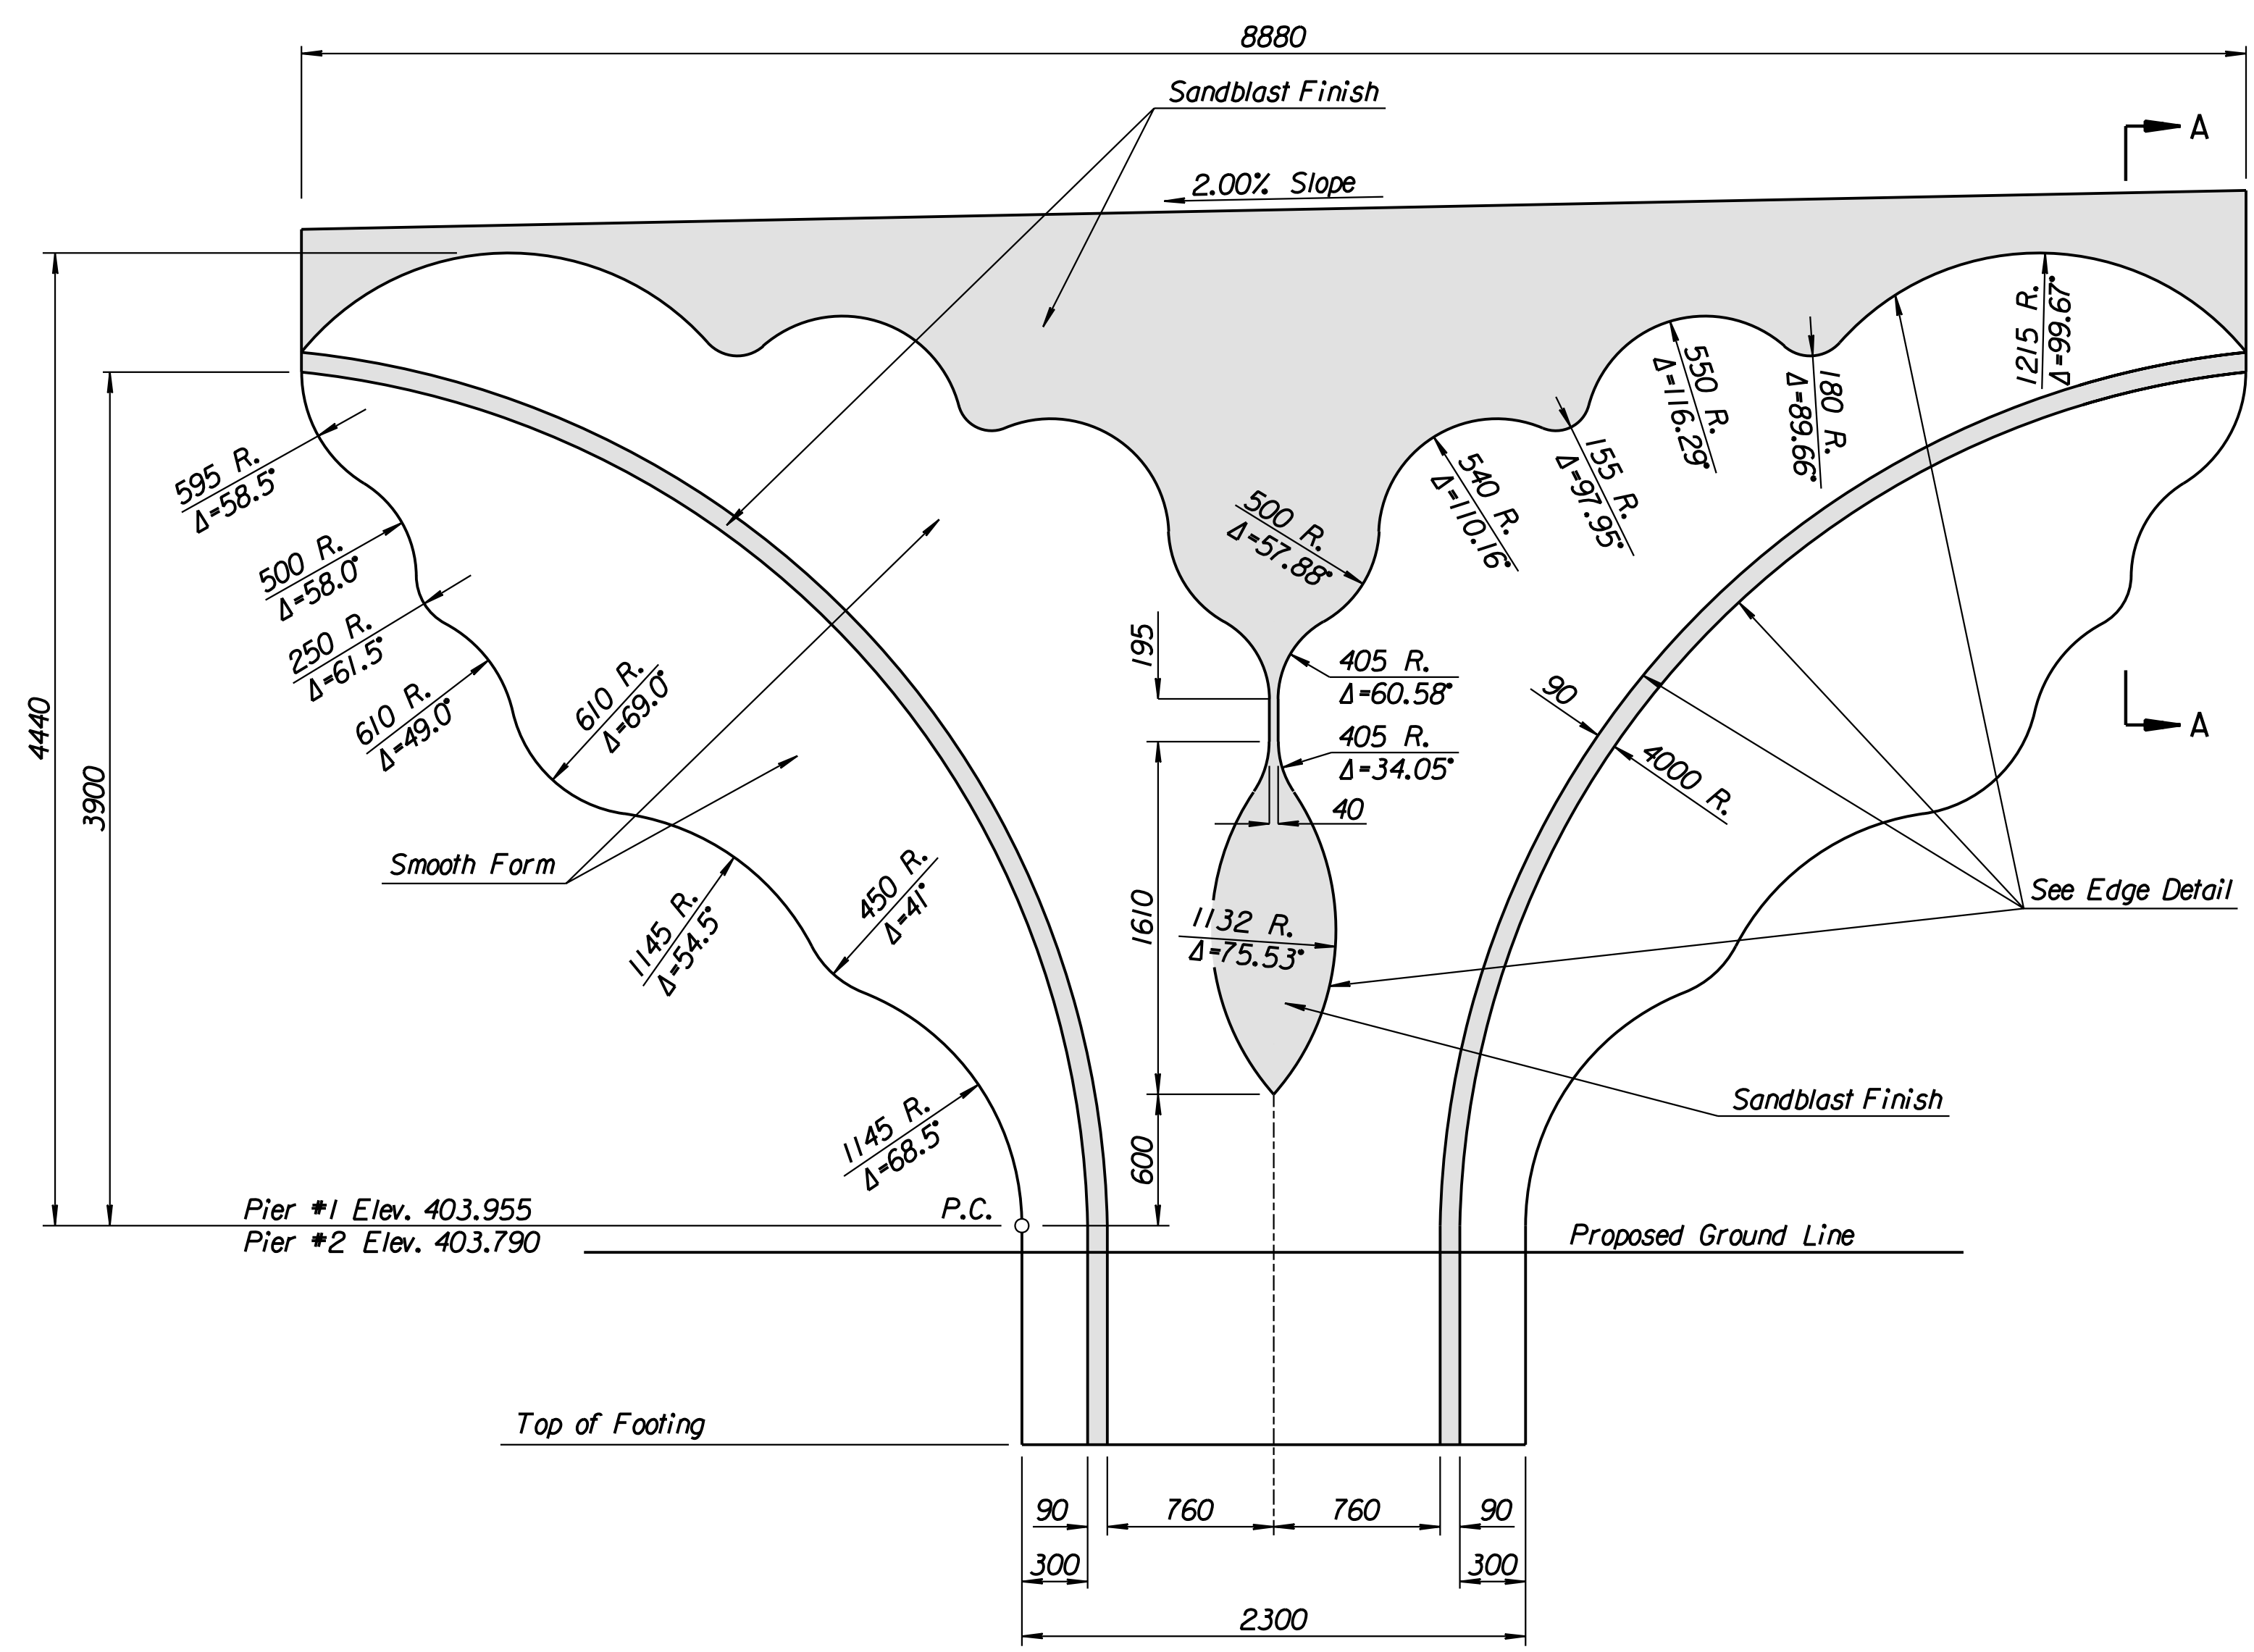

TYPICAL PIER DIMENSIONS

Note:  
 Sandblast Finish shall be equivalent to  
 #121 Sandblast #3 Form Liner by Scott Systems.

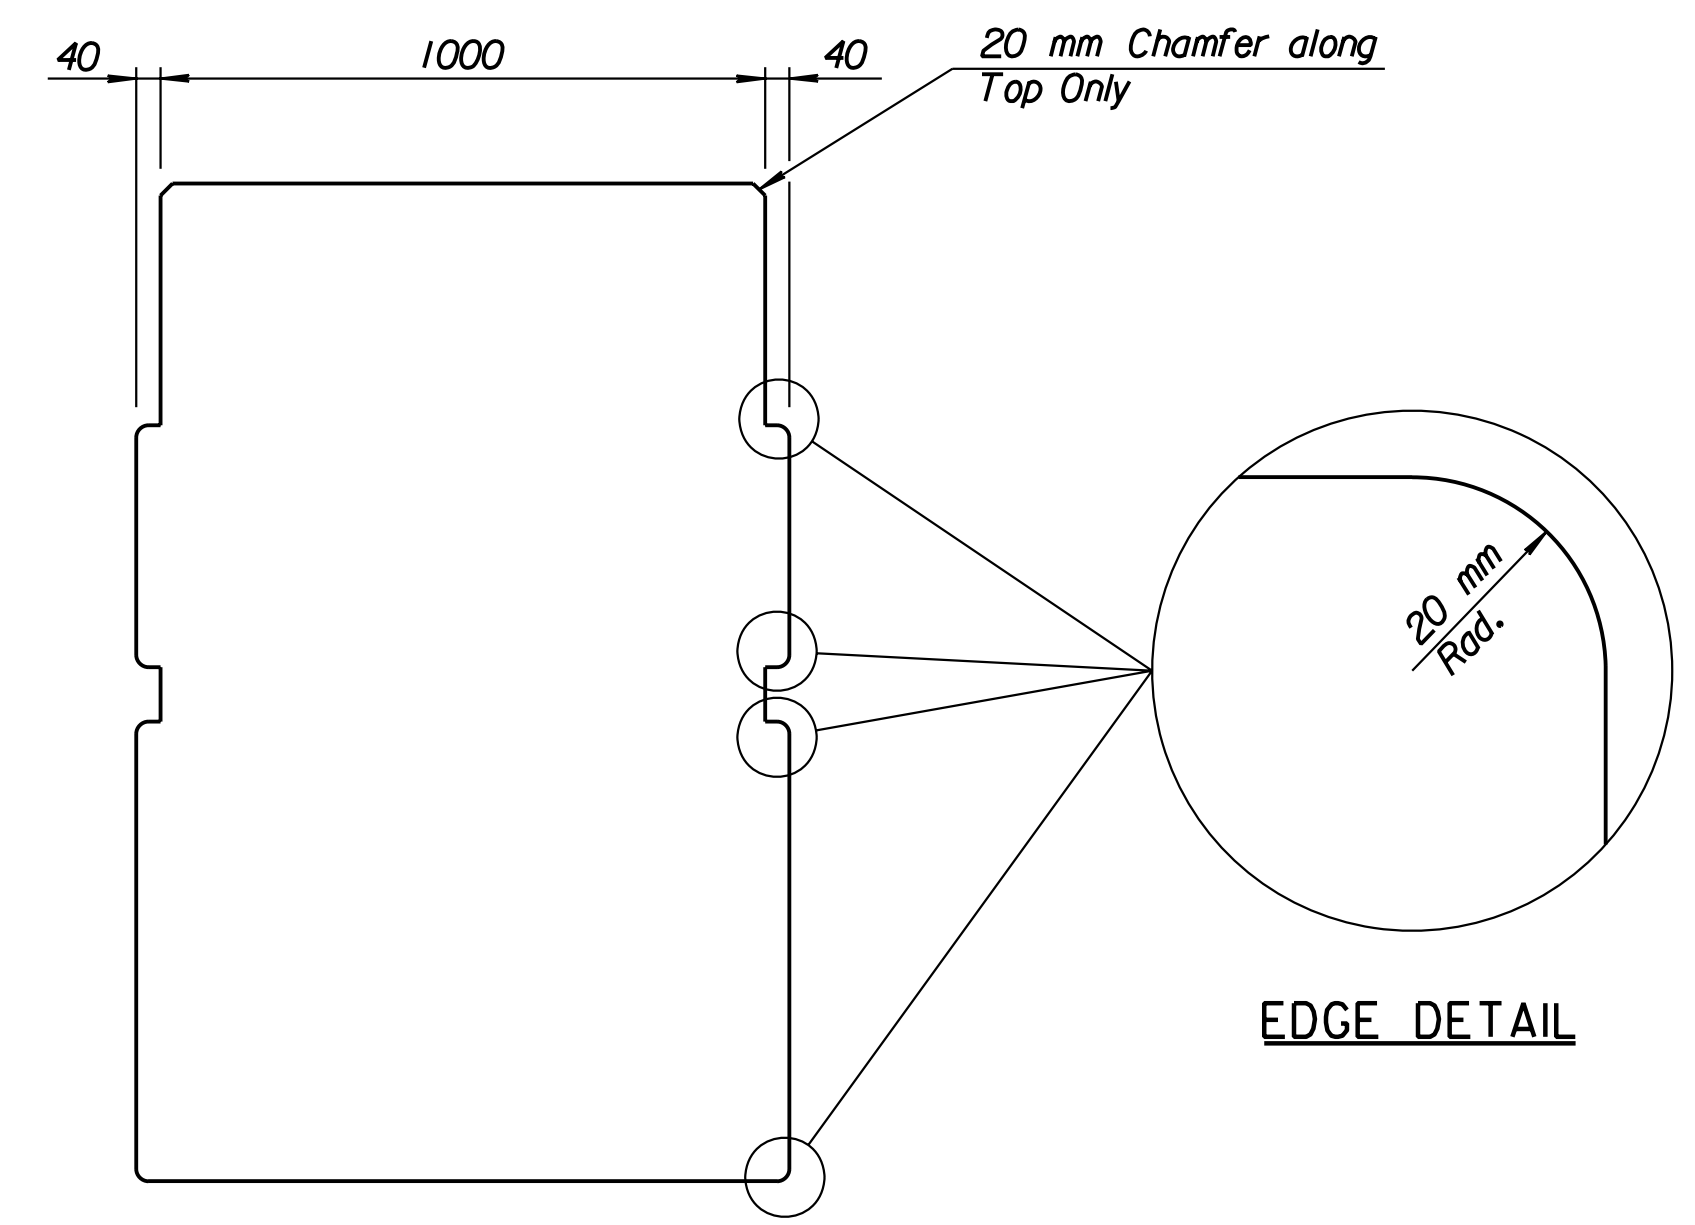

SECTION A-A

EDGE DETAIL

Drawn by: wll  
 Scale: 1/100  
 I:/1997/97362/As-Built/dgn/s/Vol\_3/Sh\_456-pier.dgn Last Rev: 8-30-07 By: gdr

RECORD DRAWING

No.	Revisions	By	Date
CITY OF WICHITA			
BR. NO. 54-87-19.05 (489) W.B.		STA. 15+612.397	
BR. NO. 54-87-19.06 (491) E.B.		STA. 15+612.397	
<b>PIER GEOMETRIC DIMENSIONS</b>			
KELLOGG (US-54)			
OVER MAIZE ROAD			
SEDGWICK COUNTY			
<b>Professional Engineering Consultants, P.A.</b>			
303 S. TOPEKA • WICHITA, KANSAS 67202			
316-262-2691 • FAX 316-262-3003			
Designed by	P.D.F.	Checked by	R.A.S.
Drawn by	W.L.L.	Date	April, 2002
		Job No.	97362