


STATE	PROJECT NO.	YEAR	SHEET NO.	TOTAL SHEETS
KANSAS	54-87 K-6657-01	2002	464	1122

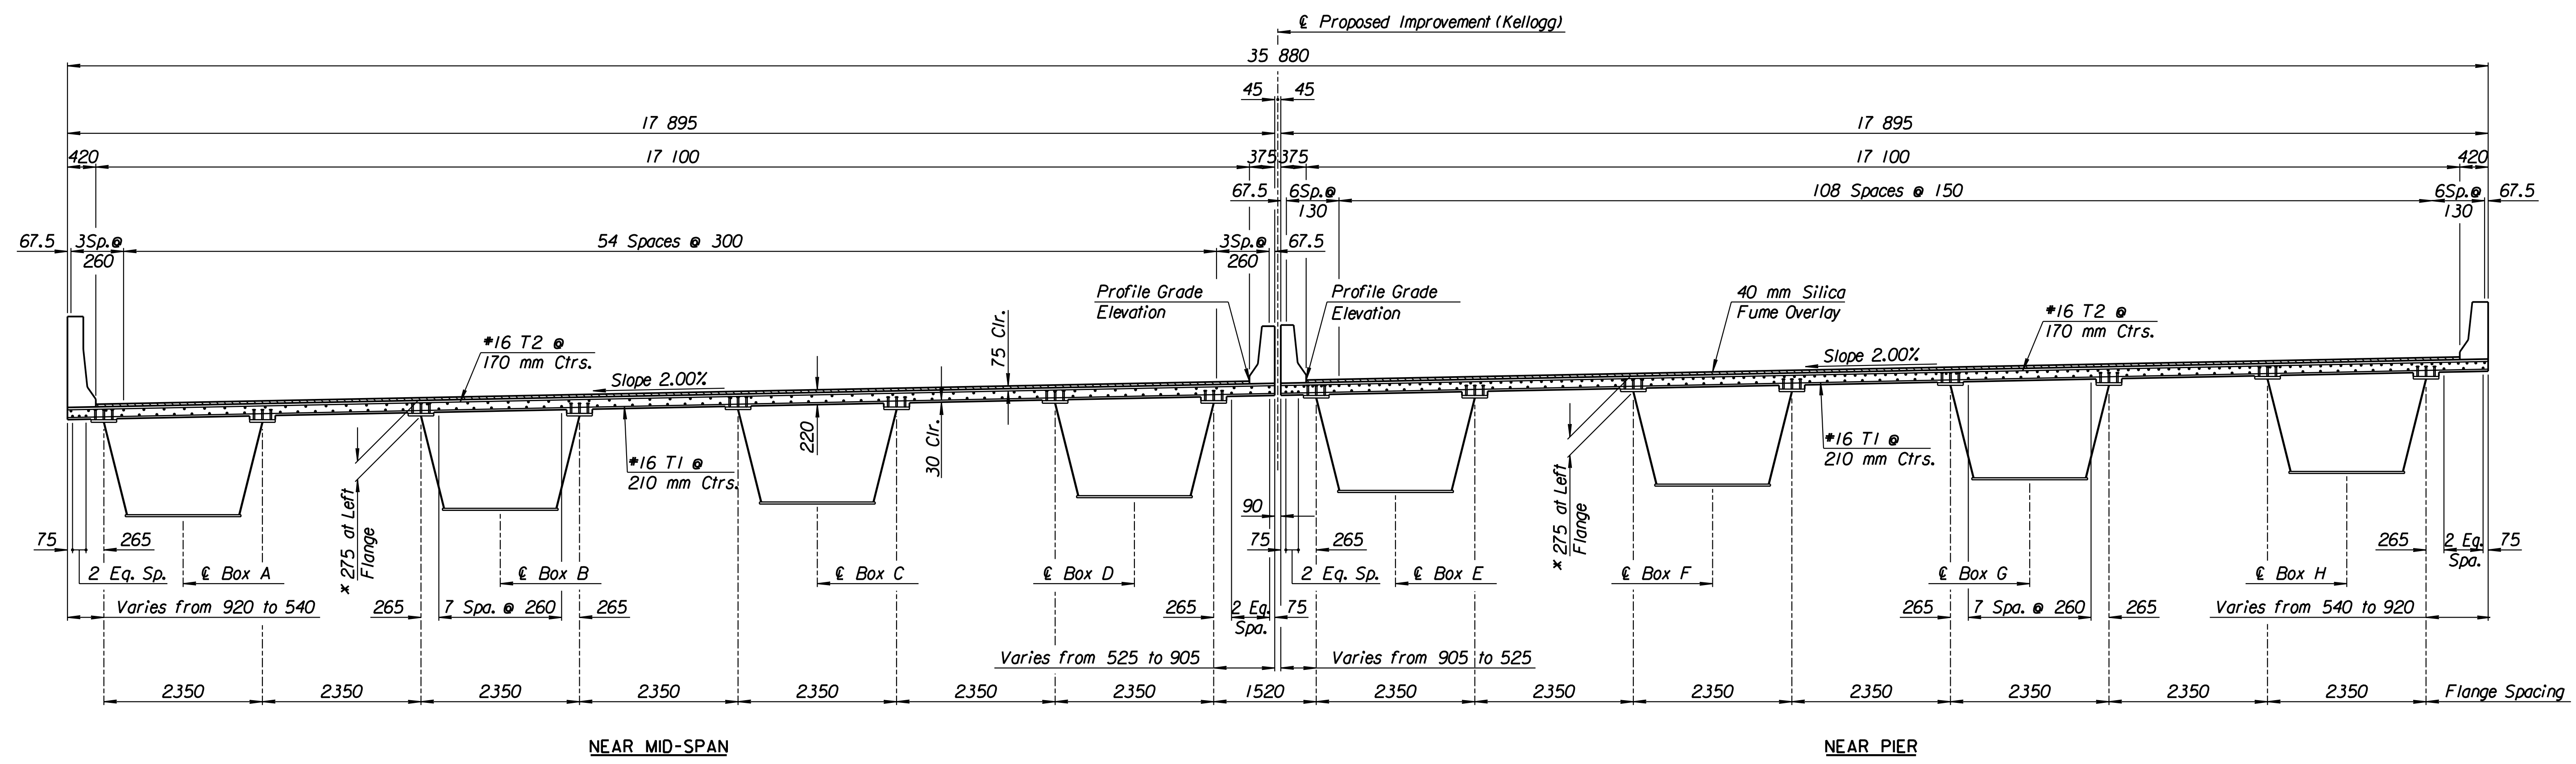

SECTION

* Note:
275 mm dimension is from the Top of Silica Fume Overlay to Top of Web.

Drawn by: wll
 Scale: 500
 I:/1997/97.362/As-Built/dgn/s/Vol_3/Sh_464-suptdet.dgn Last Rev: 8-31-07 By: ggr

RECORD DRAWING

No.	Revisions	By	Date
CITY OF WICHITA BR. NO. 54-87-19.05 (489) W.B. STA. 15+612.397 BR. NO. 54-87-19.06 (491) E.B. STA. 15+612.397 SUPERSTRUCTURE DETAILS KELLOGG (US-54) OVER MAIZE ROAD SEDGWICK COUNTY			
Professional Engineering Consultants, P.A. 303 S. TOPEKA • WICHITA, KANSAS 67202 316-262-2691 • FAX 316-262-3003			
Designed by	P.D.F.	Checked by	R.A.S.
Drawn by	W.L.L.	Date	April 2002 Job No. 97362