


STANDARD GEOLOGIC SYMBOLS			

SOUNDINGS	
	⊙ Elevation interpolated or from adjacent soundings
	○ Power auger
	○ Hand tools
	⊗ Air hammer
	▽ Dutch cone penetrometer
	⊙ Unconfined compression
	⊗ Standard penetration
	⊕ Water level

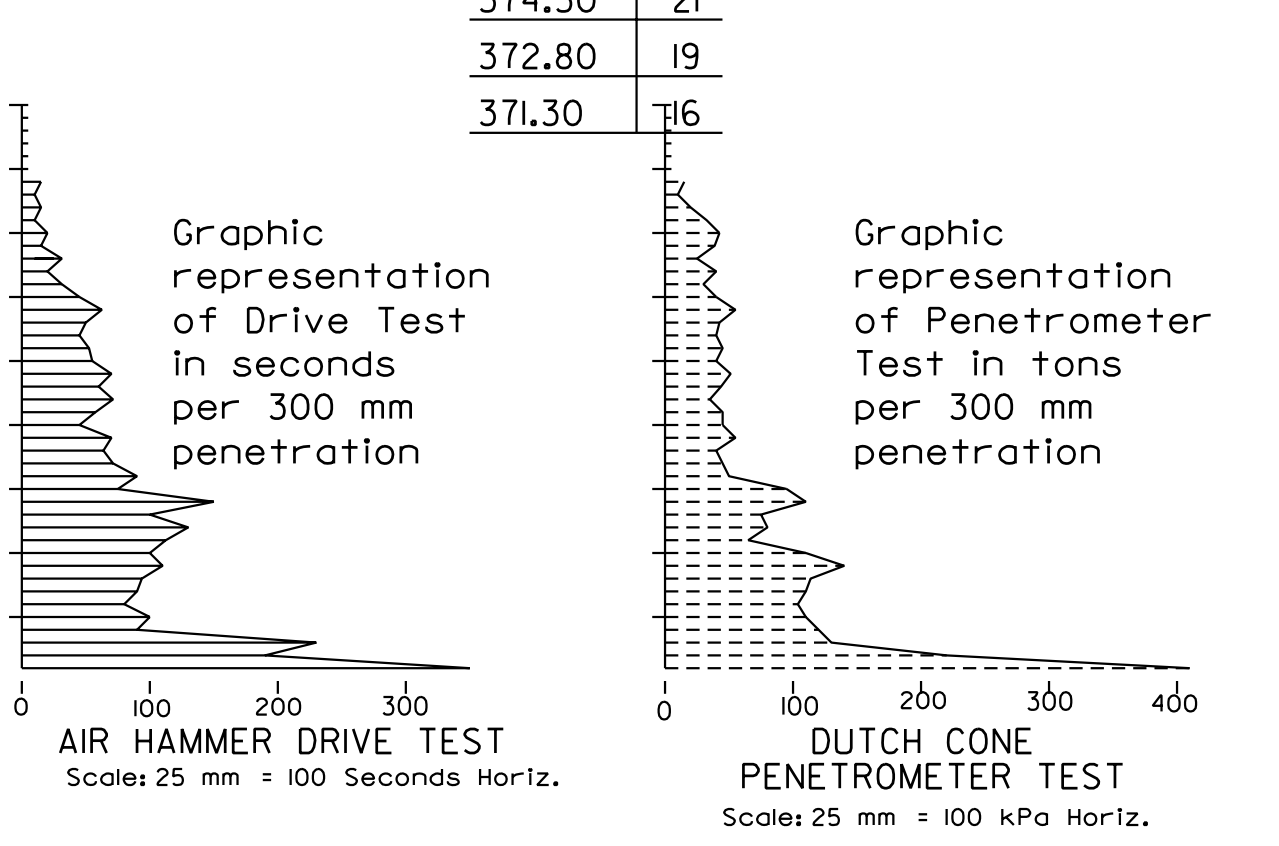

NOTE: The soundings shown on these plans are taken from notes obtained in the field and represent the best information available. The logs of these soundings are in the files of Allied Laboratories and are available at their offices at Wichita, Kansas for inspection by interested and qualified bidders.

Revisions		By	Date
CITY OF WICHITA			
BR. NO. 54-87-19.31(494) W.B.		STA. 16+011.650	
ENGINEERING GEOLOGY			
WEST BOUND KELLOGG (US-54)			
OVER COWSKIN CREEK			
SEDCWICK COUNTY			
Professional Engineering Consultants, P.A.			
303 S. TOPEKA • WICHITA, KANSAS 67202			
316-262-2691 • FAX 316-262-3003			
Designed by	R.A.S.	Checked by	R.A.S.
Drawn by	W.L.L.	Date	April, 2002
		Job No.	97362

RECORD DRAWING

SCALE: 1:200

i:\1997\97362\As-Builts\dgn\5\Sh 503-WBgeology.dgn
 Last Rev: 9-4-07 Ely: gdr
 drawn by : wil
 plotted by : gdr
 Sept. 07