



STATE	PROJECT NO.	YEAR	SHEET NO.	TOTAL SHEETS
KANSAS	54-87 K-6657-01	2002	506	1122

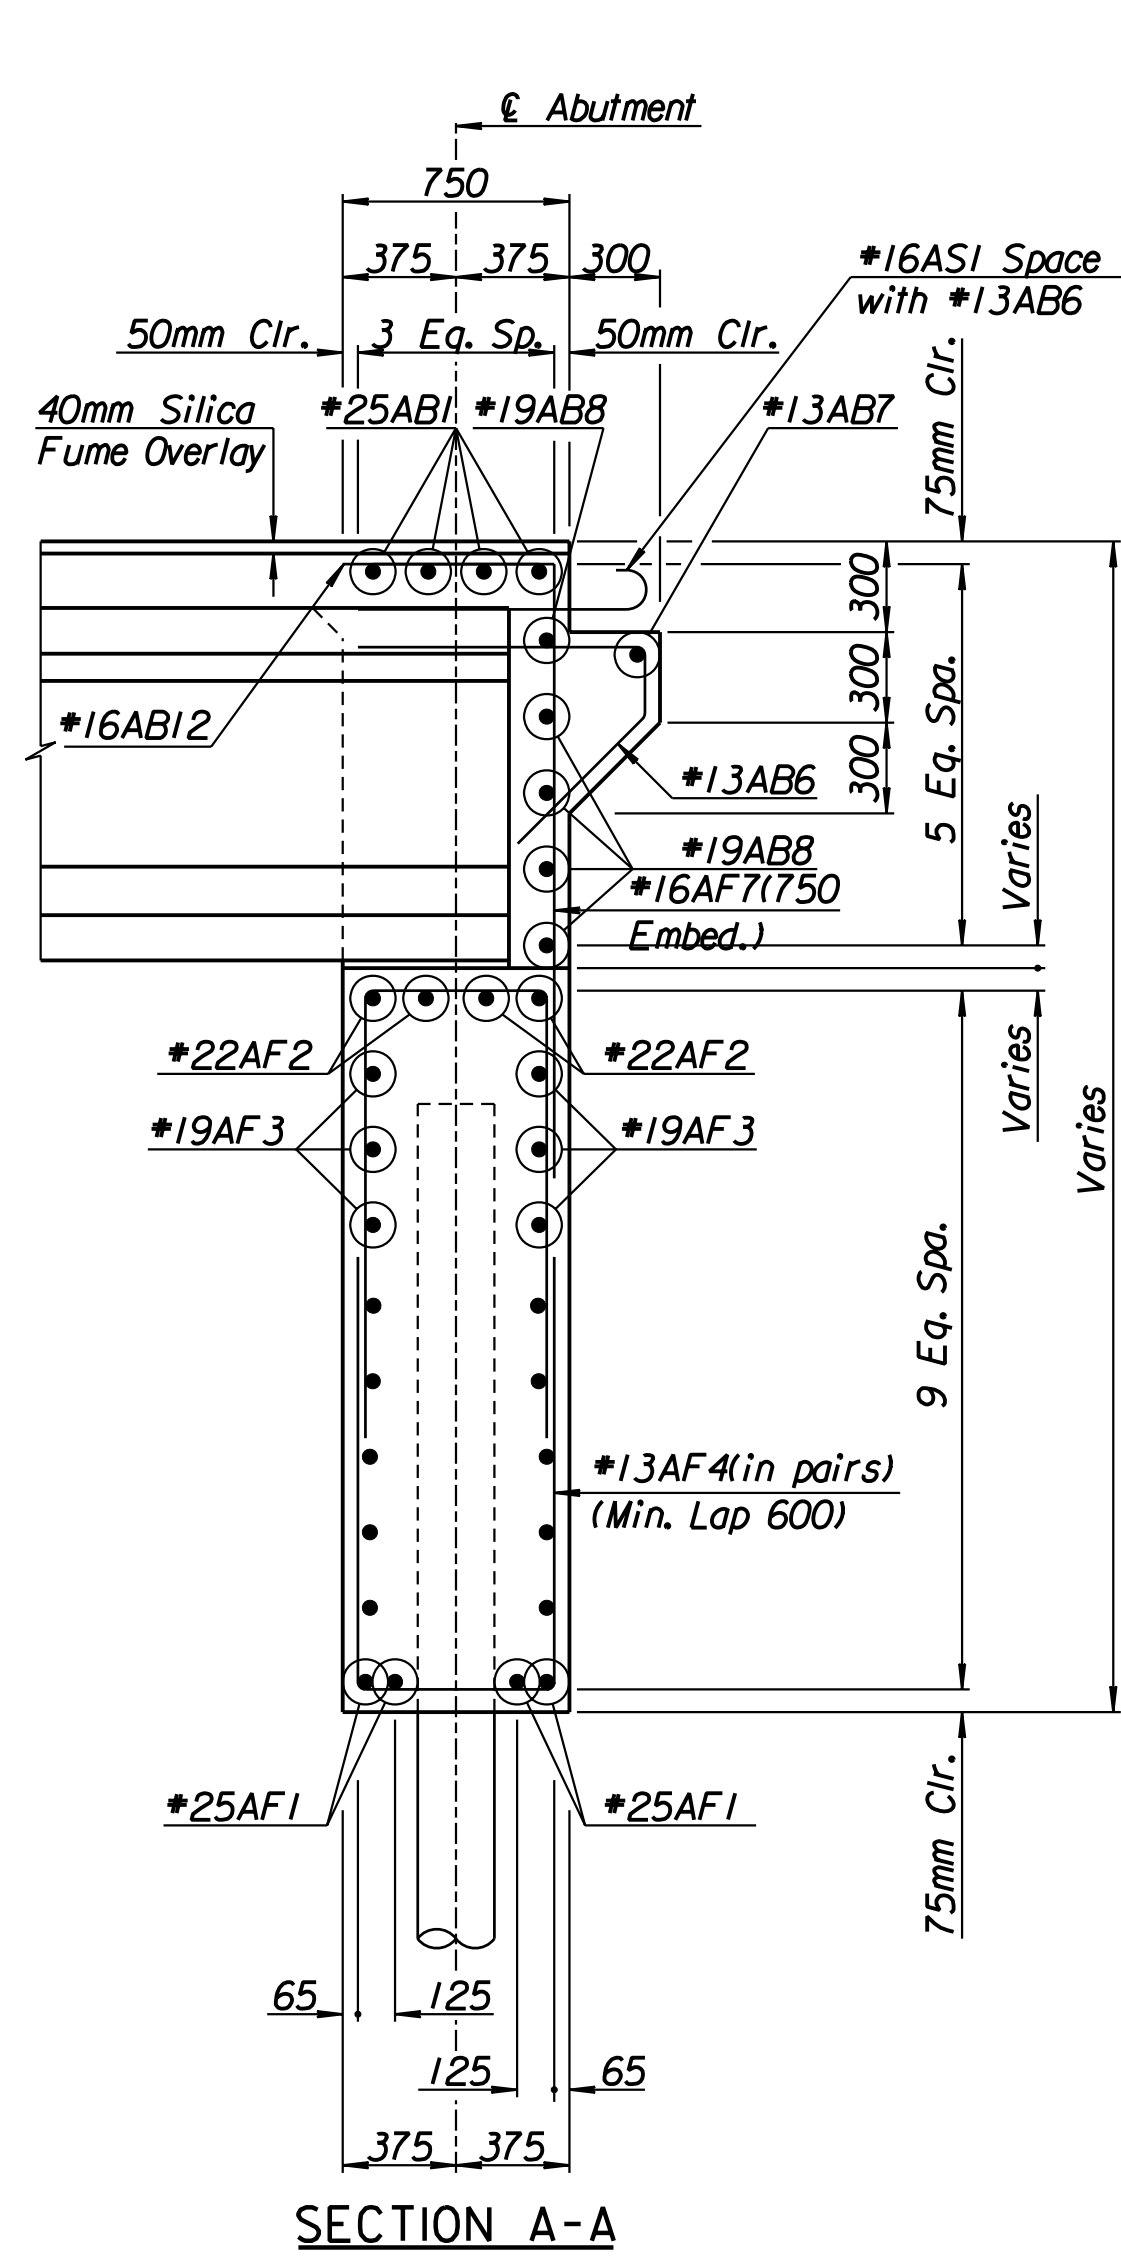


SECTION A-A

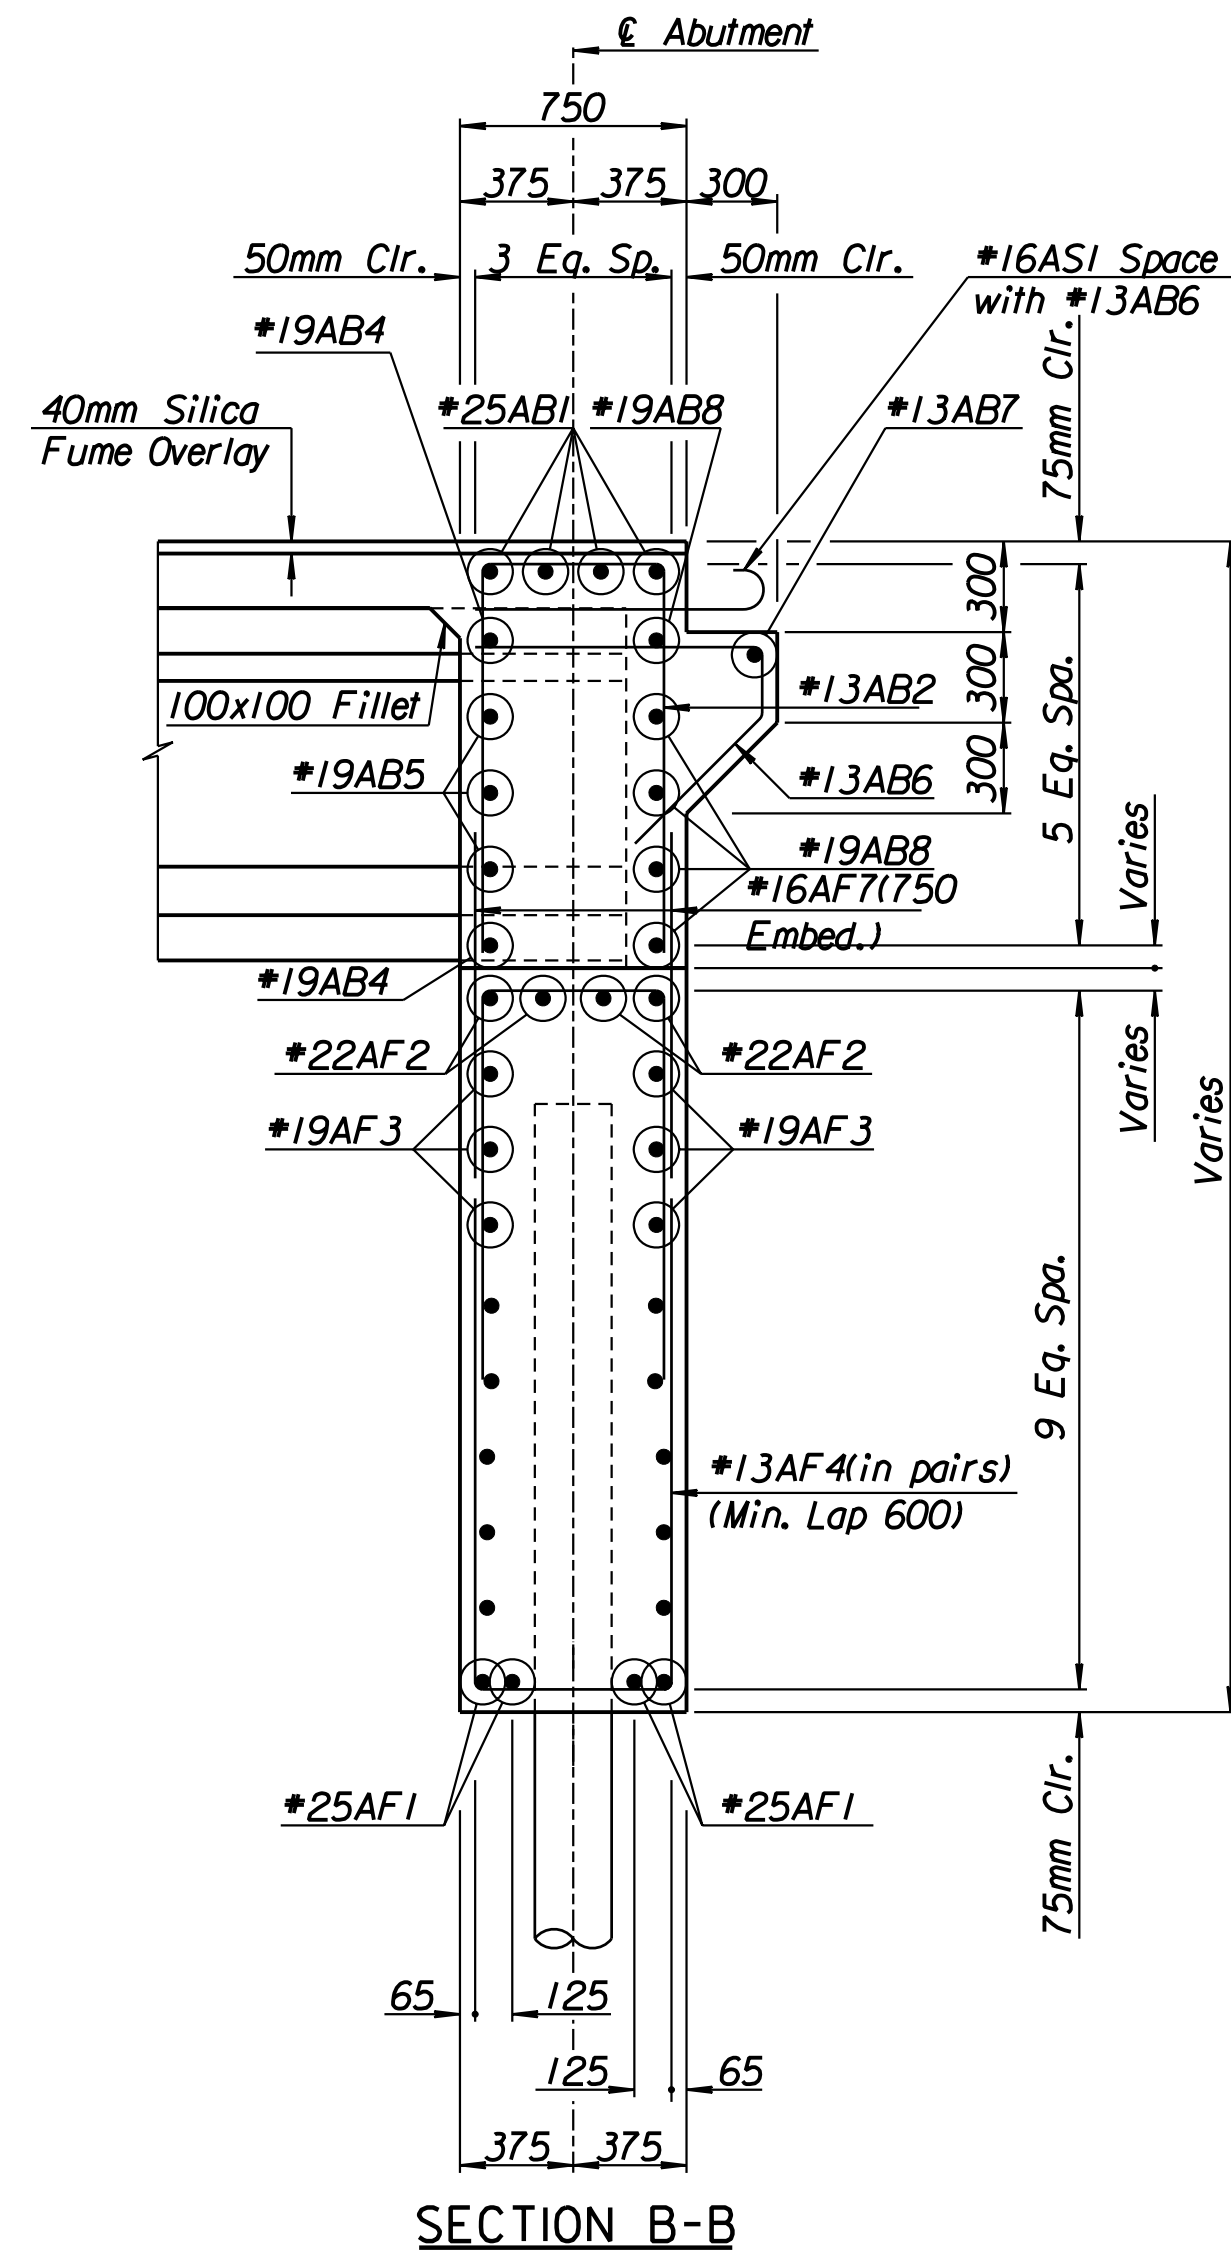

SECTION B-B

(See Framing Plan for Beam Embedment)

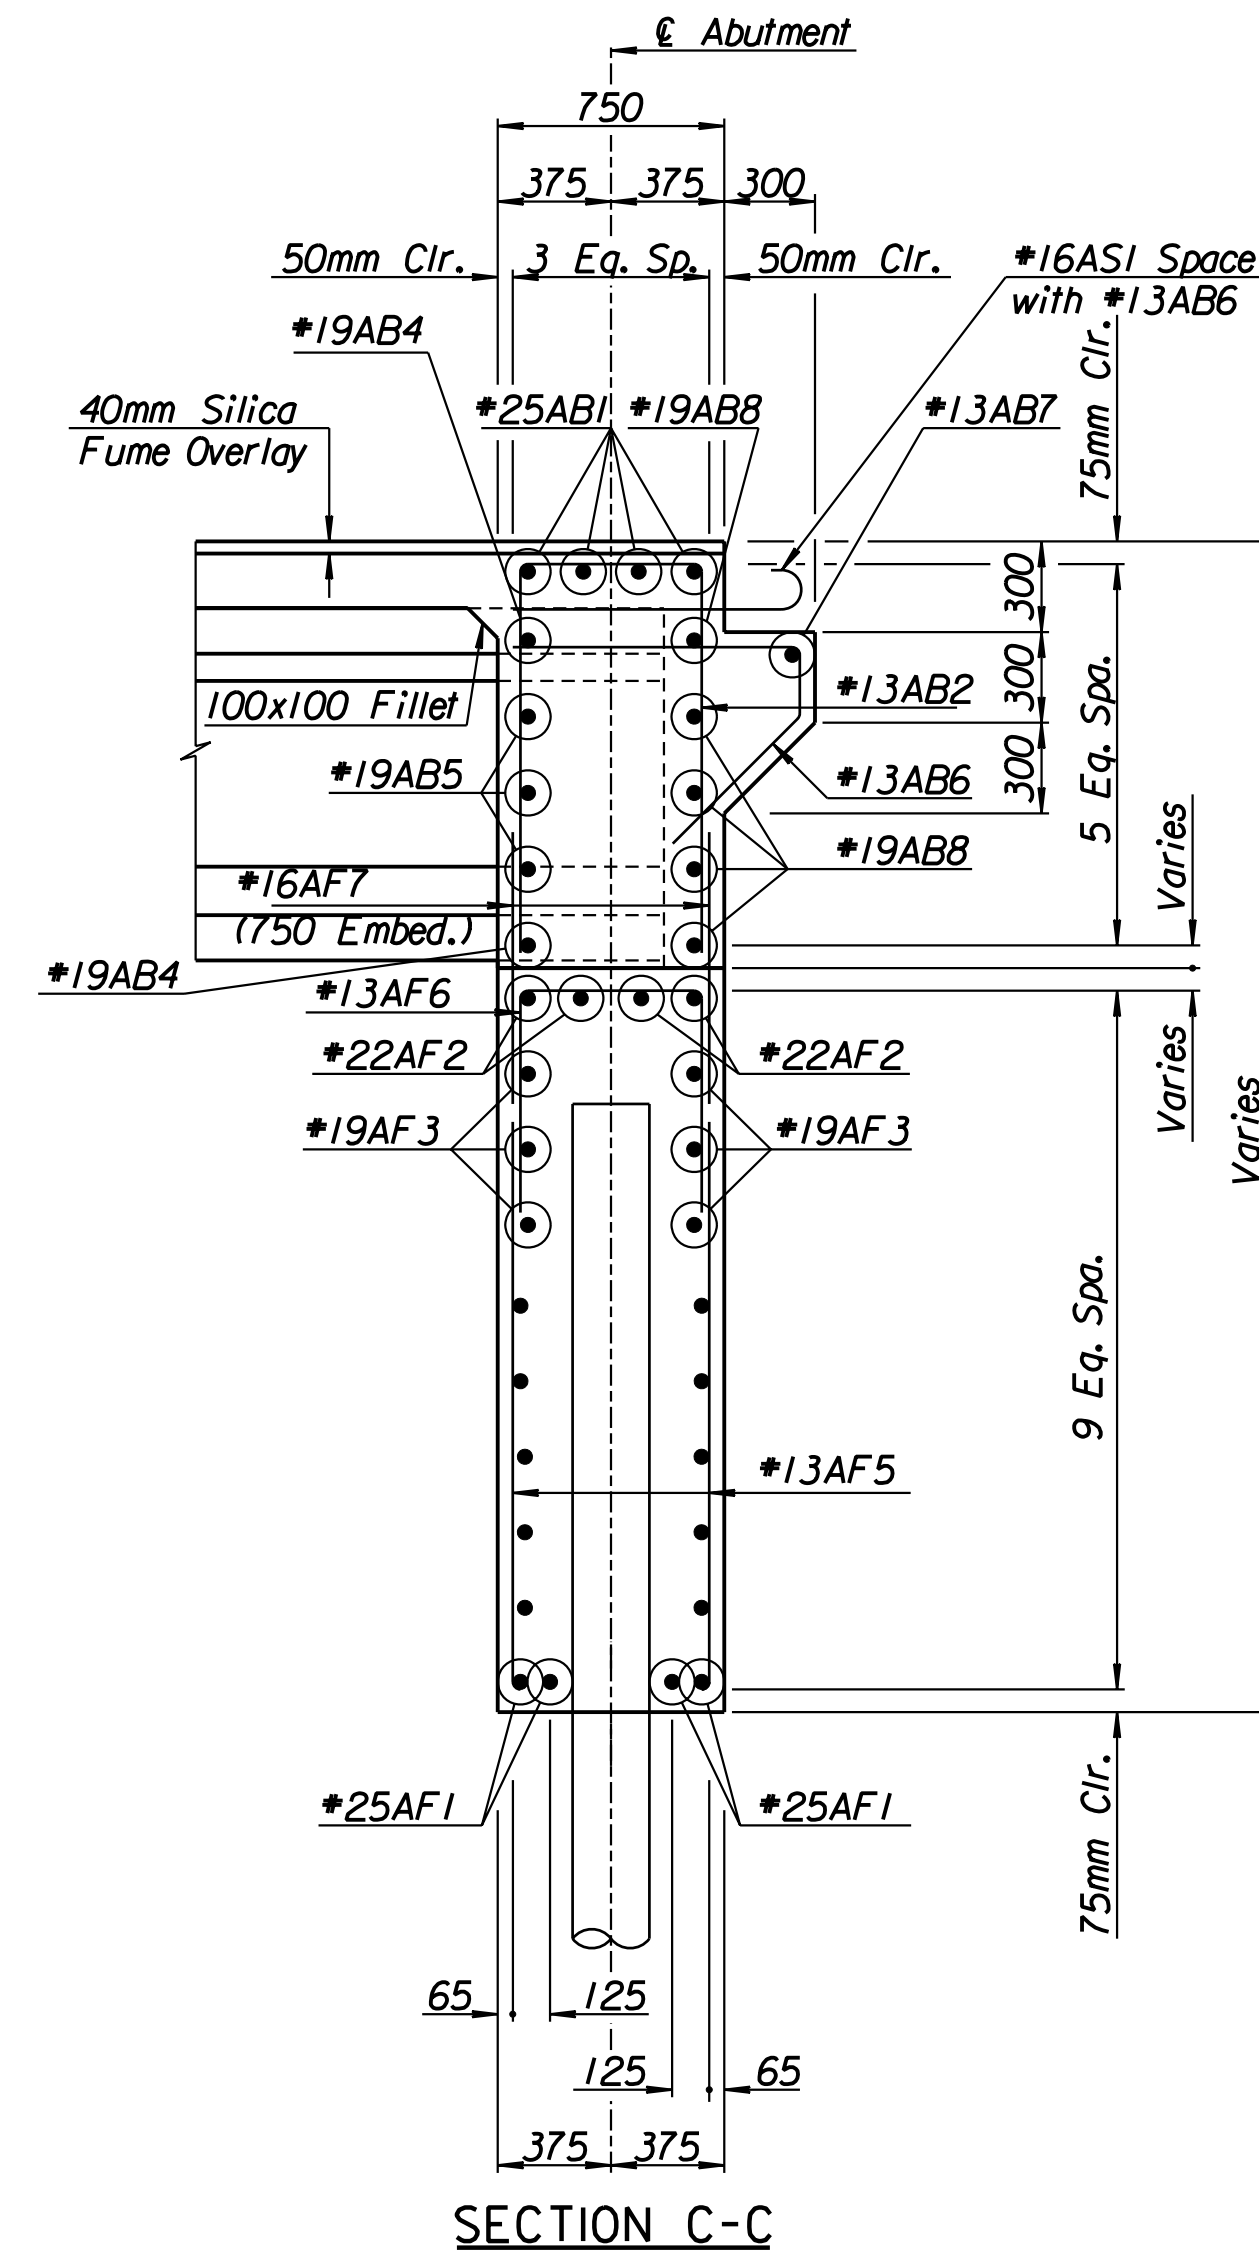

SECTION C-C

Drawn By: ros
 Plotted By: gdr
 I:/1997/97362/As-Builts/dgn's/Vol_3/Sh 506-abmt1wbml.dgn Last Rev: 9-4-07 By: gdr

RECORD DRAWING

No.	Revisions	By	Date
CITY OF WICHITA BR. NO. 54-87-19.3(494) W.B. STA. 16+011.650 WEST KELLOGG WESTBOUND MAINLINE OVER COWSKIN CREEK ABUTMENT NO. 1 DETAILS SEDGWICK COUNTY			
Professional Engineering Consultants, P.A. 303 S. TOPEKA • WICHITA, KANSAS 67202 316-262-2691 • FAX 316-262-3003			
Designed by	RAS	Checked by	RAS
Drawn by	RAS	Date	April, 2002 Job No. 97362