




STATE	PROJECT NO.	YEAR	SHEET NO.	TOTAL SHEETS
KANSAS	54-87 K-6657-01	2002	508	1122

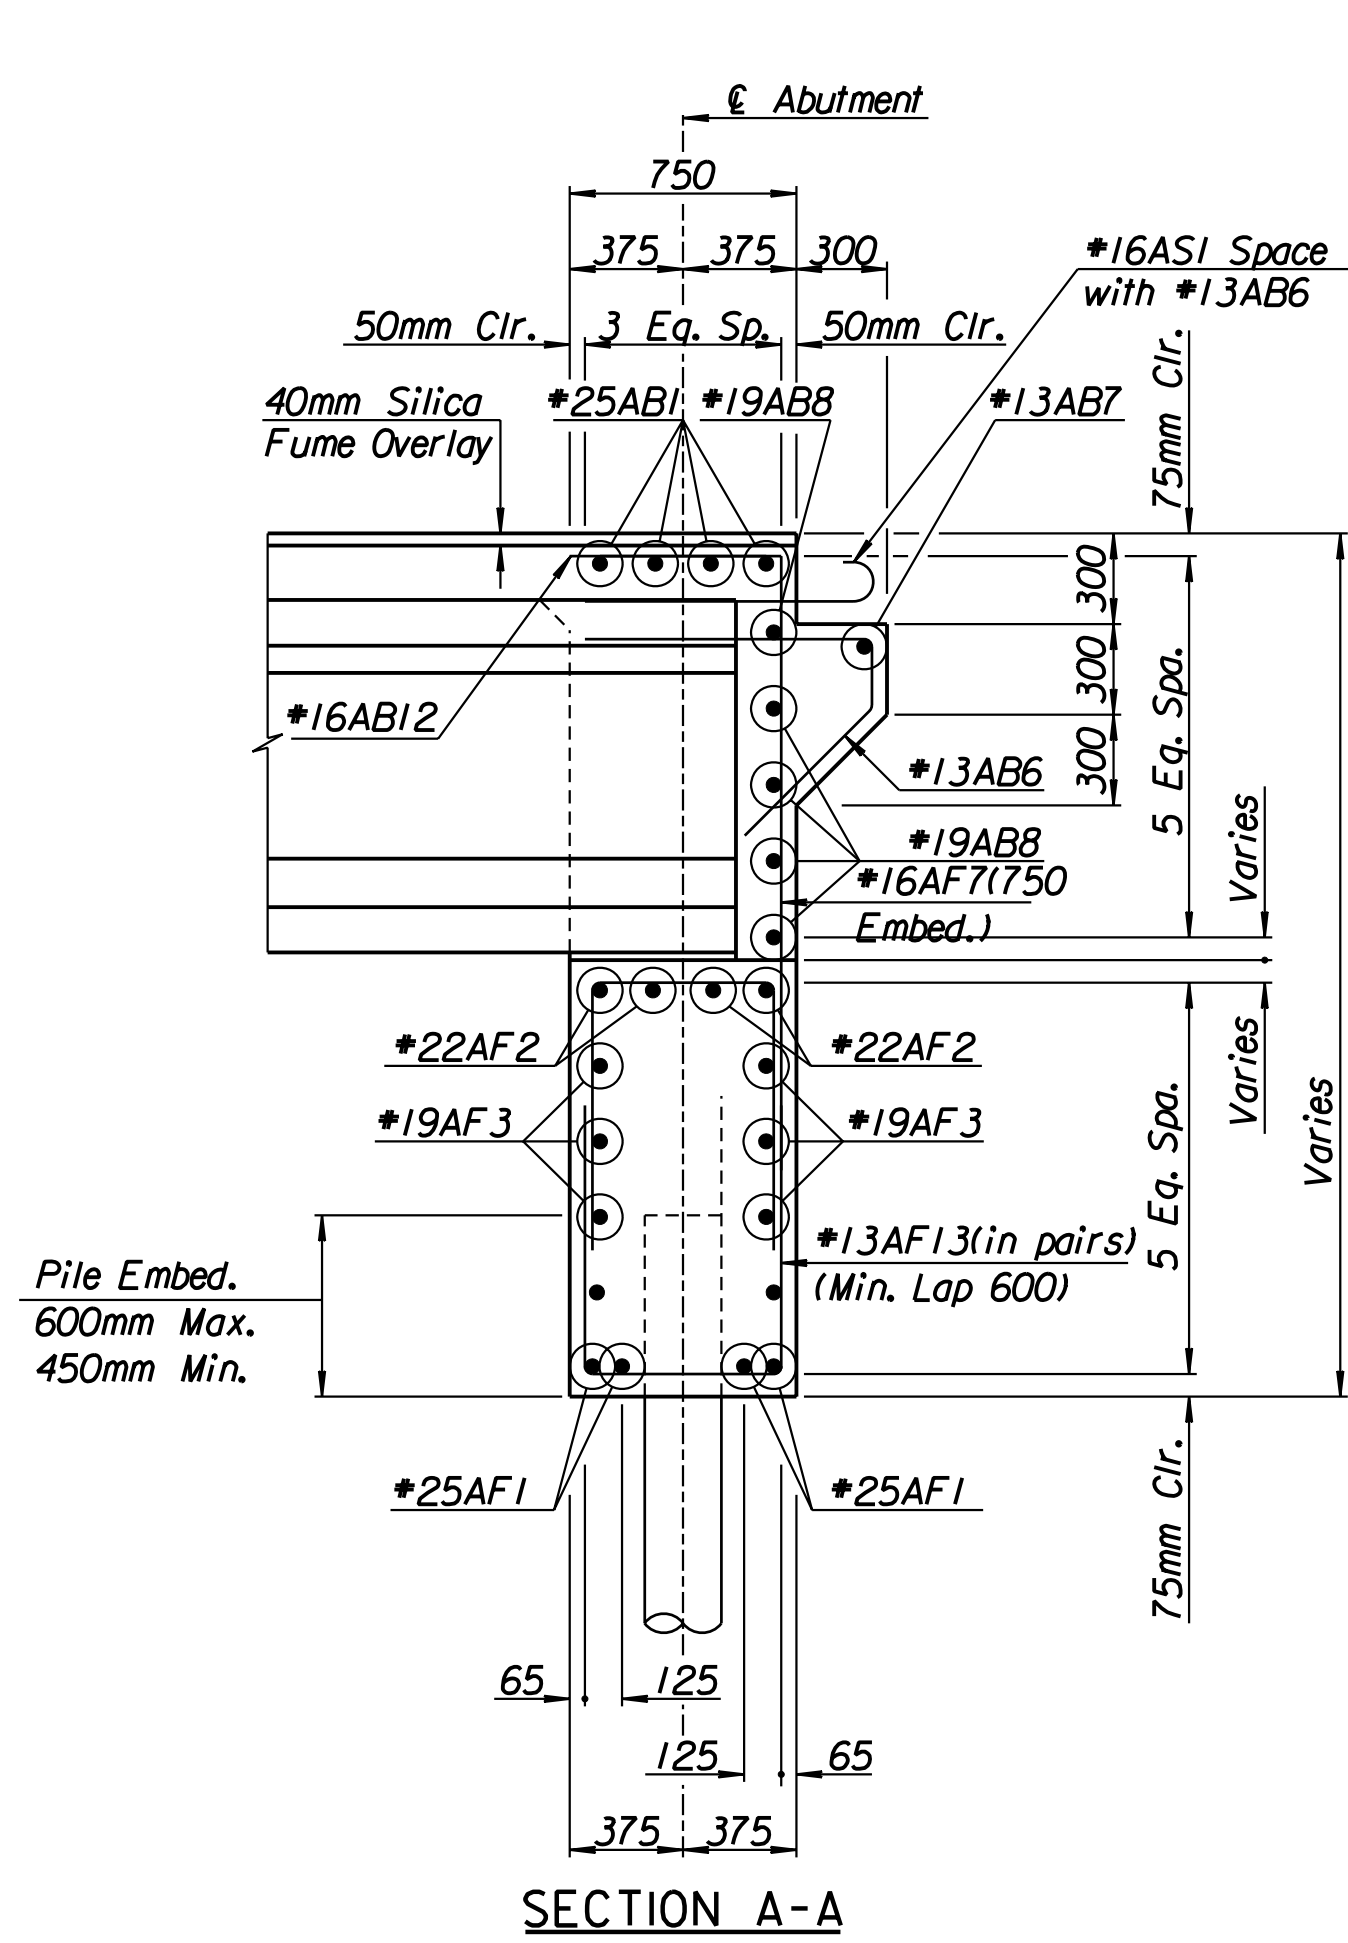

SECTION A-A

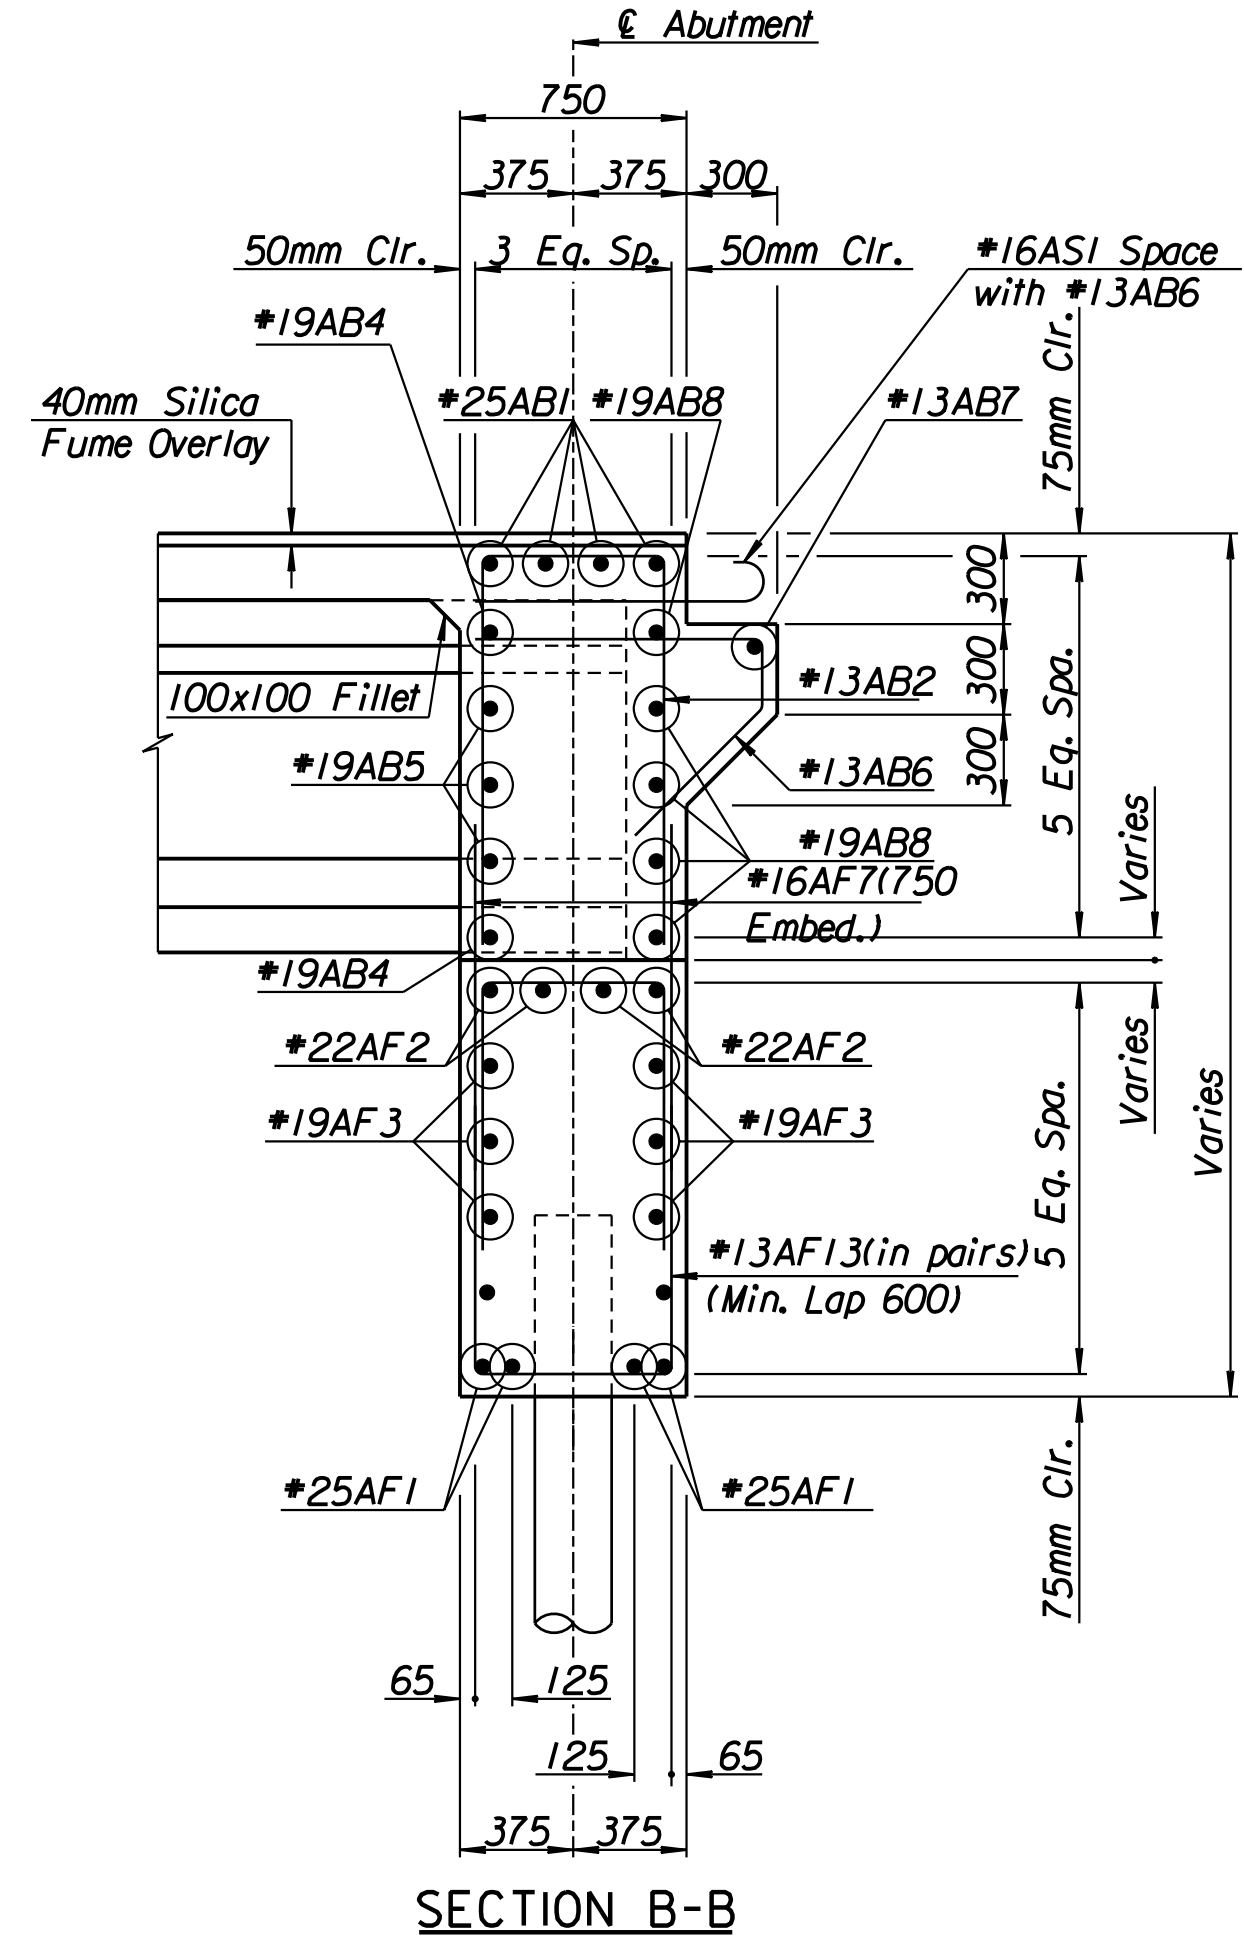

SECTION B-B

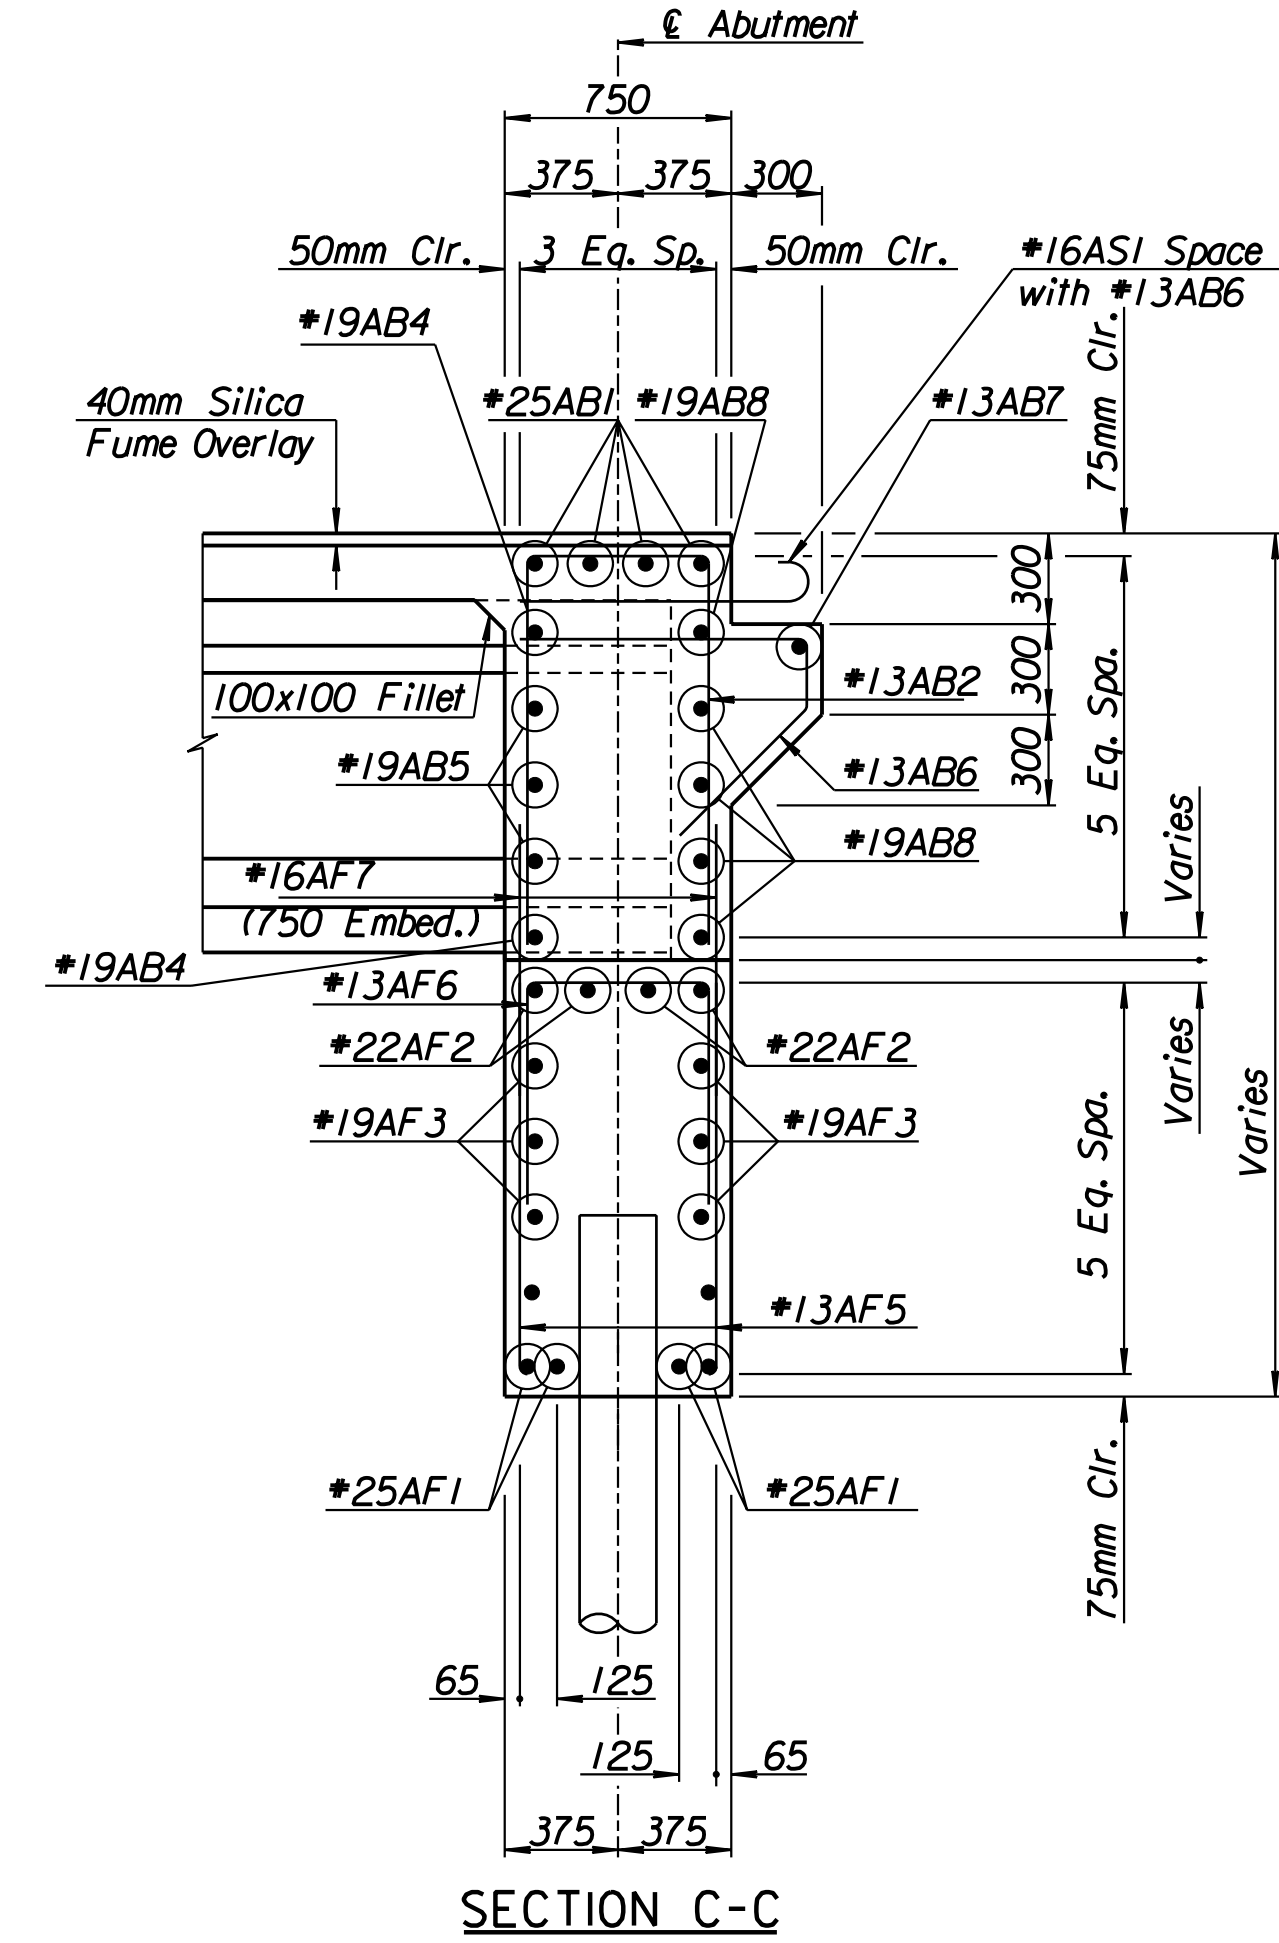


SECTION C-C

(See Framing Plan for Beam Embedment)

Drawn By: ros
 Plotted By: gdr
 i:/1997/97362/As-Builts/dgn's/Vol_3/Sh 508-abmt2wbml.dgn Last Rev: 9-4-07 By: gdr

RECORD DRAWING

No.	Revisions	By	Date
CITY OF WICHITA			
BR. NO. 54-87-19.3(494) W.B.		STA. 16+011.650	
WEST KELLOGG WESTBOUND MAINLINE OVER COWSKIN CREEK ABUTMENT NO. 2 DETAILS			
SEDGWICK COUNTY			
 Professional Engineering Consultants, P.A. 303 S. TOPEKA • WICHITA, KANSAS 67202 316-262-2691 • FAX 316-262-3003			
Designed by	RAS	Checked by	RAS
Drawn by	RAS	Date	April, 2002
		Job No.	97362