
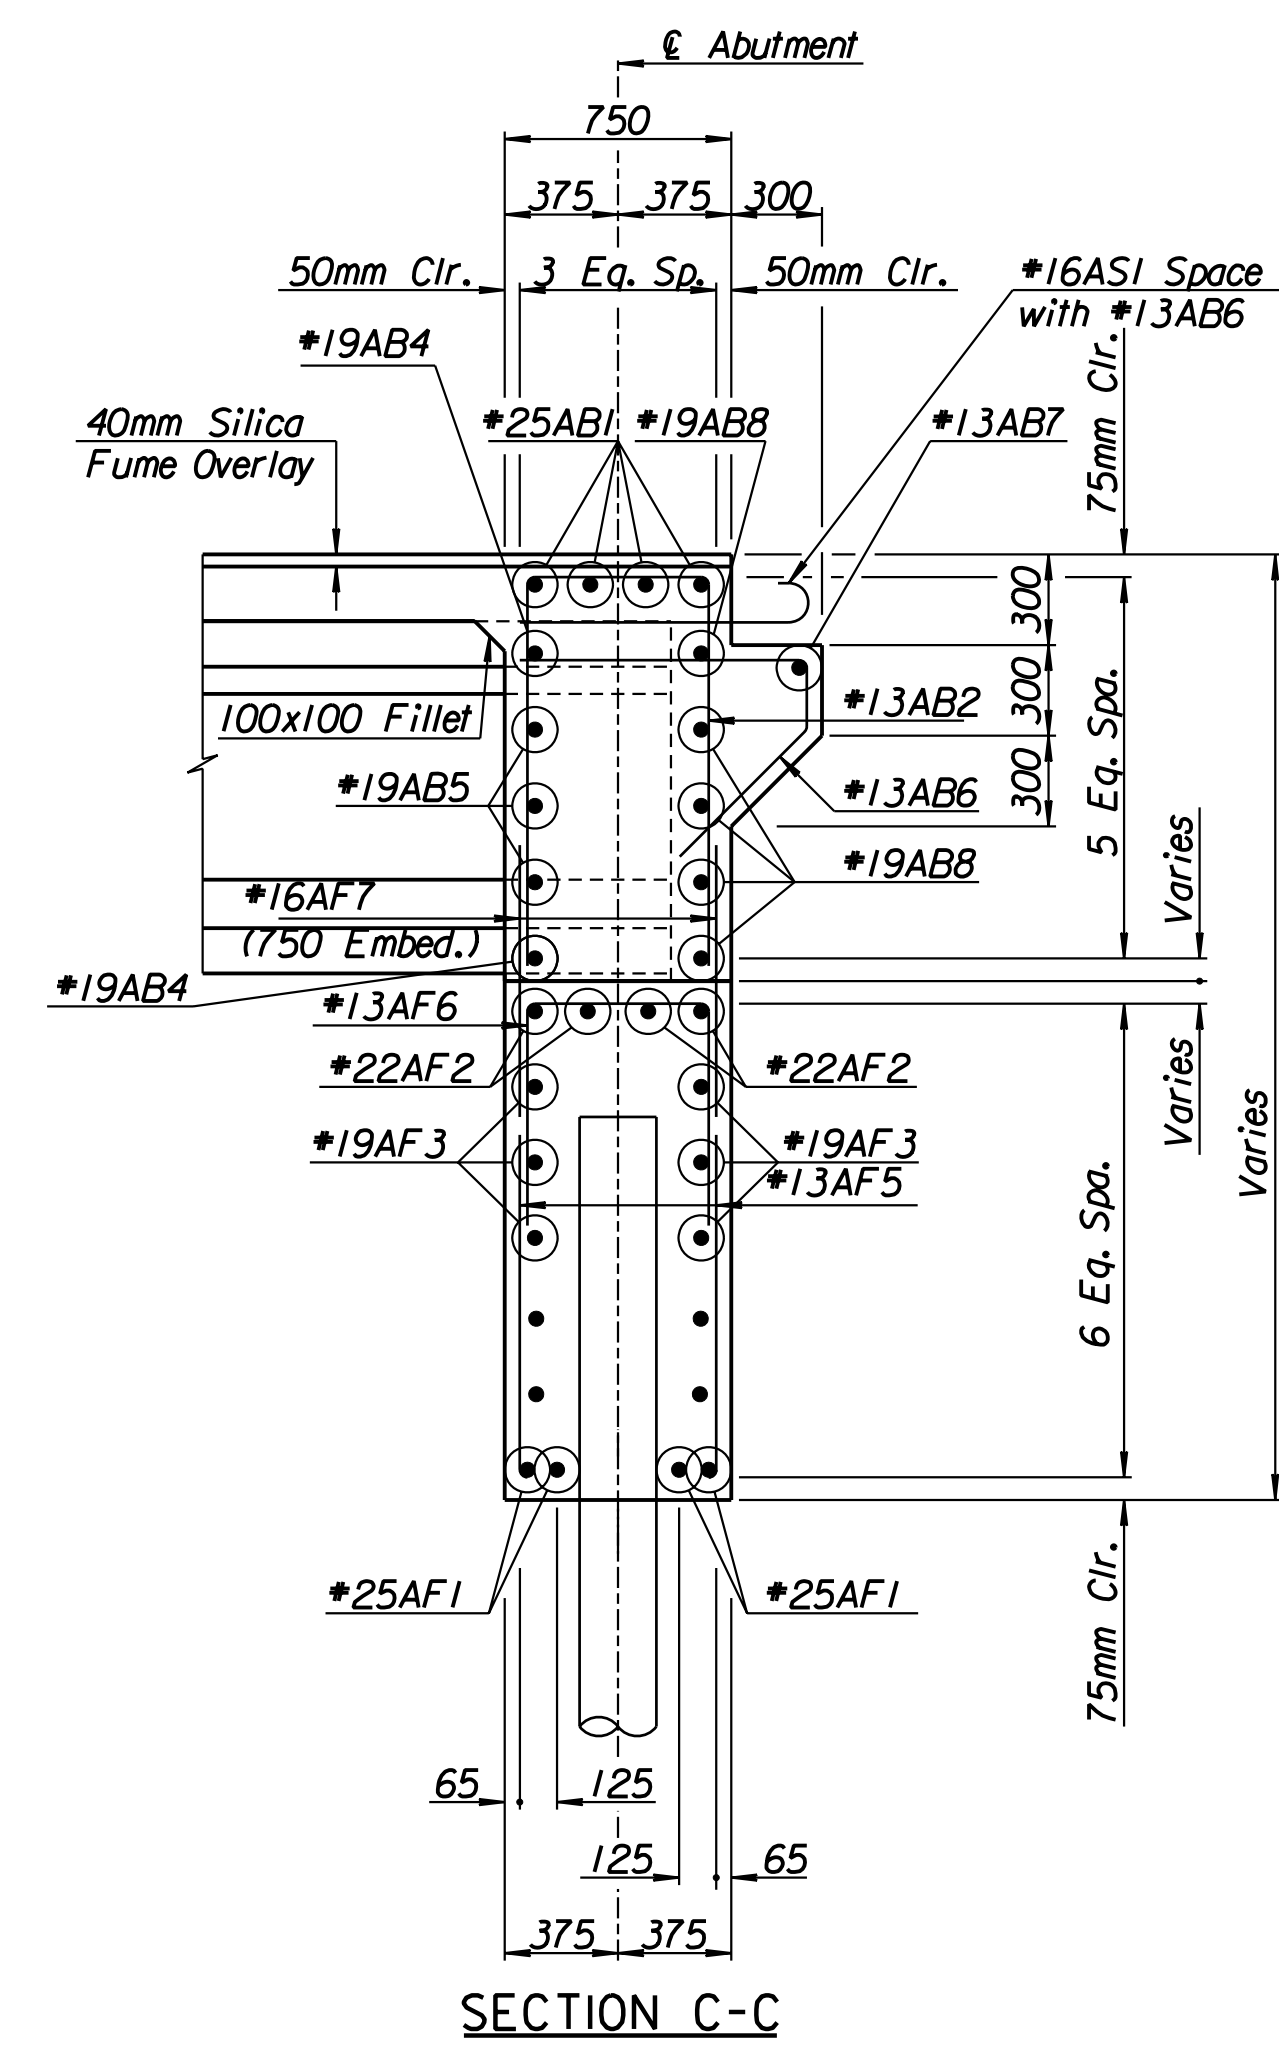
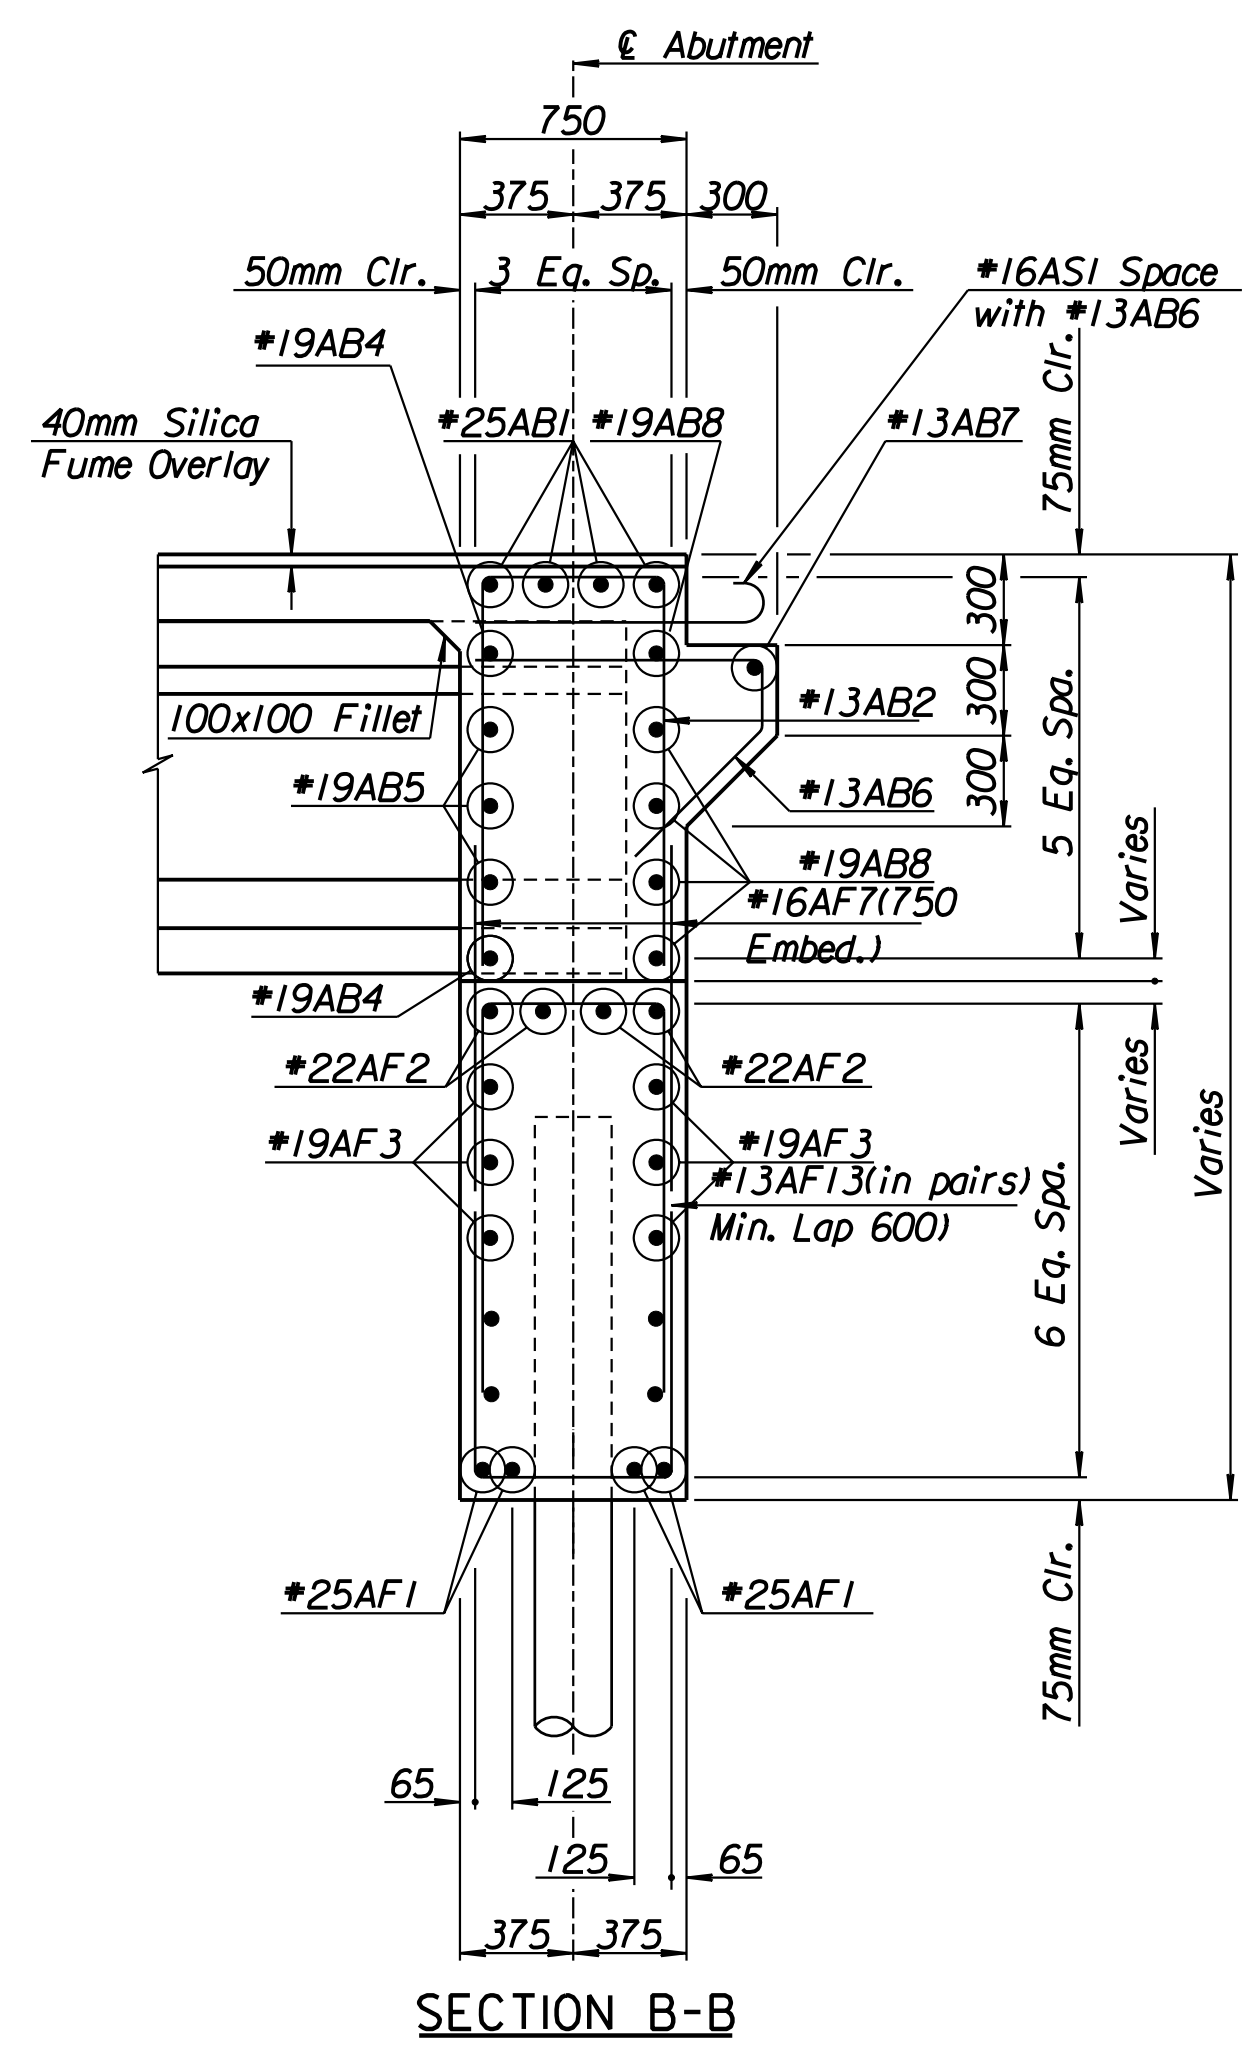


STATE	PROJECT NO.	YEAR	SHEET NO.	TOTAL SHEETS
KANSAS	54-87 K-6657-01	2002	5/2	1/22

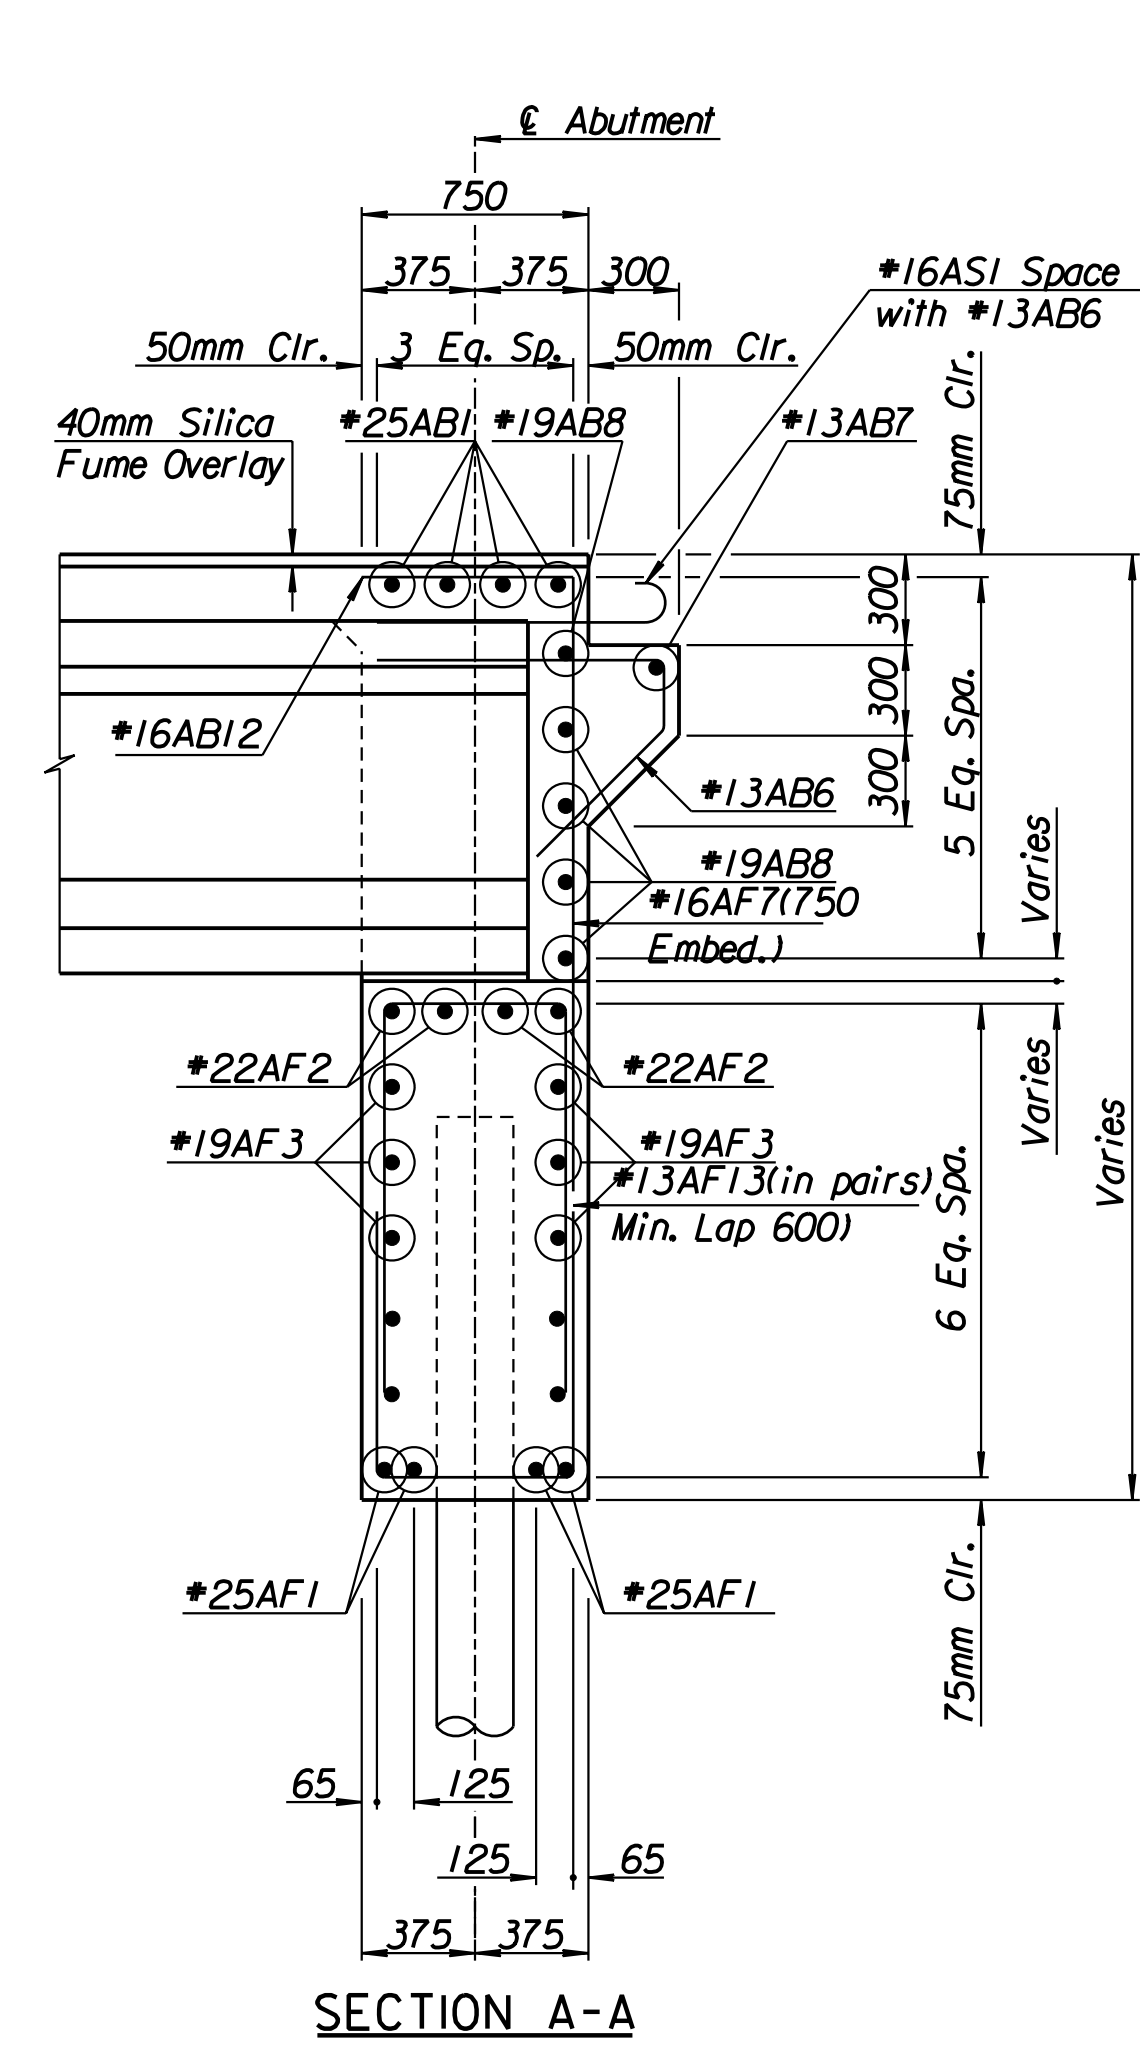

(See Framing Plan for Beam Embedment)

Drawn By: ros  
 Plotted By: gdr  
 i:/1997/97362/As-Builts/dgn's/Vol\_3/Sh 512-abmt2ebml.dgn Last Rev: 9-4-07 By: gdr

**RECORD DRAWING**

No.	Revisions	By	Date
CITY OF WICHITA BR. NO. 54-87-19.30(493) E.B. STA. 16+011.650 WEST KELLOGG EASTBOUND MAINLINE OVER COWSKIN CREEK <b>ABUTMENT NO. 2 DETAILS</b> SEDGWICK COUNTY			
<b>Professional Engineering Consultants, P.A.</b> 303 S. TOPEKA • WICHITA, KANSAS 67202 316-262-2691 • FAX 316-262-3003			
Designed by	R.A.S.	Checked by	R.A.S.
Drawn by	R.A.S.	Date	April, 2002
		Job No.	97362