
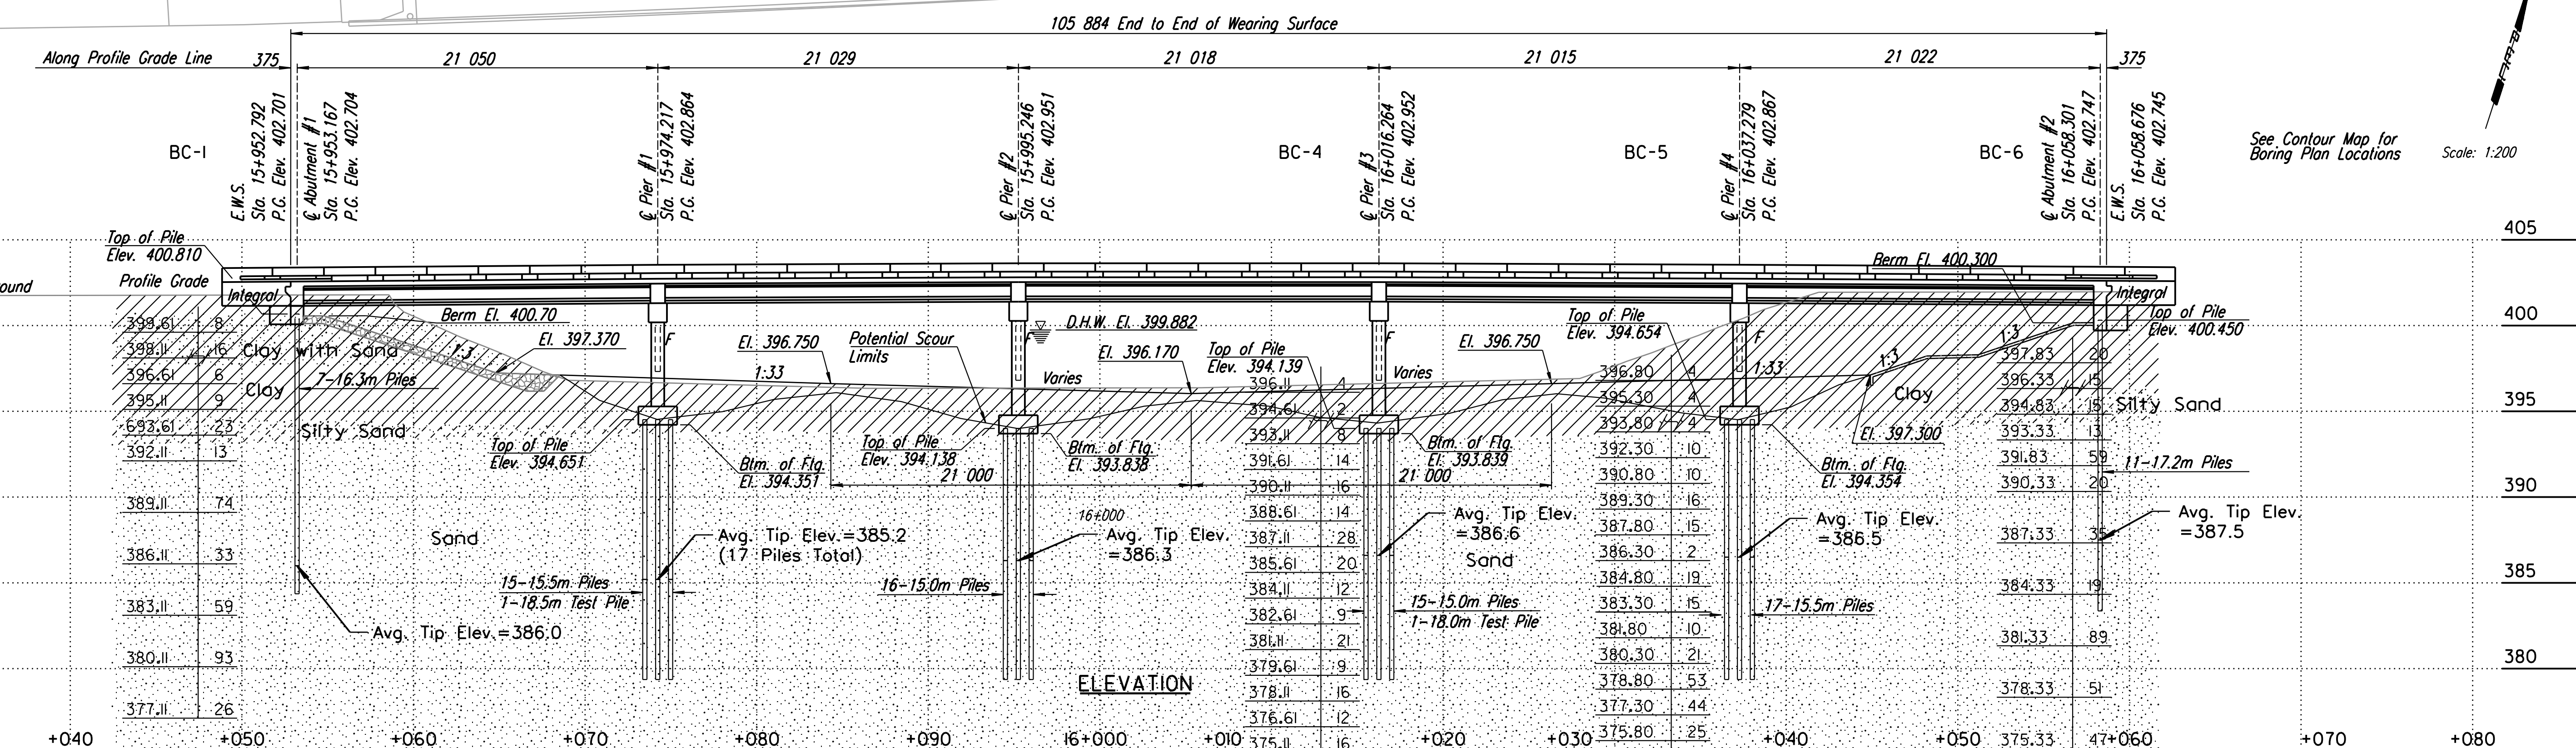


STATE	PROJECT NO.	YEAR	SHEET NO.	TOTAL SHEETS
KANSAS	54-87 K-6657-01	2002	535	1122

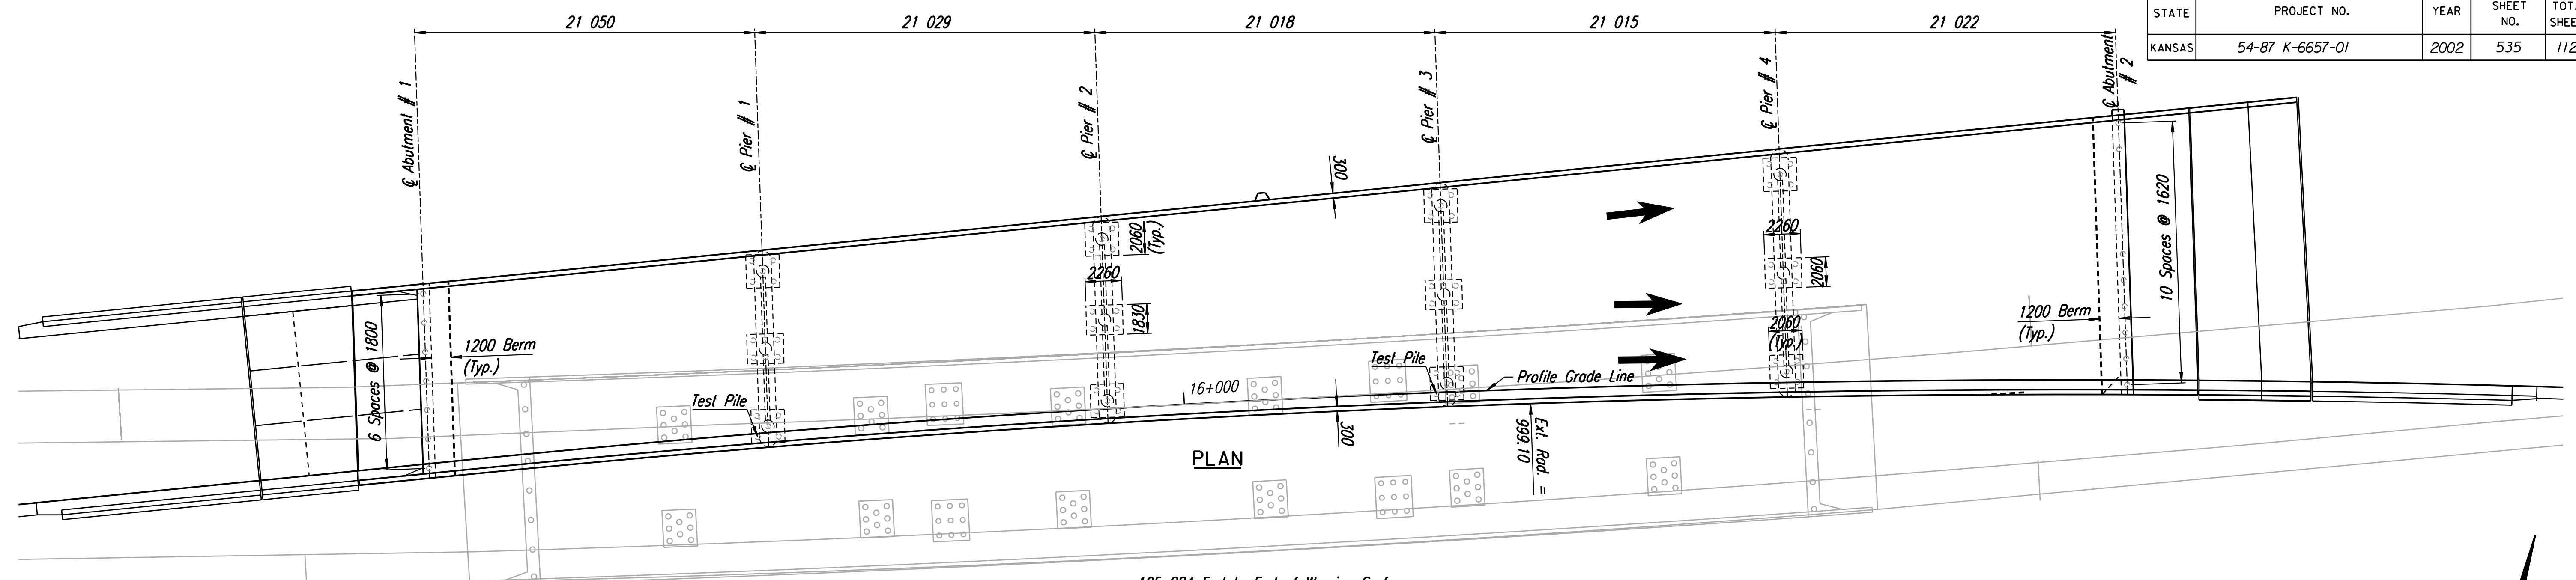

STANDARD GEOLOGIC SYMBOLS

SOUNDINGS


- ⊙ Coredrill
- ⊙ Power auger
- Hand tools
- ⊙ Air hammer
- ⊙ Dutch cone penetrometer
- ⊙ Unconfined compression
- ⊙ Standard penetration
- ⊙ Water level

LEGEND

- 1000.0 Elevation interpolated or from adjacent soundings
- 1000.0 Actual sounding elevation
- 1000.0 Drive started
- 1000.0 Refusal

TEST TYPES

- CASING DRIVE TEST
- UNCONFINED COMPRESSION TEST
- STANDARD PENETRATION TEST
- AIR HAMMER DRIVE TEST
- DUTCH CONE PENETROMETER TEST

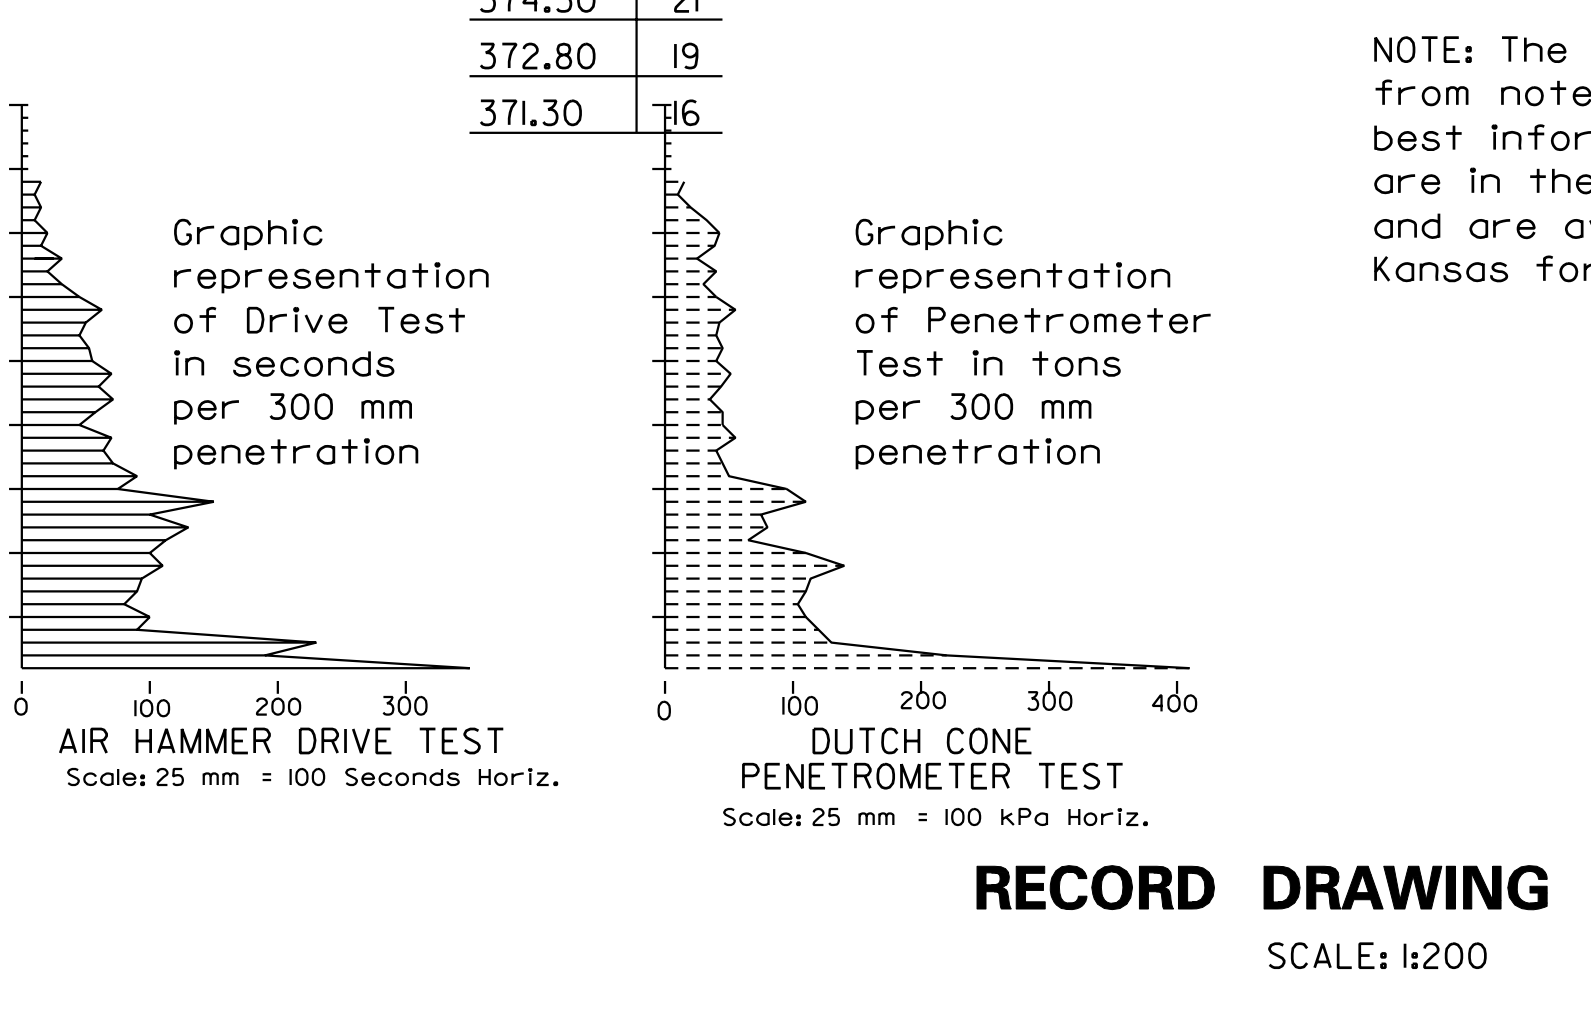

NOTE: The soundings shown on these plans are taken from notes obtained in the field and represent the best information available. The logs of these soundings are in the files of Allied Laboratories and are available at their offices at Wichita, Kansas for inspection by interested and qualified bidders.

Revisions		By	Date
CITY OF WICHITA			
BR. NO. 54-87-19.29 (492) F.E.B.		STA. 16+005.740	
ENGINEERING GEOLOGY			
E.B. FRT. RD. OVER COWSKIN CREEK			
SEDGWICK COUNTY			
Professional Engineering Consultants, P.A.			
303 S. TOPEKA • WICHITA, KANSAS 67202			
316-262-2691 • FAX 316-262-3003			
Designed by	R.A.S.	Checked by	R.A.S.
Drawn by	D.R.P.	Date	April, 2002
		Job No.	97362

RECORD DRAWING
SCALE: 1:200

i:\1997\97362\As-Builts\dgn\sh_3\sh_535-geology.dgn
 Last Rev. 9-5-07 By: gdr
 drawn by : drp
 plotted by : gdr
 Sept. 07