


STATE	PROJECT NO.	YEAR	SHEET NO.	TOTAL SHEETS
KANSAS	54-87 K-6657-01	2002	552	1122

106 052 E.W.S. to E.W.S. (measured along left edge of slab)

674-#13T7 bars @ 155 mm Ctrs.

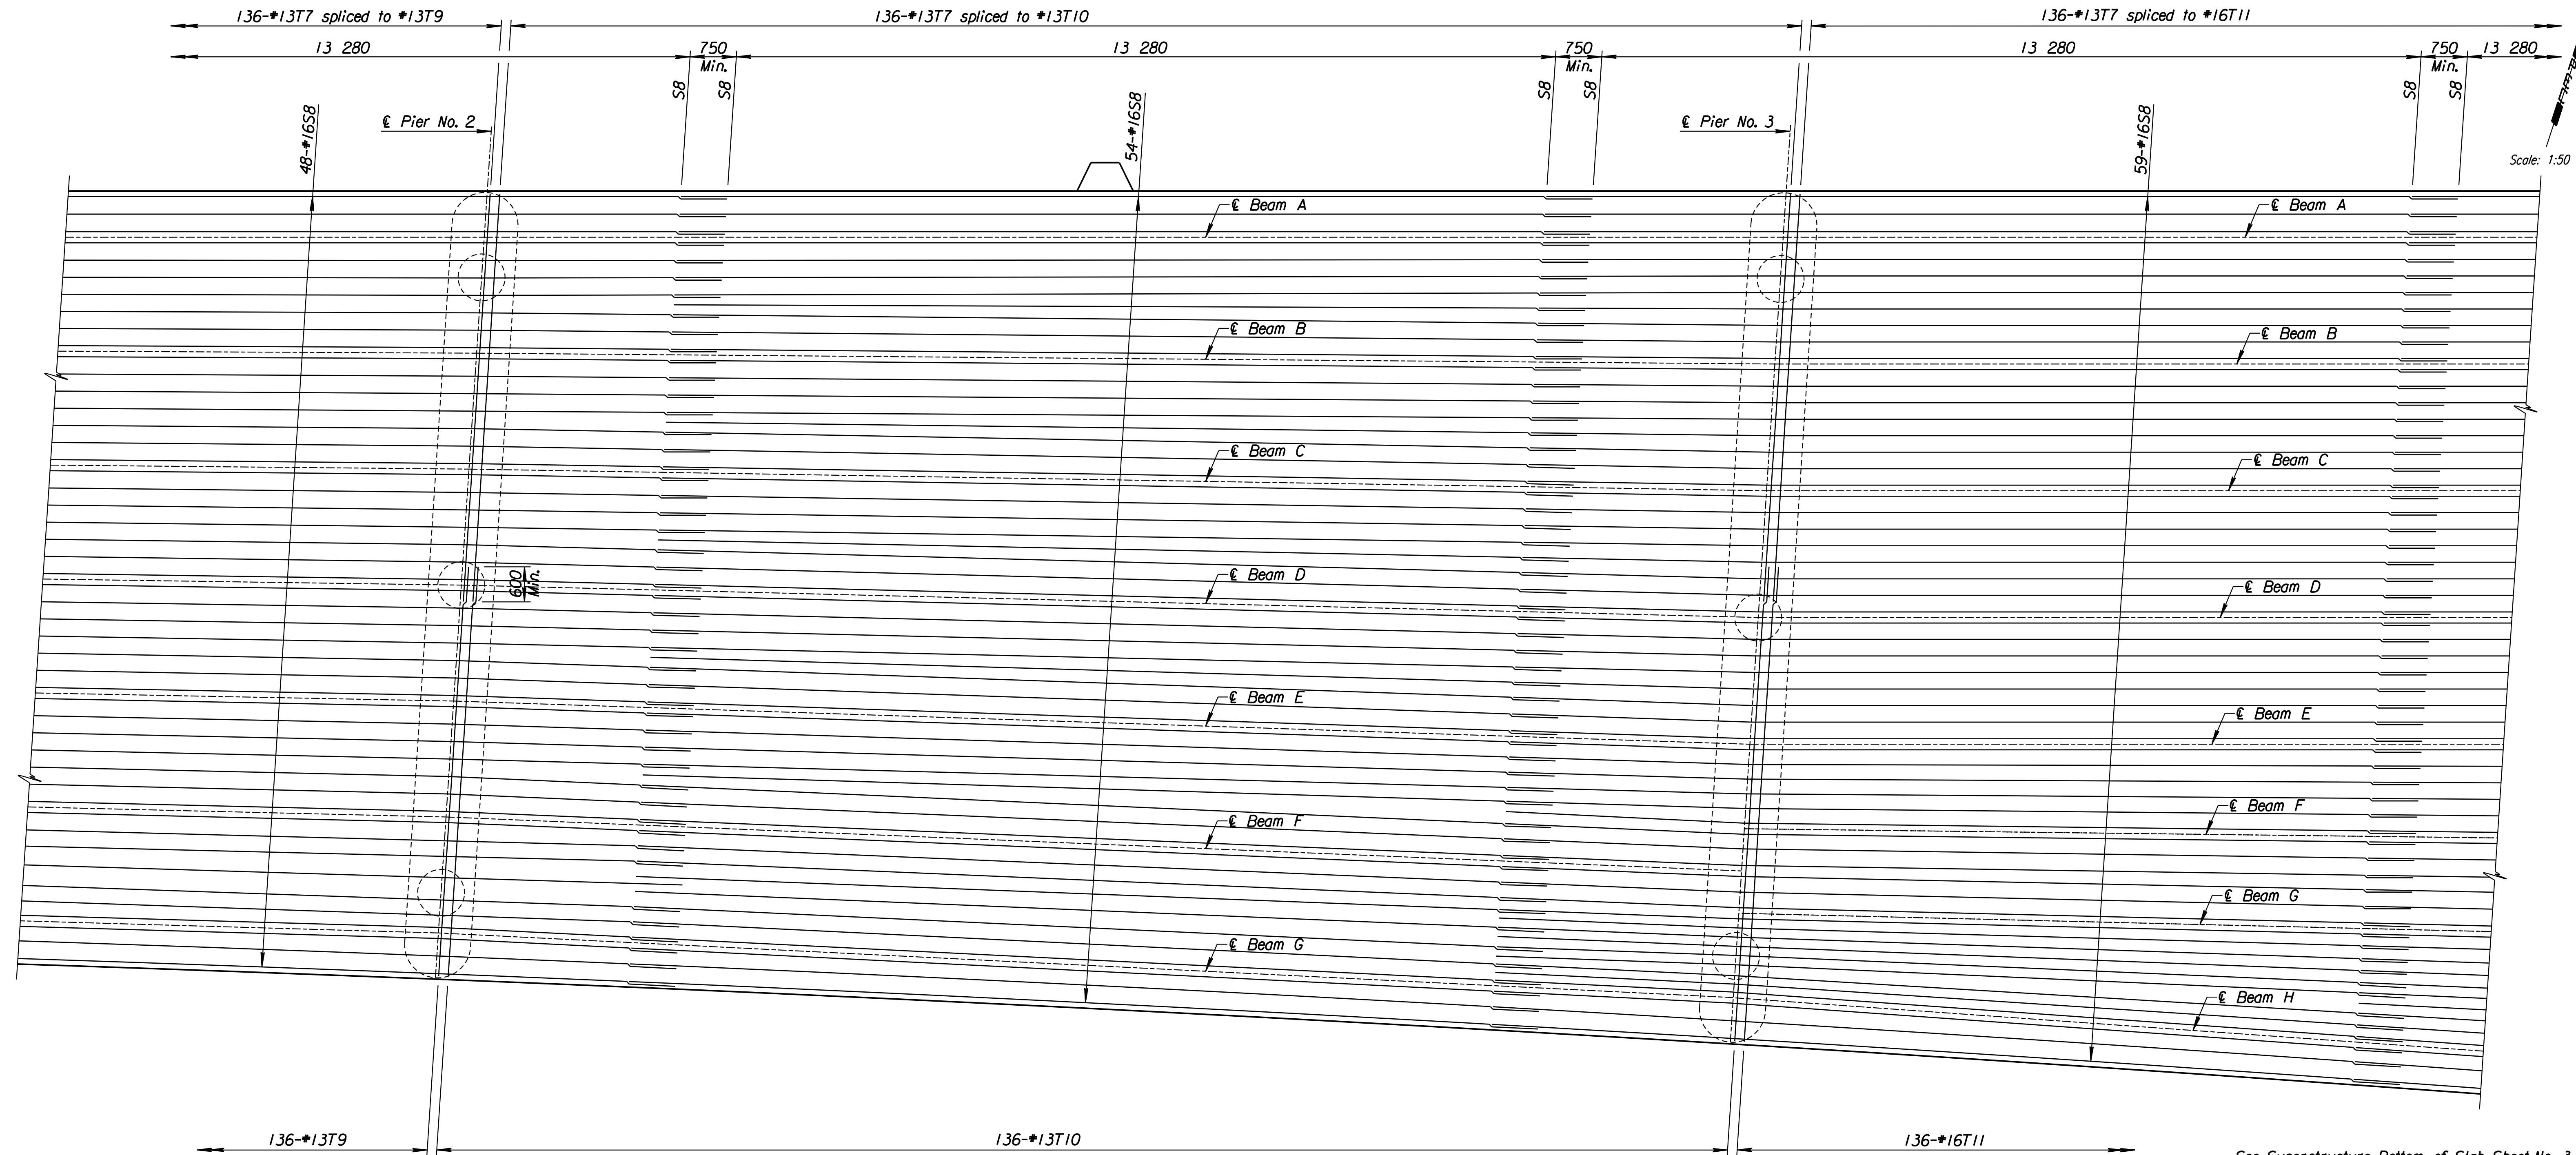

Scale: 1:50

See Superstructure Bottom of Slab Sheet No. 3 for continuation.  
See Typical Bridge Section for additional information.

Note:  
T7 thru T12 bars to be placed parallel to € of Abutments and Piers.

**RECORD DRAWING**

1			
No.	Revisions	By	Date
CITY OF WICHITA BR. NO. 54-87-19.29 (492) F.E.B. STA. 16+005.740 <b>SUPERSTRUCTURE</b> <b>BOTTOM OF SLAB-SHEET NO. 2</b> E.B. FRT. RD. OVER COWSKIN CREEK SEDGWICK COUNTY			
<b>Professional Engineering Consultants, P.A.</b> 303 S. TOPEKA • WICHITA, KANSAS 67202 316-262-2691 • FAX 316-262-3003			
Designed by	RAS	Checked by	RAS
Drawn by	DRP	Date	April, 2002
		Job No.	97362

Dsnr: RAS Oper: gdr Scale: 1:50  
 1/1997/97.362/As-Built/dgn/Vol\_3/Sh 552-suplm2.dgn Last Rev: 9-5-07 By: gdr